

Latitude

Longitude

+  
 | 1.8s  
 | 1.46w

Topo Location

7.5' Loc. \_\_\_\_\_ 15' Loc. \_\_\_\_\_  
 \_\_\_\_\_ (calc.) \_\_\_\_\_

Company \_\_\_\_\_

Farm Jesse Ashcraft #3

15' Quad \_\_\_\_\_  
(sec.)

7.5' Quad Folsom


District GRANT

WELL LOCATION PLAT

County 103 Permit 30077

3 0677

Grant

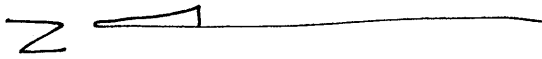

Wesley  
Robinson

Fleming

Manion Run


Jesse  
Ashcraft

Jacob  
Ashcraft

#3

J  
Herald

A  
Dye

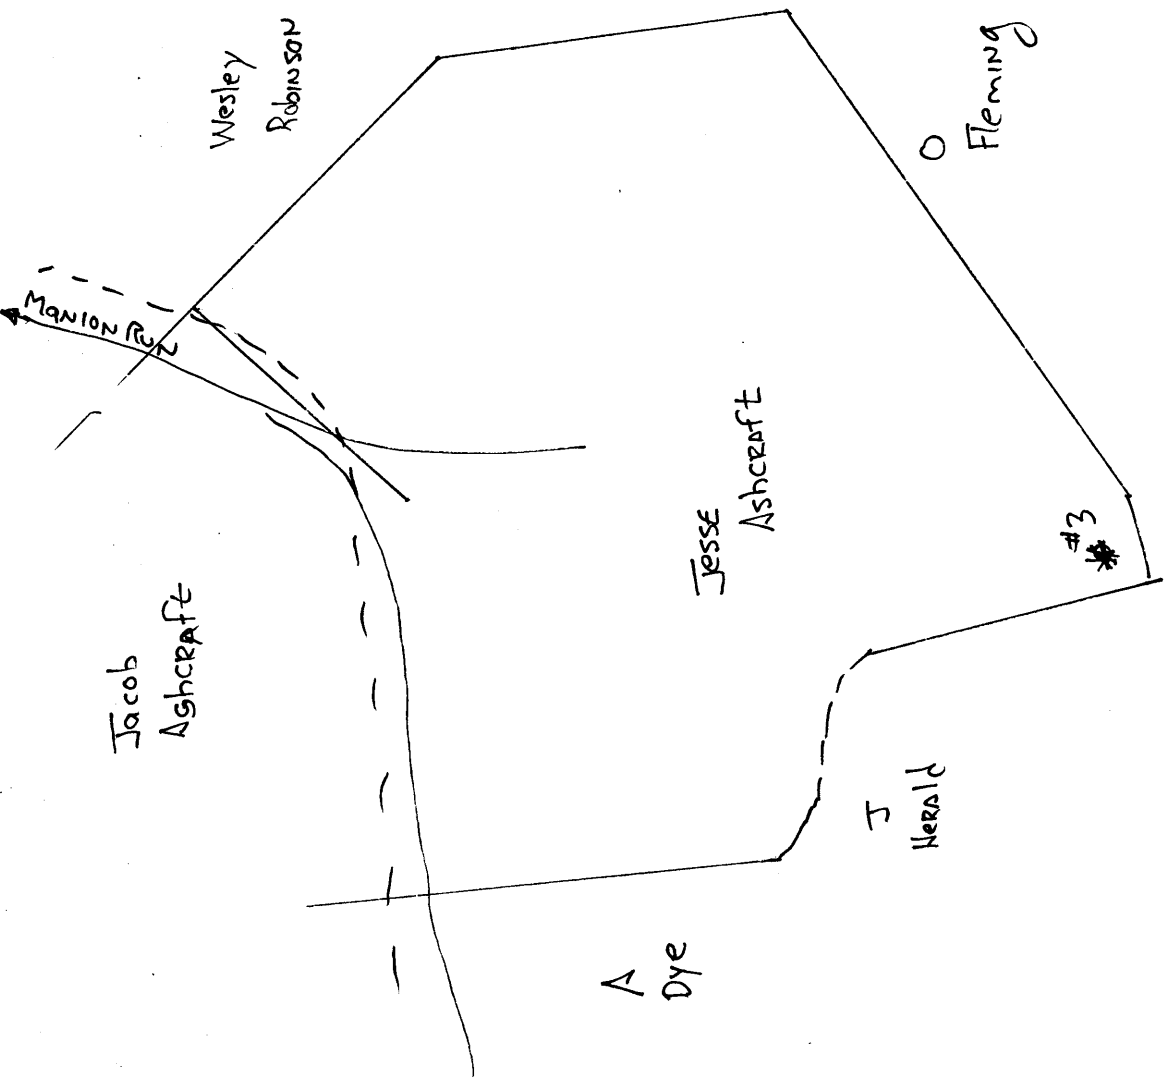

W-77-A

Grant District, Wetzel County, W. Va.

By South Penn Oil Co., Drawer 1255, Pittsburgh, Pa.

On 98.8 acres, surface by Broze G. Starkey, Folsom, W. Va., and minerals rights owned by Ingram Myers et al., New Martinsville, W. Va.

Elevation, 1414' L.

16' conductor; 10" casing, 30'; 8 $\frac{1}{4}$ ", 1685'; 6-5/8", 2670'.

Coal was encountered at 1192-1198'.

6 $\frac{1}{2}$  x 5" liner.

Abandonment reported to Dept. of Mines Jan 29, 1932.

Well was shot twice (depth unknown).

Oil well.

	Top.	Bottom.	Thickness.
Wood conductor	0	- 16	16
Pittsburgh Coal	1192	- 1198	6
Little Dunkard Sand	1580	- 1600	20
Big Dunkard Sand	1680	- 1730	50
Gas Sand	1920	- 1960	40
Salt Sand	2160	- 2250	90
Maxton Sand	2350	- 2370	20
Pencil Cave	2385	- 2395	10
Big Lime	2395	- 2490	95
Big Injun Sand	2490	- 2585	95
50-Ft. Sand	3060	- 3082	22
30-Ft. Sand	3150	- 3175	25
Stray Sand	3205	- 3260	55
Gordon Sand (oil, 3278')	3275	- 3297	22
Slate	3297	- 3316	19
Total depth		3316	