


39° 37' 30"

Latitude

Longitude

80° 45' 00"

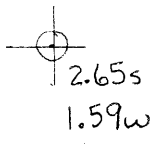

Topo Location

7.5' Loc. _____ 15' Loc. _____
 (calc.) _____

Company Mamypac Ltd NT

Farm Evans Annie Morgan # 2897


15' Quad _____
(sec.)

7.5' Quad Postes Falls

District Green

WELL LOCATION PLAT

County 103 **Permit** 30084

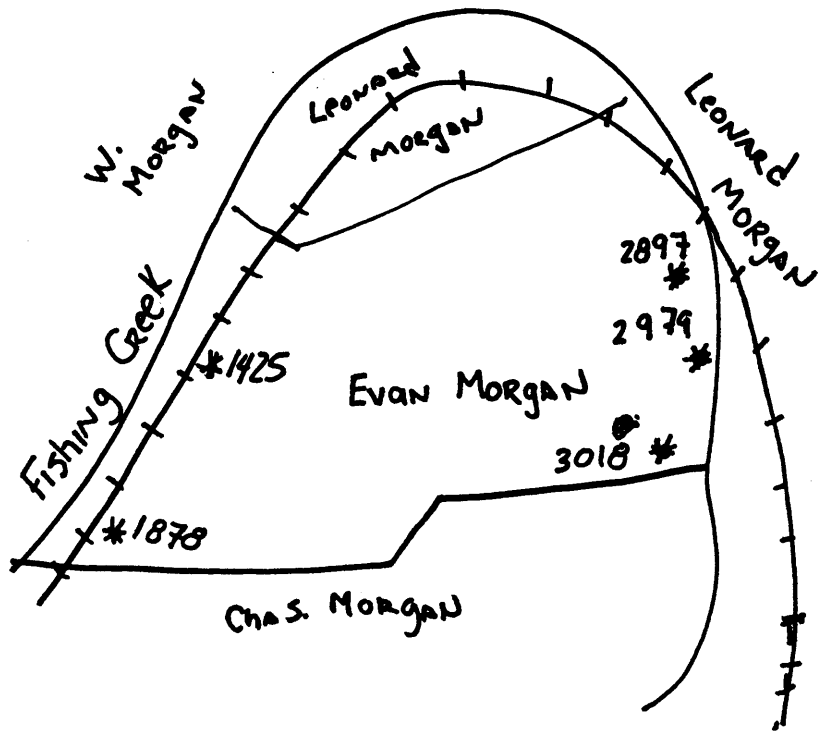

Now F. B. Jones

103-30084

Evan & A. Morgan No. 3-2897 Well (212-S)(265G)

Green District, Wetzel County, W. Va.; on south side of Fishing Creek, 0.7 mile northwest of Porters Falls; completed Dec. 11, 1933; authority, Manufacturers Light & Heat Company; elevation, 653' (H.L. to R.R.).

	Top. Feet.	Bottom. Feet.
Coal, <u>Pittsburgh</u>	476	480
Sand, <u>Minshall, Connellville</u>	506	530
Sand, <u>Murphy, Morgantown</u>	590	605
Sand, <u>Houndsville, Saltsburg</u> , (show of gas at 772-780')	755	815
Coal, <u>Lower Freeport</u>	1074	1078
Gas Sand, <u>Lower Freeport</u>	1088	1144
Coal, <u>Upper Kittanning</u>	1160	1162
Sand, <u>Second Cow Run, Homewood</u>	1220	1320
Sand, <u>Salt, Upper Connocquenessing</u> ...	1365	1390
Sand, <u>Sharon</u> , (show of gas at 1472-1474')	1470	1480
Sand and lime, hard	1540	1567
<u>Pencil Cave</u>	1590	1593
<u>Big Lime</u>	1593	1648
Sand, <u>Big Injun</u> (oil, 40 bbl.).....	1648	
Total depth		1760

13" casing, 16' (left in); 10" csg., 251' (left in);
 8" csg., 1003' (left in); 6 5/8" csg., 1618' (left in).

Green District, Wetzel County, W. Va.

M. L. & H. Co. No. 2897.

Contractor, Rowe Bros.

Completed, Dec. 11, 1923.

Elevation, 658' L.

Oil and gas well.

2" tubing, 1757'; 10" casing, 255'; 8", 1003'; 6-5/8", 1618'.

Original production, 45 bbls.; present, under 5 bbls.

Shot 3-10-25, with 15 qts; result, doubled to 20 bbls.

NET-84-A

	Top.	Bottom.
Lime	300	350
Pittsburgh Coal (blossom)	476	480
Sand	506	530
Sand	590	605
Red rock	620	640
Dunkard Sand (show gas, 772-80')	755	815
Coal	1074	1078
Gas Sand	1088	1144
Coal	1160	1162
1 Salt Sand	1220	1320
2 Salt Sand	1365	1390
3 Salt Sand (gas, 1472-4')	1470	1480
Sand and lime	1540	1567
Little Lime	1580	1590
Pencil Cave	1590	1593
Big Lime	1593	1648
Big Injun Sand (show gas, 1652-56'; oil and gas, 1755-60')	1648	1798
Total in sand		1760
Drilled deeper to		1798

oil = 20 bbls.