

Latitude

Longitude

⊕
2.74s
1.61w


Topo Location

7.5' Loc. _____ 15' Loc. _____
(calc.) _____

Company Manufact L+H
Farm Evam & Annie Morgan # 2979
15' Quad _____
(sec.)
7.5' Quad Posters Falls
District Green

WELL LOCATION PLAT

County 103 **Permit** 30085

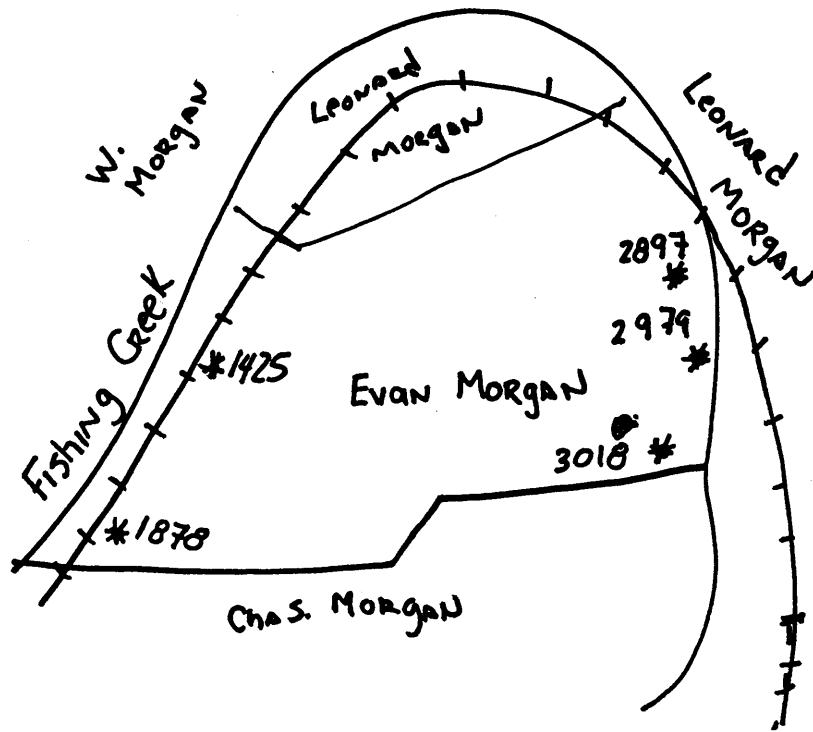

Now F. B. Jones

Green District, Wetzel County, W. Va.

By The Manufacturers Light & Heat Co., 800 Union Trust Bldg.,
Pittsburgh, Pa.

On 121 acres, surface owned by Evan and Annie Morgan, Porters Falls,
W. Va., and mineral rights by WIAHCo., Pgh., Pa.

Drilled prior to June 1, 1929.

Elevation, 670' B.

10" casing, 313'; 8 1/2", 1016'; 6-5/8", 1647'.

Coal was encountered at 481-483, and 1080-1082'.

Abandonment reported to Dept. of Mines Aug. 23, 1932.

Producing hole.

WET ~~85-A~~
85-A

	Top.	Bottom.	Thickness.
Pittsburgh Coal	481	- 483	2
Shale	483	- 500	17
Sand	500	- 528	28
Red rock	615	- 640	25
Shale	640	- 760	120
Sand	760	- 815	55
Shale	815	- 845	30
Sand	845	- 857	12
Shale	857	- 1012	155
Lime	1012	- 1025	13
Shale	1025	- 1080	55
Coal	1080	- 1082	2
Gas Sand	1090	- 1145	55
Shale	1145	- 1260	115
1st Salt Sand	1260	- 1328	68
2nd Salt Sand	1370	- 1395	25
3rd Salt Sand (show gas, 1475-1478')	1440	- 1487	47
Shale	1487	- 1542	55
Marion Sand (gas, 1550-1553') (blew out in 12 hrs.)	1542	- 1560	18
Little Lime	1570	- 1578	8
Pencil Cave	1578	- 1590	12
Big Lime	1590	- 1645	55
Big Injun Sand (gas, 1754-1756'; gas and oil, 1757-1763')	1645		
Total depth			1787