

39°40'00"

Latitude

80°40'00"

Longitude

2045
24w

Topo Location

7.5' Loc. _____ 15' Loc. _____
(calc.) _____

Company Hope Const Ref Co

Farm NJ Postlethwait # 1032


15' Quad _____
(sec.)

7.5' Quad Wileyville

District Center

WELL LOCATION PLAT

County 103 Permit 30087

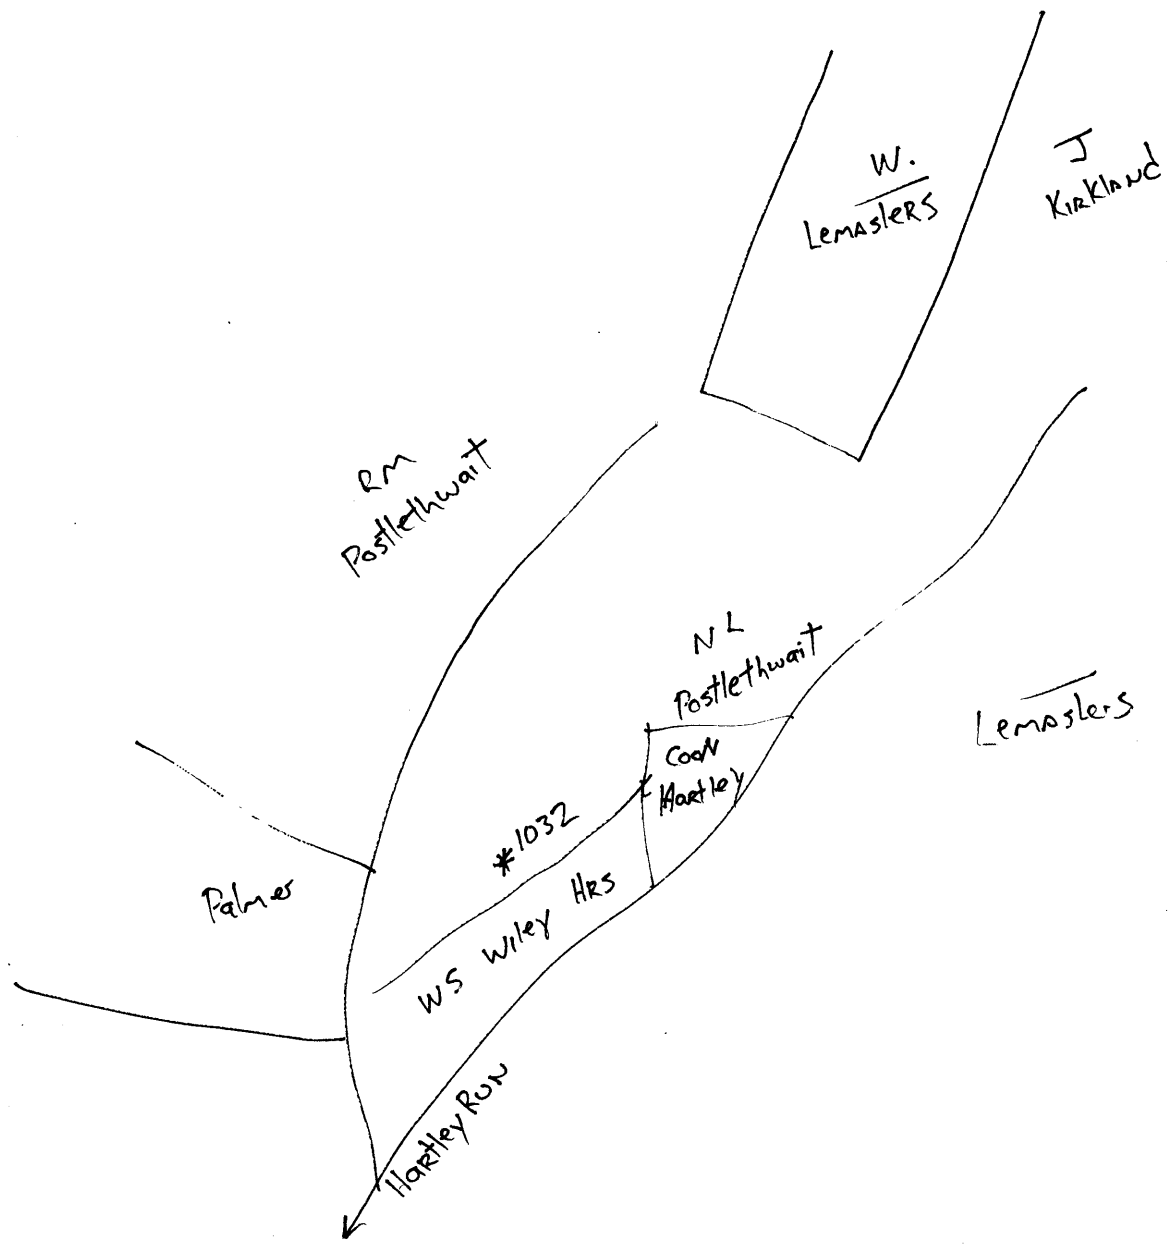

Center District, Wetzel County, W. Va.

By Hope Cons. & Ref. Co., 445 W. Main St., Clarksburg, W. Va.

On 114 acres, surface owned by R. M. Postlethwait, Wileyville, W. Va.

Elevation, 1122' L.

6-5/8" casing, 2325'; 5-3/16", 3060'.

Ab. P. 87-A

Coal was encountered at 785-787, 995-1001, and 1095-1098'.

Abandonment reported to Dept. of Mines Sept. 15, 1932.

Well was shot at 3107-3114'.

No record of fresh water; salt water at 1980 and 2175'.

Oil well; exhausted to extent that it is not commercially productive.

	Top.	Bottom.	Thickness.
Native coal	785	- 787	2
Native coal	995	- 1001	6
Pittsburgh Coal	1095	- 1098	3
Little Dunkard Sand	1520	- 1530	10
Big Dunkard Sand	1585	- 1640	55
Gas Sand	1670	- 1710	40
First Salt Sand	1810	- 1860	50
Second Salt Sand (water, 1980')	1960	- 2005	45
Maxton Sand (water, 2175')	2130	- 2245	115
Big Lime	2255	- 2285	30
Big Injun Sand	2285	- 2529	244
Berea Sand	2635	- 2685	50
50-Ft. Sand	2865	- 2870	5
30-Ft. Sand	3029	- 3041	12
Gordon Stray Sand	3105	- 3117	12
Gordon Sand (oil, 3107-3113')	3117		
Total depth			3154