




30095  
GRANT

Robinson Imp Co.

Cath Ice @ HRS

Manion Run

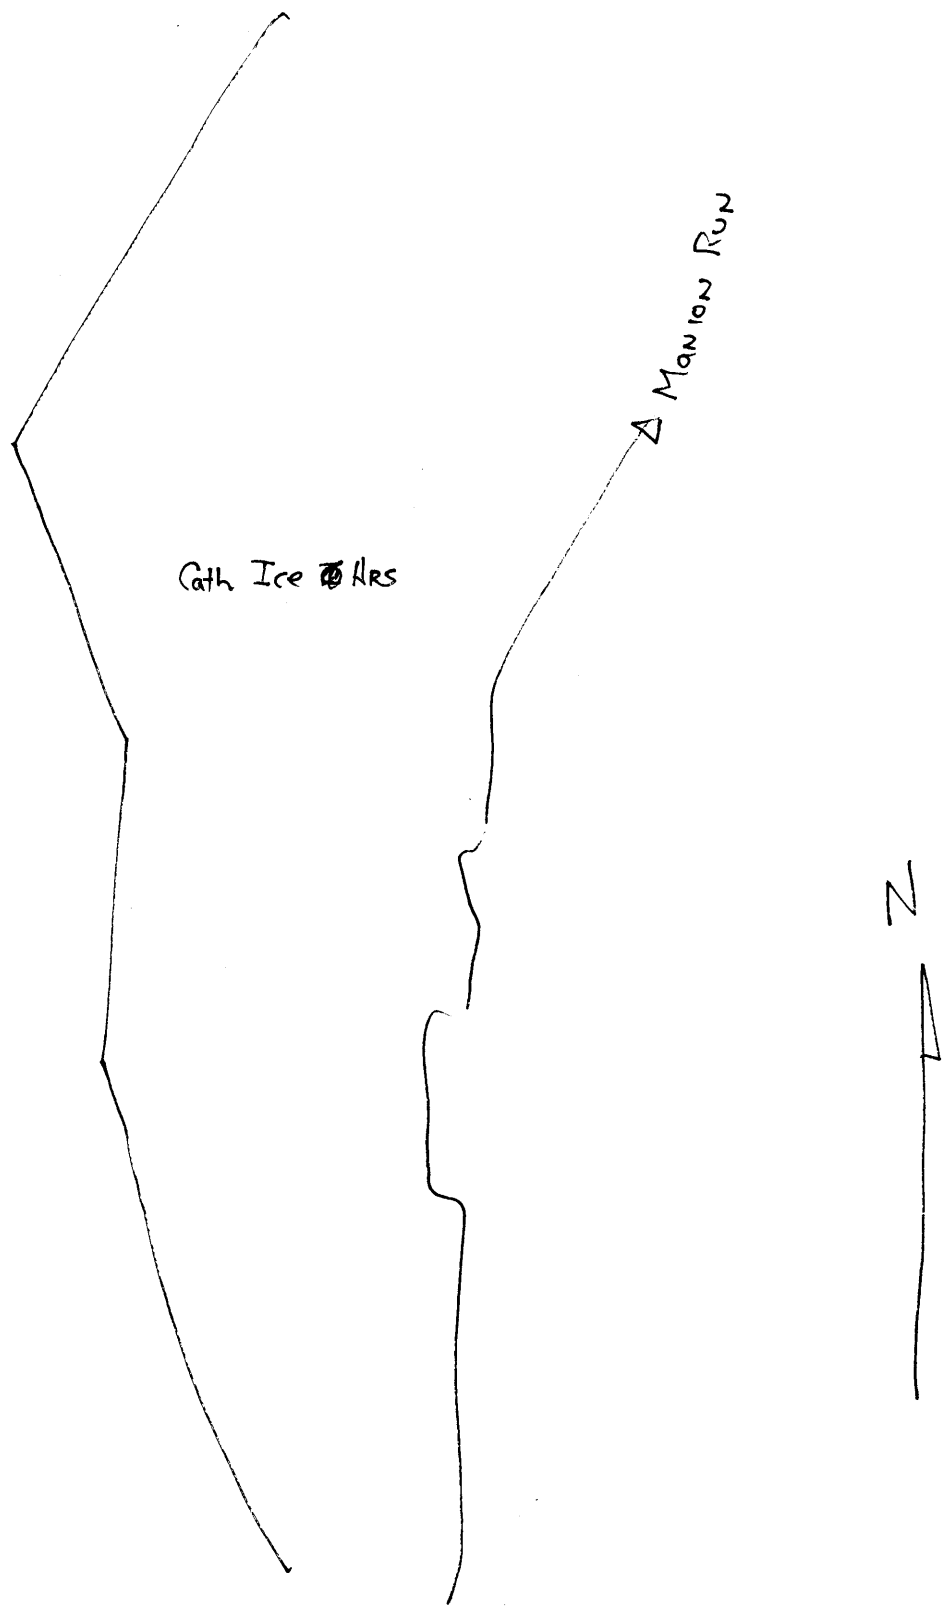

Grant District, Wetzel County, W. Va.  
 By South Penn Oil Co., P. O. Drawer 1255, Pittsburgh, Pa.  
 On 225 acres, surface and mineral rights owned by Catherine Ice  
 Heirs, M. J. Morgan, Paden City, W. Va.  
 Elevation, 1334.7' L.  
 16" conductor; 10" casing, 448'; 8 1/4", 1698'; 6-5/8", 2565';  
 5-3/16", 3258'.  
 Coal was encountered at 1165-1170'.  
 Abandonment reported to Dept. of Mines Oct. 21, 1932.  
 Well was shot in Gordon Sand, July 11, 1913, with 20 qts.;  
 July 22, 1913, with 40 qts.; and Feb. 19, 1919, with 40 qts.  
 Producing hole.

WET-95-A

	Top.	Bottom.
Pittsburgh Coal	1165	- 1170
Little Dunkard Sand	1575	- 1590
Big Dunkard Sand	1640	- 1700
Gas Sand	1930	- 1945
Salt Sand	2065	- 2160
Maxton Sand	2280	- 2370
Pencil Cave	2370	- 2374
Big Lime	2374	- 2449
Big Injun Sand	2449	- 2540
Upper 30-Ft. Sand	2878	- 2916
50-Ft. Sand	3005	- 3040
Lower 30-Ft. Sand	3111	- 3140
Gas in Stray, 3209'		
Stray Sand (Gordon)	3244	- 3264
Oil in Gordon, 3248' and 3259'		
	TOT	
Total depth		3264