

Latitude

Longitude

+
1.15s
1.77w

Topo Location

7.5' Loc. _____ 15' Loc. _____
_____ (calc.) _____

Company Green Oil Co

Farm James Elson #1


15' Quad _____
(sec.)

7.5' Quad Porters Falls

District Green

WELL LOCATION PLAT

County 103 **Permit** 30100

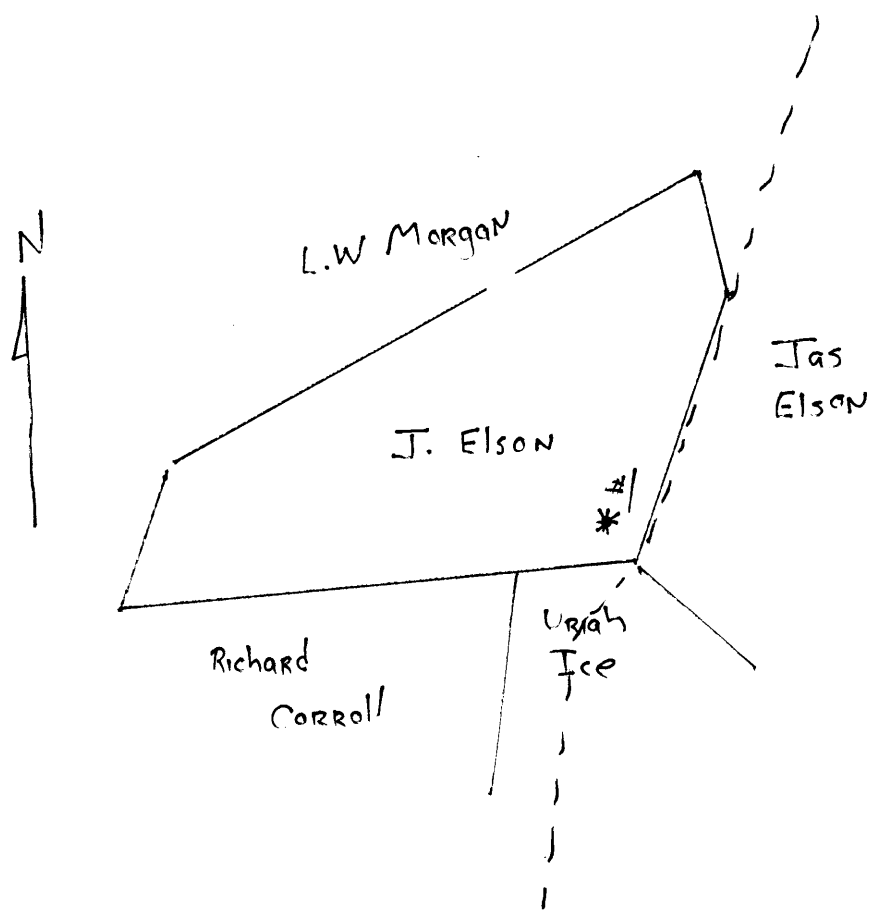

Green District, Wetsel County, W. Va.
 By Green Oil Co., New Martinsville, W. Va.
 On 13 acres, surface and mineral rights owned by James Elson,
 New Martinsville, W. Va.

No elevation given.

13" conductor, 12'; 10" casing, 350'; 8 1/2", 1540'; 6-5/8", 2197'.

No coal was encountered. No liner used.

Well was shot at 2352'.

Oil well. Completed June 26, 1928.

Abandonment? report not dated. (Filed 1933?)

WET-100-A

	Top.	Bottom.	Thickness.
Coal blossom, dark	595	- 597	2
Coal blossom, dark, slaty	800	- 804	4
Coal blossom, dark, slaty	1080	- 1083	3
Murphy Sand, gray	1095	- 1125	30
Little Dunkard Sand, gray	1446	- 1486	40
Big Dunkard Sand, gray	1532	- 1550	18
Gas Sand, gray	1645	- 1670	25
First Salt Sand, gray	1705	- 1770	65
Second Salt Sand, gray	1860	- 1940	80
Third Salt Sand, gray	2045	- 2075	30
Maxton Sand, gray	2145	- 2165	20
Big Lime, dark	2185	- 2247	62
Big Injun Sand, light-gray	2247	- 2387	140
Total depth		2387	