


30107
Church

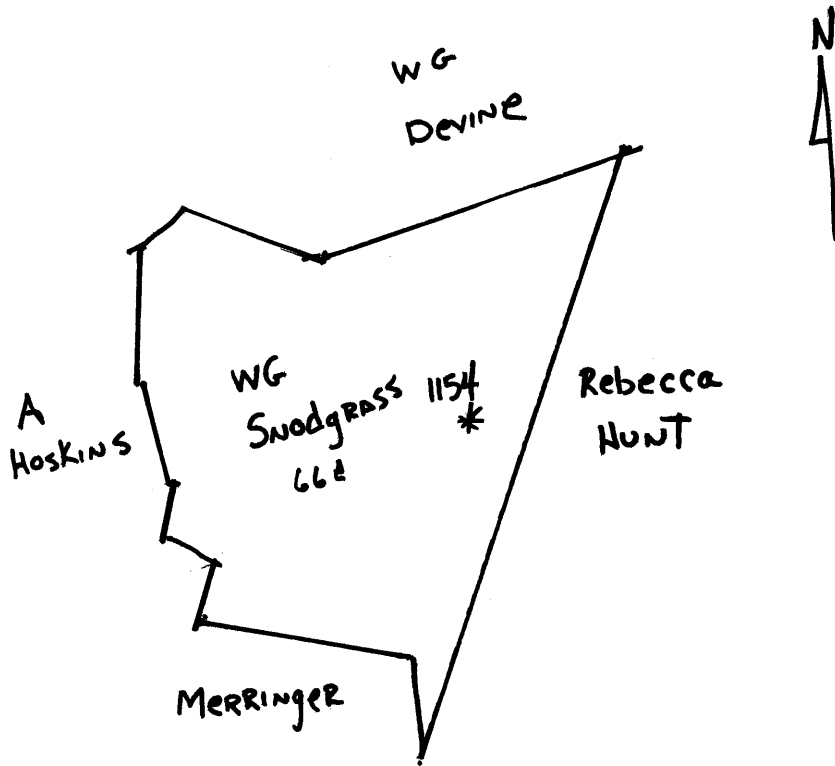

Wet-107-A

Church District, Wetzel County, W. Va.

By The Manufacturers Light & Heat Co., 800 Union Trust Bldg.,
Pittsburgh, Pa.

On 66 acres, surface owned by Walter S. Farbee, Trustee,

Mannington, W. Va., and mineral rights by ML&Co., Pgh., Pa.

Drilled prior to June 1, 1929.

Elevation, 1294' L.

10" casing, 176'; 8 $\frac{1}{4}$ ", 1370'; 6-5/8", 2168'.

Coal was encountered at 955' and 1055-1062'.

Abandonment reported to Dept. of Mines Oct. 11, 1933.

	Top.	Bottom.	Thickness.
Mapletown (Sewickley) Coal	957		
Pittsburgh Coal	1055	- 1062	7
Big Dunkard Sand	1540	- 1580	40
Gas Sand	1737	- 1795	58
Salt Sand	2045	- 2083	38
Maxton Sand	2148	- 2200	52
Big Lime	2220	- 2280	60
Big Injun Sand	2280	- 2525	245
50-Ft. Sand	3014	- 3069	55
Gordon Stray Sand	3090	- 3116	56
Gordon Sand	3150	- 3187	37
Fourth Sand	3252	- 3279	17
(Gas at 3363')			
Total depth			3505