321 30"

Latitude

· 22 s .71 w

Topo Location

7.5' Loc	15' Loc
	(calc.)

Company South Penn Oil Co


Farm Blackshore Wells & Co #61

7.5' Quad Folsom

District GRANT

WELL LOCATION PLAT

County 103 Permit 30110

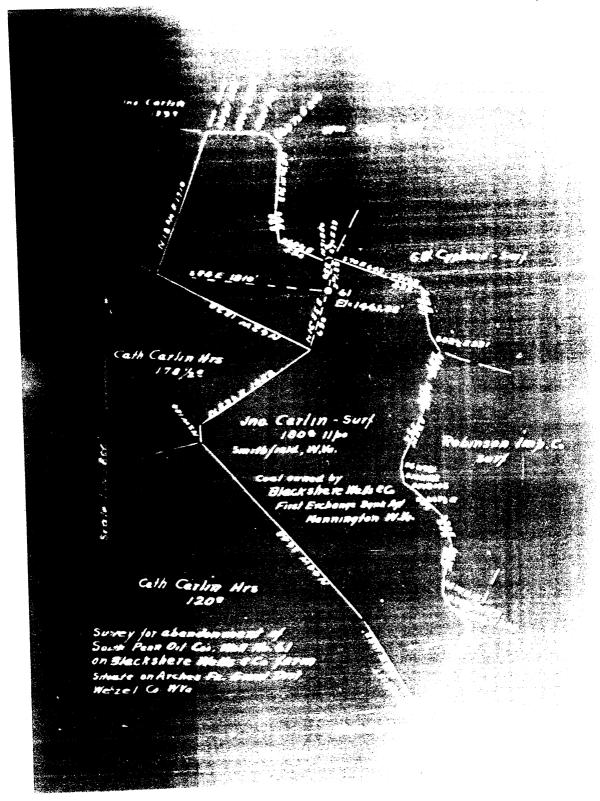

Grant District, Wetzel County, W. Va.

By South Penn Oil Co., Drawer 1255, Pittsburgh, Pa.

On 3800 acres, surface owned by John Carlin, Smithfield, W. Va., and mimeral rights by Heirs of John Blackshere et al., First Exchange Bank, Mannington, W. Va., Agent.

Elevation, 1461.88° L.

16' conductor; 10" easing, 353°; 8½°, 1711°; 6-5/8°, 2476°.

Coal was encountered at 1207-1217°.

Abandonment reported to Dept. of Mines March 21, 1934.

Well was shot Sept. 15, 1920, with 30 qts.

Water at 2150°.(salt?)

Oil well.

WET-110-A

	Top. Bottom.
Pittsburgh Coal	1207 - 1217
Little Dunkard Sand	1600 - 1615
Big Dunkard Sand	1708 - 1735
Gas Sand	19 15 - 1 9 30
1st Salt Sand	2000 - 2025
2nd Salt Sand (water, 2150')	208 0 - 2260
Little Lime	2418 - 2428
Pencil Cave	2428 - 2438
Big Lime	2438 - 2510
Big Injun Sand (gas, 2557'; oil and	•
gas, 25921)	2510
Total depth	2596