

Latitude

80° 25' 00"

Longitude

+
2.23s
.68w

Topo Location

7.5' Loc. _____ 15' Loc. _____
_____ (calc.) _____

Company Pitts & WV Gas Co

Farm Henry HumeDrick #1826

15' Quad _____
(sec.)


7.5' Quad Hundred

District Church

WELL LOCATION PLAT

County 103 Permit 30127

Church dist

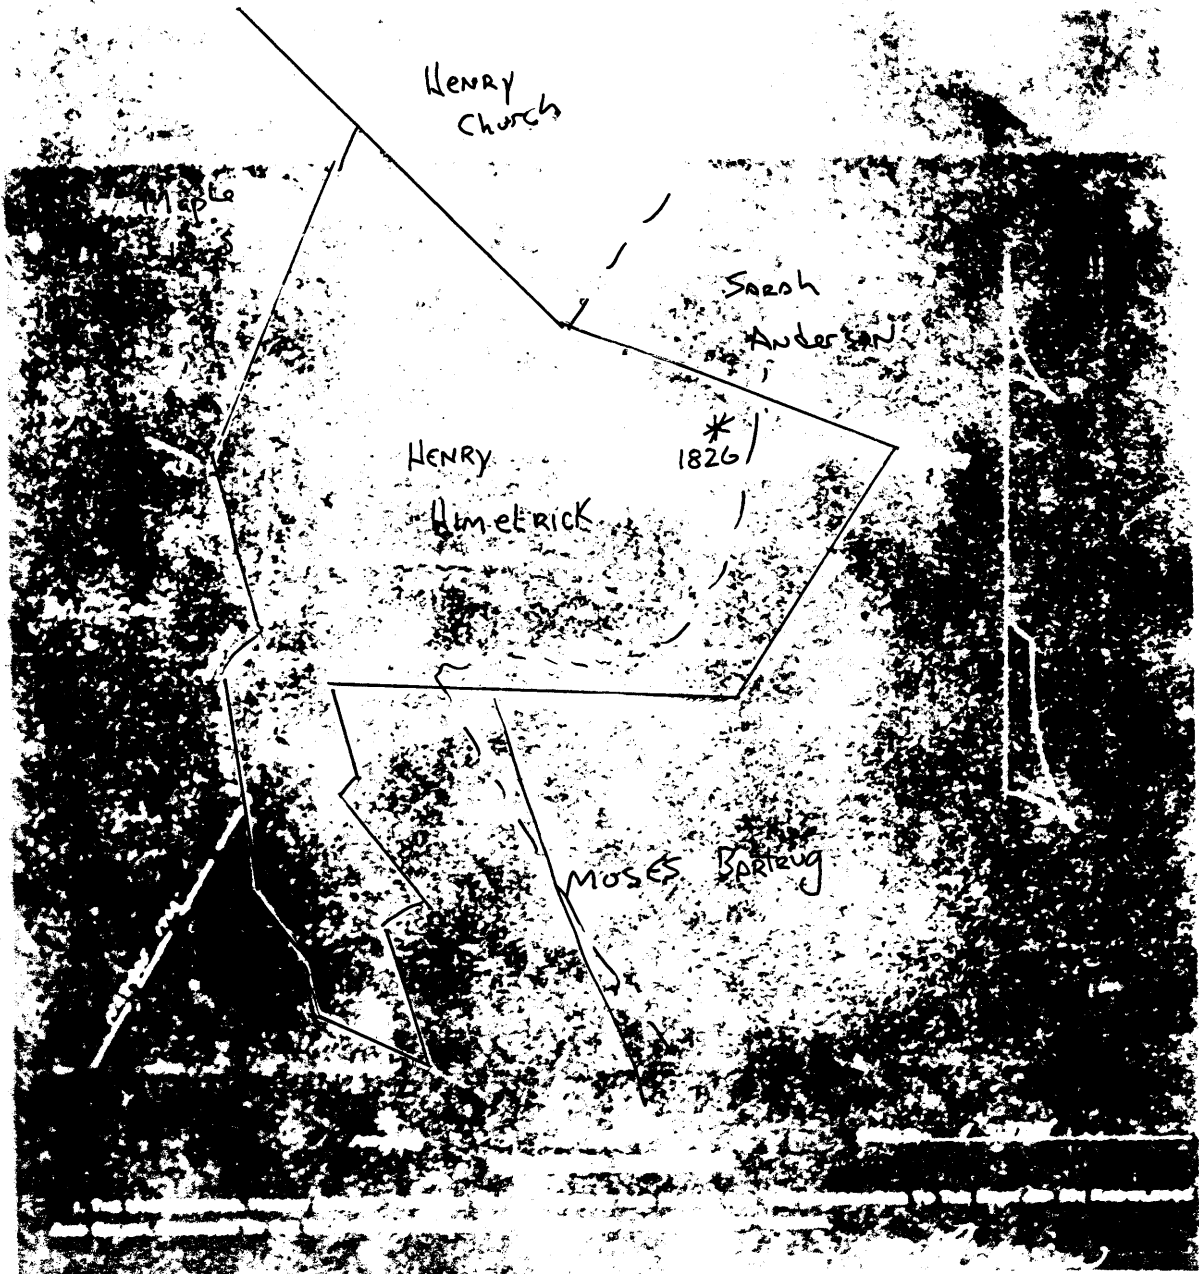

103-127A

Henry Himmelrick No. 1-1626 Well (10)

Church Dist., Wetzel Co., W. Va.; in ravine south of Church Fork of Fish Creek 1.7 miles S 68° E of Hundred; completed Sept. 27, 1904; by Pittsburgh & West Virginia Gas Co.; elevation, _____.

	Top. Feet.	Bottom. Feet.
Coal, <u>Pittsburgh</u>	--	961
Sand, <u>Salt</u>	1060	1985
Sand, <u>Maxton</u> (gas, 2091 and 2110')....	2076	--
<u>Big Linc.</u>	2138	2192
Sand, <u>Big Injun</u> (gas, 2295').....	2192	2417
Sand, <u>Gordon</u>	3070	3130
Sand, <u>Fourth</u>	3167	3187
Total depth		3300

10" casing, 289'; 8" cas., 1350'; 6 5/8" cas., 2172'; hole reduced, 3165'.

Maxton and Big Injun Sand gas well, according to record. According to local report there was Fourth Sand gas and some oil.

1888. Henry (Maxon) Farm.
 Church 1881, Weizel 1881.

Name	Color	Character	Depth of Water
Un-recorded									
Pgh. Coal									
Un-recorded									
Salt Sand									
Un-recorded									
Maxon Sand			G-2091'	2076	2130	54	2130		
Un-recorded			G-2116'	2130	2130	0	2130		
Big Lime				2130	2192	62	2192		
Big Injun			G-2295'	2192	2417	225	2417		
Un-recorded				2417	3070	653	3070		
Gordon Sand				3070	3130	60	3130		
Un-recorded				3130	3167	37	3167		
4th. Sand				3167	3187	20	3187		
Un-recorded				3187	3300	113	3300		
Total Depth							3300'		

THE ... COMPANY
[Signature]