

39° 27' 30"

Latitude

+

.13s
39w

80° 37' 30"

Longitude

Topo Location

7.5' Loc. _____ 15' Loc. _____
_____ (calc.) _____

Company Carnegie Nat Gas

Farm SJ McIntyre #2 - 1207


15' Quad _____
(sec.)

7.5' Quad CENTER POINT

District GRANT

WELL LOCATION PLAT

County 103 **Permit** 30128

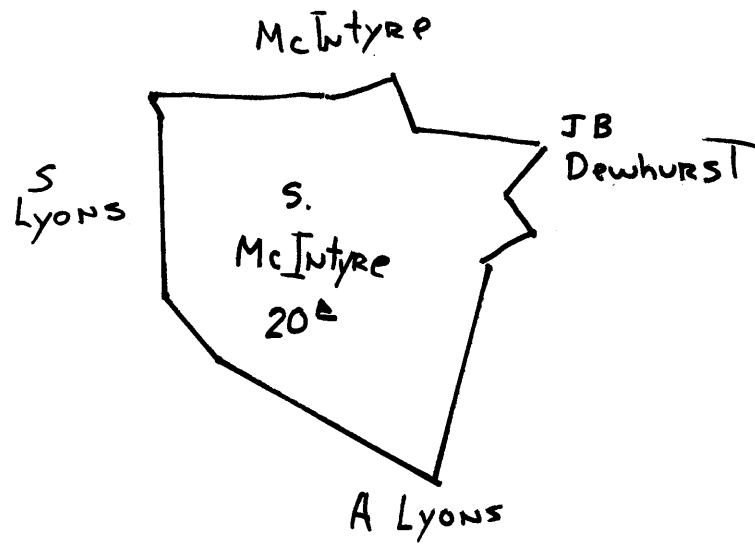

Grant District, Wetzel County, W. Va.

By Carnegie Natural Gas Co., 962 Frick Bldg. Annex, Pittsburgh, Pa.

On 20 acres, surface owned by S. J. McIntyre, Jacksonburg, W. Va.;

and mineral rights by State of W. Va. (for taxes).

Drilled before June, 1929. (Lease No. 10701).

Elevation.....

10" casing, 260'; 8 $\frac{1}{2}$ " 1505'; 6-5/8" 2350'; 2" tubing, 2514'.

Coal was encountered at 763-764 and 1053-1055'.

Abandonment reported to Dept. of Mines Oct. 3, 1934.

Well was shot at 2482-2488' and 2472-2478' and 2481-2489'.

Producing hole.

	Top.	Bottom.	Thickness.
Conductor	0	- 16	16
Mapletown (Waynesburg) Coal	763	- 764	1
Pittsburgh Coal	1053	- 1055	2
Little Dunkard Sand	1470	- 1512	42
Big Dunkard Sand	1585	- 1595	10
Gas Sand	1635	- 1655	20
1st Salt Sand	1685	- 1725	40
2nd Salt Sand	1805	- 1825	20
Maxton Sand	2200	- 2210	10
Little Lime	2295	- 2310	25
Big Lime	2343	- 2423	80
Big Injun Sand (gas, oil and water at 2482-2488')	2423		
Total depth			2514

NET-128-A