

**Latitude**

**Longitude**

+

.67s  
2.01w

**Topo Location**

7.5' Loc. \_\_\_\_\_ 15' Loc. \_\_\_\_\_  
\_\_\_\_\_ (calc.) \_\_\_\_\_

Company Manufact Lt + Ht

Farm W G Snodgrass #1 (1155)

15' Quad \_\_\_\_\_  
(sec.)


7.5' Quad Hundred

District Church

**WELL LOCATION PLAT**

County 103 Permit 30129

30129  
CHURCH

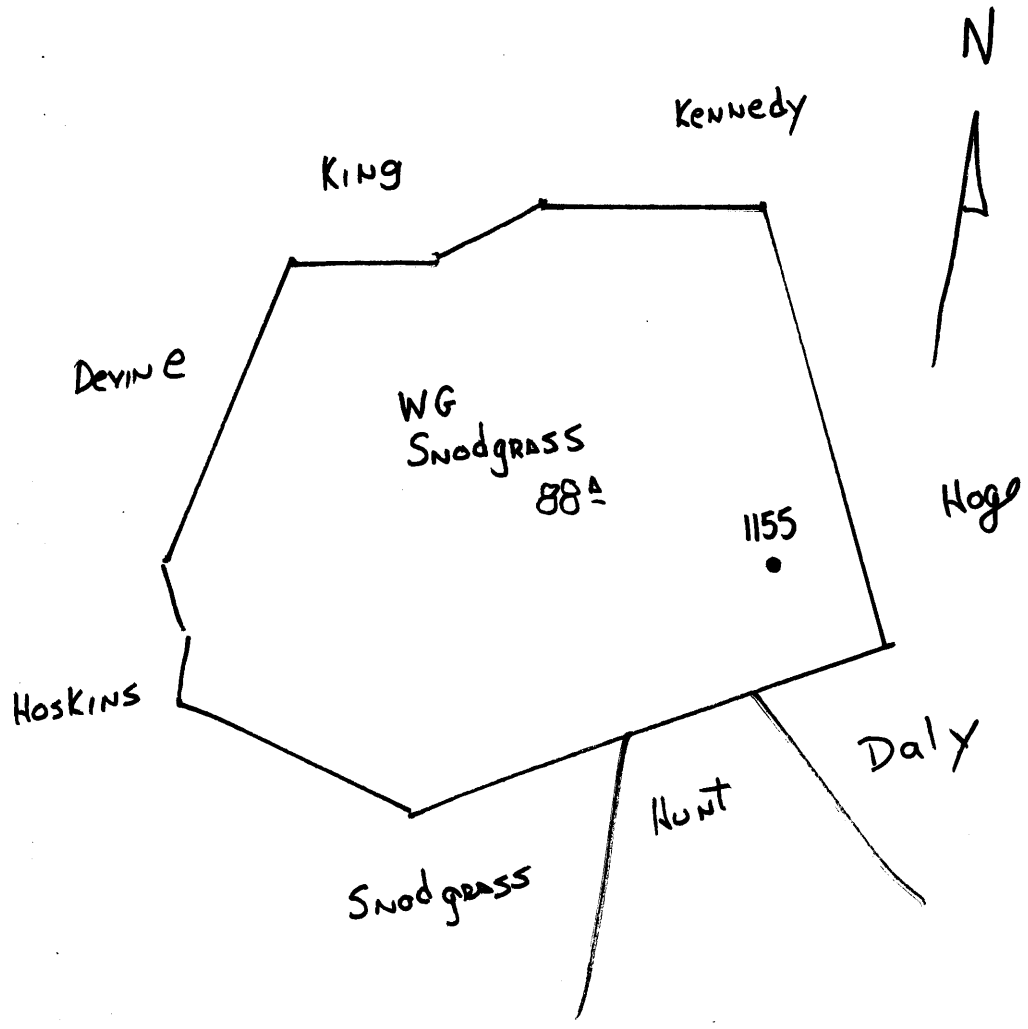

Wet-~~129~~-A

Church District, Wetzel County, W. Va.

By The Manufacturers Light & Heat Co., 800 Union Trust Bldg.,  
Pittsburgh, Pa.On 85 acres, surface owned by W. G. Snodgrass (now Walter S.  
Furbee, Trustee), Mannington, W. Va., and mineral rights  
by ML&N Co., Pgh., Pa.

Drilled prior to June 1, 1929.

Elevation, 1273' L.

16" conductor; 10" casing, 200'; 8 $\frac{1}{2}$ " 1545'; 6-5/8" 2278';  
4" tubing, 3480'.

Coal was encountered at 957 and 1055-1062'.

Abandonment reported to Dept. of Mines Oct. 1, 1934.

Producing hole.

	Top.	Bottom.
Mapletown (Sewickley) Coal	957	
Pittsburgh Coal	1055	- 1062
Big Dunkard Sand	1540	- 1580
Gas Sand	1737	- 1795
Salt Sand	2045	- 2083
Maxton Sand	2148	- 2200
Big Lime	2220	- 2280
Big Injun Sand	2280	- 2525
50-Ft. Sand	3014	- 3069
Gordon Stray Sand	3090	- 3116
Gordon Sand	3150	- 3187
Fourth Sand	3252	- 3279
Shell, (little gas)	3365	
Total depth		3505