

J. Ballou

SW

El Centro


El Centro

El Centro

El Centro

El Centro

Center

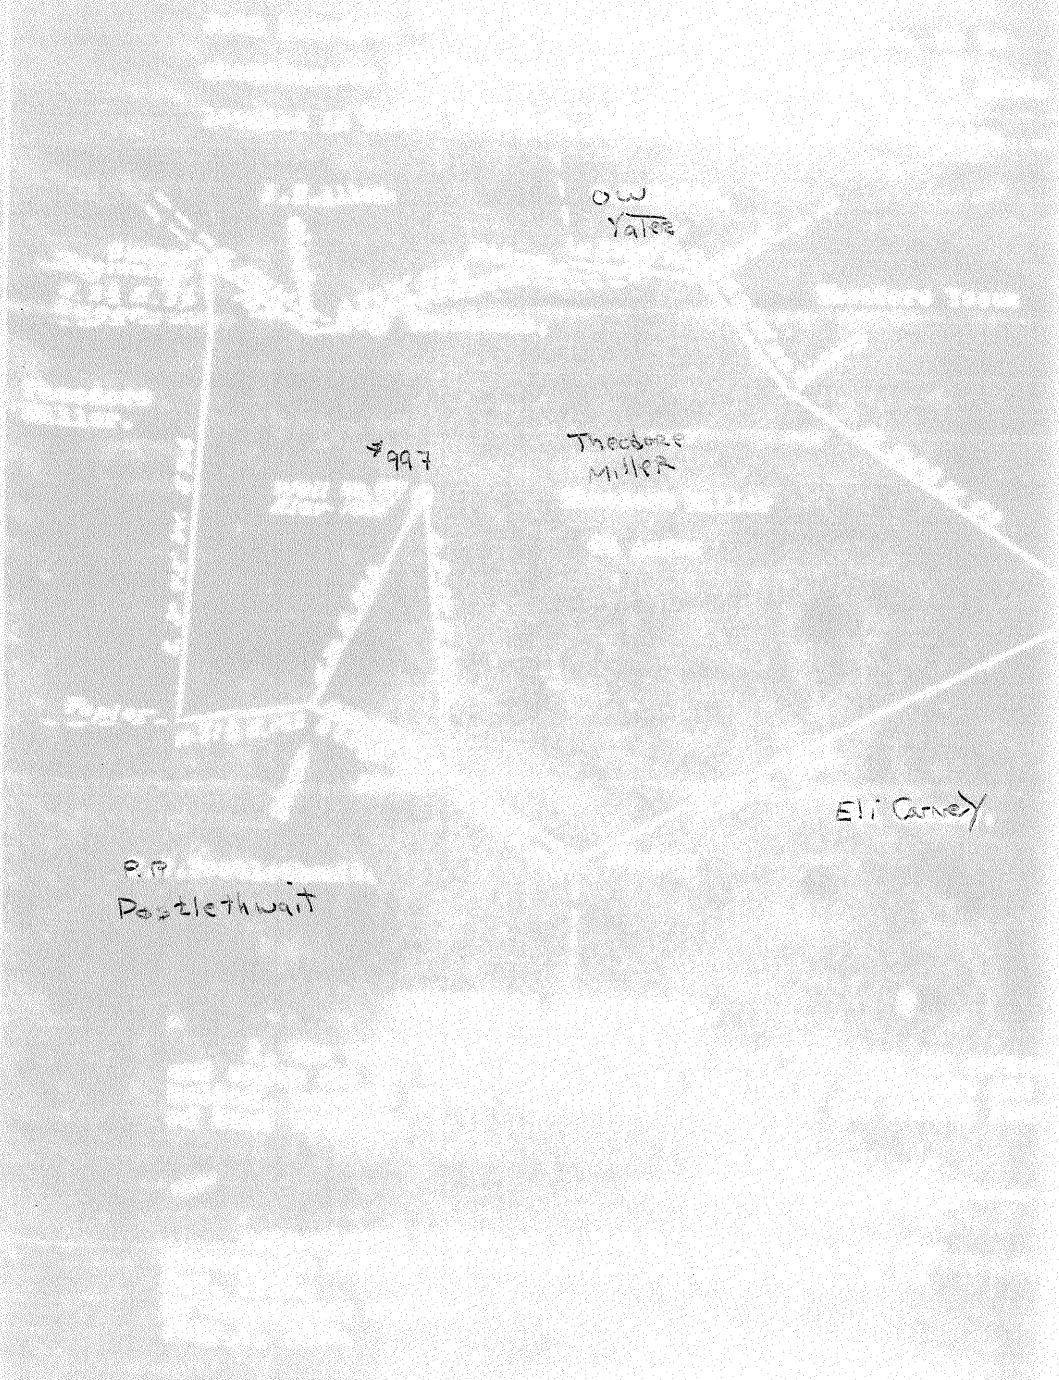

Center District, Wetzel County, W. Va.

By Donald Billinger, Knob Fork, W. Va.

Abandoned under permit Wet-148.

Surface and minerals owned by Theo. Miller, Silver Hill, W. Va.

Permit not required when drilled.

Elevation, 1360' L.

10" casing, 503'; 8" casing, 1585'; 6" casing, 2212'; 5" casing, 3108'; 2" tubing, 3395'.

Abandonment reported to Dept. of Mines June 1, 1935.

Oil well.

Record to NGT from Mrs. Griffith Sept. 19, 1938.

	Top.	Bottom.	Thickness.
Native coal	1160	- 1165	5
Pittsburgh Coal	1260	- 1267	7
Gas Sand	1955	- 1980	25
First Salt Sand (water, 2055')	2040	- 2065	25
Second Salt Sand	2145	- 2186	41
Maxton Sand (water, 2365')	2333	- 2392	59
Big Injun Sand (gas, 2494')	2460	- 2698	238
Fifty-foot Sand	3073	- 3100	27
Gordon Stray Sand (oil, 3301 1/2')	3294	- 3302	8
Gordon Sand (oil, 3315-3318')	3306	- 3320	14
Total depth			3395