




Location \_\_\_\_\_  
 County \_\_\_\_\_  
 Date \_\_\_\_\_  
 Scale \_\_\_\_\_

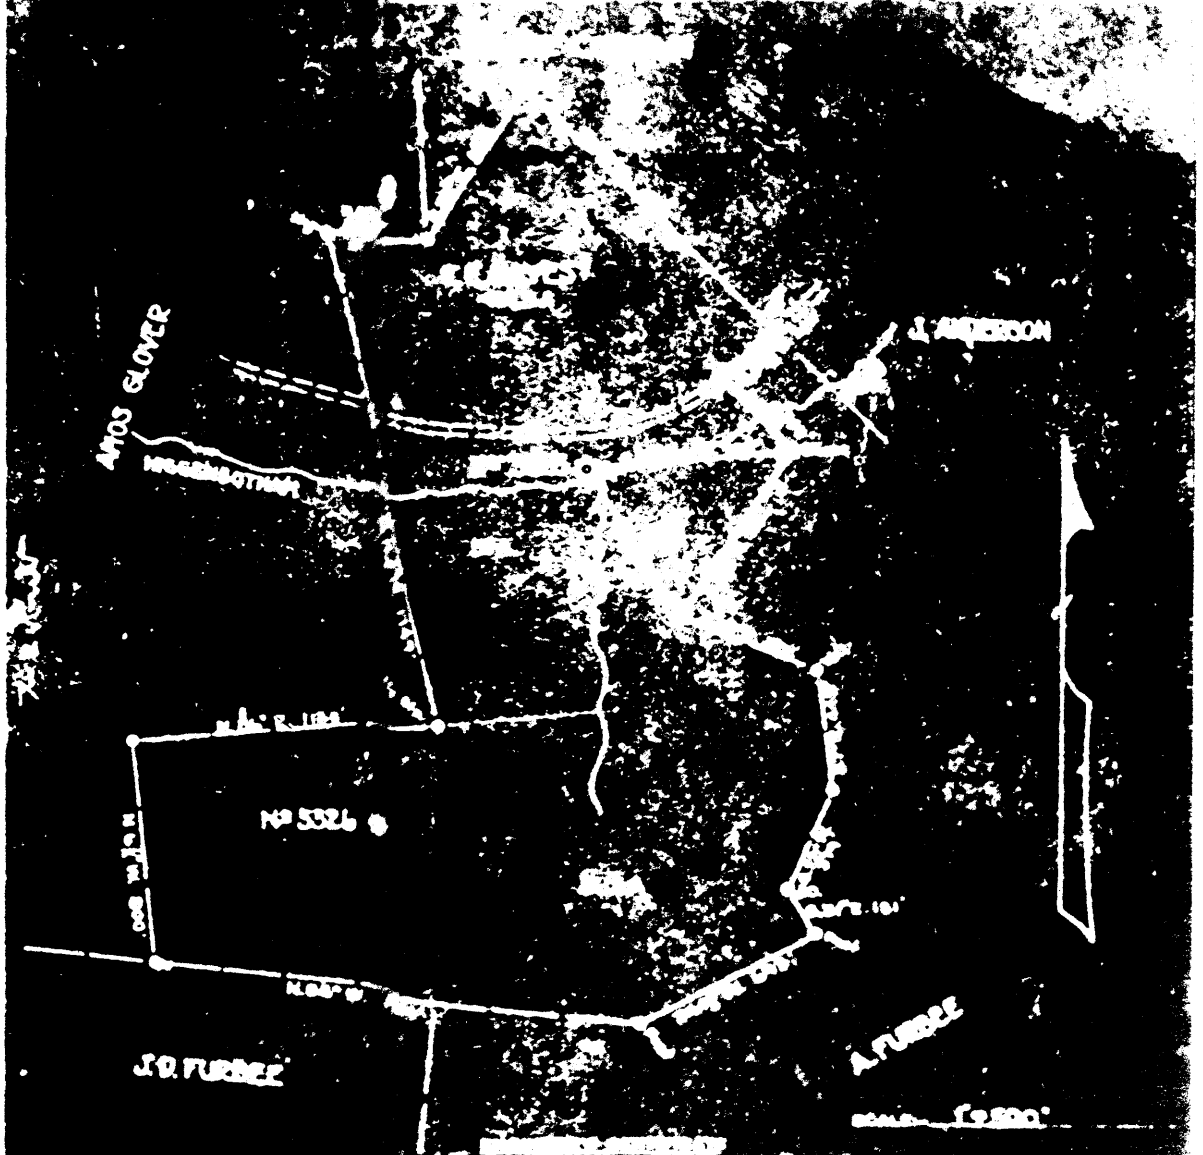

1. The Undersigned, Amos Glover, of the State of \_\_\_\_\_ and County of \_\_\_\_\_, do hereby certify that the above is a true and correct copy of the original map of the land of Amos Glover, as shown by the Co. and \_\_\_\_\_ of the \_\_\_\_\_ \_\_\_\_\_ \_\_\_\_\_

Acknowledged before me, a Notary Public, on this \_\_\_\_\_ day of \_\_\_\_\_, 19\_\_\_\_.

*James P. [Signature]*  
 Notary Public