


Longitude 80° 15'

J. C. King

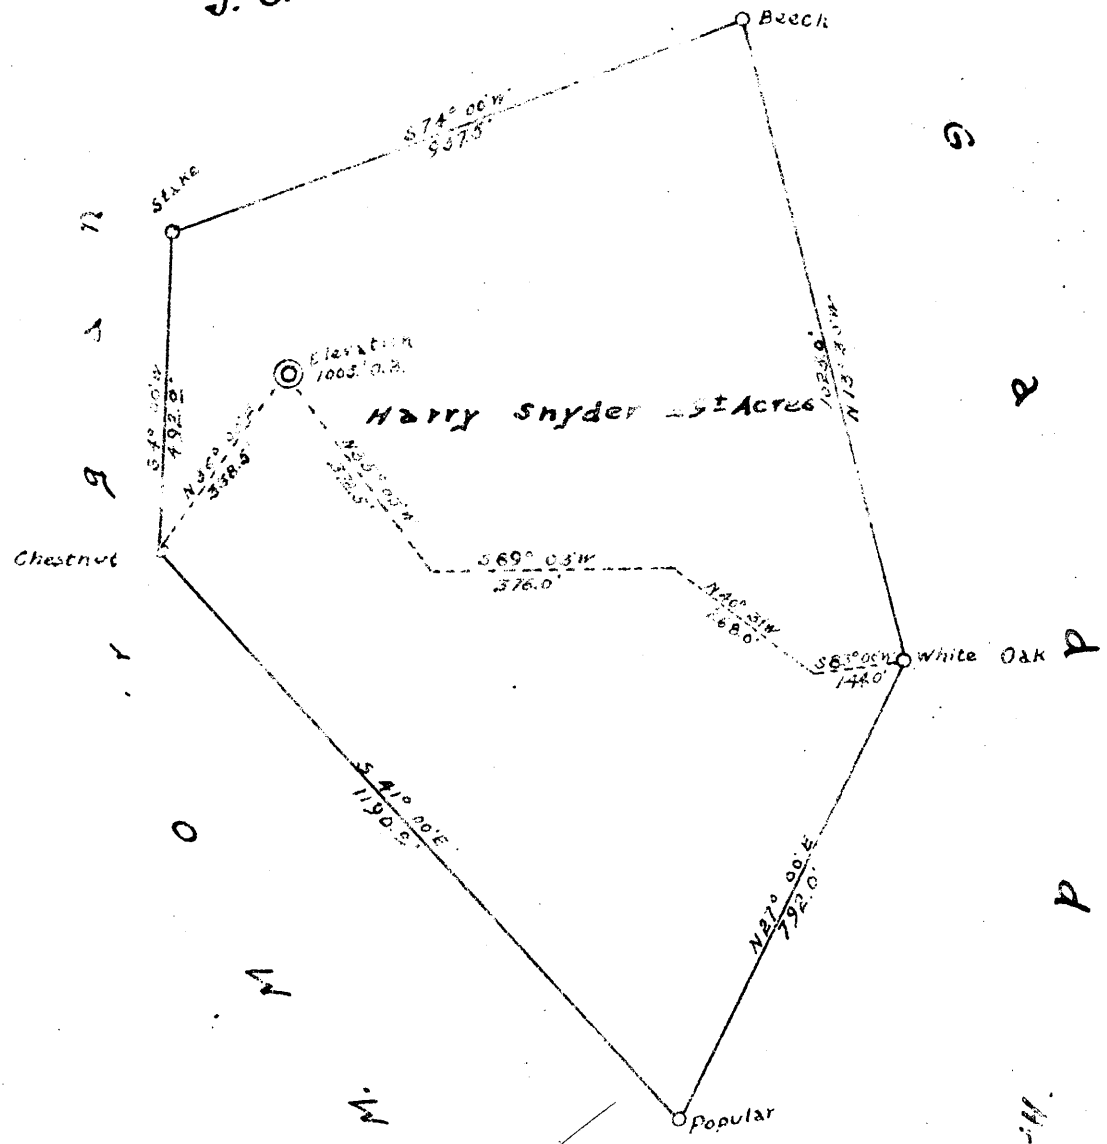

Company RAWE BROTHERS
 Address NEW MARTINSVILLE W. Va.
 Farm HARRY SNYDER
 Tract No. 0 Acres 29 1/2 Lease No. _____
 Well Farm No. 2 Serial No. _____
 Quadrangle NEW MARTINSVILLE
 County WETZEL
 District GREEN
 Engineer George L. Wetzel

File No. _____ Drawing No. _____
 Date MAR 4, 1940 Scale 1" = 300'

STATE OF WEST VIRGINIA
 DEPARTMENT OF MINES
 OIL AND GAS DIVISION
 CHARLESTON

WELL LOCATION MAP
 FILE NO. WET-326 A

+ Denotes location of well on United States
 Topographic Maps, scale 1 to 62,500, lat-
 itude and meridian lines being represented
 by border lines as shown.