

Surface: Mahala Bradley Hrs.
 Gore Bradley
 % P. & W. Va. Gas Co.
 Waynesburg, Pa.
 Coal: State of West Virginia

✓ SEP - 3 1940

0.6 W
 5.52 Q

New Location
 Drill Deeper
 Abandonment

Company South Penn Natural Gas Co.
 Address Parkersburg, W. Va.
 Farm Mahala Bradley
 Tract _____ Acres 32 Lease No. 53685
 Well (Farm) No. 1 Serial No. _____
 Elevation (Spirit Level) 1297.72
 Quadrangle Littleton
 County Wetzel District Clay Church
 Engineer E.C. Tabler
 Engineer's Registration No. _____
 File No. _____ Drawing No. _____
 Date July 27, 1940 Scale 1" = 400'

STATE OF WEST VIRGINIA
 DEPARTMENT OF MINES
 OIL AND GAS DIVISION
 CHARLESTON

WELL LOCATION MAP
 FILE NO. WET-342A

+ Denotes location of well on United States Topographic Maps, scale 1 to 62,500, latitude and longitude lines being represented by border lines as shown.
 - Denotes one inch spaces on border line of original tracing.

STATE OF WEST VIRGINIA
DEPARTMENT OF MINES
OIL AND GAS DIVISION

806

WELL RECORD

Permit No. **342-A**


Oil or Gas Well **GAS-OIL**
(KIND)

Company **South Penn Natural Gas Company,**
Address **Union Trust Bldg., Parkersburg, W. Va.**
Farm **Mahala Bradley** Acres **32**
Location (waters) **Long Drain**
Well No. **1** Elev. **1297.72**
District **Church** County **Wetzel**
The surface of tract is owned in fee by **Mahala Bradley Heirs**
Gore Bradley Address **Waynesburg, Pa.**
o/o Penn. Gas Co.
Mineral rights are owned by **O. J. Bradley et al**
Address **Littleton, W. Va.**
Drilling commenced **April 1, 1905**
Drilling completed **May 26, 1905**
Date shot **June 1, 1905-200ft** Depth of shot **---**
Open Flow **10** /10ths Water in **2"** Inch
/10ths Merc. in **---** Inch
Volume **---** Cu. Ft.
Rock Pressure **70** lbs **---** hrs.
Oil **1** bbls., 1st 24 hrs.
Fresh water **---** feet **---** feet
Salt water **---** feet **---** feet

Casing and Tubing	Used in Drilling	Left in Well	Packers
Size			
16			Kind of Packer ---
13			---
10	263'		Size of ---
8 1/4	2500'	1500'	8 1/2" X 6-5/8"
6 1/2	2270'	?	Depth set ---
5 3/16	2707'	?	1985'
3			Perf. top ---
2	1987'		Perf. bottom ---
Liners Used			Perf. top ---
Cond.	14'		Perf. bottom ---

CASING CEMENTED **---** SIZE **---** No. Ft. **---** Date **---**
COAL WAS ENCOUNTERED AT **924** FEET **36** INCHES
1029 FEET **84** INCHES **---** FEET **---** INCHES
--- FEET **---** INCHES **---** FEET **---** INCHES

Formation	Color	Hard or Soft	Top	Bottom	Oil, Gas or Water	Depth Found	Remarks
Mapletown Coal			924	927			
Pittsburgh Coal			1029	1036			
Little Dunkard Sand			1420	1440			
Big Dunkard Sand			1505	1570			
Gas Sand			1805	1850			
Salt Sand			1950	2004			
2nd Salt Sand			2024	2070	Gas	1979	
Maxon Sand			2105	2145			
Little Lime			2200	2212			
Pencil Cave			2212	2222			
Big Lime			2222	2275			
Big Injun Sand			2275	2514			
Stray Sand			3084	3122			
Gordon Sand			3124	3159			
Fourth Sand			3160	3195	Gas	3180	
Fifth Sand			3240	3245	Show Oil	3243	
Total Depth				3266			

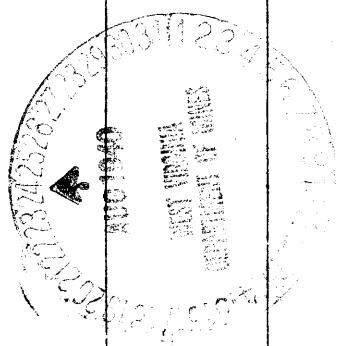

Formation	Color	Hard or Soft	Top	Bottom	Oil, Gas or Water	Depth Found	Remarks

Date **August 23,** 194**0**

APPROVED **SOUTH PENN NATURAL GAS COMPANY**, Owner

By *Etton E. Young* Land Agent