

✓ MAR 24 1941
 1.37 7.4 W
 4.27 4.35

Company Valley Run Oil & Gas Co.
 Address Cameron, W. Va.
 Farm J. K. Long
 Tract _____ Acres 149 Lease No. _____
 Well (Farm) No. 1 Serial No. _____
 Elevation (Spirit Level) 1289 - S. 4
 Quadrangle Littleton
 County Wetzel District Center
 Engineer Gordon W. Sammons
 Engineer's Registration No. 509
 File No. _____ Drawing No. _____
 Date 5-31-1940 Scale 1 in = 500'

STATE OF WEST VIRGINIA
 DEPARTMENT OF MINES
 OIL AND GAS DIVISION
 CHARLESTON

WELL LOCATION MAP
 FILE NO. WET-356A

+ Denotes location of well on United States Topographic Maps, scale 1 to 62,500. latitude and longitude lines being represented by border lines as shown.

- Denotes one inch spaces on border line of original tracing.

STATE OF WEST VIRGINIA
DEPARTMENT OF MINES
OIL AND GAS DIVISION

879

Ab 358-A

WELL RECORD


Oil or Gas Well Oil
(CHECK)

Permit No. _____
Company Valley Run Oil & Gas Company
Address Box 186, Cameron, W. Va.
Farm J. K. Long Acres 149
Location (waters) _____
Well No. 1 Elev. 1289
District Center County Wetzel
The surface of tract is owned in fee by J. K. Long
Address Silver Hill
Mineral rights are owned by J. K. Long
Address Silver Hill
Drilling commenced January 20, 1926
Drilling completed April 22, 1926
Date shot May 28, 1926 Depth of shot 3218-3226
Open Flow /10ths Water in _____ Inch
/10ths Merc. in _____ Inch
Volume _____ Cu. Ft.
Rock Pressure _____ lbs _____ hrs.
Oil 12 bbls. per week _____ bbls., 1st 24 hrs.
Fresh water 2085-7 feet _____ feet
Salt water _____ feet _____ feet

Casing and Tubing	Used in Drilling	Left in Well	Packers
Size			
16.			Kind of Packer
13.			
10.			Size of
8 1/4		1594	
6%		2104	Depth set
5 3/16		2344	
3.			Perf. top
2.		3253' 6"	Perf. bottom
Liners Used			Perf. top
			Perf. bottom

CASING CEMENTED No SIZE _____ No. Ft. _____ Date _____
COAL WAS ENCOUNTERED AT 893 FEET _____ INCHES
1090 FEET _____ INCHES 1192 FEET _____ INCHES
_____ FEET _____ INCHES _____ FEET _____ INCHES

Formation	Color	Hard or Soft	Top	Bottom	Oil, Gas or Water	Depth Found	Remarks
			14	893			
Waynesburg Coal	Black	Soft	893	898			
Mapletown Coal	Black	Soft	1090	1095			
Pittsburgh Coal	Black	Soft	1192	1198			
L. Dunkard	Light	Hard	1575	1638			
B. Dunbard	Light	Hard	1672	1750			
Gas Sand	Light	Hard	1840	1894			
1st. Salt	Light	Hard	1935	1963			
2nd Salt	Light	Hard	2075	2120	Water	2085-7	Hole of Water
Sand	Light	Hard	2228	2237			
Maxon	Light	Hard	2289	2300			
L. Lime	White	Hard	2315	2327			
Pencil Cave	Dark	Soft	2327	2331			
B. Lime	White	Hard	2331	2379			
Injun	Brown	Hard	2379	2620			
Gordon Stray	Gray	Medium	3213	3218	Oil	3218-3226	
Gordon	Light	Hard	3220	3239			
Total Depth			-----				3240 ft.

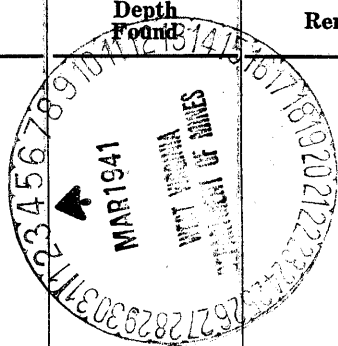

Formation	Color	Hard or Soft	Top	Bottom	Oil, Gas or Water	Depth Found	Remarks

Date....., 194.....

APPROVED....., Owner

By.....

(Title)