

Latitude 39 45'

Longitude 80 30'


J. E. Williams

Marshall Co. Line
Wetzel Co.

Wm. Peterson

M. Aber 199

W. G. Sidwell - Former owner
J. E. Williams - Present
42 Acres
Coal not operated

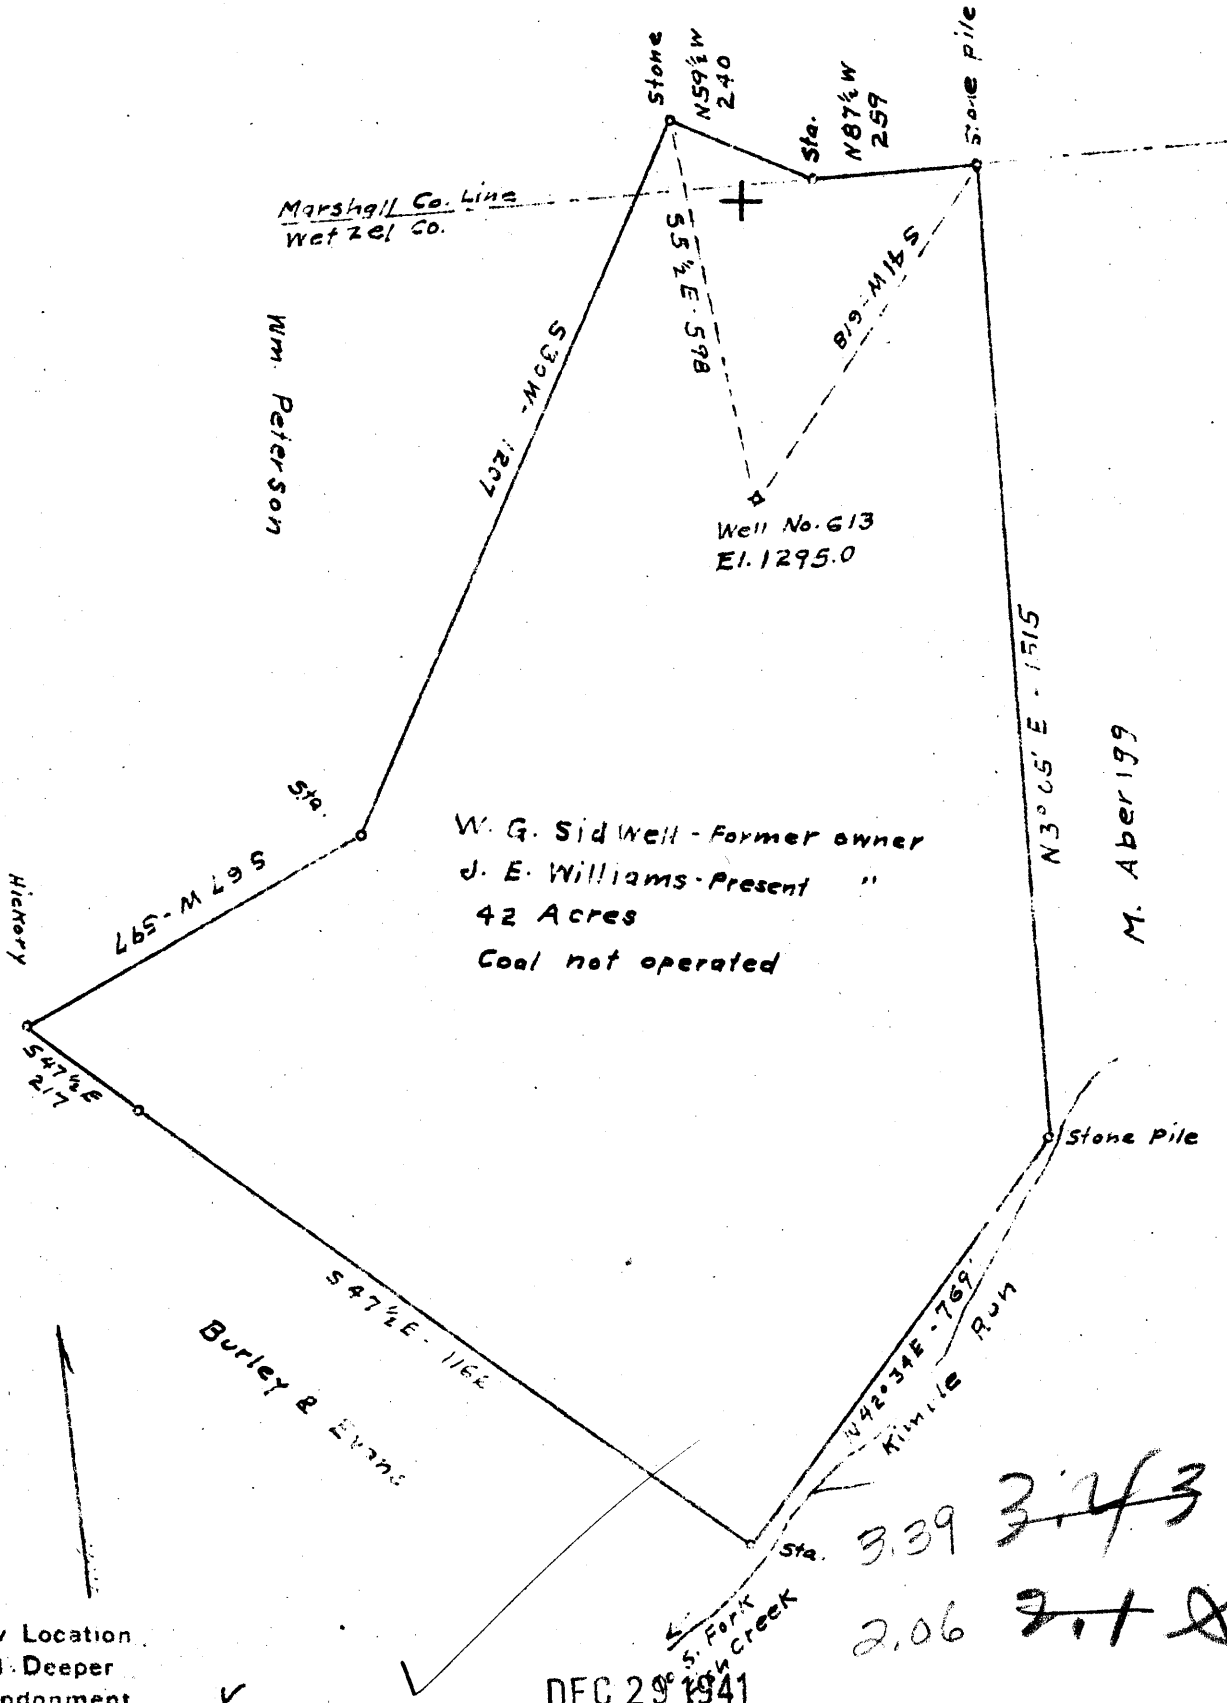

New Location
Drill Deeper
Abandonment

DEC 29 1941

3.39 3.43 W
2.06 2.11

Company The Interstate Pipe & Supply Co.
 Address P.O. Box 611 Marietta Ohio
 Farm W. G. Sidwell
 Tract _____ Acres 42 Lease No. _____
 Co. No. 613
 Well (Farm) No. one Serial No. _____
 Elevation (Spirit Level) 1295.0
 Quadrangle Littleton
 County Wetzel District Center
 Engineer C. O. Newing
 Engineer's Registration No. 811
 File No. _____ Drawing No. _____
 Date 20 Dec 1941 Scale 1" = 300'

STATE OF WEST VIRGINIA
DEPARTMENT OF MINES
OIL AND GAS DIVISION
CHARLESTON

WELL LOCATION MAP
FILE NO. WET-409A

+ Denotes location of well on United States Topographic Maps, scale 1 to 62,500, latitude and longitude lines being represented by border lines as shown.
- Denotes one inch spaces on border line of original tracing.



STATE OF WEST VIRGINIA
DEPARTMENT OF MINES
OIL AND GAS DIVISION

874

WELL RECORD

Permit No. 459-A


Oil or Gas Well Oil
(KIND)

Company The Interstate Pipe & Supply Company
Address Marietta, Ohio
Farm W. G. Sidwell Acres 42
Location (waters).....
Well No. 613 Elev.....
District Clay County Wetzel
The surface of tract is owned in fee by J. E. Williams
Address.....
Mineral rights are owned by J. E. Williams
Address.....
Drilling commenced October 12, 1922
Drilling completed December 7, 1922
Date shot..... Depth of shot 3184-3192
Open Flow /10ths Water in..... Inch
/10ths Merc. in..... Inch
Volume..... Cu. Ft.
Rock Pressure..... lbs..... hrs.
Oil..... bbls., 1st 24 hrs.
Fresh water..... feet..... feet
Salt water..... feet..... feet

Casing and Tubing	Used in Drilling	Left in Well	Packers
Size			Kind of Packer.....
16			
13			
10	267		Size of.....
8 1/4	1544	1544	
6 5/8	2345	2345	Depth set.....
5 3/16			
3			Perf. top.....
2		163 Jts	Perf. bottom.....
Liners Used			Perf. top.....
			Perf. bottom.....

CASING CEMENTED..... SIZE..... No. Ft..... Date.....
COAL WAS ENCOUNTERED AT 1013 FEET 60 INCHES
1117 FEET 84 INCHES FEET INCHES
FEET INCHES FEET INCHES

Formation	Color	Hard or Soft	Top	Bottom	Oil, Gas or Water	Depth Found	Remarks
Clay			0	15			
Mapletown Coal			1013	1018			
Pittsburgh Coal			1117	1124			
Red Rock			1305	1350			
Big Dunkard			1632	1675			
Salt Sand			1995	2070	Show Gas	2018	
Sand			2105	2145			
Big Lime			2276	2345			
Big Injun			2345	2595	Show Gas	2440	
Slate & Shells			2755	2936			
Sand			2936	2950			
Slate & Shells			2950	3058			
Pink Rock			3058	3070			
Sand			3140	3146			
Shells & Slate			3146	3181			
Gordon Sand			3181	3199			
Total Depth				3199	Oil Top	3195	

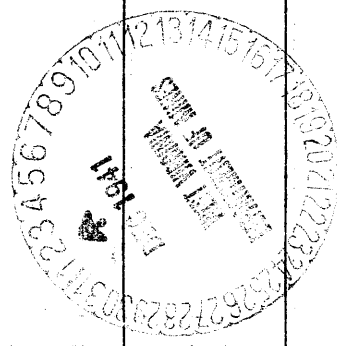

Formation	Color	Hard or Soft	Top	Bottom	Oil, Gas or Water	Depth Found	Remarks

Date November 29, 1941

APPROVED The Interstate Pipe & Supply Co., Owner

By H. H. Beren
(Title) 9.

