

New Location
 Drill Deeper
 Abandonment

JUN 27 1943

3.58 ~~3.65~~ W
 2.62 ~~2.67~~ X

Company CARNEGIE NATURAL GAS
 Address PITTSBURGH, PENNA.
 Farm JAMES MCGUFFIE
 Tract ONE Acres 26 Lease No E-10865-73
 Well (Farm) No. 1 Serial No. 1115
 Elevation (Spirit Level) 1328'
 Quadrangle LITTLETON N.E.
 County WETZEL District CLAY
 Engineer D.T. BRITTON
 Engineer's Registration No. _____
 File No. _____ Drawing No. _____
 Date 4-27-1943 Scale 1" = 400'

STATE OF WEST VIRGINIA
 DEPARTMENT OF MINES
 OIL AND GAS DIVISION
 CHARLESTON

WELL LOCATION MAP
 FILE NO. WET-447-A

+ Denotes location of well on United States Topographic Maps, scale 1 to 62,500, latitude and longitude lines being represented by border lines as shown.

- Denotes one inch spaces on border line of original tracing.

WEST VIRGINIA DEPARTMENT OF MINES
OIL AND GAS DIVISION

900

WELL RECORD

Permit No. 447-A

Oil or Gas Well OIL
(Kind)


WELL TO BE ABANDONED

Company CARNEGIE NATURAL GAS COMPANY	Casing and Tubing	Used in Drilling	Left in Well	Packers
Address 1015 FRICK BLDG., PITTSBURGH, PA.	Size			
Farm JAMES McGUFFIE Acres 26	16			Kind of Packer
Location (waters)	13			
Well No. 1115 Elev. 1328'	10		304'	Size of
District CLAY County WETZEL	8 1/4		1571'	Depth set
The surface of tract is owned in fee by Mrs. ETTA McGUFFIE	6 5/8		2358'	Perf. top
Address Deep Valley, Pa.	5 3/16			Perf. bottom
Mineral rights are owned by SEE BELOW	3			Perf. top
Address	2		3275'	Perf. bottom
Drilling commenced 8-8-22 D.D. 11-16-23	Liners Used			
Drilling completed 9-11-22 D.D. 1-15-24				
Date shot 3-28-24 Depth of shot 3258-3266				
Open Flow 2 /10ths Water in 8-1/4 Inch				
/10ths Merc. in				
Volume 994,000 Cu. Ft.	CASING CEMENTED	SIZE	No. FT.	Date
Rock Pressure lbs hrs.				
Oil 15 bbls., 1st 24 hrs.	COAL WAS ENCOUNTERED AT 1092 FEET			
Fresh water feet	1192 FEET			
Salt water feet				

Formation	Color	Hard or Soft	Top	Bottom	Oil Gas or Water	Depth Found	Remarks
Mapletown Coal			1092'	1098'			
Pittsburgh Coal			1192'	1199'			
Little Dunkard			1600'	1616'			
Big Dunkard			1670'	1720'			
Gas Sand			1865'	1900'			
1st Salt Sand			1939'		Gas	1954-1962'	
TOTAL DEPTH 9-11-22				1972'			
1st Salt Sand				1982'			
2nd Salt Sand			2020'	2120'			
Marion Sand			2140'	2255'			
Little Lime			2338'	2348'			
Pencil Cave			2348'	2356'			
Big Lime			2356'	2422'			
Big Injun			2422'	2667'	Show of Gas	2505'	
Lime			3164'	3170'			Hole reduced at 3165'
Gordon Sand			3250'		Show of Oil	3260'	
TOTAL DEPTH 1-15-24				3275'	Oil	3263-3264'	

OWNERS OF MINERAL RIGHTS:

Mrs. Etta McGuffie, Deep Valley, Pa.
Thomas Little Estate, Littleton, W. Va.
Bertha Maley, Warwood, W. Va.

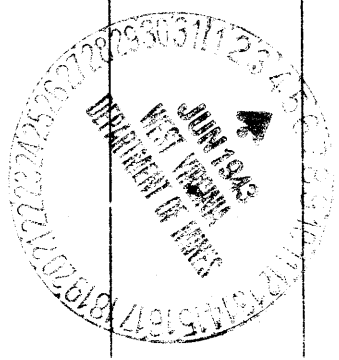

Formation	Color	Hard or Soft	Top	Bottom	Oil, Gas or Water	Depth Found	Remarks

Date JUNE 4, 1943.

APPROVED CARNEGIE NATURAL GAS COMPANY, Owner

By B. H. Archer
(Title) Land Agent.