
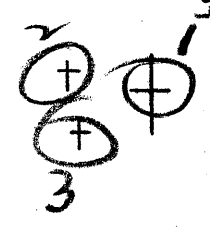


Latitude 39 45

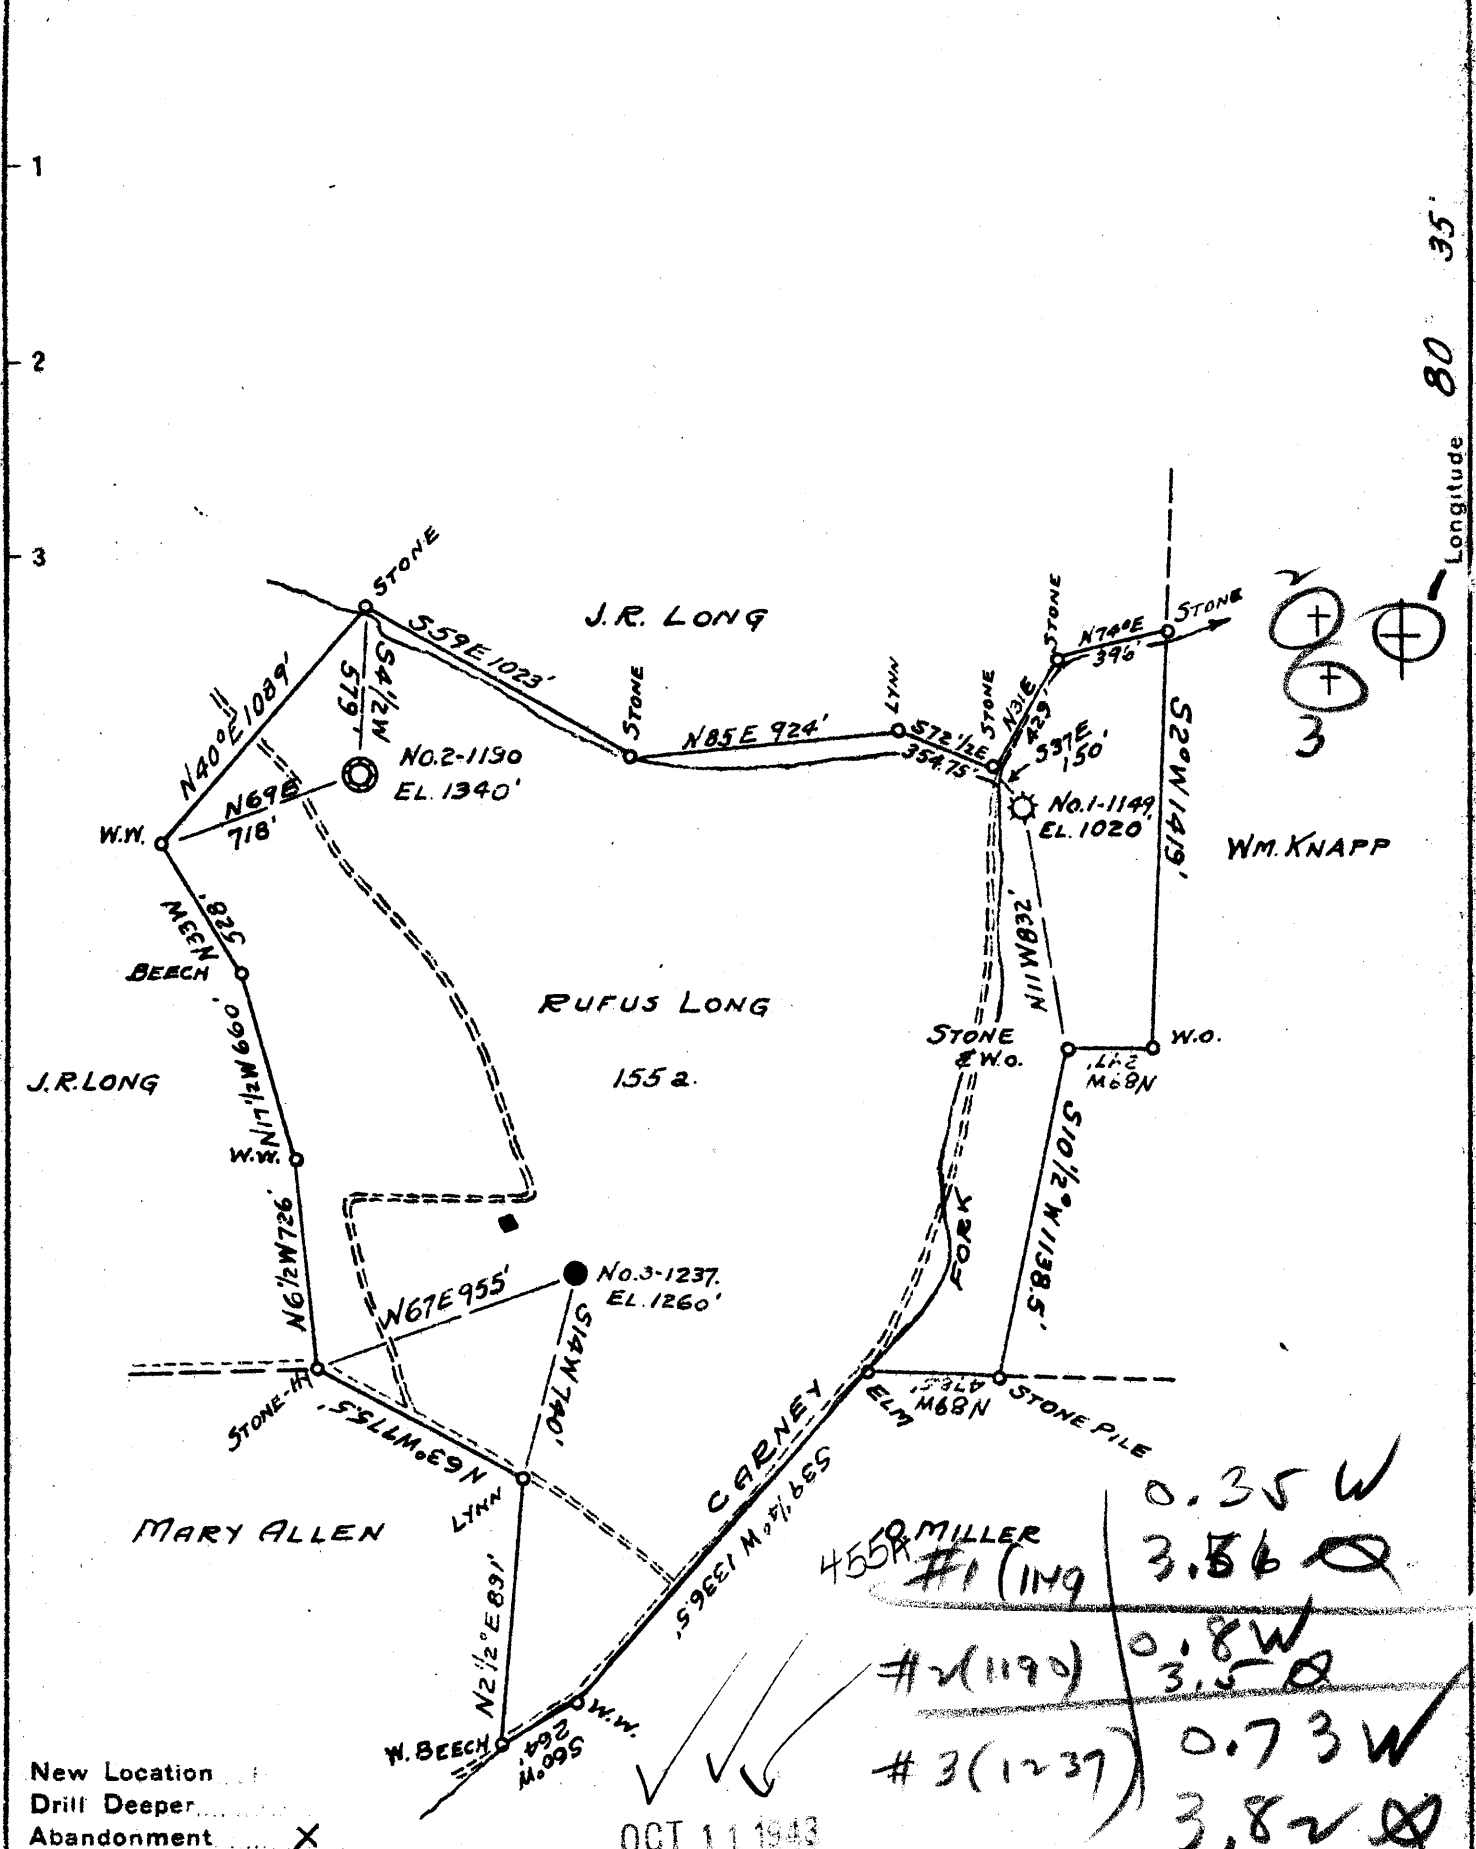

New Location
 Drill Deeper
 Abandonment X

OCT 11 1943

455R MILLER
 #1 (1149) 0.35 W
 3.56 Q
 #2 (1190) 0.8 W
 3.5 Q
 #3 (1237) 0.73 W
 3.82 Q

Company CARNEGIE NATURAL GAS Co.
 Address PITTSBURGH, PA.
 Farm RUFUS LONG
 Tract _____ Acres 155 Lease No. E-10968-71
 Well (Farm) No. 1 Serial No. 1149
 Elevation (Spirit Level) 1020'
 Quadrangle LITTLETON N.E.
 County WETZEL District CENTER
 Engineer D.T. BRITTON
 Engineer's Registration No. _____
 File No. _____ Drawing No. _____
 Date 5-31-39 Scale 1"=660'

STATE OF WEST VIRGINIA
 DEPARTMENT OF MINES
 OIL AND GAS DIVISION
 CHARLESTON

WELL LOCATION MAP
 FILE NO. WET-455-A

+ Denotes location of well on United States Topographic Maps, scale 1 to 62,500, latitude and longitude lines being represented by border lines as shown.
 - Denotes one inch spaces on border line of original tracing.

NL

RUFUS LONG NO. 1 (1149) - CARNEGIE N.G.C. - WET-455-A