


Latitude $37^{\circ} 35'$

Longitude $80^{\circ} 45'$

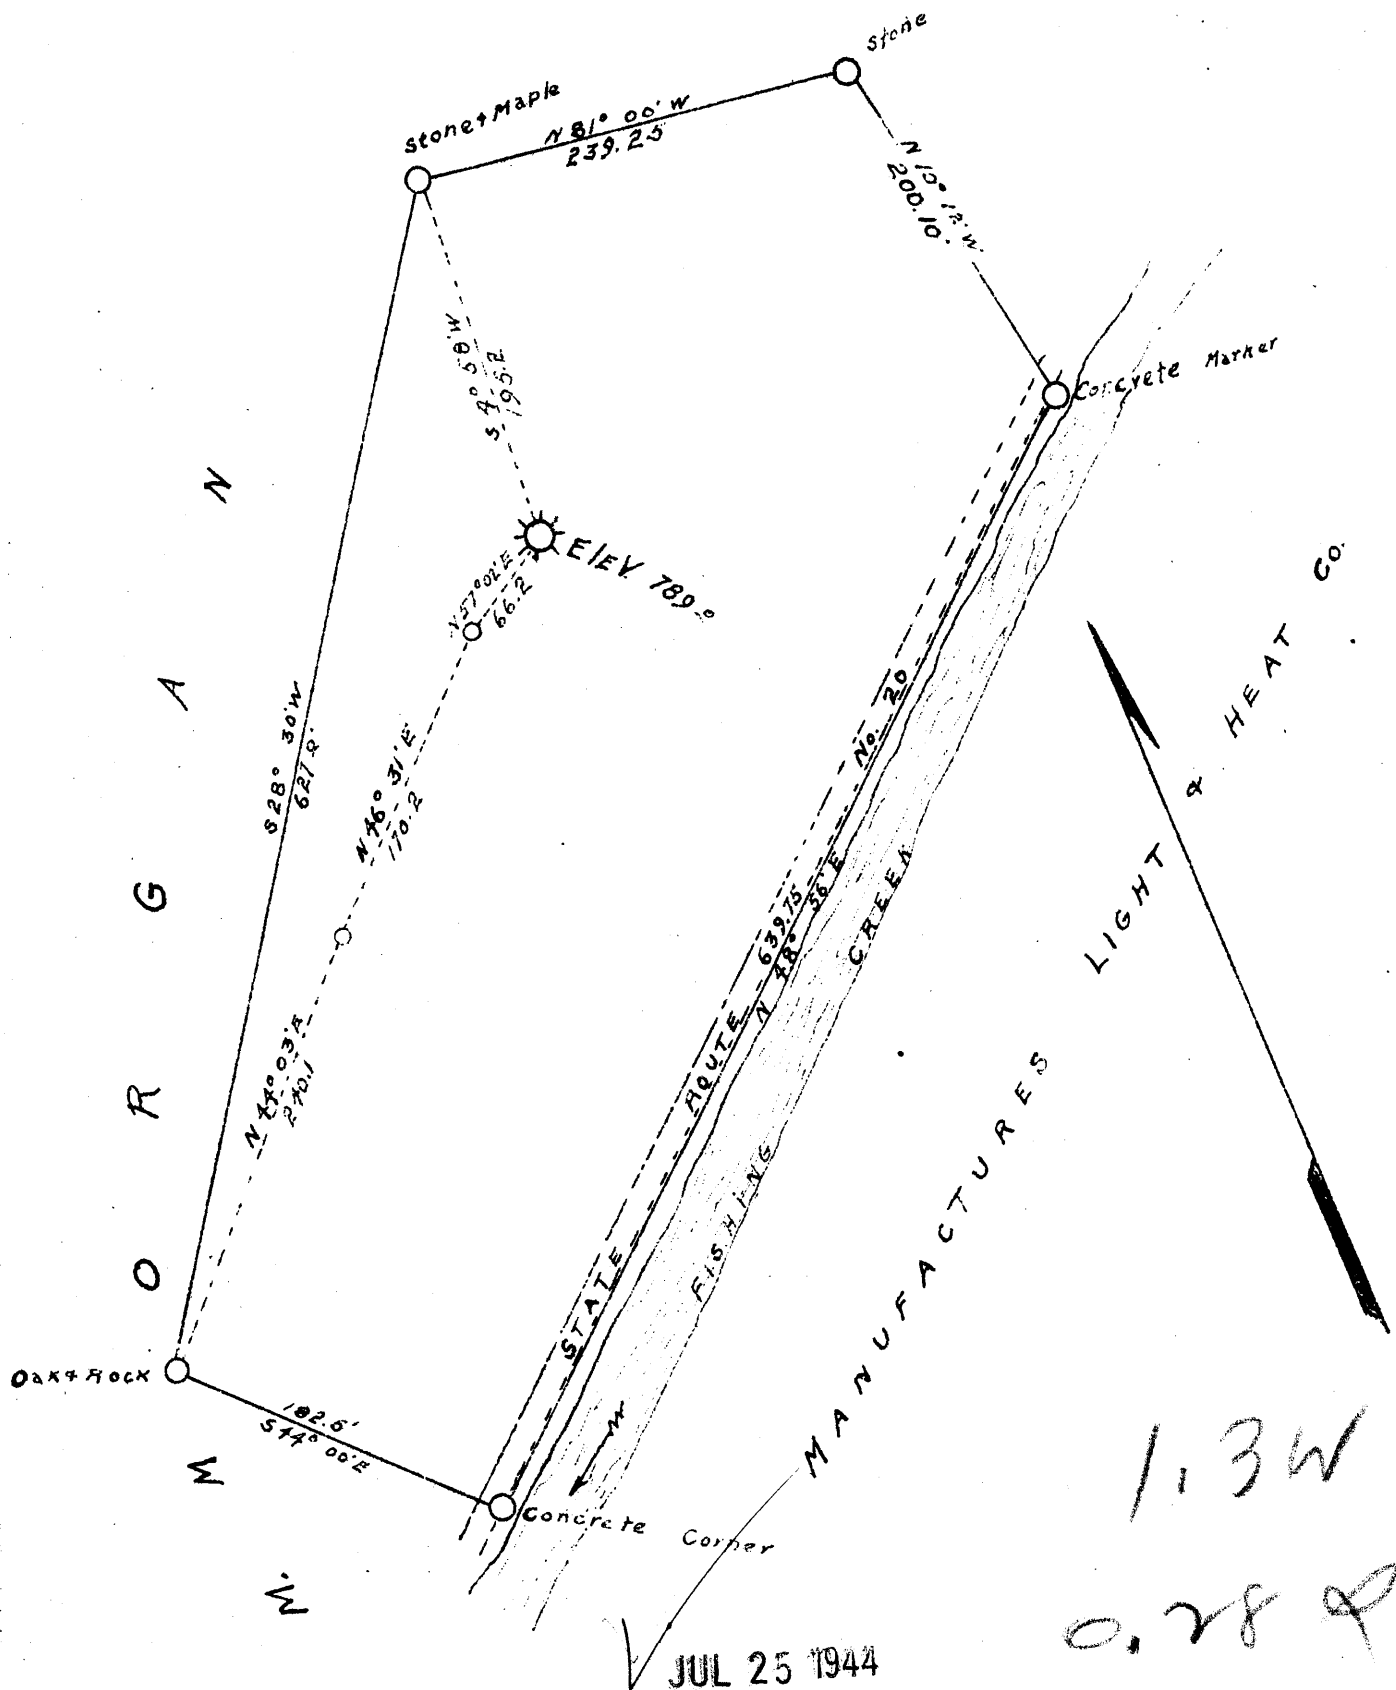


Company RAWE BROS.
 Address NEW MARTINSVILLE WVA
 Farm J. E. SNIDER
 Tract 1 Acres 5.37 Lease No. R
 Well Farm No. 1 Serial No. _____
 Quadrangle NEW MARTINSVILLE
 County WETZEL
 District GREEN
 Engineer GEO. L. MCINTIRE
 Engineer's Registration No. _____
 File No. _____ Drawing No. _____
 Date 2/9/39 Scale 1"=100'

STATE OF WEST VIRGINIA
 DEPARTMENT OF MINES
 OIL AND GAS DIVISION
 CHARLESTON

WELL LOCATION MAP
 FILE NO. WET- 477-A

† Denotes location of well on United States Topographic Maps, scale 1 to 62,500, latitude and longitude lines being represented by border lines as shown

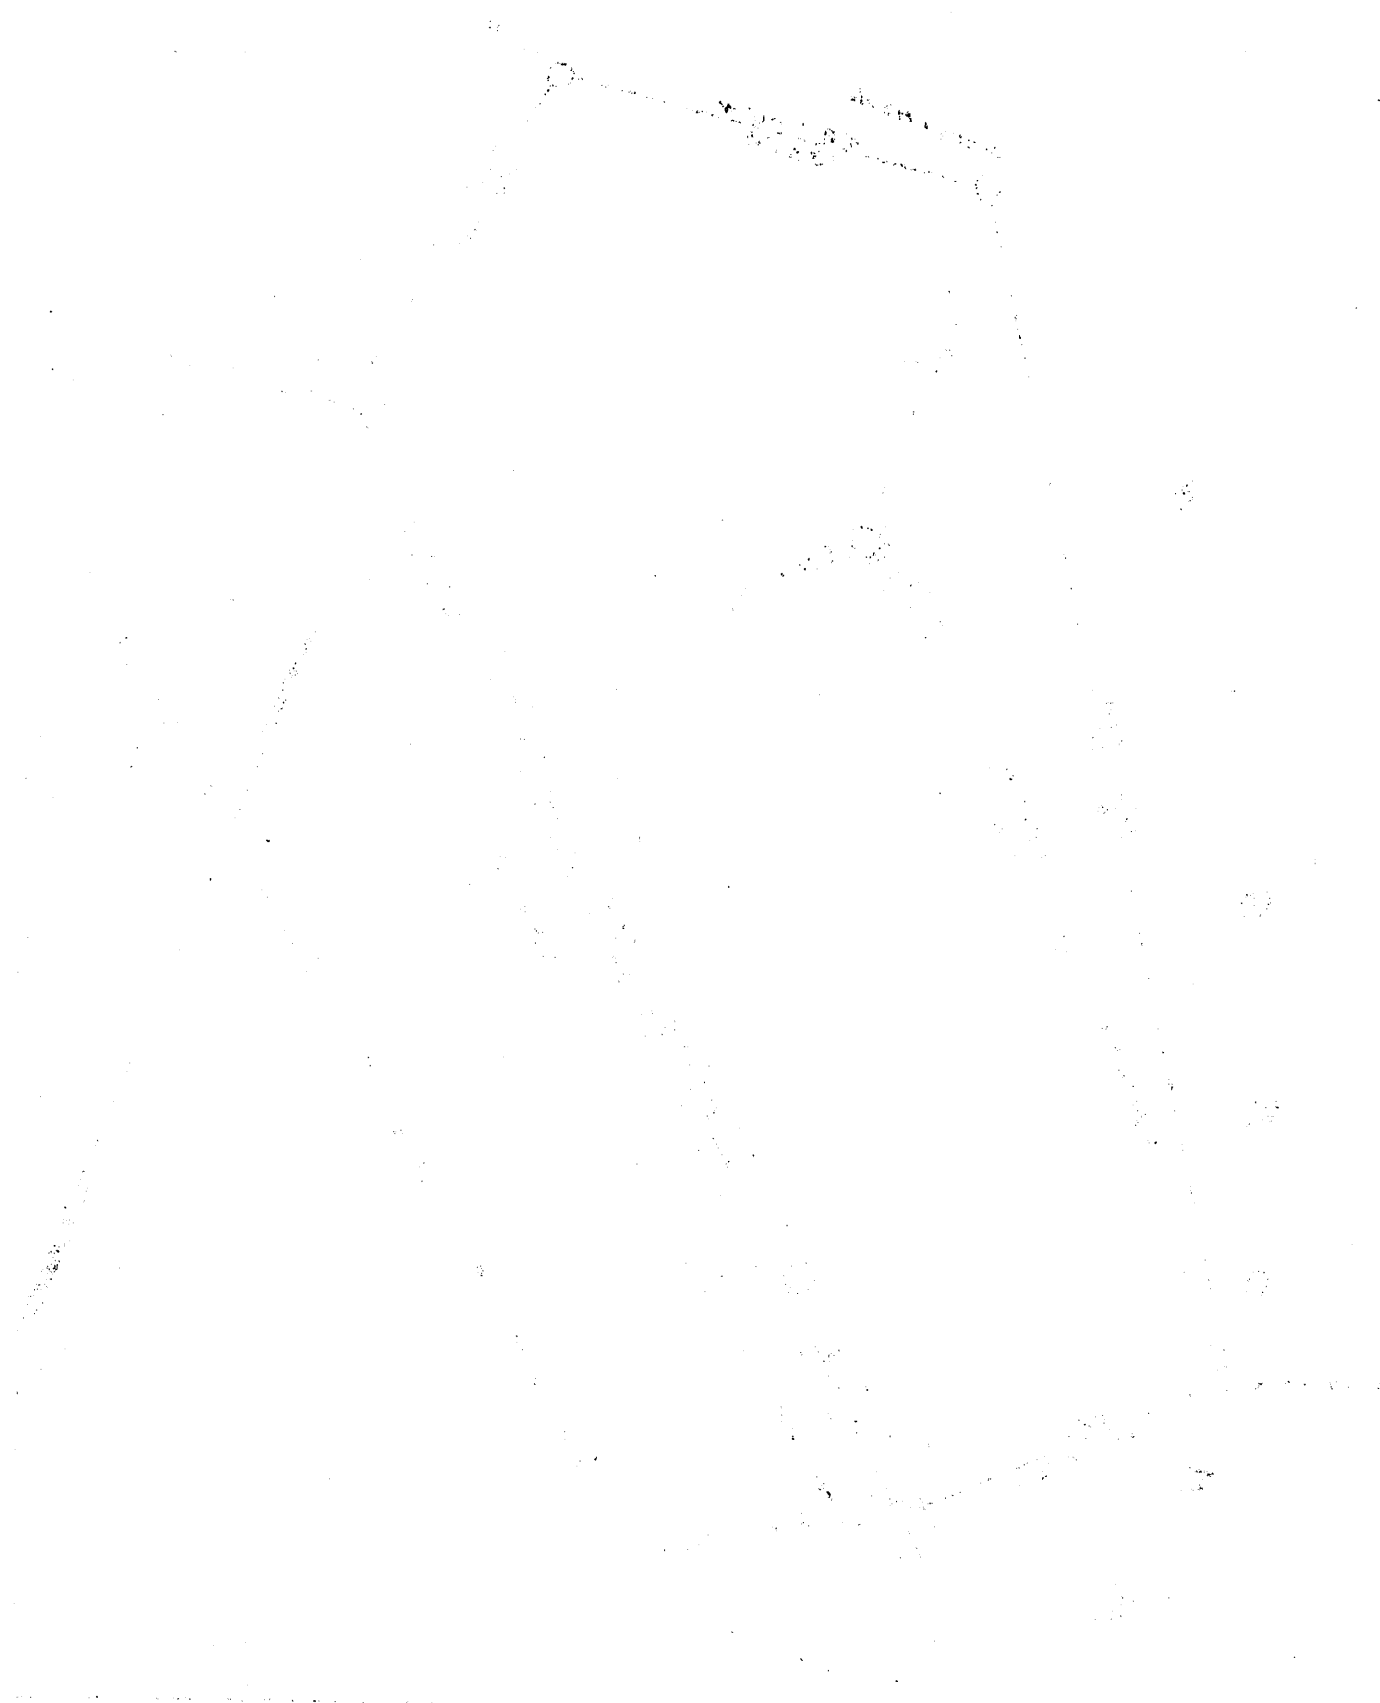

The first part of the text is a list of names or locations, possibly related to the map above. The text is very faint and difficult to read, but appears to be organized in a list-like format.

The second part of the text is a list of names or locations, similar to the first part. It also appears to be a list of items, possibly related to the map or a separate survey. The text is very faint and difficult to read.



COPY

939

STATE OF WEST VIRGINIA
DEPARTMENT OF MINES
OIL AND GAS DIVISION

WELL RECORD

Permit No. **WET-477**

Oil or Gas Well **Gas**
(KIND)

Company **Rawe Brothers**
 Address **New Martinsville, W. Va.**
 Farm **J. E. Snider** Acres **5-37**
 Location (waters) _____
 Well No. **1** Elev. **789**
 District **Green** County **Wetzel**
 The surface of tract is owned in fee by **J. E. Snider**
 Address **Porter Falls, W. Va.**
 Mineral rights are owned by **Same**
 Address _____
 Drilling commenced **April 5, 1928**
 Drilling completed _____
 Date Shot _____ From _____ To _____
 With _____
 Open Flow _____ /10ths Water in _____ Inch
 _____ /10ths Merc. in _____ Inch
 Volume _____ Cu. Ft.
 Rock Pressure _____ lbs. _____ hrs.
 Oil _____ bbls., 1st 24 hrs.
 Fresh water **105** feet _____ feet
 Salt water _____ feet _____ feet

Casing and Tubing	Used in Drilling	Left in Well	Packers
Size			
16			Kind of Packer _____
13			
10	335		Size of _____
8 1/4	1165		
6 5/8	1723		Depth set _____
5 3/16			
3			Perf. top _____
2			Perf. bottom _____
Liners Used			Perf. top _____
			Perf. bottom _____

CASING CEMENTED _____ SIZE _____ No. Ft. _____ Date _____
No coal
 COAL WAS ENCOUNTERED AT _____ FEET _____ INCHES
 _____ FEET _____ INCHES FEET _____ INCHES
 _____ FEET _____ INCHES FEET _____ INCHES

Formation	Color	Hard or Soft	Top	Bottom	Oil, Gas or Water	Depth Found	Remarks
Clay			0	10			
R R			10	35			
Sand			35	110			
Slate			110	200			
R R			200	240			
Slate			240	260			
R R			260	270			
Slate			270	285			
R R			285	310			
Slate			310	335			
Lime			335	345			
Sand			345	416			
R R			416	430			
Slate			455	475			
Sand			475	525			
Slate			525	565			
Lime			565	590			
Slate			590	618			
Sand			618	654			
Slate			654	703			
Sand			703	720			
Slate			720	738			
R R			738	758			
Lime			758	842			
Slate			842	872			
Lime			872	933			
Slate			933	960			
Lime			960	985			
Slate			985	1155			
Lime			1155	1188			
Slate			1188	1210			
Lime			1210	1250			
Slate			1250	1348			
Lime			1348	1405			
Slate			1405	1620			
Lime			1620	1630			
Slate			1630	1646			
Lime			1646	1656			
Slate			1656	1682			

Formation	Color	Hard or Soft	Top	Bottom	Oil, Gas or Water	Depth Found	Remarks
Little Lime			1682	1690			
Pencil Cave			1690	1697			
Big Lime			1697	1770			
Big Injun Sand			1770		Gas	1772-1780	
Total Depth			1892				

Date July 8, 1944

APPROVED RAWE BROTHERS, Owner

By T. C. Rawe, Partner
(Title)

