

Surface: Mrs. Ola Coen.  
 R.F.O. #1, Smithfield, Wetzel Co. W.Va.

Coal: Consolidation Coal Co.  
 Watson Building, Fairmont, W.Va.

3.03 ~~3.09~~ W  
 2.52 ~~2.55~~ ~~W~~ ~~D~~  
 JUN 21 1946  
 400' map # 2752 N 7. E 4

New Location   
 Drill Deeper   
 Abandonment

Company Raad Supply Co.  
 Address Salem, W.Va.  
 Farm S.B. McDougal  
 Tract \_\_\_\_\_ Acres 16 1/2 a Lease No. \_\_\_\_\_  
 Well (Farm) No. 1 Serial No. \_\_\_\_\_  
 Elevation (Spirit Level) Floor - 1346.84  
 Ground - 1345.24  
 Quadrangle Littleton  
 County Wetzel District Grant  
 Engineer E.C. Tabler  
 Engineer's Registration No. \_\_\_\_\_  
 File No. \_\_\_\_\_ Drawing No. \_\_\_\_\_  
 Date Aug. 14<sup>th</sup> 1945 Scale 1" = 400'

STATE OF WEST VIRGINIA  
 DEPARTMENT OF MINES  
 OIL AND GAS DIVISION  
 CHARLESTON

WELL LOCATION MAP  
 FILE NO. WET-534-A

+ Denotes location of well on United States Topographic Maps, scale 1 to 62,500, latitude and longitude lines being represented by border lines as shown.  
 - Denotes one inch spaces on border line of original tracing.

S.B. McDougal No. 1 - RAAD SUPPLY Co., - WET-534-A



STATE OF WEST VIRGINIA  
DEPARTMENT OF MINES  
OIL AND GAS DIVISION

995

AP 34-A

WELL RECORD


Permit No. \_\_\_\_\_ Oil or Gas Well \_\_\_\_\_ (KIND)

Company Raad Supply Company  
 Address 184 E. Main St., Salem, W. Va.  
 Farm S. B. McDougal Acres 16 1/2  
 Location (waters) \_\_\_\_\_  
 Well No. 1 Elev. 1345.24  
 District Grant County Wetzel  
 The surface of tract is owned in fee by Mrs. Ola Coen  
R. F. D. #1 Address Smithfield, W. Va.  
 Mineral rights are owned by Consolidation Coal Co.  
 Address Watson Building  
Fairmont, W. Va.  
 Drilling commenced \_\_\_\_\_  
 Drilling completed 11/20/04  
 Date Shot 12/5/04 From Injun To \_\_\_\_\_  
 With No date # \_\_\_\_\_  
 Open Flow 7/5/12 10ths Water in \_\_\_\_\_ Inch  
8/3/12 /10ths Merc. in 2474 - 2484 Inch  
 Volume \_\_\_\_\_ Cu. Ft.  
 Rock Pressure \_\_\_\_\_ lbs. \_\_\_\_\_ hrs.  
 Oil \_\_\_\_\_ bbls., 1st 24 hrs.  
 Fresh water \_\_\_\_\_ feet \_\_\_\_\_ feet  
 Salt water \_\_\_\_\_ feet \_\_\_\_\_ feet

Casing and Tubing	Used in Drilling	Left in Well	Packers
Size			Kind of Packer
16			
13			<b>Hpok Wall</b>
10	<b>550</b>	<b>None</b>	Size of
8 1/4	<b>1458'</b>	<b>1458'</b>	<b>5-3/16x6-5/8"</b>
6 5/8	<b>2100'</b>	<b>2100'</b>	Depth set <b>2384'</b>
5 3/16	<b>2350'</b>	<b>2350'</b>	<b>April, 1944.</b>
3			Perf. top
2	<b>2489'</b>	<b>2489'</b>	Perf. bottom
Liners Used			Perf. top
			Perf. bottom

CASING CEMENTED No SIZE \_\_\_\_\_ No. Ft. \_\_\_\_\_ Date \_\_\_\_\_  
 COAL WAS ENCOUNTERED AT 1091 FEET \_\_\_\_\_ INCHES  
 \_\_\_\_\_ FEET \_\_\_\_\_ INCHES FEET \_\_\_\_\_ INCHES  
 \_\_\_\_\_ FEET \_\_\_\_\_ INCHES FEET \_\_\_\_\_ INCHES

Formation	Color	Hard or Soft	Top	Bottom	Oil, Gas or Water	Depth Found	Remarks
<u>Pittsburgh Coal</u>			<u>1091</u>				
<u>Big Injun</u>			<u>2386</u>				
<u>Big Injun</u>			<u>2481</u>		<u>Oil</u>		
<u>Big Injun</u>			<u>2474</u>		<u>Gas</u>		
<u>Total Depth</u>			<u>2489</u>				

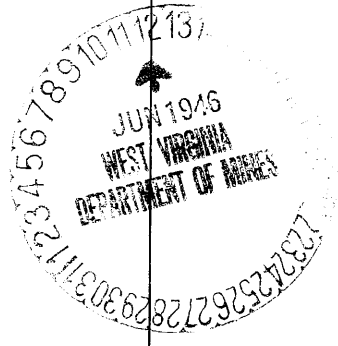

Formation	Color	Hard or Soft	Top	Bottom	Oil, Gas or Water	Depth Found	Remarks

Date June 11, 1946

APPROVED Road Supply Co, Owner

By J. M. Rood-meyer  
(Title)

