


LAT. 39° 40'

Scale 1" = 800 Feet

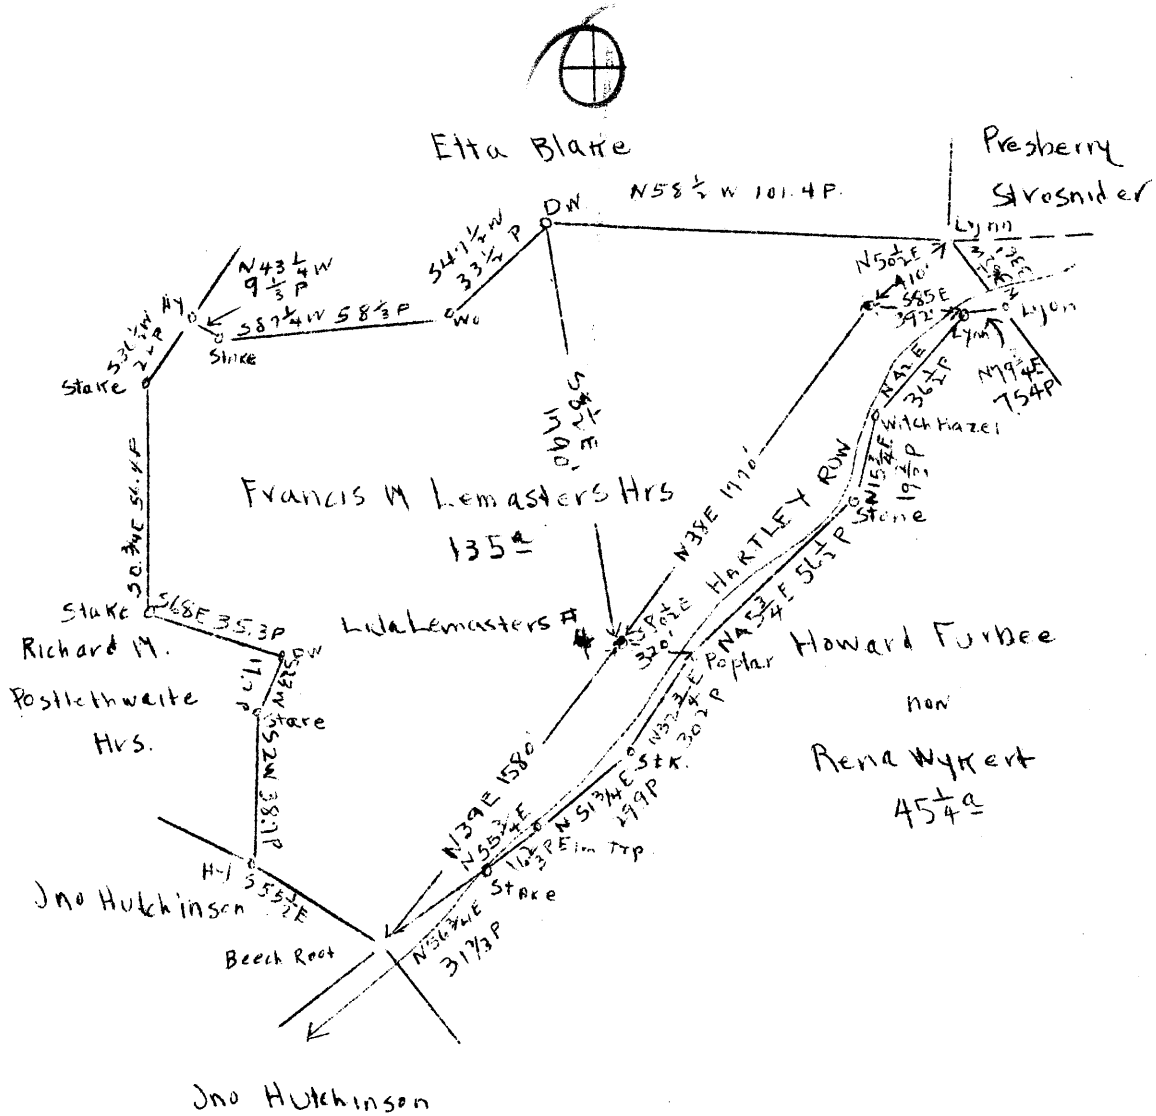

SURFACE: F.M. LEMASTERS HRS.
 ADDRESS: MRS. LIDA LEMASTERS, WILEYVILLE, WETZEL CO., W. VA.

COAL: SOLD FROM HELEN, V.S. & V.A. GILMORE TO STATE OF W. VA. FOR TAXES 1931 - 1932
 TITLE AT PRESENT IN STATE OF WEST VIRGINIA

ABANDONMENT X

✓ N14 W 1-2
 AUG 20 1946

3.64 3.7 W
 1.6

COMPANY INTERSTATE PIPE & SUPPLY CO.
 ADDRESS MARIETTA, OHIO
 FARM LIDA LEMASTERS
 TRACT ACRES 127A LEASE NO.
 WELL (FARM) NO. 4 SERIAL NO.
 ELEVATION FLOOR 1184.80
 (SPIRIT LEVEL) GROUND 1183.00
 QUADRANGLE LITTLETON
 COUNTY WETZEL DIST. CENTER
 ENGINEER E. C. TABLER
 ENGINEER'S REG. NO.
 FILE NO. DRAWING NO.
 DATE APR. 25TH, 1946 SCALE 1" = 800'

STATE OF WEST VIRGINIA
 DEPARTMENT OF MINES
 OIL AND GAS DIVISION
 CHARLESTON
 WELL LOCATION MAP

FILE NO. WET - 537-A

+ DENOTES LOCATION OF WELL ON U.S. TOPOGRAPHIC MAPS, SCALE 1 TO 62,500 LATITUDE AND LONGITUDE LINES BEING REPRESENTED BY BORDER LINES AS SHOWN
 - DENOTES ONE INCH SPACES ON BORDER LINE OF ORIGINAL TRACING.

LIDA LEMASTERS NO. 4 - INTERSTATE PIPE & SUPPLY CO. - WET 537-A



1005

STATE OF WEST VIRGINIA
DEPARTMENT OF MINES
OIL AND GAS DIVISION

WELL RECORD

Permit No. 537-A

Oil or Gas Well Oil


Company The Interstate Pipe & Supply Company
Address 115 N. Fourth St., Marietta, Ohio
Farm Lida Lemasters Acres 127
Location (waters) _____
Well No. 4 Elev. 1183
District Center County Wetzel
The surface of tract is owned in fee by F.M. Lemaster Heirs
c/o Mrs. Lida Lemasters Address Wileyville, W. Va.
Mineral rights are owned by State of West Virginia
Address Charleston, W. Va.

Casing and Tubing	Used in Drilling	Left in Well	Packers
Size			
16		16'	Kind of Packer
18			
10		910'	Size of
8 1/4		1535'	
6 1/2		2285'	Depth set
5 3/16		2460'	
3			Perf. top
2			Perf. bottom
Liners Used			Perf. top
			Perf. bottom

Drilling commenced _____
Drilling completed 1904
Date Shot _____ From _____ To _____
With _____
Open Flow /10ths Water in _____ Inch
/10ths Merc. in _____ Inch
Volume _____ Cu. Ft.
Rock Pressure _____ lbs _____ hrs.
Oil 45 bbls. _____ bbls., 1st 24 hrs.
Fresh water _____ feet _____ feet
Salt water _____ feet _____ feet

CASING CEMENTED _____ SIZE _____ No. Ft. _____ Date _____
COAL WAS ENCOUNTERED AT 1060 FEET 48 INCHES
1150 FEET 108 INCHES _____ FEET _____ INCHES
_____ FEET _____ INCHES _____ FEET _____ INCHES

Formation	Color	Hard or Soft	Top	Bottom	Oil, Gas or Water	Depth Found	Remarks
Native Coal			1060	1064			
Pittsburgh Coal			1150	1159			
Dunkard Sand			1650	1690			
Salt Sand			1785	2160			
Pencil Cave			2295	2300			
Big Injun			2365	2575			
Stray			3160				
Oil and Gas			3170				

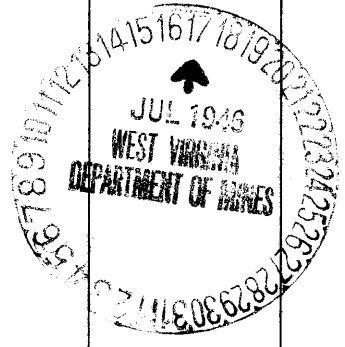

Formation	Color	Hard or Soft	Top	Bottom	Oil, Gas or Water	Depth Found	Remarks

Date July 15, 194 6

APPROVED THE INTERSTATE PIPE & SUPPLY COMPANY Owner

By H. H. Berew
(Title) 9.