






Longitude 80° 30'

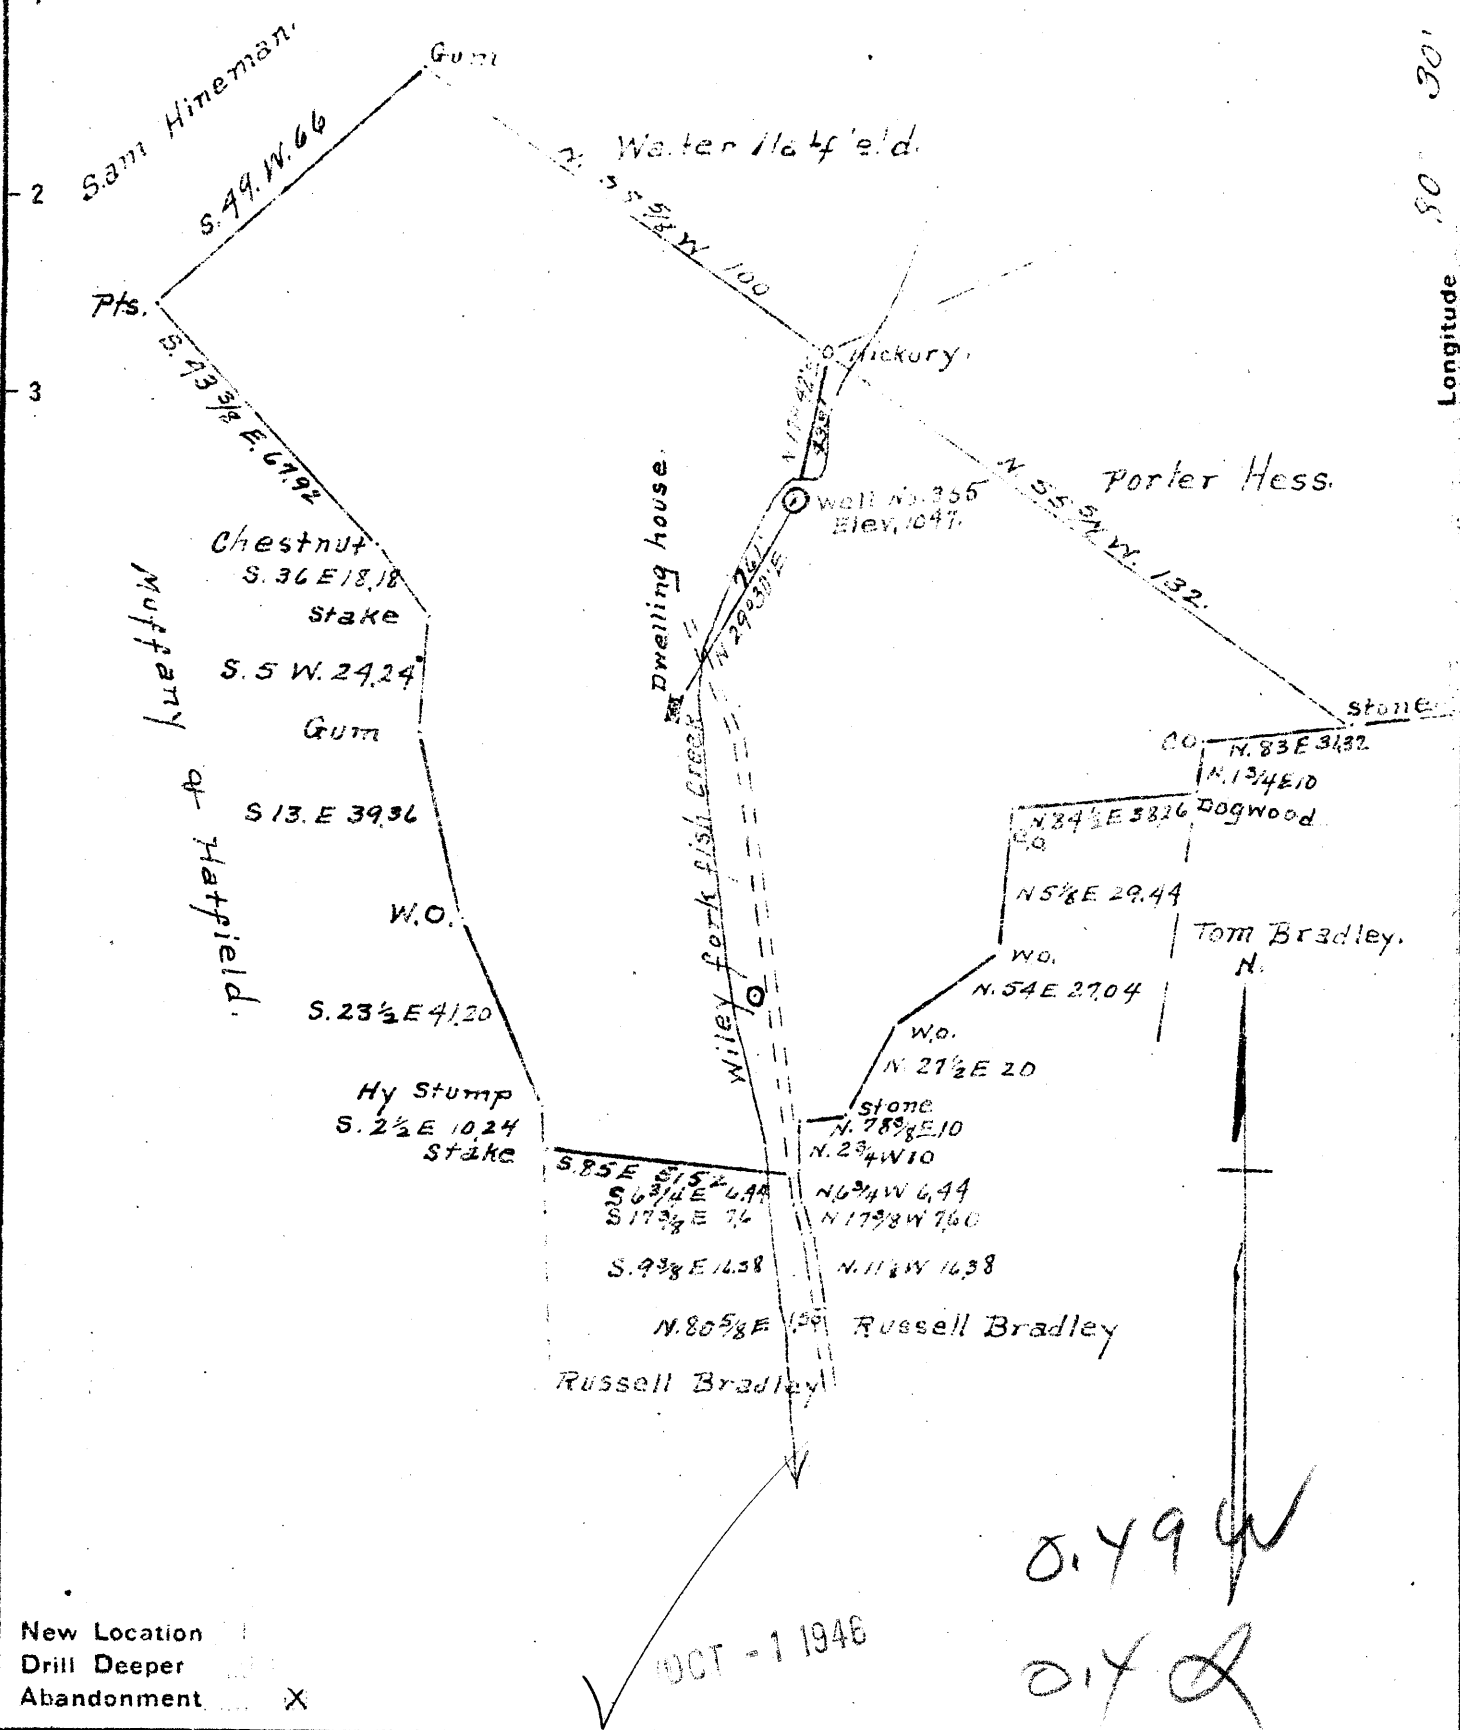

New Location

Drill Deeper

Abandonment  X

Company A. M. Snider

Address Garrison, Pa.

Farm J. W. Hatfield.

Tract one Acres 147 1/2 Lease No. 3637

Well (Farm) No. 1 Serial No. 355

Elevation (Spirit Level) 1047'

Quadrangle Littleton.

County Wetzel District Grant

Engineer A. L. Headley.

Engineer's Registration No. \_\_\_\_\_

File No. \_\_\_\_\_ Drawing No. \_\_\_\_\_

Date 8-23-1946 Scale 1 in = 40 poles.

STATE OF WEST VIRGINIA  
DEPARTMENT OF MINES  
OIL AND GAS DIVISION  
CHARLESTON

**WELL LOCATION MAP**  
FILE NO. WET-541-A

+ Denotes location of well on United States Topographic Maps, scale 1 to 62,500, latitude and longitude lines being represented by border lines as shown.

- Denotes one inch spaces on border line of original tracing.