


Latitude  $39^{\circ} 35'$   
 $7\frac{1}{2}$   $39^{\circ} 30'$

Longitude  $80^{\circ} 55'$

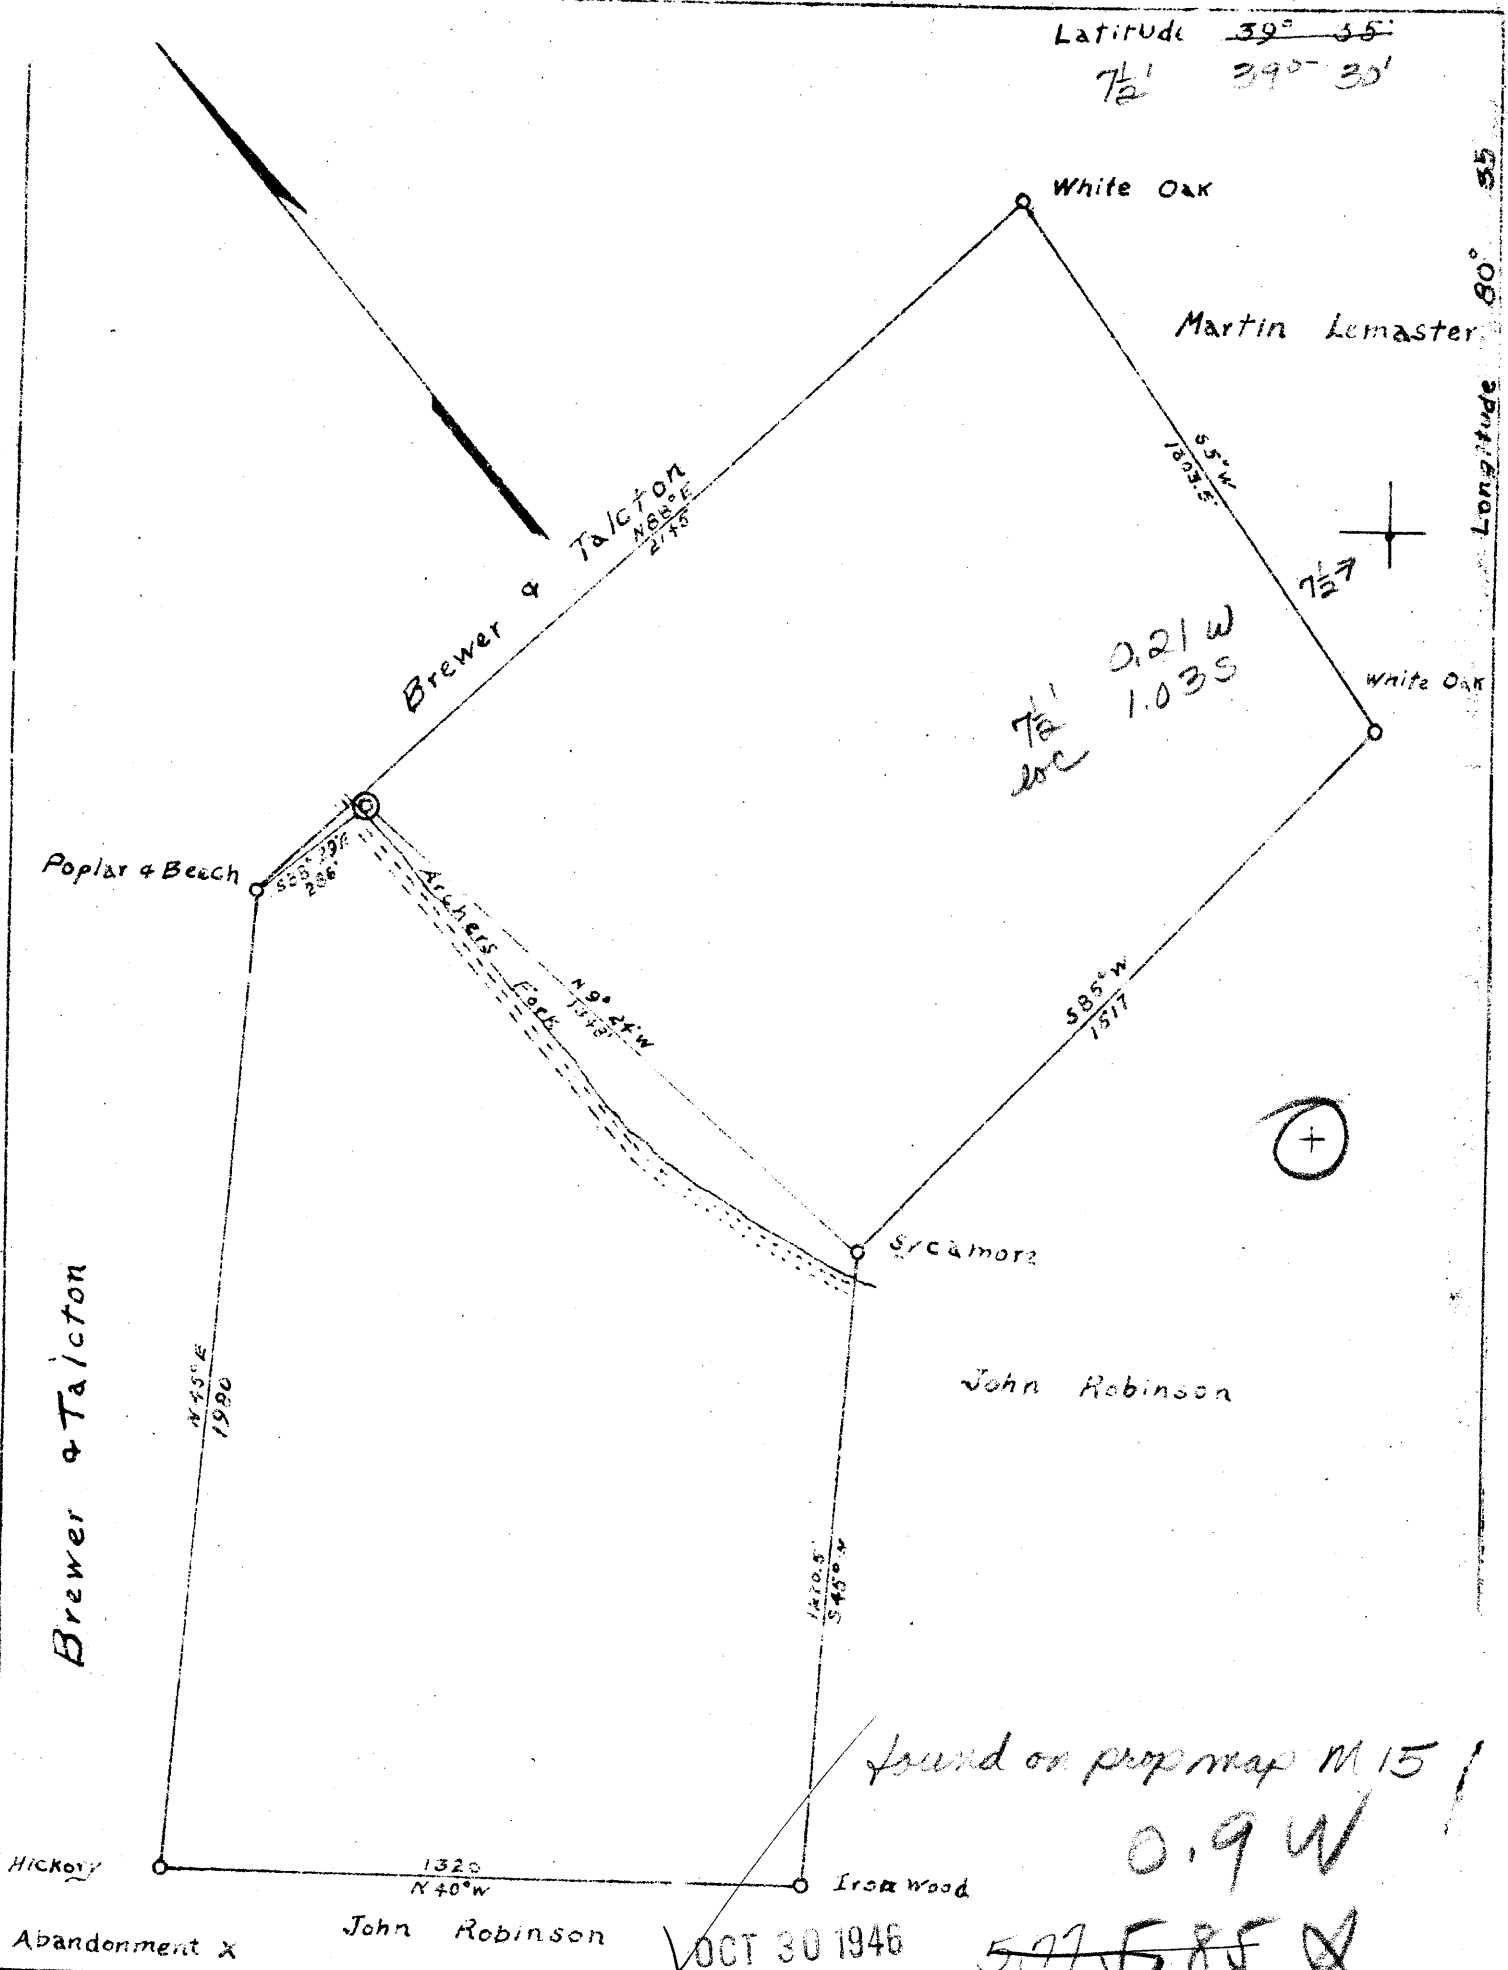

Company George Eagon Co.  
 Address New Martinsville W. Va.  
 Farm Isaac Shreeves His  
 Tract Acres 100 Lease No. 2 A  
 Well (Farm) No. 1 Serial No. \_\_\_\_\_  
 Elevation (Spirit Level) 843  
 Quadrangle Centerpoint NC **(SC)**  
 County Wayzel District Grant  
 Engineer John M. White  
 Engineer's Registration No. 1137  
 File No. \_\_\_\_\_ Drawing No. \_\_\_\_\_  
 Date Sept 17 1946 Scale 1" = 400'

STATE OF WEST VIRGINIA  
 DEPARTMENT OF MINES  
 OIL AND GAS DIVISION  
 CHARLESTON

WELL LOCATION MAP  
 FILE NO. WET-545-A

+ Denotes location of well on United States Topographic Maps, scale 1 to 62,500. latitude and longitude lines being represented by border lines as shown.

- Denotes one inch spaces on border line of original tracing

*Wilson 7 1/2'*



STATE OF WEST VIRGINIA  
DEPARTMENT OF MINES  
OIL AND GAS DIVISION

1007

Permit No. WET-545-A

Oil or Gas Well

(KIND)

Company George Eagon Company  
Address New Martinsville, W. Va.  
Farm Isaac Shreeves Heirs Acres 100  
Location (waters) \_\_\_\_\_  
Well No. \_\_\_\_\_ Elev. 843  
District Grant County Wayne  
The surface of tract is owned in fee by \_\_\_\_\_  
Address \_\_\_\_\_  
Mineral rights are owned by \_\_\_\_\_  
Address \_\_\_\_\_

Drilling commenced 1913  
Drilling completed \_\_\_\_\_  
Date Shot \_\_\_\_\_ From \_\_\_\_\_ To \_\_\_\_\_  
With \_\_\_\_\_  
Open Flow \_\_\_\_\_ /10ths Water in \_\_\_\_\_ Inch  
\_\_\_\_\_ /10ths Merc. in \_\_\_\_\_ Inch  
Volume \_\_\_\_\_ Cu. Ft.  
Rock Pressure \_\_\_\_\_ lbs. \_\_\_\_\_ hrs.  
Oil \_\_\_\_\_ bbls., 1st 24 hrs.  
Fresh water \_\_\_\_\_ feet \_\_\_\_\_ feet  
Salt water \_\_\_\_\_ feet \_\_\_\_\_ feet

Casing and Tubing	Used in Drilling	Left in Well	Packers
Size			
16			Kind of Packer _____
13			
10	300	300	Size of _____
8 1/4	1150	Pulled	
6 5/8	1860	1860	Depth set _____
5 3/16			
3			Perf. top _____
2			Perf. bottom _____
Liners Used			Perf. top _____
			Perf. bottom _____

CASING CEMENTED \_\_\_\_\_ SIZE \_\_\_\_\_ No. Ft. \_\_\_\_\_ Date \_\_\_\_\_  
COAL WAS ENCOUNTERED AT \_\_\_\_\_ FEET \_\_\_\_\_ INCHES  
\_\_\_\_\_ FEET \_\_\_\_\_ INCHES \_\_\_\_\_ FEET \_\_\_\_\_ INCHES  
\_\_\_\_\_ FEET \_\_\_\_\_ INCHES \_\_\_\_\_ FEET \_\_\_\_\_ INCHES

Formation	Color	Hard or Soft	Top	Bottom	Oil, Gas or Water	Depth Found	Remarks
Pittsburgh coal			642	647			
Big Dunkard sand			1147	1187			
Gas sand			1247	1267			
Salt sand			1425	1530			
Maxton sand			1605	1630			
Lime			1855	1950			
Big Injun			1950	2150			
Shales	(pink and gray)		2150	2740			
Gordon sand			2740	2765	Gas	2752-2760	
Total depth				2770			

Formation	Color	Hard or Soft	Top	Bottom	Oil, Gas or Water	Depth Found	Remarks

Date \_\_\_\_\_, 194\_\_

APPROVED \_\_\_\_\_, Owner

By \_\_\_\_\_

(Title)

