

Coal: State of West Virginia

Surface: Samuel Frazee,
Uniontown, Pa.

0.64 0.67 W
7107 Q
Map N 48 N 2 E 2

✓ AUG 11 1947

New Location
Drill Deeper
Abandonment

Company	Roan Supply Co.
Address	Salem W. Va.
Farm	J.B. Dewhurst
Tract	Acres 1262 Lease No.
Well (Farm) No.	24 Serial No.
Elevation (Spirit Level)	Floor - 1101.89 Ground - 1098.89
Quadrangle	Centerpoint
County	Wetzel District Grant
Engineer	E.C. Tabler
Engineer's Registration, No.	
File No.	Drawing No.
Date	Oct. 18 th 1945 Scale 1" = 400'

STATE OF WEST VIRGINIA
DEPARTMENT OF MINES
OIL AND GAS DIVISION
CHARLESTON

WELL LOCATION MAP
FILE NO. Wet-594-A

+ Denotes location of well on United States Topographic Maps, scale 1 to 62,500, latitude and longitude lines being represented by border lines as shown.
- Denotes one inch spaces on border line of original tracing.

J.B. DEWHURST #24 - ROAN SUPPLY CO. - WET-594-A



1044

STATE OF WEST VIRGINIA
DEPARTMENT OF MINES
OIL AND GAS DIVISION

WELL RECORD

Ab 594-A

Permit No. 594-A Oil or Gas Well 012
(KIND)


Company Raad Supply Company
Address 184 E. Main St., Salem, W. Va.
Farm J. B. Dewhurst Acres 1262
Location (waters) _____
Well No. 24 Elev. 1098.99
District Grant County Wetzel
The surface of tract is owned in fee by Samuel Frazee
Address Uniontown, Pa.
Mineral rights are owned by State of W. Va.
Address _____
Drilling commenced _____
Drilling completed April 26, 1904
Date Shot 4/29/04 From 2249' To _____
With 5/4/20 2250'
Open Flow 7/28/36 2250' - 2257' Inch
_____ /10ths Water in _____ Inch
_____ /10ths Merc. in _____ Inch
Volume _____ Cu. Ft.
Rock Pressure _____ lbs. _____ hrs.
Oil _____ bbls., 1st 24 hrs.
Fresh water _____ feet _____ feet
Salt water _____ feet _____ feet

Casing and Tubing	Used in Drilling	Left in Well	Packers
Size			
16			Kind of Packer
13			
10	<u>254'</u>	<u>41'</u>	Size of
8 1/4	<u>1363' 7"</u>	<u>1363' 7"</u>	Depth set
6 5/8	<u>2119' 3"</u>	<u>2119' 3"</u>	
5 3/16			
3			Perf. top
2	<u>2269'</u>	<u>2269'</u>	Perf. bottom
Liners Used			Perf. top
			Perf. bottom

CASING CEMENTED No SIZE _____ No. Ft. _____ Date _____

COAL WAS ENCOUNTERED AT 851 FEET 48 INCHES
_____ FEET _____ INCHES FEET _____ INCHES
_____ FEET _____ INCHES FEET _____ INCHES

Formation	Color	Hard or Soft	Top	Bottom	Oil, Gas or Water	Depth Found	Remarks
Pittsburgh Coal			851	855			
Dunkard Sand			1373	1400			
Salt Sand			1766	1900			
Maxon Sand			2063	2073			
Big Lime			2114	2199			
Pencil Cave			2108	2114			
Big Injun			2199				
1st. Pay			2252	2257			
Total Depth				2269			

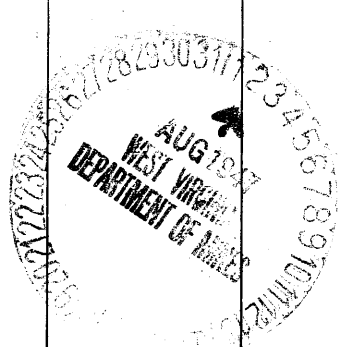

1904

Formation	Color	Hard or Soft	Top	Bottom	Oil, Gas or Water	Depth Found	Remarks

Date August 1, 1947

APPROVED Road Supply Co., Owner

By J. M. Road, Mgr. owner
 (Title) 3 m.