

Latitude 39° 35'

Longitude 80° 30'

Scale 1" = 800'

Coal: Allegheny Real Estate Co.
Watson Bldg., Fairmont, W.Va.

1.63 W
 ✓ SEP 16 1947 4.21 4.78
 N 5-6 E 5-6. Map N 59

New Location
 Drill Deeper
 Abandonment

Company Road Supply Co.
 Address Salem, W.Va.
 Farm B.W. Peterson
 Tract _____ Acres 456.4 Lease No. _____
 Well (Farm) No. 50 Serial No. _____
 Elevation (Spirit Level) Floor - 1265.02
Ground - 1265.02
 Quadrangle Littleton
 County Wetzel District Grant
 Engineer E.C. Tabler
 Engineer's Registration No. _____
 File No. _____ Drawing No. _____
 Date Aug. 2nd 1945 Scale 1" = 800'

STATE OF WEST VIRGINIA
 DEPARTMENT OF MINES
 OIL AND GAS DIVISION
 CHARLESTON

WELL LOCATION MAP
 FILE NO. WET-600-A

+ Denotes location of well on United States Topographic Maps, scale 1 to 62,500, latitude and longitude lines being represented by border lines as shown.

- Denotes one inch spaces on border line of original tracing.



STATE OF WEST VIRGINIA
DEPARTMENT OF MINES
OIL AND GAS DIVISION

1052

Ab
Permit No. 600 A

WELL RECORD


Oil or Gas Well (KIND)

Company Road Supply Company
 Address 184 E. Main St., Salem, W. Va.
 Farm B. W. Peterson Acres 456.4
 Location (waters) _____
 Well No. 50 Elev. 1263.02
 District Grant County Wetzel
 The surface of tract is owned in fee by S. Austin Smith
 Address Clarksburg, W. Va.
 Mineral rights are owned by Allegany Real Estate Co
 Address Watson Building Fairmont, W. Va.
 Drilling commenced _____
 Drilling completed July 29, 1897
 Date Shot 9/6/1899 From 2395' To _____
 With 11/16/1900 No Record
 Open Flow 7/7/1905 Water in 3138' Inch
4/12/1909 Merc. in 3138' Inch
 Volume _____ Cu. Ft.
 Rock Pressure _____ lbs. _____ hrs.
 Oil _____ bbls., 1st 24 hrs.
 Fresh water 31 feet _____ feet
 Salt water _____ feet _____ feet

Casing and Tubing	Used in Drilling	Left in Well	Packers
Size			
16			Kind of Packer
13			
10	<u>770'</u>	<u>None</u>	Size of
8 1/4	<u>1540'</u>	<u>None</u>	
6 5/8	<u>2324'</u>	<u>2324'</u>	Depth set
5 3/16	<u>2556'</u>	<u>2556' 11"</u>	
3			Perf. top
2	<u>3165'</u>	<u>3165'</u>	Perf. bottom
Liners Used			Perf. top
			Perf. bottom

CASING CEMENTED No SIZE _____ No. Ft. _____ Date _____
 COAL WAS ENCOUNTERED 1018' 1024' FEET 72 INCHES
 FEET INCHES FEET INCHES
 FEET INCHES FEET INCHES

Formation	Color	Hard or Soft	Top	Bottom	Oil, Gas or Water	Depth Found	Remarks
NOTE: Well drilled deeper - Commenced 5/3/05 - Completed 6/29/05 Original Depth 2409' Final depth 3165'.							
Conductor				16'			
Pittsburgh Coal			1018'	1024'			
Salt Sand			1928	2028			
Big Lime			2215	2315			
Pencil Cave			2200	2215			
Big Injun			2315	2459			
1st. Pay Oil			2395		Oil		
Depth was				2409			
Stray Sand			3102	3125			
Gordon Sand			3127	3149			
1st Pay Oil			3146		Oil		
Fourth Sand			3175	3195			
Gas			3184				
Filled up to				3165			
Total Depth				3165			

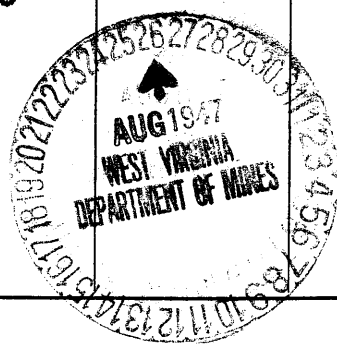

Formation	Color	Hard or Soft	Top	Bottom	Oil, Gas or Water	Depth Found	Remarks

Date Aug 25, 1947

APPROVED Paad Supply Co., Owner

By J. M. Raad, mgr. owner.
S. M. (Title)