

3.57 W  
 2145-47

New Location   
 Drill Desper   
 Abandonment


Company CARNEGIE NATURAL GAS  
 Address PITTSBURGH, Pa.  
 Farm E. J. & JAMES R. WADE  
 Tract \_\_\_\_\_ Acres 9 Lease No. E. 10695 73  
 Well (Farm) No. 1 Serial No. E. 1131  
 Elevation (Spirit Level) 1058'  
 Quad; angle LITTLETON N.E.  
 County WETZEL District CENTER  
 Engineer E. L. SWERNEY  
 Engineer's Registration No. \_\_\_\_\_  
 File No. \_\_\_\_\_ Drawing No. \_\_\_\_\_  
 Date 7-23-17 Scale 1" = 20 Feet

STATE OF WEST VIRGINIA  
 DEPARTMENT OF MINES  
 OIL AND GAS DIVISION  
 CHARLESTON

WELL LOCATION MAP  
 FILE NO. WET-624-A

+ Denotes location of well on United States Topographic Maps, scale 1 to 62,500, latitude and longitude lines being represented by border lines as shown.

- Denotes one inch spaces on border line of original tracing.

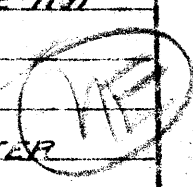



STATE OF WEST VIRGINIA  
DEPARTMENT OF MINES  
OIL AND GAS DIVISION

1085

6-4-A

**WELL RECORD**  
(WELL TO BE ABANDONED)

Oil or Gas Well **GAS**  
(KIND)

Company **CARNEGIE NATURAL GAS COMPANY**  
Address **1015 Frick Bldg., PITTSBURGH, PA.**  
Farm **E. J. & JAMES Q. WADE** Acres **9**  
Location (waters) \_\_\_\_\_  
Well No. **1-1131** Elev. **1058**  
District **CLAY** County **WETZEL**  
The surface of tract is owned in fee by **JOHN A. WADE**  
**Route #2** Address **BARNESVILLE, OHIO**  
Mineral rights are owned by **SEE BELOW**  
Address \_\_\_\_\_  
Drilling commenced **Nov. 25, 1922**  
Drilling completed **Jan. 19, 1923**  
Date Shot \_\_\_\_\_ From \_\_\_\_\_ To \_\_\_\_\_  
With \_\_\_\_\_

Casing and Tubing	Used in Drilling	Left in Well	Packers
Size			
16			Kind of Packer
18			<b>*Anchor **Anchor</b>
10	<b>219</b>	<b>219</b>	Size of <b>* 8 1/2 x 6-5/8</b>
8 1/4	<b>1350</b>	<b>1350</b>	<b>** 6-5/8 x 2</b>
6 3/8	<b>2117</b>	<b>2117</b>	Depth set <b>*1690</b>
5 3/16			<b>** 2130</b>
3			Perf. top _____
2	<b>2362</b>	<b>2362</b>	Perf. bottom _____
Liners Used			Perf. top _____
			Perf. bottom _____


Open Flow **2** /10ths Water in **8-1/4** Inch  
/10ths Merc. in \_\_\_\_\_ Inch  
Volume **1,100,000** Cu. Ft.  
Rock Pressure \_\_\_\_\_ lbs. \_\_\_\_\_ hrs.  
Oil \_\_\_\_\_ bbls., 1st 24 hrs.  
Fresh water **926** feet \_\_\_\_\_ feet  
Salt water \_\_\_\_\_ feet \_\_\_\_\_ feet

CASING CEMENTED \_\_\_\_\_ SIZE \_\_\_\_\_ No. Ft. \_\_\_\_\_ Date \_\_\_\_\_  
COAL WAS ENCOUNTERED AT **606** FEET \_\_\_\_\_ INCHES  
**822** FEET \_\_\_\_\_ INCHES **924** FEET \_\_\_\_\_ INCHES  
\_\_\_\_\_ FEET \_\_\_\_\_ INCHES \_\_\_\_\_ FEET \_\_\_\_\_ INCHES

Formation	Color	Hard or Soft	Top	Bottom	Oil Gas or Water	Depth Found	Remarks
Waynesburg Coal			606	609			
Mapleton Coal			822	828			
Pittsburgh Coal			924	930	Water	926	
Little Dunkard			1352	1359			
Big Dunkard			1430	1465			
Gas Sand			1600	1616			
1st Salt Sand			1686		Gas	1691-1695	
2nd Salt Sand			1762	1854			
Marion Sand			1887	1935			
Little Lime			2066	2076			
Pencil Cave			2076	2084			
Big Lime			2084	2138	Gas	2154-2158-2169	
Big Injun			2138		Gas	2174-2223-2225	
TOTAL DEPTH				2362			

**OWNERS of MINERAL RIGHTS:**

John A. Wade, Route #2, Barnesville, Ohio  
L. F. Burley, Woodruff, W. Va.  
T. E. Conaway, Woodruff, W. Va.  
R. Stanley Smith, Trustee  
for C.K. Spragg Estate, Waynesburg, Pa.

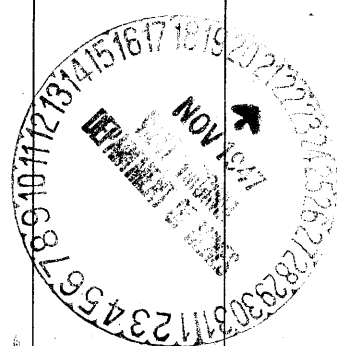

Formation	Color	Hard or Soft	Top	Bottom	Oil, Gas or Water	Depth Found	Remarks

Date **NOVEMBER 20**, 19**47**

APPROVED **CARNEGIE NATURAL GAS COMPANY**, Owner

By *Carroll Luning*  
(Title) **Gen. Supd.**