

New Location
 Drill Deeper
 Abandonment

Map 39 N7W4 F.B. 885 P. 25 26-27

Company Hope Natural Gas Co
 Address Clarksburg, W.Va.
 Farm C.P. McCoy Hrs.
 Tract Acres 200 Lease No. 419
 Well (Farm) No. Serial No. 9
 Elevation (Spirit Level) 833'
 Quadrangle Littleton
 County Wetzel District Green
 Engineer W.M. Bowers
 Engineer's Registration No. 900
 File No. Drawing No.
 Date 12-19-47 Scale 1"=40P

STATE OF WEST VIRGINIA
 DEPARTMENT OF MINES
 OIL AND GAS DIVISION
 CHARLESTON

WELL LOCATION MAP
 FILE NO. WET-637-A

+ Denotes location of well on United States Topographic Maps, scale 1 to 62,500, latitude and longitude lines being represented by border lines as shown.
 - Denotes one inch spaces on border line of original tracing.



STATE OF WEST VIRGINIA
DEPARTMENT OF MINES
OIL AND GAS DIVISION

1785

637-A

WELL RECORD

Off or Gas Well (KIND)

Permit No. _____

Company **Hope Natural Gas Company.**

Address **445 West Main St. Clarksburg, W. Va.**

Farm **C.P. McCoy Hrs.** Acres **200**

Location (waters) _____

Well No. **9** Elev. **833**

District **Green** County **Wetzel**

The surface of tract is owned in fee by _____
Address _____

Mineral rights are owned by _____
Address _____

Drilling commenced **September 3, 1898**

Drilling completed **November 17, 1898**

Date Shot _____ From _____ To _____

With _____

Open Flow _____ /10ths Water in _____ Inch
_____ /10ths Merc. in _____ Inch

Volume _____ Cu. Ft.

Rock Pressure _____ lbs. _____ hrs.

Oil _____ bbls., 1st 24 hrs.

Fresh water **none recorded** feet _____ feet

Salt water **none recorded** feet _____ feet

Casing and Tubing	Used in Drilling	Left in Well	Packers
Size			
16			Kind of Packer _____
13			
10	416	416	Size of _____
8 1/4	1211	1211	
6 5/8	1881	1881	Depth set _____
5 3/16	2570	2570	
3			Perf. top _____
2			Perf. bottom _____
Liners Used	229	229	Perf. top _____
			Perf. bottom _____


CASING CEMENTED _____ SIZE _____ No. Ft. _____ Date _____

COAL WAS ENCOUNTERED AT **553** FEET **60** INCHES

_____ FEET _____ INCHES FEET _____ INCHES

_____ FEET _____ INCHES FEET _____ INCHES

Formation	Color	Hard or Soft	Top	Bottom	Oil, Gas or Water	Depth Found	Remarks
Pittsburgh Coal			553	558			
Big Injun			1840	2050	gas	1920	
Gordon stray			2642	2657			
Gordon			2672		gas	2678	
Total depth				2678			

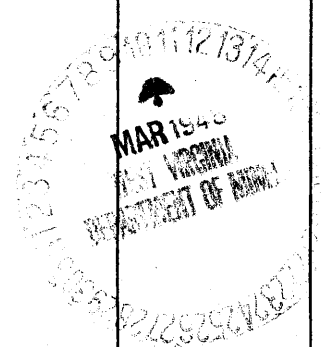

Formation	Color	Hard or Soft	Top	Bottom	Oil, Gas or Water	Depth Found	Remarks

Date March 8, 1948, 19

APPROVED Hope Natural Gas Company, Owner

By _____

(Title) PA