

Elevations:

- 2 J.W. Palmer { Casinghead - 1218.71  
Ground - 1216.21
- 3 J.W. Palmer { Floor - 1240.91  
Ground - 1240.91

#2	3.86	S
	1.97	W
#3	3.72	S
	1.89	W

Surface: J.W. Miller, Wileyville, Wetzel Co. W.Va.  
 Coal: State of West Virginia.

- New Location...
- Drill Deeper.....
- Abandonment.....

N 68

N 12 E 1

Company Randall-Zogg Supply Co.  
 Address Owensboro, Ky.  
 Farm J.W. Palmer  
 Tract \_\_\_\_\_ Acres 130 5/8 Lease No. \_\_\_\_\_  
 Well (Farm) No. 2 and 3 Serial No. C  
 Elevation (Spirit Level) See above  
 Quadrangle LITTLETON  
 County Wetzel District Grant  
 Engineer EC Tabler  
 Engineer's Registration No. \_\_\_\_\_  
 File No. \_\_\_\_\_ Drawing No. \_\_\_\_\_  
 Date May 11<sup>th</sup> 1948 Scale 1" = 800 Feet

STATE OF WEST VIRGINIA  
 DEPARTMENT OF MINES  
 OIL AND GAS DIVISION  
 CHARLESTON

WELL LOCATION MAP

FILE NO. Wet-692-A-#2  
Wet-703-A-#3

+ Denotes location of well on United States Topographic Maps, scale 1 to 62,500, latitude and longitude lines being represented by border lines as shown.

- Denotes one inch spaces on border line of original tracing.



STATE OF WEST VIRGINIA  
DEPARTMENT OF MINES  
OIL AND GAS DIVISION

1163

Permit No. 692-A

WELL RECORD

Oil or Gas Well OIL

(KIND)

Company RANDALL-ZOGG SUPPLY COMPANY  
 Address BOX 526, CHARLESTON, 22 W. VA.  
 Farm J. W. Palmer Acres 130 5/8  
 Location (waters) Four Mile Run  
 Well No. Two (2) Elev. 1218-71  
 District Grant County Wetzel  
 The surface of tract is owned in fee by J. W. Miller,  
 Address Wileyville, W. Va.  
 Mineral rights are owned by Coal sold to State of  
W. Va. for Taxes Address \_\_\_\_\_  
 Drilling commenced No Record  
 Drilling completed No Record  
 Date Shot SEE BELOW From \_\_\_\_\_ To \_\_\_\_\_  
 With \_\_\_\_\_  
 Open Flow \_\_\_\_\_ /10ths Water in \_\_\_\_\_ Inch  
 \_\_\_\_\_ /10ths Merc. in \_\_\_\_\_ Inch  
 Volume \_\_\_\_\_ Cu. Ft.  
 Rock Pressure \_\_\_\_\_ lbs. \_\_\_\_\_ hrs.  
 Oil No Record bbls., 1st 24 hrs.  
 Fresh water \_\_\_\_\_ feet \_\_\_\_\_ feet  
 Salt water \_\_\_\_\_ feet \_\_\_\_\_ feet

Casing and Tubing	Used in Drilling	Left in Well	Packers
Size			
16			Kind of Packer
13			
10	530'		Size of
8 1/4	1552'	1552'	
6 5/8	2038'	2038'	Depth set
5 3/16	2259'	2259'	
3			Perf. top
2	3118'	3118'	Perf. bottom
Liners Used			Perf. top
			Perf. bottom


CASING CEMENTED \_\_\_\_\_ SIZE \_\_\_\_\_ No. Ft. \_\_\_\_\_ Date \_\_\_\_\_

COAL WAS ENCOUNTERED AT 1035 FEET 96 INCHES  
 \_\_\_\_\_ FEET \_\_\_\_\_ INCHES \_\_\_\_\_ FEET \_\_\_\_\_ INCHES  
 \_\_\_\_\_ FEET \_\_\_\_\_ INCHES \_\_\_\_\_ FEET \_\_\_\_\_ INCHES

Formation	Color	Hard or Soft	Top	Bottom	Oil, Gas or Water	Depth Found	Remarks
Pittsburgh Coal			1035	1043			
Dunkard Sand			1525	1565			
Salt Sand			1750	2050			
Pencil Cave			2220	2226			
Big Lime			2226	2285			
Big Injun Sand			2285	2525			
Stray Sand			3070				
Gordon Sand			3100		Oil	3103	
Total Depth				3118			

SHOT RECORD

WHEN COMPLETED  
 August 15th, 1904 Shot with 30 Qts.  
 September 3rd, 1908 " " 40 "  
 January 12th, 1914 " " 60 "  
 " " 80 "

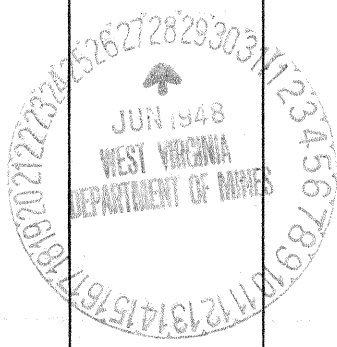

Formation	Color	Hard or Soft	Top	Bottom	Oil, Gas or Water	Depth Found	Remarks

Date JUNE 28th, 1948

APPROVED RANDALL-ZOGG SUPPLY COMPANY, Owner

By *R. D. [Signature]*  
(Title) Agent