


Latitude 39° 30'

Longitude 80° 30'

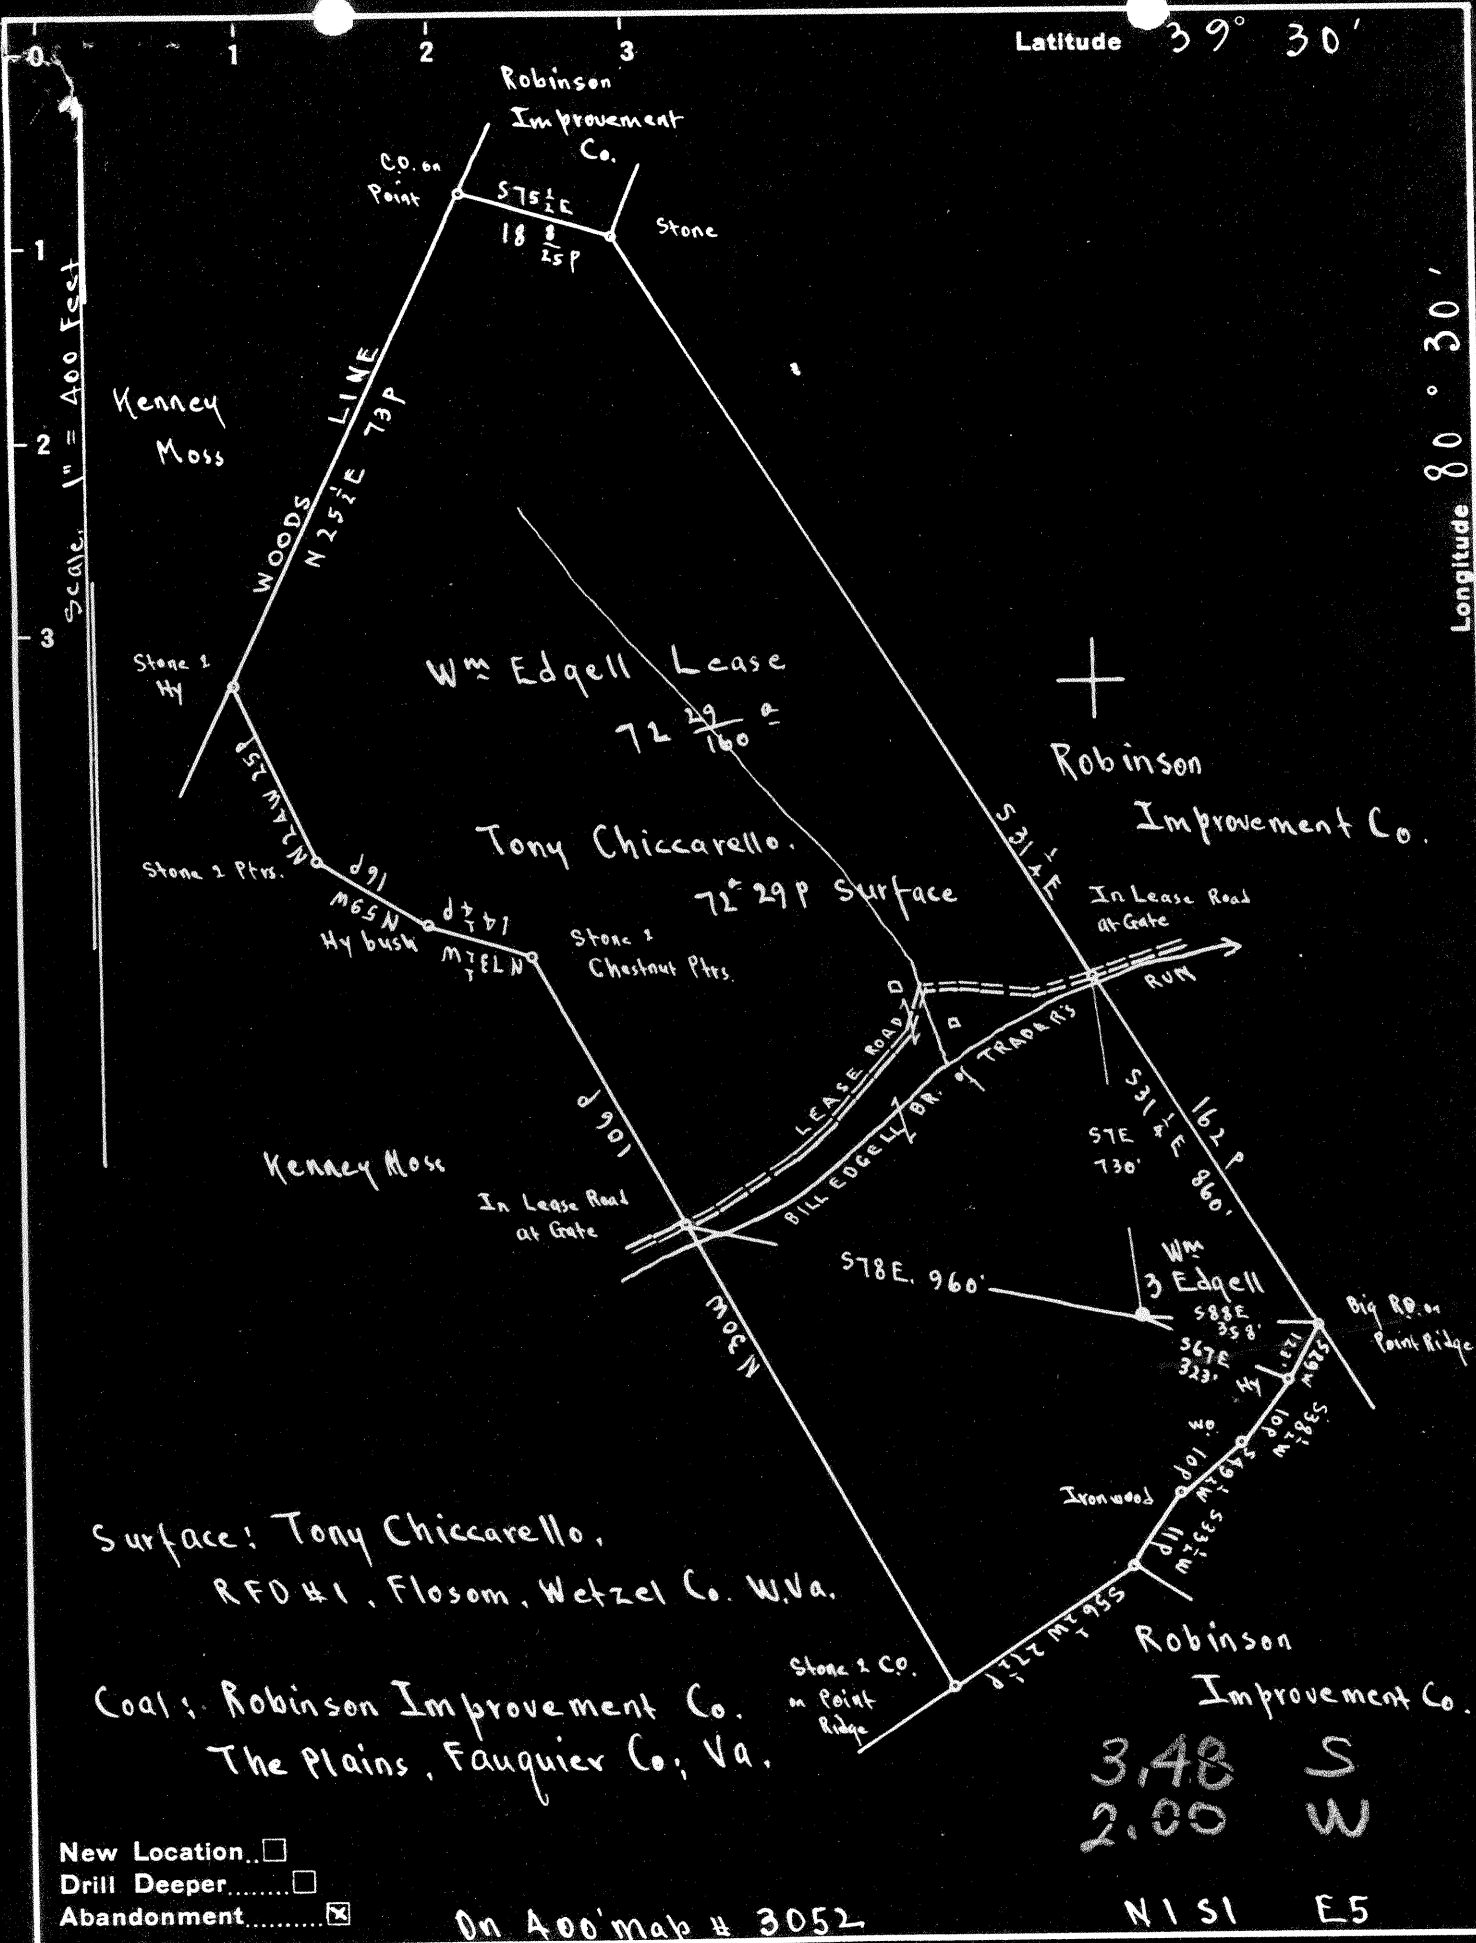

3.48 S
2.00 W
N 1 S 1 E 5

New Location
 Drill Deeper
 Abandonment

On 400' map # 3052

Company Strauss and Beren
 Address Marietta Ohio
 Farm Wm Edgell
 Tract _____ Acres 73 Lease No. _____
 Well (Farm) No. 3 Serial No. _____
 Elevation (Spirit Level) Casinghead - 1344.20
Ground - 1343.20
 Quadrangle CENTERPOINT
 County Wetzel District Grant
 Engineer E.C. Tabler
 Engineer's Registration No. _____
 File No. _____ Drawing No. _____
 Date Aug 16th 1948 Scale 1" = 400 Feet

STATE OF WEST VIRGINIA
 DEPARTMENT OF MINES
 OIL AND GAS DIVISION
 CHARLESTON

WELL LOCATION MAP
 FILE NO. WET-708-A

+ Denotes location of well on United States Topographic Maps, scale 1 to 62,500, latitude and longitude lines being represented by border lines as shown.
 - Denotes one inch spaces on border line of original tracing.



STATE OF WEST VIRGINIA
DEPARTMENT OF MINES
OIL AND GAS DIVISION

1137

WELL RECORD

Permit No. 908-A

Oil or Gas Well _____
(KIND)

Company Straus & Beron
Address Marietta, Ohio
Farm William Edgell Acres 73
Location (waters) Traders Run
Well No. 3 Elev. 1344.20
District Grant County Wetzel
The surface of tract is owned in fee by Tony Chiccarello
RPD # 1 Address Polson, W. Va.
Mineral rights are owned by Robinson Improvement Co.
Address The Plains, Va.
Drilling commenced _____
Drilling completed _____
Date Shot _____ From _____ To _____
With _____
Open Flow _____ /10ths Water in _____ Inch
_____ /10ths Merc. in _____ Inch
Volume _____ Cu. Ft.
Rock Pressure _____ lbs. _____ hrs.
Oil _____ bbls., 1st 24 hrs.
Fresh water _____ feet _____ feet
Salt water _____ feet _____ feet

Casing and Tubing	Used in Drilling	Left in Well	Packers
Size			Kind of Packer
16			
18			
10	372'	none	Size of
8 1/4	1620'	none	
6 5/8	2366'	2366'	Depth set
5 3/16	2996'	2996'	
3			Perf. top
2			Perf. bottom
Liners Used	2 1/4" - 4 x 4 1/2" F.J.		Perf. top
			Perf. bottom

CASING CEMENTED _____ SIZE _____ No. Ft. _____ Date _____
COAL WAS ENCOUNTERED AT 445 FEET _____ INCHES
780 FEET _____ INCHES 1095 FEET _____ INCHES
1125 FEET _____ INCHES _____ FEET _____ INCHES

Formation	Color	Hard or Soft	Top	Bottom	Oil, Gas or Water	Depth Found	Remarks
Coal, Native			445	449			
Coal,			780	785			
Coal, Graham			1095	1098			
Coal, Pgh.			1125	1133			
Little Dunkard			1468	1503			
Salt Sand, 1st			1890	1930			
Salt Sand, 2nd			2070	2170			
Maxon Sand			2285	2300			
Little Lime			2320	2334			
Pencil Cave			2334	2345			
Big Lime			2345	2421			
Big Injun			2422	2528			
Fifty Foot			2990	3000			
Thirty Foot			3065	3105			
Stray Sand			3127	3192			

