

COAL OWNED BY $\frac{1}{3}$ FIRST NAT'L BANK & TRUST CO. WAYNESBURG PA.
 $\frac{1}{3}$ GEORGE E. RICE JR. WAYNESBURG PA.
 $\frac{1}{3}$ EDITH CORNELIA RICE WAYNESBURG PA.
 NEW LOCATION
 DRILL DEEPER
 ABANDONMENT

Detail location
 Scale 1" = 100'
 4,97 S
 2,10 W

COMPANY THE MANUFACTURERS LIGHT & HEAT CO.
 ADDRESS 800 UNION TRUST BLDG. PITTSBURGH PA.
 FARM BAILEY & RICE NOW THE W.P. DEVINE LOT.
 TRACT 1 ACRES 93.68 LEASE No. 2986
 WELL (FARM) No. 1 SERIAL No. 1150
 ELEVATION (SPIRIT LEVEL) 1038'
 QUADRANGLE MANNINGTON
 COUNTY WETZEL DISTRICT CHURCH
 ENGINEER *Wetzel*
 ENGINEER'S REGISTRATION No. _____
 FILE No. P-26/6 DRAWING No. Y-13-108
 DATE OCT-6-1948 SCALE 1"=800'

STATE OF WEST VIRGINIA
 DEPARTMENT OF MINES
 OIL AND GAS DIVISION
 CHARLESTON

WELL LOCATION MAP

FILE No. WCE-731-A

+ DENOTES LOCATION OF WELL ON UNITED STATES TOPOGRAPHIC MAPS, SCALE 1 TO 62,500. LATITUDE AND LONGITUDE LINES BEING REPRESENTED BY BORDER LINES AS SHOWN.
 — DENOTES ONE INCH SPACES ON BORDER LINE OF ORIGINAL TRACING.



STATE OF WEST VIRGINIA
DEPARTMENT OF MINES
OIL AND GAS DIVISION

1223

WELL RECORD

Permit No. Ab 731-A Oil or Gas Well (KIND)


Company The Manufacturers Light & Heat Company
 Address 800 Union Trust Building
 Farm Bailey & Rice Acres 103
 Location (waters).....
 Well No. 1150 Elev.....
 District Church County Wetzel
 The surface of tract is owned in fee by Geo. E. Rice, Jr.
20 North Richhill St. Address Waynesburg, Pa.
 Mineral rights are owned by The Mfrs. Light & Heat Co.
800 Union Trust Bldg. Address Pittsburgh, Pa.
 Drilling commenced February 23rd, 1907
 Drilling completed April 24th, 1907
 Date Shot From To
 With

Casing and Tubing	Used in Drilling	Left in Well	Packers
Size			
16			Kind of Packer
18			
10	275	275	Size of <u>4x6-5/8</u>
8 1/2	1158	1158	
6 1/2	1973	1973	Depth set <u>2876</u>
5 3/16			
3			Perf. top
2			Perf. bottom
Liners Used			Perf. top
			Perf. bottom

Open Flow /10ths Water in Inch
 /10ths Merc. in Inch
 Volume Cu. Ft.
 Rock Pressure lbs hrs.
 Oil bbls., 1st 24 hrs.
 Fresh water feet feet
 Salt water feet feet

CASING CEMENTED SIZE No. Ft. Date
 COAL WAS ENCOUNTERED AT 745 FEET 72 INCHES
 FEET INCHES FEET INCHES
 FEET INCHES FEET INCHES

Formation	Color	Hard or Soft	Top	Bottom	Oil, Gas or Water	Depth Found	Remarks
Clay			0	100			
Slate & Lime			100	200			
Red Rock			200	300			
Slate, Lime & Rock			300	400			
Slate			400	500			
Slate & Lime			500	600			
Slate			600	700			
Sand, Lime & Slate			700	745			
Pittsburgh Coal			745	751			
Lime & Red Rock			751	1158			
Little Dunkard Sand			1158	1188			
Big Dunkard Sand			1215	1265			
Gas Sand			1455	1485			
Salt Sand			1552	1664			
2nd Salt Sand			1768	1800	No water		
Maxon Sand			1880	1915	No water		
Break			1915	1919	Show gas at 1890		
Big Lime			1919	1973			
Big Injun			1973	2221			
Sand			2346	2364			
50 ft. Sand			2734	2759			
30 ft. Sand			2765	2795			
Stray Sand			2795	2835			
Slate & Shells			2835	2869			
Gordon			2869	2926			
Fourth Sand			2942	2969	Gas at 2906		
TOTAL DEPTH				2969	Gas from 2945 - 2951		

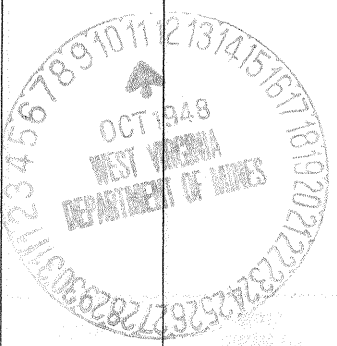

Formation	Color	Hard or Soft	Top	Bottom	Oil, Gas or Water	Depth Found	Remarks

Date OCTOBER 8TH, 1948

APPROVED THE MANUFACTURERS LIGHT & HEAT COMPANY, Owner

By Ben Steeper LAND AGENT.
(Title)