

5.40 S
3.61 W

New Location
 Drill Deeper
 Abandonment

Map Sh. 32-N 10 E 8 FB. 927-P. 35-36.

Company Hope Natural Gas Co
 Address Clarksburg, W. Va.
 Farm Littleton-Myers
 Tract _____ Acres 132 Lease No. 3207
 Well (Farm) No. _____ Serial No. 3800
 Elevation (Spirit Level) 1300'
 Quadrangle Mannington
 County Wetzel District Grant
 Engineer Wm Bowers
 Engineer's Registration No. 900
 File No. _____ Drawing No. _____
 Date 3-16-49 Scale 1" = 40 P

STATE OF WEST VIRGINIA
 DEPARTMENT OF MINES
 OIL AND GAS DIVISION
 CHARLESTON

WELL LOCATION MAP
 FILE NO. Wet-795-A

+ Denotes location of well on United States Topographic Maps, scale 1 to 62,500, latitude and longitude lines being represented by border lines as shown.
 - Denotes one inch spaces on border line of original tracing.



STATE OF WEST VIRGINIA
DEPARTMENT OF MINES
OIL AND GAS DIVISION

1227

WELL RECORD

Permit No. Ab 795-A


Oil or Gas Well _____ (KIND)

Company Hope Natural Gas Company.
 Address 445 West Main St. Clarksburg, W. Va.
 Farm Littleton Myers Acres 132
 Location (waters) _____
 Well No. 3800 Elev. 1300
 District Grant County Wetzel
 The surface of tract is owned in fee by _____
 Address _____
 Mineral rights are owned by _____
 Address _____
 Drilling commenced May 5, 1915
 Drilling completed Sept. 9, 1915
 Date Shot _____ From _____ To _____
 With _____
 Open Flow _____ /10ths Water in _____ Inch
 _____ /10ths Merc. in _____ Inch
 Volume _____ Cu. Ft.
 Rock Pressure _____ lbs. _____ hrs.
 Oil _____ bbls., 1st 24 hrs.
 Fresh water none recorded feet _____ feet
 Salt water 1860 feet _____ feet

Casing and Tubing	Used in Drilling	Left in Well	Packers
Size			Kind of Packer
16			
13			
10	715	Pulled	Size of
8 1/4	1442	426	
6 3/8	2215	2215	Depth set
5 3/16	2975	2975	
3			Perf. top
2			Perf. bottom
Liners Used			Perf. top
			Perf. bottom

CASING CEMENTED _____ SIZE _____ No. Ft. _____ Date _____
 COAL WAS ENCOUNTERED AT 865 FEET 48 INCHES
965 FEET 48 INCHES FEET INCHES
 FEET INCHES FEET INCHES

Formation	Color	Hard or Soft	Top	Bottom	Oil, Gas or Water	Depth Found	Remarks
Native coal			865	869			
Pittsburgh Coal			965	969			
Little Dunkard			1310	1330			
Big Dunkard			1430	1490	show gas	1465	
Gas sand			1605	1675			
First Salt			1710	1800	show gas	1727	
Second Salt			1840	1965	water	1860	
Maxon			2090	2158			
Little Lime				2158			
Pencil cave			2158	2164			
Big Lime			2164	2246			
Big Injun			2246	2390	gas	2255	
Squaw			2393	2422			
Fifty foot			2900	2923	gas	2903	
Gordon			3049	3112	gas	3065, 2087	
Fourth			3131	3161	gas	3154	
Fifth			3192		gas	3194	
Total depth				3199			

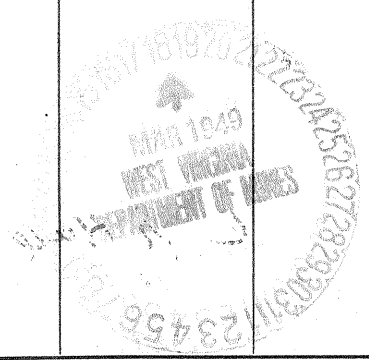

Formation	Color	Hard or Soft	Top	Bottom	Oil, Gas or Water	Depth Found	Remarks

Date March 14, 1949, 19____

APPROVED Hope Natural Gas Company., Owner

By _____

(Title)

