


0 1 2 3 LATITUDE ° 39 40

1
2
3 LONGITUDE 80 35

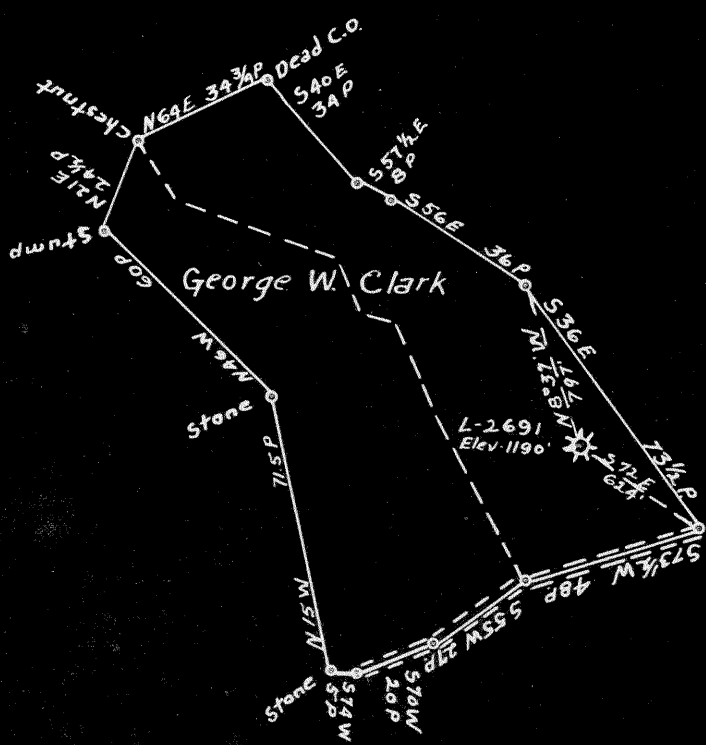

0126 S
048 W

COAL OWNED BY The Biddle Coal & Coke Co
% A.P. Austin, Uniontown Pa.

NEW LOCATION...
DRILL DEEPER.....
ABANDONMENT.....

COMPANY The Manufacturers Light & Heat Co
ADDRESS 800 Union Trust Bldg Pittsburgh Pa
FARM George W. Clark
TRACT _____ ACRES 56 LEASE No. 8471
WELL (FARM) No. 1 SERIAL No. L2691
ELEVATION (SPIRIT LEVEL) 1190'
QUADRANGLE Littleton **C**
COUNTY Wetzel DISTRICT Center
ENGINEER Alexander Streater
ENGINEER'S REGISTRATION No. _____
FILE No. _____ DRAWING No. Y-13-176
DATE April 20 1949 SCALE 1" = 800'

STATE OF WEST VIRGINIA
DEPARTMENT OF MINES
OIL AND GAS DIVISION
CHARLESTON

WELL LOCATION MAP

FILE No. Wet-807-A

+ DENOTES LOCATION OF WELL ON UNITED STATES TOPOGRAPHIC MAPS. SCALE 1 TO 62,500. LATITUDE AND LONGITUDE LINES BEING REPRESENTED BY BORDER LINES AS SHOWN.

- DENOTES ONE INCH SPACES ON BORDER LINE OF ORIGINAL TRACING.



STATE OF WEST VIRGINIA
DEPARTMENT OF MINES
OIL AND GAS DIVISION

1251

Ab-807-A

WELL RECORD

Permit No. _____ Oil or Gas Well _____
(KIND)

Company The Manufacturers Light & Heat Company
Address 800 Union Trust Bldg. Pittsburgh, Pa.
Farm Andrew Clark Acres 56
Location (waters) _____
Well No. 2691 Elev. 1190
District Center County Wetzel
The surface of tract is owned in fee by Anna Prendergast
Cameron, W. Va. Address _____
Mineral rights are owned by The Mfrs. Light & Heat Co.
800 Union Trust Bldg. Pittsburgh, Pa. Address _____
Drilling commenced June 27, 1921
Drilling completed August 17, 1921
Date Shot _____ From _____ To _____
With _____

Casing and Tubing	Used in Drilling	Left in Well	Packers
Size			
16			Kind of Packer
18			
10	300		Size of <u>6 5/8" x 4</u>
8 1/4	1589'10"	1589'10"	
6 5/8	2300'10"	2300'10"	Depth set <u>2345</u>
5 3/16			
3			Perf. top
2			Perf. bottom
Liners Used			Perf. top
			Perf. bottom

Open Flow _____ /10ths Water in _____ Inch
_____ /10ths Merc. in _____ Inch
Volume _____ Cu. Ft.
Rock Pressure 650 lbs. 13 hrs.
Oil _____ bbls., 1st 24 hrs.
Fresh water _____ feet
Salt water _____ feet

CASING CEMENTED _____ SIZE _____ No. Ft. _____ Date _____
COAL WAS ENCOUNTERED AT 660 FEET 36 INCHES
988 FEET 72 INCHES 1085 FEET 84 INCHES
_____ FEET _____ INCHES _____ FEET _____ INCHES

Formation	Color	Hard or Soft	Top	Bottom	Oil, Gas or Water	Depth Found	Remarks
Clay			0	16			
Rock			40	100	Water at 80'		
Bluff Sand			620	660			
Fairview Coal			660	663			
Mapletown Coal			988	994			
Pittsburgh Coal			1085	1092			
Red Rock			1410	1460			
Little Dunkard			1475	1525			
Big Dunkard			1560	1605			
Gas Sand			1730	1790			
1st. Salt Sand			1845	1857			
2nd. Salt Sand			1892	1920			
3rd. Salt Sand			1950	2010			
Maxon Salt Sand			2150	2230	Water at 2210, 4 bailers per hour.		
Little Lime			2230	2255			
Pencil Cave			2255	2260			
Big Lime			2260	2325			
Big Injun			2325		Gas at 2379 to 2384,		
TOTAL DEPTH			2460		Still in sand.		

