

New Location...   
 Drill Deeper.....   
 Abandonment.....  40

849-A	S	3.32
#28	W	1.71
781-A	S	2.90
#40	W	1.79
#4932	S	3.47
	W	1.81

Map Sh. 39 N 7 W 5 F B. 920 P-11-16

Company Hope Natural Gas Co.  
 Address Clarksburg, Wva.  
 Farm M.A. & A.E. Brast  
 Tract \_\_\_\_\_ Acres 603 Lease No. 481  
 Well (Farm) No. \_\_\_\_\_ Serial No. As Shown  
 Elevation (Spirit Level) As Shown  
 Quadrangle Littleton SW  
 County Wetzel District Greene  
 Engineer Wm Bowers  
 Engineer's Registration No. 900  
 File No. \_\_\_\_\_ Drawing No. \_\_\_\_\_  
 Date 1-5-49 Scale 1"=1320'

STATE OF WEST VIRGINIA  
 DEPARTMENT OF MINES  
 OIL AND GAS DIVISION  
 CHARLESTON

**WELL LOCATION MAP**  
 FILE NO. Wet - 849-A - #28  
Wet - 849-A - #28  
 + Denotes location of well on United States Topographic Maps, scale 1 to 62,500, latitude and longitude lines being represented by border lines as shown.  
 - Denotes one inch spaces on border line of original tracing.



STATE OF WEST VIRGINIA  
DEPARTMENT OF MINES  
OIL AND GAS DIVISION

1300

AP 849-A

WELL RECORD


Permit No. \_\_\_\_\_ Off or Gas Well \_\_\_\_\_ (KIND)

Company Hope Natural Gas Company.  
 Address 445 West Main St. Clarksburg, W. Va.  
 Farm M.A. & A.E. Brast Acres 603  
 Location (waters) \_\_\_\_\_  
 Well No. 28 Elev. 769  
 District Greene County Wetzel  
 The surface of tract is owned in fee by \_\_\_\_\_  
 Address \_\_\_\_\_  
 Mineral rights are owned by \_\_\_\_\_  
 Address \_\_\_\_\_  
 Drilling commenced 1901  
 Drilling completed 1901  
 Date Shot \_\_\_\_\_ From \_\_\_\_\_ To \_\_\_\_\_  
 With \_\_\_\_\_  
 Open Flow \_\_\_\_\_ /10ths Water in \_\_\_\_\_ Inch  
 \_\_\_\_\_ /10ths Merc. in \_\_\_\_\_ Inch  
 Volume \_\_\_\_\_ Cu. Ft.  
 Rock Pressure \_\_\_\_\_ lbs. \_\_\_\_\_ hrs.  
 Oil \_\_\_\_\_ bbls., 1st 24 hrs.  
 Fresh water none recorded feet \_\_\_\_\_ feet  
 Salt water none recorded feet \_\_\_\_\_ feet

Casing and Tubing	Used in Drilling	Left in Well	Packers
Size			
16			Kind of Packer
13			
10	166	Pulled	Size of
8 1/4	957	Pulled	
6 5/8	1584	1584	Depth set
5 3/16	2048	2048	
3			Perf. top
2	2624	2624	Perf. bottom
Liners Used			Perf. top
			Perf. bottom

CASING CEMENTED \_\_\_\_\_ SIZE \_\_\_\_\_ No. Ft. \_\_\_\_\_ Date \_\_\_\_\_  
 COAL WAS ENCOUNTERED AT 509 FEET 84? INCHES  
 \_\_\_\_\_ FEET \_\_\_\_\_ INCHES FEET \_\_\_\_\_ INCHES  
 \_\_\_\_\_ FEET \_\_\_\_\_ INCHES FEET \_\_\_\_\_ INCHES

Formation	Color	Hard or Soft	Top	Bottom	Oil, Gas or Water	Depth Found	Remarks
Pittsburgh Coal			509	516 est			
Big Injun			1785	2010			
Gordon			2609	2615	gas	2581	
Total depth				2624			

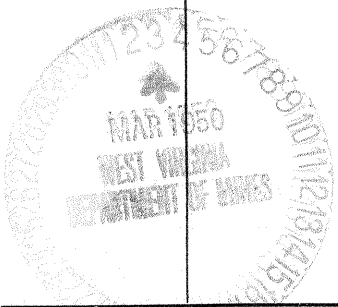

Formation	Color	Hard or Soft	Top	Bottom	Oil, Gas or Water	Depth Found	Remarks

Date February 28, 1950, 19

APPROVED Hope Natural Gas Company., Owner

By \_\_\_\_\_

(Title)