

New Location.   
 Drill Deeper.....   
 Abandonment.....

Company Quaker State Oil Refining Corp  
 Address Parkersburg, West Virginia;  
 Farm J. L. Carney,  
 Tract One Acres 271 Lease No. \_\_\_\_\_  
 Well (Farm) No. 1 - 3, Serial No. \_\_\_\_\_  
 Elevation (Spirit Level) 1071 - 1207 Feet  
 Quadrangle Littleton,  
 County Wetzel District Center  
 Engineer J. M. Cochran.  
 Engineer's Registration No. Co: Surveyor  
 File No. \_\_\_\_\_ Drawing No. \_\_\_\_\_  
 Date Aug. 3, 1960 Scale 400' = 1"

STATE OF WEST VIRGINIA  
 DEPARTMENT OF MINES  
 OIL AND GAS DIVISION  
 CHARLESTON

WELL LOCATION MAP  
 FILE NO. Wet-860-A-#3  
Wet-861-A-#1

+ Denotes location of well on United States Topographic Maps, scale 1 to 62,500, latitude and longitude lines being represented by border lines as shown.  
 - Denotes one inch spaces on border line of original tracing.

39°42'30"

Latitude

80°35'00"

Longitude

2.16s  
1.53w

Topo Location

7.5' Loc. \_\_\_\_\_ 15' Loc. \_\_\_\_\_  
(calc.) \_\_\_\_\_

#72 MTW Co Rept 1909

Company Kanawha

Farm JL Carney #1

15' Quad \_\_\_\_\_  
(sec.)

7.5' Quad Littleton

District Center

WELL LOCATION PLAT

County 103 Permit 76365

New  
861A



STATE OF WEST VIRGINIA  
DEPARTMENT OF MINES  
OIL AND GAS DIVISION

1378

WELL RECORD


Permit No. 861-A Oil or Gas Well oil (KIND)

Company Quaker State Oil Refining Corp.,  
 Address Box 1789, Parkersburg, W. Va.  
 Farm J. L. CARNEY Acres 271  
 Location (waters) \_\_\_\_\_  
 Well No. 1 Elev. \_\_\_\_\_  
 District Center County Wetzel  
 The surface of tract is owned in fee by Webster Henderson  
 Address (Hundred, W. Va.  
(R.F.D.  
 Mineral rights are owned by \_\_\_\_\_  
 Address \_\_\_\_\_  
 Drilling commenced \_\_\_\_\_  
 Drilling completed Jan. 8, 1900  
 Date Shot 7-27 From \_\_\_\_\_ To \_\_\_\_\_  
 With \_\_\_\_\_  
 Open Flow \_\_\_\_\_ /10ths Water in \_\_\_\_\_ Inch  
 \_\_\_\_\_ /10ths Merc. in \_\_\_\_\_ Inch  
 Volume \_\_\_\_\_ Cu. Ft.  
 Rock Pressure \_\_\_\_\_ lbs. \_\_\_\_\_ hrs.  
 Oil \_\_\_\_\_ bbls., 1st 24 hrs.  
 Fresh water \_\_\_\_\_ feet \_\_\_\_\_ feet  
 Salt water \_\_\_\_\_ feet \_\_\_\_\_ feet

Casing and Tubing	Used in Drilling	Left in Well	Packers
Size			Kind of Packer
16			
13	65'		
10	1280'		Size of
<del>8 1/2</del> 8	1840'		
<del>6 5/8</del> 6	1950'		Depth set
5 3/16	2390'		
3			Perf. top
2			Perf. bottom
Liners Used			Perf. top
			Perf. bottom

CASING CEMENTED \_\_\_\_\_ SIZE \_\_\_\_\_ No. Ft. \_\_\_\_\_ Date \_\_\_\_\_  
 COAL WAS ENCOUNTERED AT \_\_\_\_\_ FEET \_\_\_\_\_ INCHES  
 \_\_\_\_\_ FEET \_\_\_\_\_ INCHES FEET \_\_\_\_\_ INCHES  
 \_\_\_\_\_ FEET \_\_\_\_\_ INCHES FEET \_\_\_\_\_ INCHES

Formation	Color	Hard or Soft	Top	Bottom	Oil, Gas or Water	Depth Found	Remarks
Pittsburgh Coal			980				
Little Dunkard			1300	1330			
Big Dunkard			1360	1411			
Gas Sand			1620	1700			
Lower Streak			1750	1820			
Salt Sand--Water			1840	1940			
Pencil Cave			2135				
Keaner Sand			2200				
Big Injun			2240	2450			
Gantz			2765	2780			
50 Ft. Sand			2835	2885			
Top of Stray			2985	3000			
Brake			3000	3010			
Gordon			3010	3033			
Pay			3014				
Bottom of hole				3036			

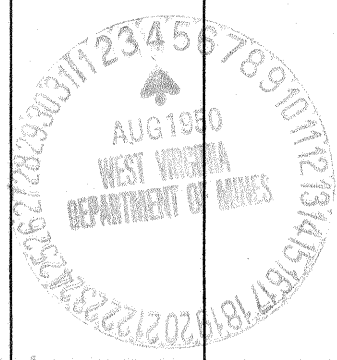

JUN 24 1951

