

Surface owned by L. E. Morgan.  
 Address: Mr. L. E. Morgan, 214, Maple Ave. New Martinsville, W. Va.  
 Coal owned by Benjamin G. Reeder, Trustee.  
 Address: Mr. Benjamin G. Reeder, P.O. Box 842, Morgantown, W. Va.

- New Location...
- Drill Deeper.....
- Abandonment.....

On 400' Map No. 2852, Sqs. N4-5 E 5.

Company William Moses  
 Address Salem, W. Va.  
 Farm I. D. Morgan  
 Tract \_\_\_\_\_ Acres 44 1/10 Lease No. \_\_\_\_\_  
 Well (Farm) No. 19 Serial No. \_\_\_\_\_  
 Elevation (Spirit Level) Floor--944.60  
Ground-944.60  
 Quadrangle Littleton  
 County Wetzel District Grant  
 Engineer Elworth Haines  
 Engineer's Registration No. 2221  
 File No. \_\_\_\_\_ Drawing No. \_\_\_\_\_  
 Date Mar. 24th, 1950, Scale 1" = 800 Feet

STATE OF WEST VIRGINIA  
 DEPARTMENT OF MINES  
 OIL AND GAS DIVISION  
 CHARLESTON

**WELL LOCATION MAP**  
 FILE NO. Wet- 875-A

+ Denotes location of well on United States Topographic Maps, scale 1 to 62,500, latitude and longitude lines being represented by border lines as shown.  
 - Denotes one inch spaces on border line of original tracing.



STATE OF WEST VIRGINIA  
DEPARTMENT OF MINES  
OIL AND GAS DIVISION

1382


Ab  
Permit No. 875-A

WELL RECORD

Oil or Gas Well oil  
(KIND)

Company <u>William Moses</u>	Casing and Tubing	Used in Drilling	Left in Well	Packers
Address <u>Salem, W. Va.</u>				
Farm <u>D. D. Morgan</u> Acres <u>441.7</u>	Size			
Location (waters)				Kind of Packer
Well No. <u>19</u> Elev. <u>944.60</u>	16			
District <u>Grant</u> County <u>Wetzel</u>	13			Size of
The surface of tract is owned in fee by <u>South Penn Natl Gas Co.</u>	10			
<u>Parkburg</u> Address <u>W. Va.</u>	8 1/4			Depth set
Mineral rights are owned by <u>Benjamin S. Reeder, Trustee,</u>	6 7/8		<u>2009</u>	
<u>P.O. Box 842</u> Address <u>Morgantown, W. Va.</u>	5 3/16		<u>2015</u>	
Drilling commenced <u>4/1/97</u>	3			Perf. top
Drilling completed <u>5/11/97</u>	2			Perf. bottom
Date Shot _____ From _____ To _____	Liners Used			Perf. top
With _____				Perf. bottom
Open Flow _____ /10ths Water in _____ Inch				
_____ /10ths Merc. in _____ Inch	CASING CEMENTED _____ SIZE _____ No. Ft. _____ Date _____			
Volume _____ Cu. Ft.				
Rock Pressure _____ lbs. _____ hrs.				
Oil _____ bbls., 1st 24 hrs.	COAL WAS ENCOUNTERED AT <u>707</u> FEET <u>60</u> INCHES			
Fresh water _____ feet _____ feet	_____ FEET _____ INCHES _____ FEET _____ INCHES			
Salt water _____ feet _____ feet	_____ FEET _____ INCHES _____ FEET _____ INCHES			

Formation	Color	Hard or Soft	Top	Bottom	Oil, Gas or Water	Depth Found	Remarks
			<u>707</u>	<u>712</u>			
			<u>1200</u>	<u>1230</u>			
			<u>1600</u>	<u>1765</u>			
			<u>1929</u>	<u>2007</u>			
			<u>2007</u>	<u>2116</u>			
			<u>Total depth 2116</u>				

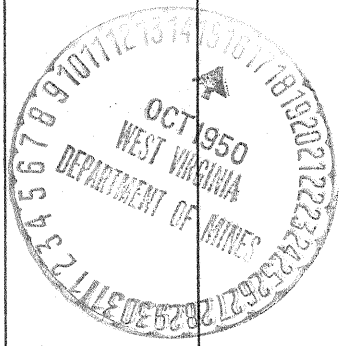

(Over)

NOV 28 1951