


Latitude 39° 35'

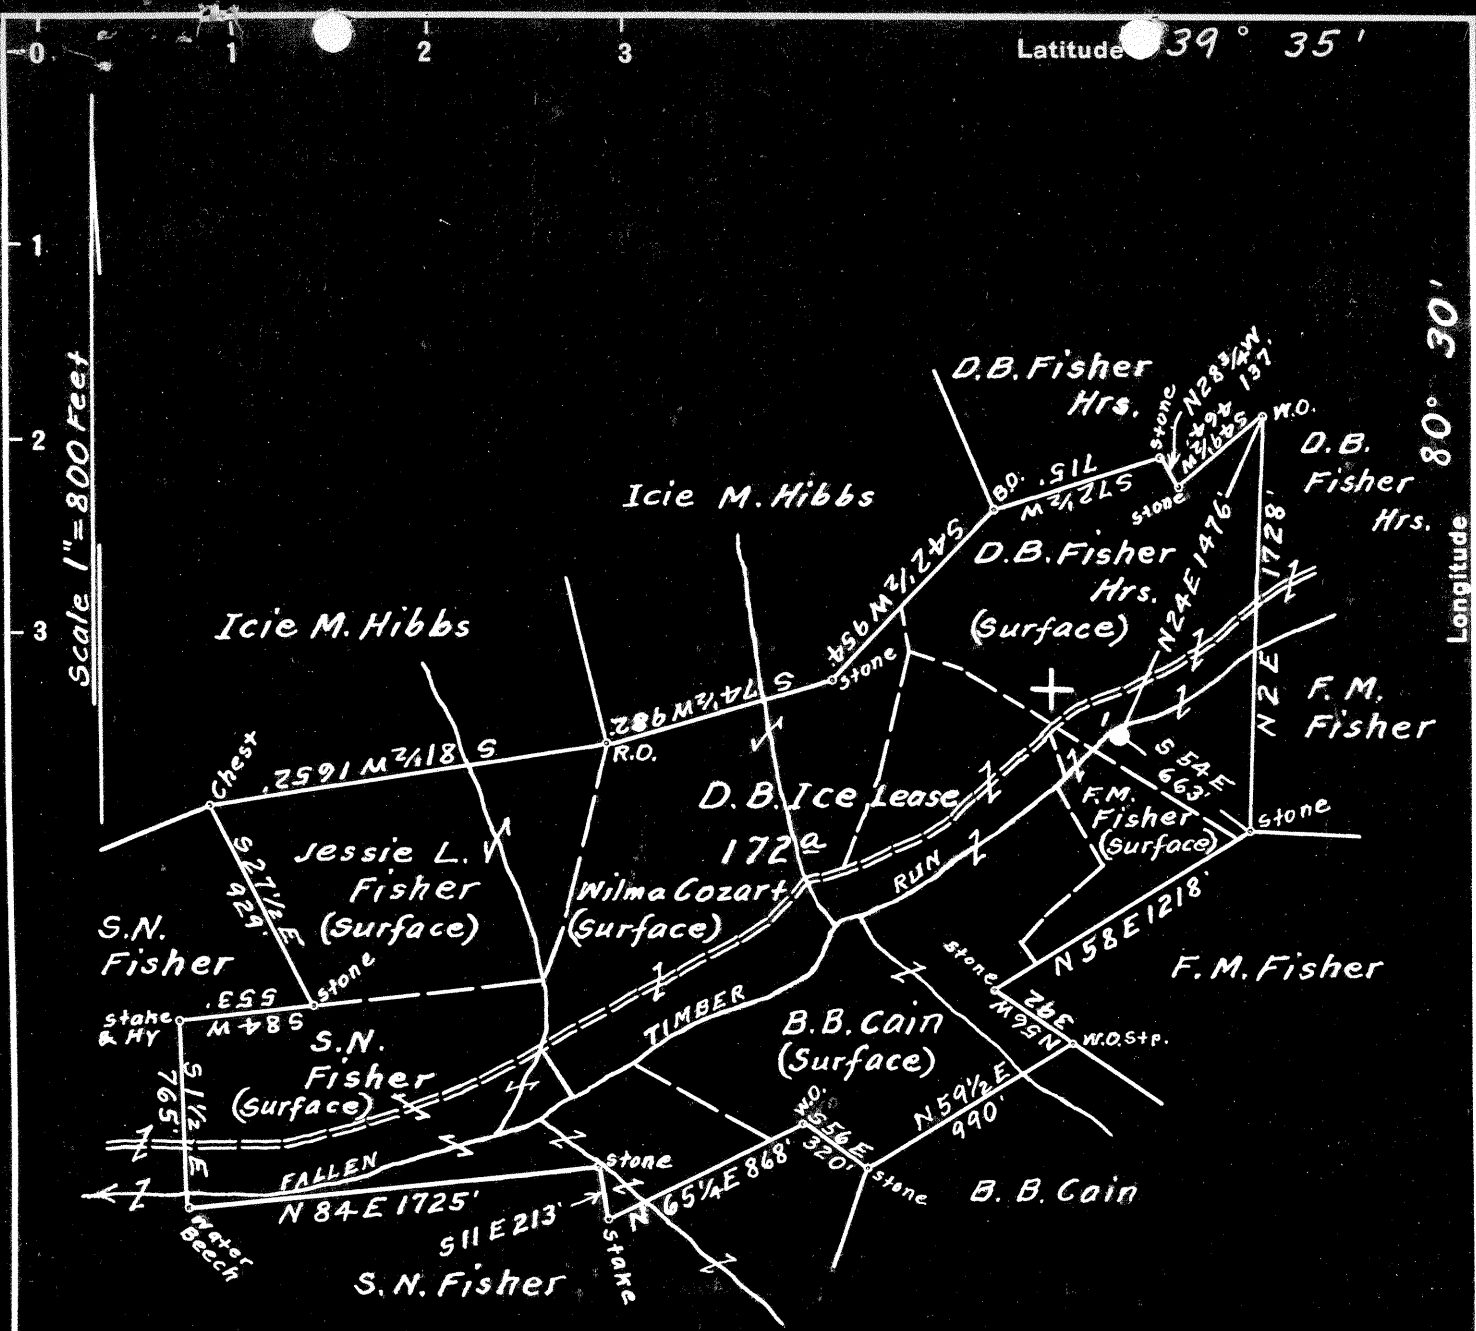

S 3.47
W 2.18

Surface owned by D.B. Fisher Hrs.
Address: Mr. Russell Fisher, R.F.D. No. 1, Smithfield, W. Va.
Coal owned by Benjamin G. Reeder, Trustee.
Address: Mr. Benjamin G. Reeder, P.O. Box 842, Morgantown, W. Va.

- New Location...
- Drill Deeper.....
- Abandonment.....

On 400' Map No. 2752, Sqs. N 6 E 5.

Company	William Moses
Address	Salem, W. Va.
Farm	D.B. Ice
Tract	Acres 172 Lease No.
Well (Farm) No.	1, Serial No.
Elevation (Spirit Level)	Floor -- 1041.67 Ground -- 1039.87
Quadrangle	Littleton
County	Wetzel District Grant
Engineer	Elsworth Haines
Engineer's Registration No.	2221
File No.	Drawing No.
Date	Mar. 7th, 1950, Scale 1" = 800 Feet

STATE OF WEST VIRGINIA
DEPARTMENT OF MINES
OIL AND GAS DIVISION
CHARLESTON

WELL LOCATION MAP
FILE NO. WCT-876-A

+ Denotes location of well on United States Topographic Maps, scale 1 to 62,500, latitude and longitude lines being represented by border lines as shown.
- Denotes one inch spaces on border line of original tracing.



STATE OF WEST VIRGINIA
DEPARTMENT OF MINES
OIL AND GAS DIVISION

1321

WELL RECORD

Permit No. Ab 876 A Oil or Gas Well oil (KIND)

Company WVA
Address 840 WVA
Farm _____ Acres 17 1/2
Location (waters) _____
Well No. _____ Elev. 1041.67
District _____ County _____
The surface of tract is owned in fee by _____
Address _____
Mineral rights are owned by _____
Address 190

Casing and Tubing	Used in Drilling	Left in Well	Packers
Size			Kind of Packer
16			
13			
10			Size of
8 1/4		<u>1702</u>	Depth set
6 1/2		<u>2047</u>	
5 3/16			Perf. top
3			Perf. bottom
2			Perf. top
Liners Used			Perf. bottom

Drilling commenced _____
Drilling completed _____
Date Shot _____ From _____ To _____
With _____
Open Flow _____ /10ths Water in _____ Inch
_____ /10ths Merc. in _____ Inch
Volume _____ Cu. Ft.
Rock Pressure _____ lbs. _____ hrs.
Oil _____ bbls., 1st 24 hrs.
Fresh water _____ feet _____ feet
Salt water _____ feet _____ feet

CASING CEMENTED _____ SIZE _____ No. Ft. _____ Date _____
COAL WAS ENCOUNTERED AT 790 FEET 60 INCHES
_____ FEET _____ INCHES _____ FEET _____ INCHES
_____ FEET _____ INCHES _____ FEET _____ INCHES

Formation	Color	Hard or Soft	Top	Bottom	Oil, Gas or Water	Depth Found	Remarks
<u>Pgh Coal</u>			<u>790</u>	<u>795</u>			
<u>Big Dipper</u>			<u>2033</u>	<u>2165</u>	<u>oil</u>		
<u>2nd Dip</u>				<u>2165</u>			

