

39°37'30"

Latitude

80°27'30"

+

.68s
134w

Longitude

Topo Location

7.5' Loc. _____ 15' Loc. _____
_____ (calc.) _____

Company Carnegie Nat Gas Co

Farm M J Higginbotham #270

15' Quad _____
(sec.)

7.5' Quad Glover Gap

District Church


WELL LOCATION PLAT

County 103 Permit 30903

30903

Church

39°40'

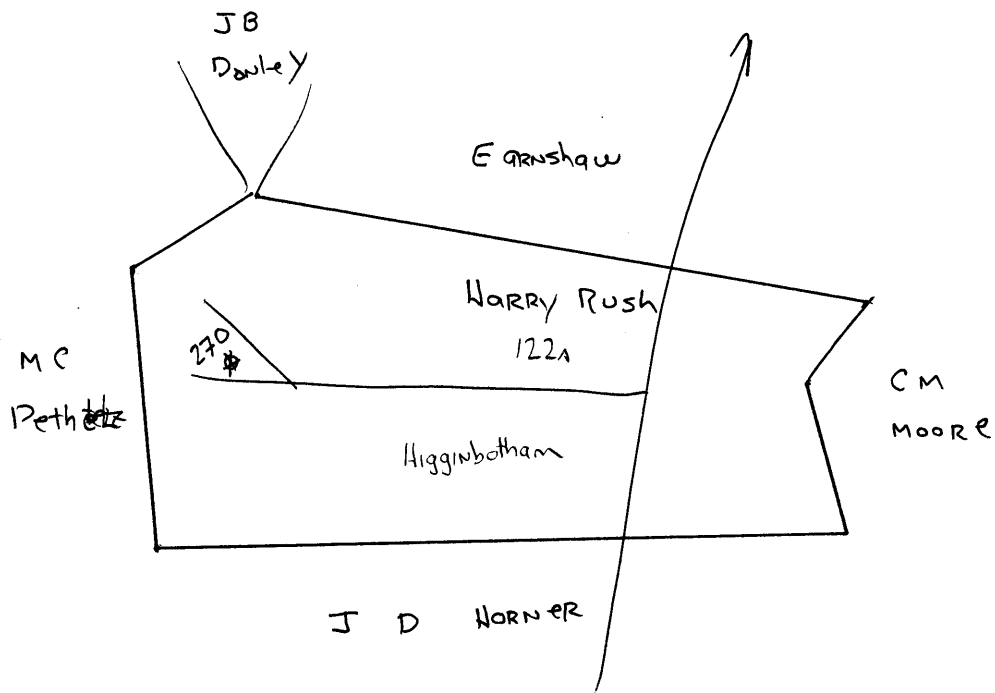

Formation	Color	Hard or Soft	Top	Bottom	Oil, Gas or Water	Depth Found	Remarks

Date May 14, 19 51

APPROVED CARNEGIE NATURAL GAS COMPANY, Owner

By B. H. Archer Land Agent
(Title)