

39°45'00"

Latitude

80°25'00"

Longitude

2.625
.09w

Topo Location

7.5' Loc. _____ 15' Loc. _____
 (calc.) _____

Company Valley Stead Prods

Farm BR Sime #1


15' Quad _____
(sec.)

7.5' Quad Hundred

District Church

WELL LOCATION PLAT

County 103 Permit 30950

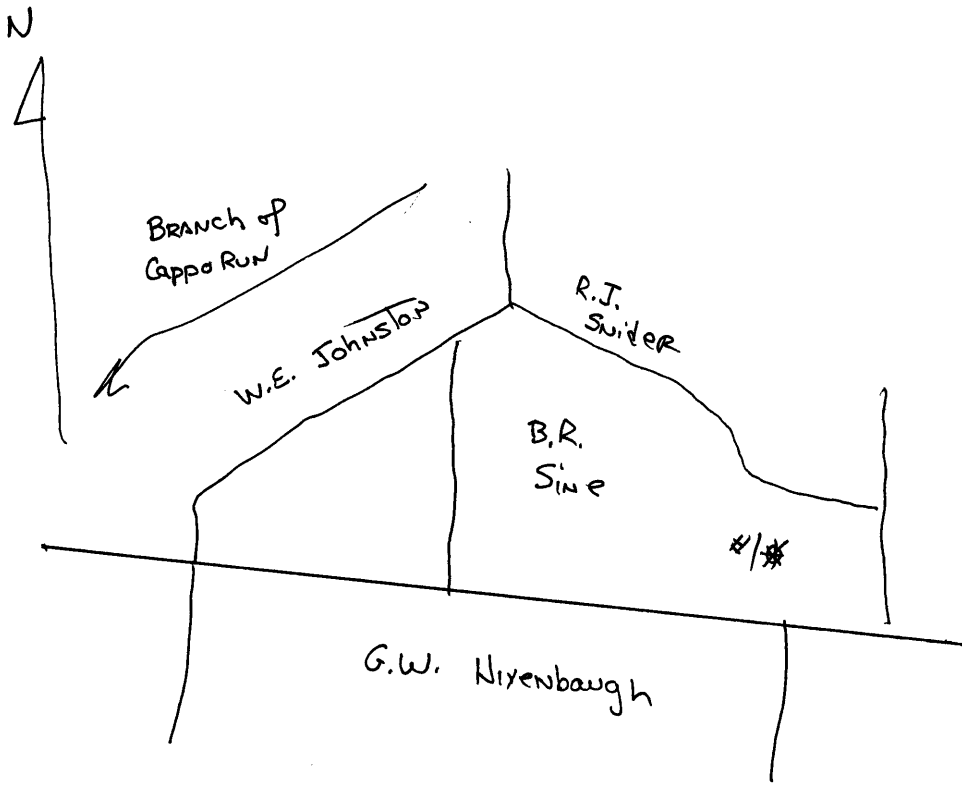



STATE OF WEST VIRGINIA
DEPARTMENT OF MINES
OIL AND GAS DIVISION

1387

WELL RECORD


Permit No. 950-A Oil or Gas Well X (KIND)

Company Valley Steel Products Company
 Address St. Louis, Mo.
 Farm E. R. Sine Acres 26
 Location (waters) Br. Capps Run
 Well No. 1 Elev. 1454'
 District Church County Netzel
 The surface of tract is owned in fee by _____
 Address _____
 Mineral rights are owned by _____
 Address _____
 Drilling commenced _____
 Drilling completed _____
 Date Shot _____ From _____ To _____
 With _____
 Open Flow _____ /10ths Water in _____ Inch
 _____ /10ths Merc. in _____ Inch
 Volume _____ Cu. Ft.
 Rock Pressure _____ lbs. _____ hrs.
 Oil _____ bbls., 1st 24 hrs.
 Fresh water _____ feet _____ feet
 Salt water _____ feet _____ feet

Casing and Tubing	Used in Drilling	Left in Well	Packers
Size			Kind of Packer
16			
13			
10			Size of
8 1/4	1387'	1387'	
6 3/4	2604'	2604'	Depth set
5 3/16			
3			Perf. top
2	3400'	3400'	Perf. bottom
Liners Used			Perf. top
			Perf. bottom

CASING CEMENTED _____ SIZE _____ No. Ft. _____ Date _____
 COAL WAS ENCOUNTERED AT _____ FEET _____ INCHES
 _____ FEET _____ INCHES _____ FEET _____ INCHES
 _____ FEET _____ INCHES _____ FEET _____ INCHES

Formation	Color	Hard or Soft	Top	Bottom	Oil, Gas or Water	Depth Found	Remarks
Fairview Coal			914				
Mapletown Coal			1154	1160			
Pittsburgh Coal			1254	1263			
Dunkard Sand			1759	1814			
Gas Sand			2054	2109			
Salt Sand			2124	2299	Water 2144'		
Maxon Sand			2384	2434			
Big Lime			2434	2504			
Big Injun			2504	2753	Gas 2534		
Fifty-Foot Sand			3211	3271			
Stray Sand			3337	3354			
Gordon Sand			3387	3401			
Fourth Sand			3404'				
1st Pay			3429				
Total Depth, approximately				3450'			

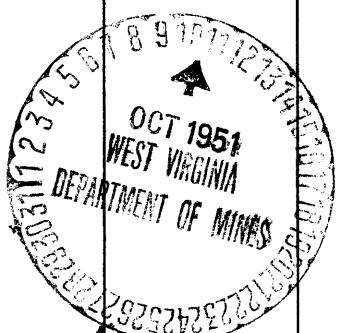

JAN 16 1952