

Latitude

1.51s
.76s

Longitude

Topo Location

7.5' Loc. _____ 15' Loc. _____
 _____ (calc.) _____

Company Quaker State Oil Ref. Corp.

Farm W.W. Lemasters #1


15' Quad _____
(sec.)

7.5' Quad Wileyville

District Center

WELL LOCATION PLAT

County 103 Permit 30978

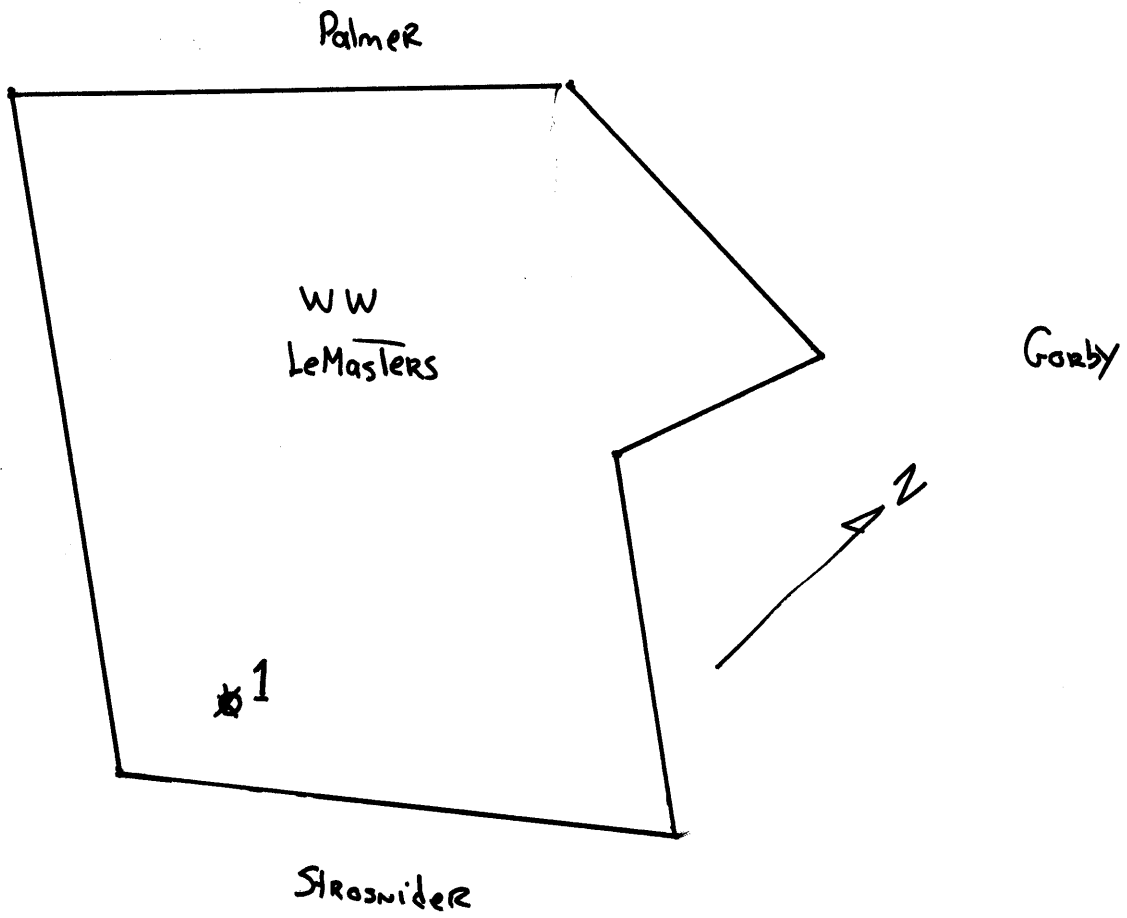



STATE OF WEST VIRGINIA
DEPARTMENT OF MINES
OIL AND GAS DIVISION

1393

WELL RECORD

Oil or Gas Well Oil
(KIND)

Permit No. 918-A

Company Quaker State Oil Refining Corp.
Address Box 1789 Parkersburg, W. Va.
Farm W. W. Lemasters Acres 85
Location (waters) Steals Run
Well No. 1 Elev. 1,127'
District Center County Wetzel
The surface of tract is owned in fee by _____
Address _____
Mineral rights are owned by _____
Address _____
Drilling commenced _____
Drilling completed Nov. 16, 1904
Date Shot _____ From _____ To _____
With _____

Casing and Tubing	Used in Drilling	Left in Well	Packers
Size			Kind of Packer
16			Wall
13			Size of <u>6-5/8" x</u>
10	780	---	<u>5-3/16"</u>
8 1/4	1460	---	Depth set <u>?</u>
6 5/8	2280	2280	
5 3/16	Yes	Yes	
3			Perf. top
2	3147	3147	Perf. bottom
Liners Used			Perf. top
			Perf. bottom

Open Flow _____ /10ths Water in _____ Inch
_____ /10ths Merc. in _____ Inch
Volume _____ Cu. Ft.
Rock Pressure _____ lbs. _____ hrs.
Oil Yes _____ bbls., 1st 24 hrs.
Fresh water _____ feet _____ feet
Salt water _____ feet _____ feet

CASING CEMENTED _____ SIZE _____ No. Ft. _____ Date _____
COAL WAS ENCOUNTERED AT 1,100 FEET _____ INCHES
_____ FEET _____ INCHES FEET _____ INCHES
_____ FEET _____ INCHES FEET _____ INCHES

Formation	Color	Hard or Soft	Top	Bottom	Oil, Gas or Water	Depth Found	Remarks
<u>Coal-Pittsburgh</u>			1100				
<u>Sand-Gordon</u>			3123				
Total Depth				3147			



(Over)
DEC 2 1952

