

Latitude

Longitude

281s  
.52w

Topo Location

7.5' Loc. \_\_\_\_\_ 15' Loc. \_\_\_\_\_  
\_\_\_\_\_ (calc.) \_\_\_\_\_

#234 MTW Co Rep 1909

Company Tri-State

Farm Lot Maston #1

15' Quad \_\_\_\_\_  
(sec.)

7.5' Quad Pine Grove

District Green

WELL LOCATION PLAT

County 103 Permit 70492

now: 103-30981



STATE OF WEST VIRGINIA  
DEPARTMENT OF MINES  
OIL AND GAS DIVISION

1408

WELL RECORD

Permit No. 981A Oil or Gas Well Gas (KIND)


Company <u>THE MANUFACTURERS LIGHT AND HEAT COMPANY</u>	Casing and Tubing	Used in Drilling	Left in Well	Packers
Address <u>800 Union Trust Bldg., Pittsburgh, Pa.</u>	Size			
Farm <u>Lot Martin</u> Acres <u>200</u>	16			Kind of Packer
Location (waters)	13			
Well No. <u>1343</u> Elev.	10	<u>440'</u>	<u>440'</u>	Size of <u>6 5/8 x 3"</u>
District <u>Green</u> County <u>Wetzel</u>	8 1/4	<u>1035'</u>	<u>1035'</u>	Depth set <u>80'</u>
The surface of tract is owned in fee by <u>Lot and Mary Martin</u>	6%	<u>1825'</u>	<u>1825'</u>	
Address <u>Reader, W. Va.</u>	5 3/16			
Mineral rights are owned by <u>The Mfrs. Light &amp; Heat Co.</u>	3		<u>2537'</u>	Perf. top
<u>Union Trust Bldg. Address Pgh., Pa.</u>	2			Perf. bottom
Drilling commenced <u>October 2, 1903</u>	Liners Used			Perf. top
Drilling completed <u>November 11, 1903</u>				Perf. bottom
Date Shot From To				
With				

Open Flow /10ths Water in \_\_\_\_\_ Inch  
 \_\_\_\_\_ /10ths Merc. in \_\_\_\_\_ Inch  
 Volume \_\_\_\_\_ Cu. Ft.  
 Rock Pressure 375 lbs. \_\_\_\_\_ hrs.  
 Oil \_\_\_\_\_ bbls., 1st 24 hrs.  
 Fresh water \_\_\_\_\_ feet \_\_\_\_\_ feet  
 Salt water \_\_\_\_\_ feet \_\_\_\_\_ feet

CASING CEMENTED \_\_\_\_\_ SIZE \_\_\_\_\_ No. Ft. \_\_\_\_\_ Date \_\_\_\_\_

COAL WAS ENCOUNTERED AT 435 FEET \_\_\_\_\_ INCHES  
 \_\_\_\_\_ FEET \_\_\_\_\_ INCHES FEET \_\_\_\_\_ INCHES  
 \_\_\_\_\_ FEET \_\_\_\_\_ INCHES FEET \_\_\_\_\_ INCHES

Formation	Color	Hard or Soft	Top	Bottom	Oil, Gas or Water	Depth Found	Remarks
Coal			435				
Dunkard Sand			850	950			
Gas Sand			1055	1075			
Salt Sand			1265	1490			
Maxton Sand			1565	1595			
Lime Sand			1640	1695			
Injun Sand			1695	1940			
Gordon Sand			2508				
					Gas at 2512		
					Bottom hole 2537 feet.		

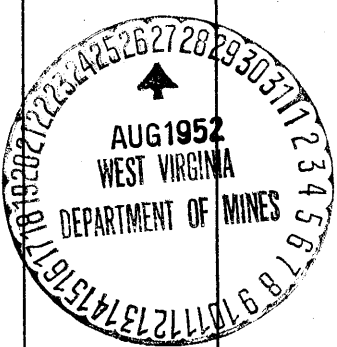

FEB 11 1953 (Over)