

COAL OWNED BY _____

NEW LOCATION.....

DRILL DEEPER.....

ABANDONMENT.....

AUG 30 1955

Y-42 W

3.71 3.78

COMPANY The Manufacturers Light & Heat Co.

ADDRESS 800 Union Trust Bldg. Pgh. Pa.

FARM (Okey Morgan) Wm. Conley

TRACT _____ ACRES 25 LEASE NO. 3018

WELL (FARM) NO. 1 SERIAL NO. 1336

ELEVATION (SPIRIT LEVEL) 1269.97'

QUADRANGLE Littleton

COUNTY Wetzel DISTRICT Green

ENGINEER John A. Landon

ENGINEER'S REGISTRATION NO. 12710

FILE NO. _____ DRAWING NO. Y-15-262

DATE 28 June 1955 SCALE 1" = 400'

STATE OF WEST VIRGINIA
DEPARTMENT OF MINES
OIL AND GAS DIVISION
CHARLESTON

WELL LOCATION MAP

FILE NO. WET-1013-A

+ DENOTES LOCATION OF WELL ON UNITED STATES TOPOGRAPHIC MAPS. SCALE 1 TO 62,500. LATITUDE AND LONGITUDE LINES BEING REPRESENTED BY BORDER LINES AS SHOWN.

- DENOTES ONE INCH SPACES ON BORDER LINE OF ORIGINAL TRACING.

(OKEY MORGAN)
WM. CONLEY No. 1 (1336) - M, L, & H, Co. - WET-1013 A



STATE OF WEST VIRGINIA
DEPARTMENT OF MINES
OIL AND GAS DIVISION

WELL RECORD

1497

Permit No. 1497 Oil or Gas Well Oil (KIND)


Company THE MANUFACTURERS LIGHT AND HEAT COMPANY
Address 800 UNION TRUST BLDG., PGH., PENNA.
Farm Wm. Conley Acres 25
Location (waters) _____
Well No. 1336 Elev. 1269.97'
District Greene County Wetzel
The surface of tract is owned in fee by _____
Address _____
Mineral rights are owned by _____
Address _____
Drilling commenced Mar. 31, 1905
Drilling completed May 18, 1905
Date Shot _____ From _____ To _____
With _____

Casing and Tubing	Used in Drilling	Left in Well	Packers
Size			Kind of Packer
16			
13			
10	145	145	Size of 3 x 6-5/8
8 1/4	1390	1390	
6 3/8	2380	2380	Depth set 2937
5 3/16			
3		3028	Perf. top
2			Perf. bottom
Liners Used			Perf. top
			Perf. bottom

Open Flow _____ /10ths Water in _____ Inch
_____ /10ths Merc. in _____ Inch
Volume _____ Cu. Ft.
Rock Pressure 480 lbs. _____ hrs.
Oil _____ bbls., 1st 24 hrs.
Fresh water _____ feet _____ feet
Salt water _____ feet _____ feet

CASING CEMENTED _____ SIZE _____ No. Ft. _____ Date _____
COAL WAS ENCOUNTERED AT 958 FEET _____ INCHES
_____ FEET _____ INCHES FEET _____ INCHES
_____ FEET _____ INCHES FEET _____ INCHES

Formation	Color	Hard or Soft	Top	Bottom	Oil, Gas or Water	Depth Found	Remarks
Pgh. Coal			958				
Little Dunkard	Sand		1300	1350			
Big Dunkard			1390	1430			
Gas Sand			1640	1680			
Salt Sand			1758	2050			
Maxon Sand		2000	2100	2120			
Blue Monday			2150	2185			
Big Line			2185	2258			
Big Indian Sand			2258	2488			
Gordon Sand			3006	3027			
Gas			3019				
Total Depth			3077				

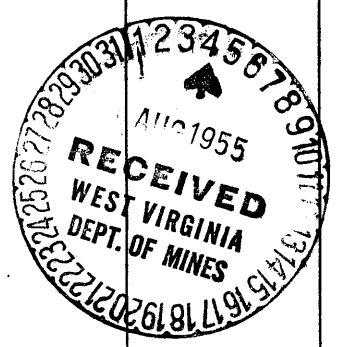

OCT 6 1955

