


Latitude 39° 35'

Longitude 80° 45'

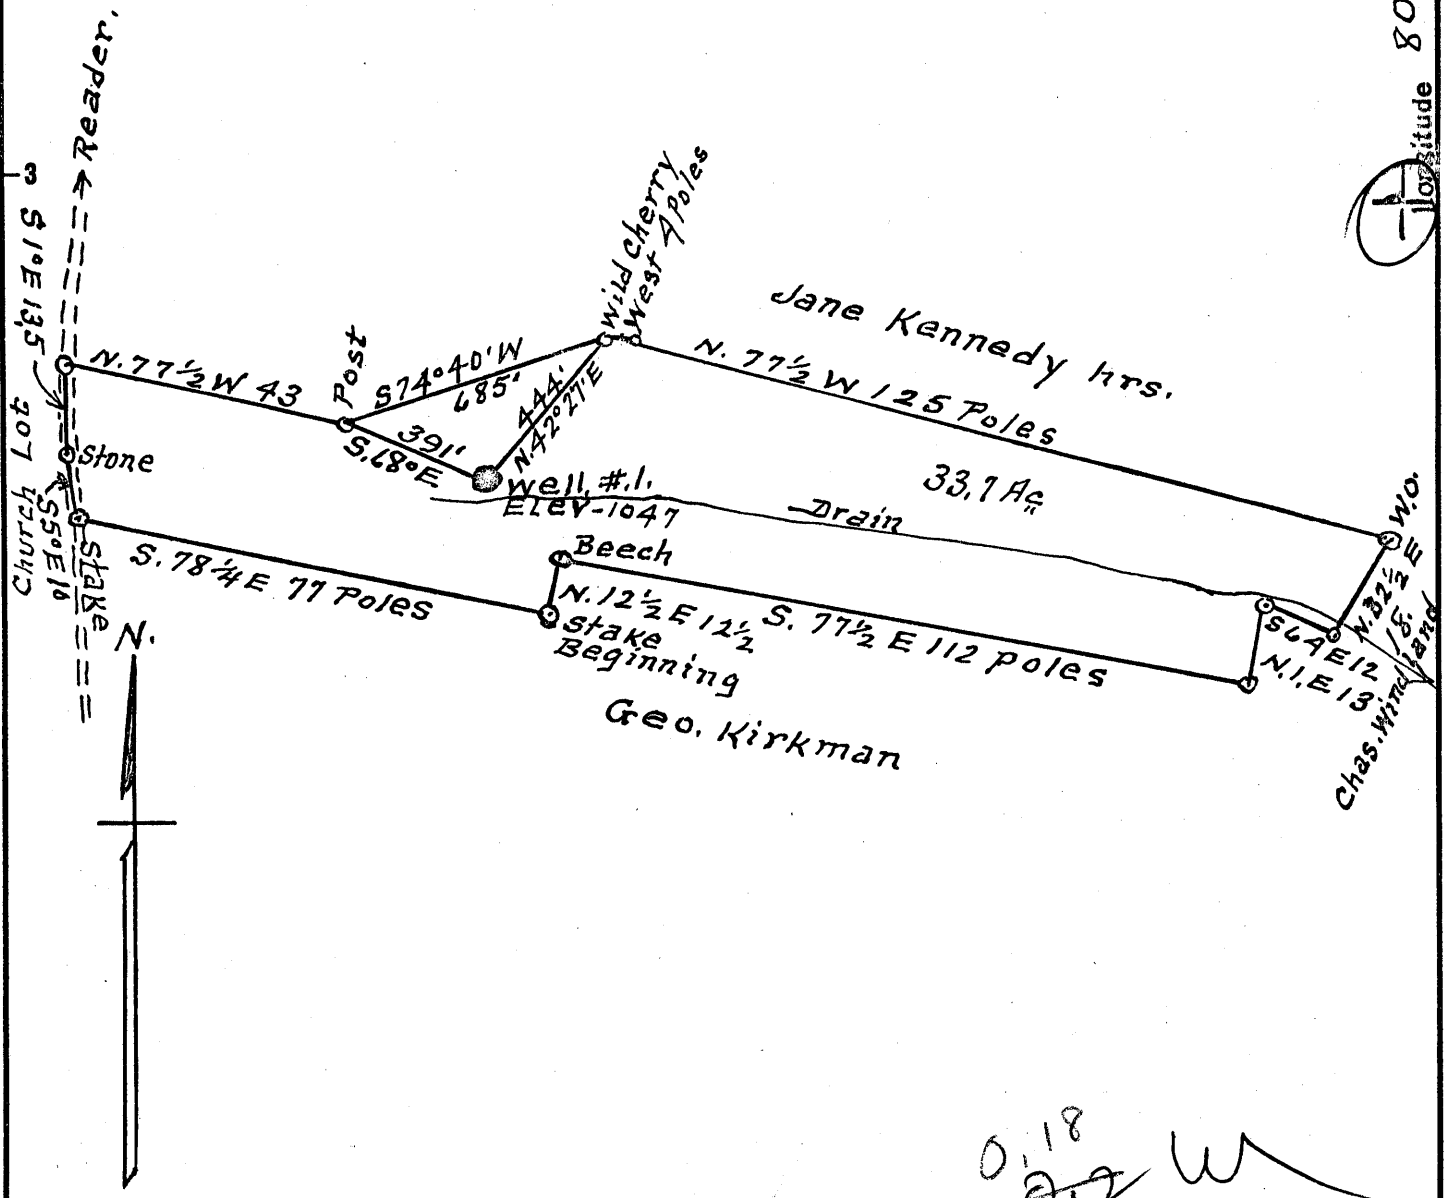

0.18  
 3.22 3.78  
 Surface = Hush Mingux  
 Pine Grove, W. Va.  
 No marketable Coal.

New Location...   
 Drill Deeper...   
 Abandonment...

DEC 17 1957

Company A.M. Snider  
 Address Hundred W Va.  
 Farm Lucretia Windland  
 Tract 1 Acres 33.7 Lease No. \_\_\_\_\_  
 Well (Farm) No. 1 Serial No. 707  
 Elevation (Spirit Level) 1047'  
 Quadrangle New Martinsville  
 County Wetzel District Greene  
 Engineer A. L. Headley  
 Engineer's Registration No. 42021  
 File No. \_\_\_\_\_ Drawing No. \_\_\_\_\_  
 Date 11-18-57 Scale 1" = 500'

STATE OF WEST VIRGINIA  
 DEPARTMENT OF MINES  
 OIL AND GAS DIVISION  
 CHARLESTON

WELL LOCATION MAP  
 FILE NO. Wet-1078-A

+ Denotes location of well on United States Topographic Maps, scale 1 to 62,500, latitude and longitude lines being represented by border lines as shown.

- Denotes one inch spaces on border line of original tracing.