


Rocki - Spartan

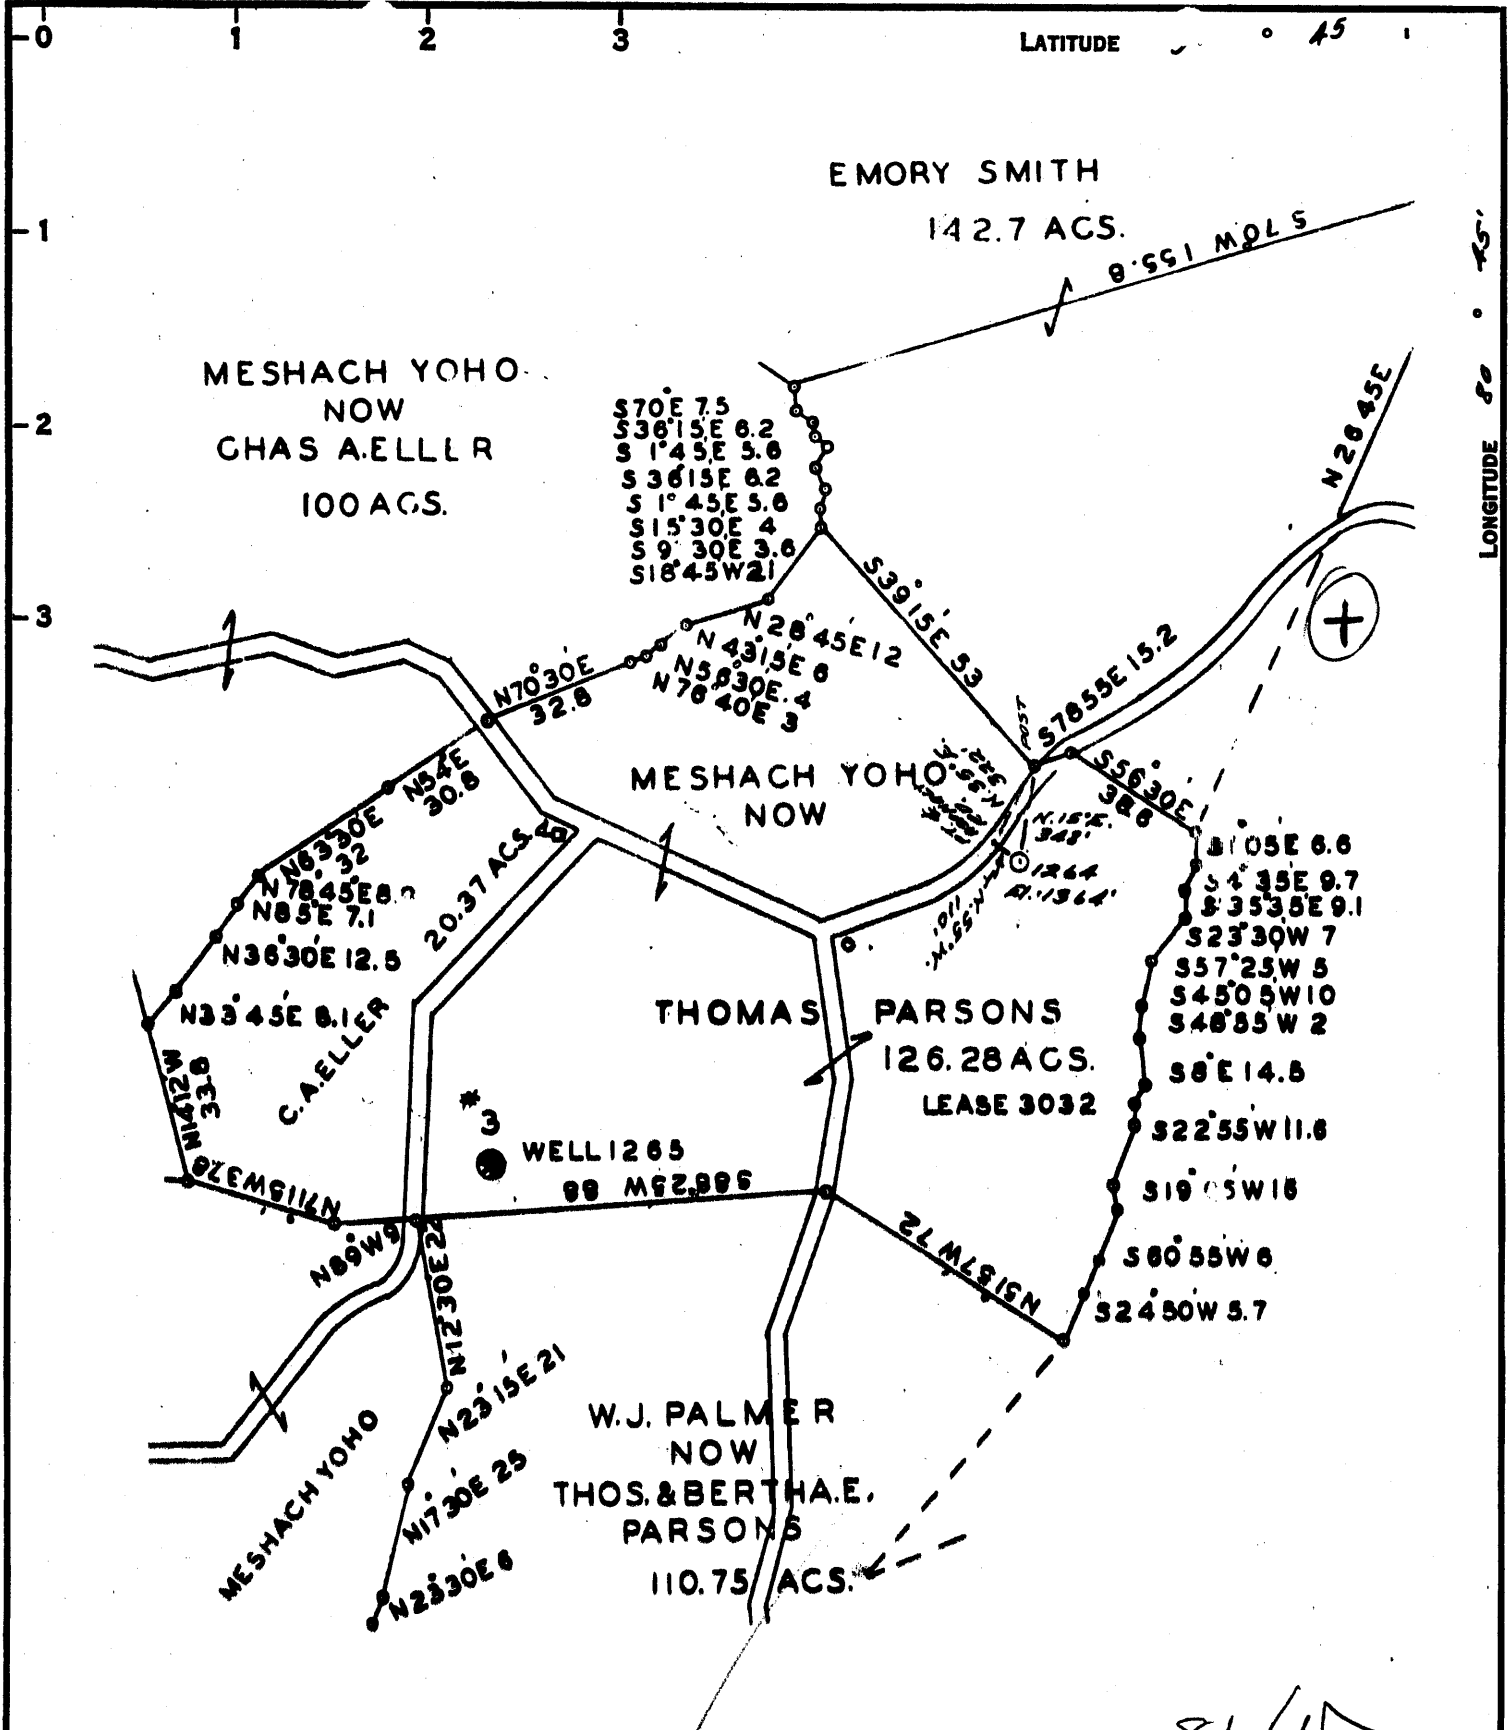

COAL OWNED BY _____

NEW LOCATION.....

DRILL DEEPER.....

ABANDONMENT.....

NOV 16 1959

COMPANY THE MANUFACTURERS LIGHT & HEAT

ADDRESS 800 UNION TRUST BLDG. PENN. PD.

FARM MESHACK YOHO

TRACT _____ ACRES 300 LEASE No. 3032

WELL (FARM) No. 1 SERIAL No. 1265

ELEVATION (SPIRIT LEVEL) 1364'

QUADRANGLE NEW MARTINSVILLE

COUNTY WETZEL DISTRICT PROCTOR

ENGINEER Thomas E. Virgin M.

ENGINEER'S REGISTRATION No. 1503

FILE No. _____ DRAWING No. Y-25-33

DATE 8 OCT. 1959 SCALE 1"=660

STATE OF WEST VIRGINIA
DEPARTMENT OF MINES
OIL AND GAS DIVISION
CHARLESTON

WELL LOCATION MAP

FILE No. WGT-1101-A

+ DENOTES LOCATION OF WELL ON UNITED STATES TOPOGRAPHIC MAPS, SCALE 1 TO 62,500. LATITUDE AND LONGITUDE LINES BEING REPRESENTED BY BORDER LINES AS SHOWN.

- DENOTES ONE INCH SPACES ON BORDER LINE OF ORIGINAL TRACING.

MESHACK YOHO No. 1 (1264) - M. L. & H. Co. - WGT-1101-A