


Latitude 39° 40'

Longitude 80° 35'

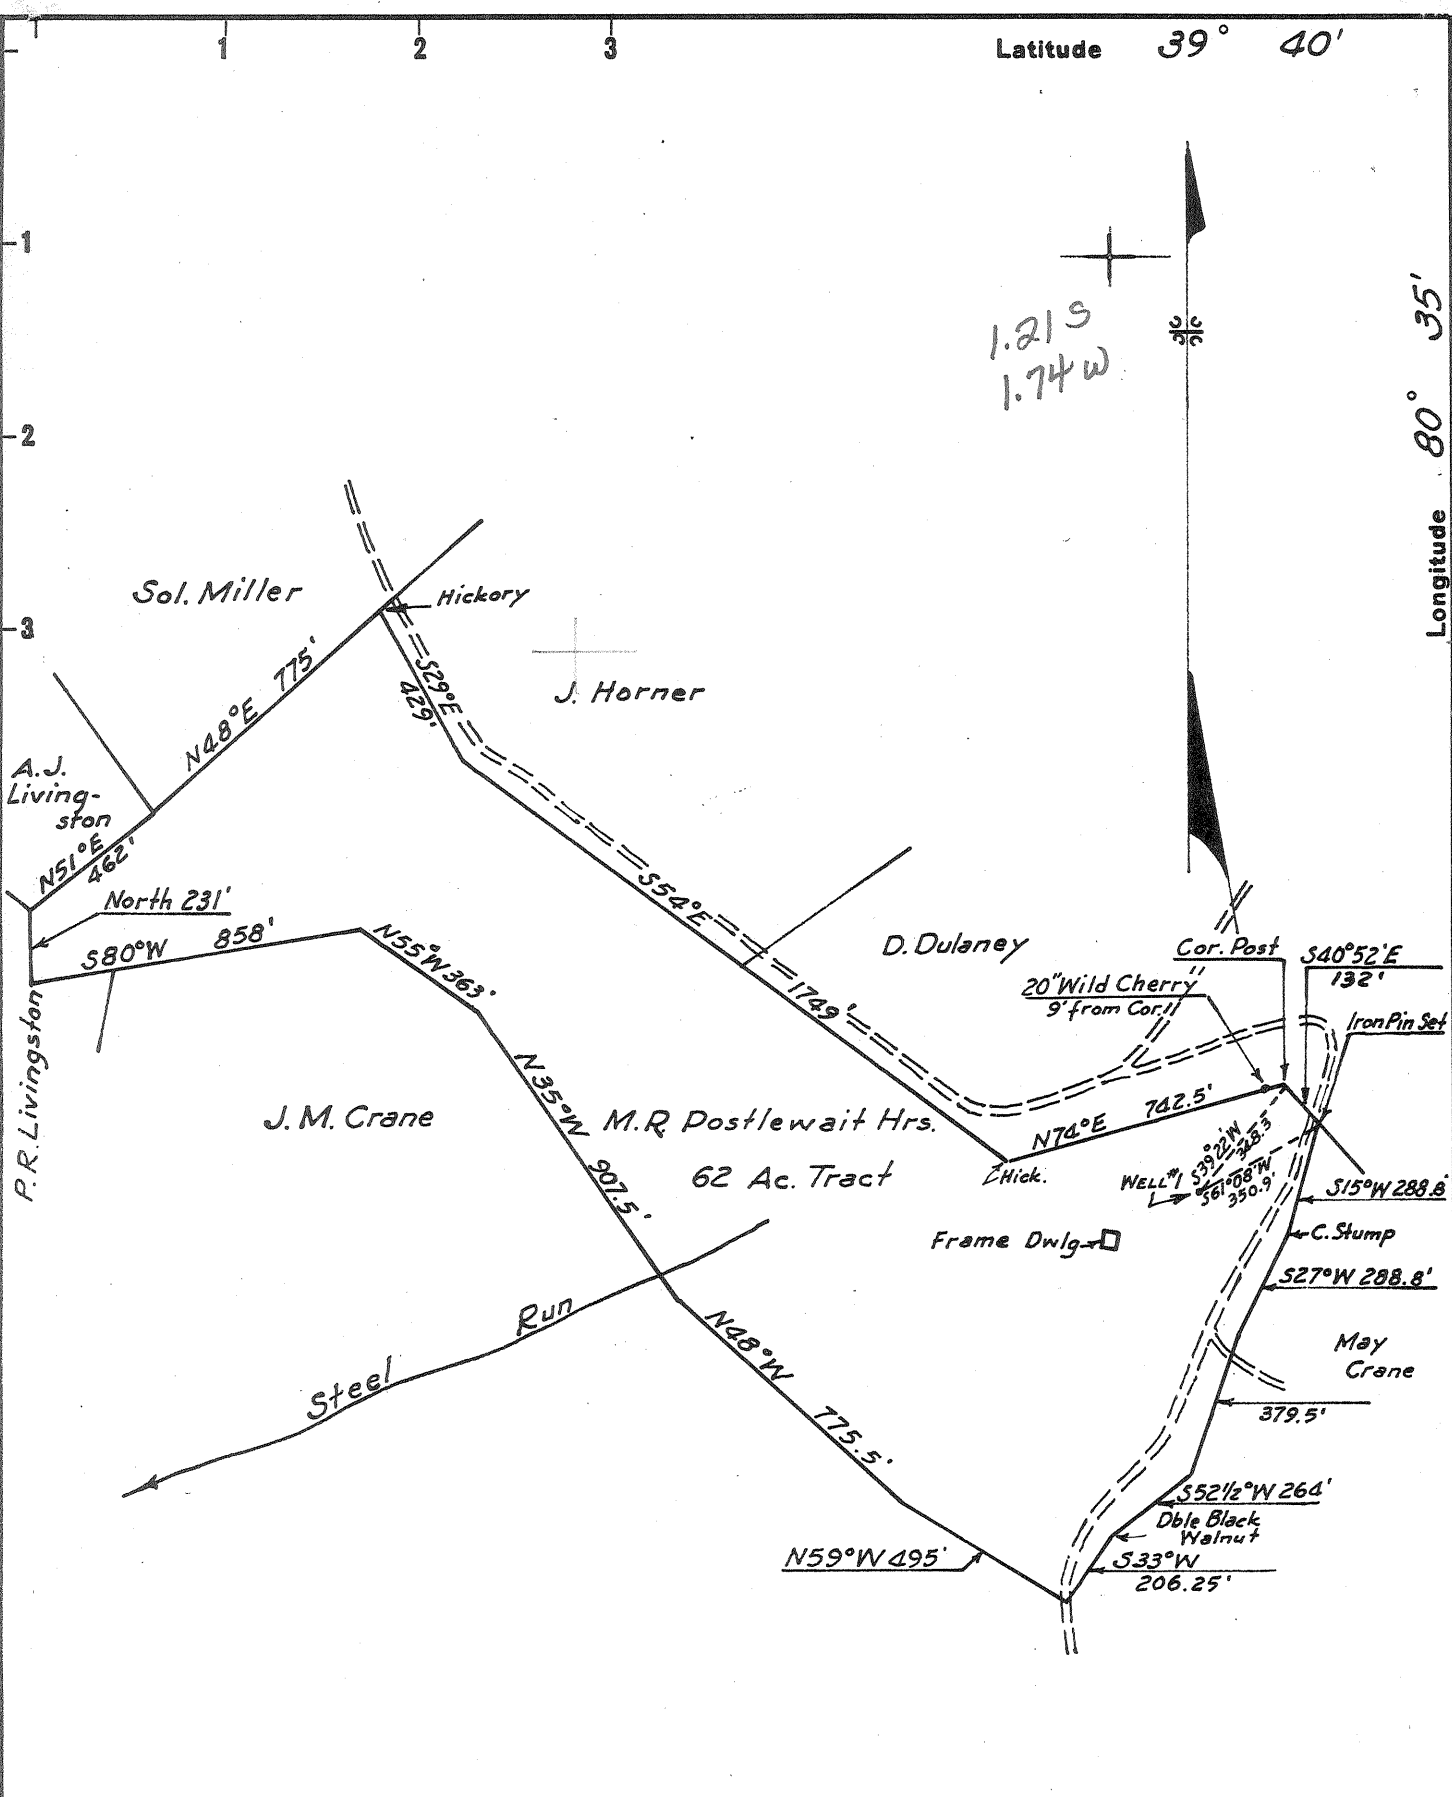

New Location..
 Drill Deeper.....
 Abandonment.....

Company Quaker State Oil Refining Corp.
 Address Box 1789, Parkersburg, W. Va.
 Farm M. R. Postlewait Hrs.
 Tract _____ Acres 62 Lease No. _____
 Well (Farm) No. 1 Serial No. _____
 Elevation (Spirit Level) 1468.4
 Quadrangle Littleton EV
 County Wetzel District Center
 Engineer [Signature]
 Engineer's Registration No. 2492
 File No. _____ Drawing No. _____
 Date June 26, 1962 Scale 500'

STATE OF WEST VIRGINIA
 DEPARTMENT OF MINES
 OIL AND GAS DIVISION
 CHARLESTON

WELL LOCATION MAP
 FILE NO. WET-1147-R

+ Denotes location of well on United States Topographic Maps, scale 1 to 62,500, latitude and longitude lines being represented by border lines as shown.
 - Denotes one inch spaces on border line of original tracing.



103 1147A

STATE OF WEST VIRGINIA
DEPARTMENT OF MINES
OIL AND GAS DIVISION

Quadrangle Littleton

WELL RECORD

Oil or Gas Well

Permit No. WET-1147

Company Waver State Oil Refining Corp.
Address Box 1927 Parkersburg, W. Va.
Farm Wardlaw Postlethwaite Acres 60
Location (waters) Steel Run
Well No. One Elev. 1168.4
District Center County Putnam
The surface of tract is owned in fee by M. A. Postlethwaite
New Martinsville, W. Va. Address _____
Mineral rights are owned by Same
Address _____
Drilling commenced _____
Drilling completed July 5, 1904
Date Shot 6-27-23 From - To -
With 40 gts.

Casing and Tubing	Used in Drilling	Left in Well	Packers
Size			
16			Kind of Packer
13			
10	1090		Size of
8 1/2	1200		
6 3/4	2300		Depth set
5 3/16	2735		
3			Perf top
2			Perf bottom
Liners Used			Perf top
			Perf bottom

Open Flow /10ths Water in _____ Inch
/10ths Merc. in _____ Inch
Volume _____ Cu. Ft.
Rock Pressure _____ lbs. _____ hrs.
Oil _____ bbls., 1st 24 hrs.
WELL ACIDIZED _____

CASING CEMENTED _____ SIZE _____ No. Ft. _____ Date _____
COAL WAS ENCOUNTERED AT 1398 FEET _____ INCHES
FEET _____ INCHES FEET _____ INCHES
FEET _____ INCHES FEET _____ INCHES

WELL FRACTURED _____

RESULT AFTER TREATMENT _____

ROCK PRESSURE AFTER TREATMENT _____

Fresh Water _____ Feet Salt Water _____ Feet

Formation	Color	Hard or Soft	Top	Bottom	Oil, Gas or Water	Depth	Remarks
Pitts Coal			1368				
Sand (Gordon)			3380				
Gas			3380				
Oil			3397				
Oil			3402				
Total Depth				3407			

