

Map Sheet 32 N H E7 FB 167 Page 74

Minimum Error of Closure $1'' = 200'$
 Source of Elevation ELEV. FROM U.S.G.S.-U.F. ELEV. 1980.0'

New Location I, the undersigned, hereby certify that this map is correct to the best of my know-
 Drill Deeper ledge and belief and shows all the information required by paragraph 6 of the rules
 Abandonment and regulations of the oil and gas section of the mining laws of West Virginia."

Company	HODE NATURAL GAS Co
Address	CLARKSBURG, W.VA.
Farm	E.E. GLOVER
Tract	Acres 85 Lease No. 24303
Well (Farm) No.	Serial No. 3895
Elevation (Spirit Level)	1342.0'
Quadrangle	LITTLETON EG
County	WETZEL District GRANT
Engineer	Jackson M. Jarvis
Engineer's Registration No.	2397
File No.	Drawing No.
Date	11-10-64 Scale 1" = 40 POLES

STATE OF WEST VIRGINIA
 DEPARTMENT OF MINES
 OIL AND GAS DIVISION
 CHARLESTON

WELL LOCATION MAP
 FILE NO. WET-1177-A

+ Denotes location of well on United States Topographic Maps, scale 1 to 62,500, latitude and longitude lines being represented by border lines as shown.

- Denotes one inch spaces on border line of original tracing.

STATE OF WEST VIRGINIA
DEPARTMENT OF MINES
OIL AND GAS DIVISION

AFFIDAVIT OF PLUGGING AND FILLING WELL

AFFIDAVIT SHOULD BE MADE IN TRIPPLICATE. ONE COPY MAILED TO THE DEPARTMENT. ONE COPY TO BE RETAINED BY THE WELL OPERATOR AND THE THIRD COPY (AND EXTRA COPIES IF REQUIRED) SHOULD BE MAILED TO EACH COAL OPERATOR AT THEIR RESPECTIVE ADDRESSES.

NO OPERATIONS
COAL OPERATOR OR OWNER
ADDRESS
TACA COAL COMPANY
725
LIBERTY AVE., PITTSBURGH, PENNA.
SURFACE:
HERMAN BRADLEY
LEASE OR PROPERTY OWNER
NEW MARTINSVILLE, WEST VIRGINIA
ADDRESS

CONSOLIDATED GAS SUPPLY CORPORATION
BOX 1951
CLARKSBURG, WEST VIRGINIA
COMPLETE ADDRESS
APRIL 30, 1965
WELL AND LOCATION
GRANT
WETZEL
County
Well No. 3895
E. E. GLOVER
Farm

STATE INSPECTOR SUPERVISING PLUGGING Brian Shuman

AFFIDAVIT


STATE OF WEST VIRGINIA,

County of *Marion*

SS:

Don Eddy and *Johnnie Tennant*
being first duly sworn according to law depose and say that they are experienced in the work of plugging and filling oil and gas wells and were employed by *F. M. Chisler* well operator, and participated in the work of plugging and filling the above well, that said work was commenced on the 18 day of *May*, 1965, and that the well was plugged and filled in the following manner:

SAND OR ZONE RECORD	FILLING MATERIAL	PLUGS USED	CASING	
			CSG PULLED	CSG LEFT IN
FORMATION		SIZE & KIND		
filled With Mud&Clay	2200-2770			
placed Cement Bridge	2380-2365			
filled With Mud&Clay	2365-2270			
placed Cement Plug	2270-2255			
installed Bridge	2080-2065			
filled With Clay	2065-1755			
placed Cement Plug	1755-1740			
installed Bridge	1490-1475			
filled With Clay	1475-1387			
Installed Bridge&Cemented Solid Through Coal	1040-800			
filled With Clay	890-740			
installed Bridge At	240-225			
filled With Clay	225-10			
Installed 13FT. Marker, 10ft. Cemented in, 3FT. Above Ground.				
COAL SEAMS				
(NAME)				
(NAME)				
(NAME)				
(NAME)				

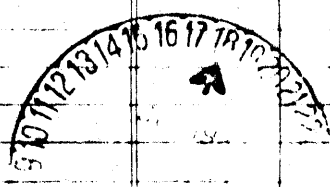

and that the work of plugging and filling said well was completed on the 20th day of October, 1965.

And further deponents saith not.

Sworn to and subscribed before me this 13 day of July, 1967.

My commission expires:

July 16, 1974

Don Eddy
Johnnie Tennant
Gladys M. Frost
Notary Public.

Permit No.

WET-1177 A