


39° 40'

Latitude

80° 40'

Longitude

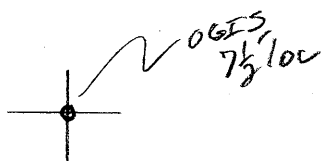

Topo Location

7.5' Loc.	<u>1.89 S</u>	15' Loc.	<u>1.89 S</u>
	<u>1.87 W</u>	(calc.)	<u>1.87 W</u>

Company Silverhill Oil Co

Farm C.R. Palmer #1

15' Quad Littleton  
(sec.)

7.5' Quad Wileyville

District Procter

WELL LOCATION PLAT

County 103 Permit 73496

103-73496

C.R. Palmer No. 1 Well (222-3)(277A)

Proctor District, Wetzel County, W. Va.; on Scheidler Run of Little Fishing Creek 1.5 miles northeast of Halls Mills; completed Nov. 11, 1922; authority, Silverhill Oil Company; elevation, \_\_\_\_\_.

	Top. Feet.	Bottom. Feet.
Unrecorded (water at 32 and 60').....	0	238
Coal, <u>Washington</u> .....	238	290
Coal, <u>Mapletown, Sewickley</u> , soft (steel line) .....	647	652
Coal, <u>Pittsburgh</u> , soft (steel line).....	748	750
Sand, <u>Moundsville, Saltsburg</u> , hard .....	1170	1137
Sand, <u>Big Dunkard, Mahoning</u> , hard.....	1337	1335
Sand, <u>Burning Springs, Upper Freeport</u> , soft .....	1370	1385
Coal, <u>Lower Freeport</u> , hard .....	1388	1390
Gas Sand, <u>Lower Freeport</u> , soft .....	1485	1505
Sand, <u>Salt, Upper Connocuenessing</u> , hard..	1662	1765
Sand, <u>Maxton</u> , hard and close.....	1825	1872
<u>Little Line</u> , hard .....	1872	1884
<u>Lime</u> , broken .....	1884	1896
<u>Big Line</u> , hard .....	1896	1940
Sand, <u>Big Injun</u> , hard .....	1940	2162
Sand, <u>Souaw</u> , lime, hard .....	2254	2346
Sand, <u>Weir</u> , hard .....	2314	2388
Sand, <u>Berea</u> , hard .....	2518	2536
Hard shells .....	2553	2537
Sand, <u>Thirty-foot</u> , lime, hard .....	2596	2603
Red rock, hard .....	2609	2685
Sand, <u>Gordon</u> , shell .....	2772	2775
Total depth .....		3001

Reduced hole to 5" at 2726'6". Line shells.

Dry hole in all sands. Hole plugged solid from bottom to top and all casings removed.

Water Well Record.

Water Well drilled to depth of 60'.  
 Fresh water found at 40 to 53'; run 8" bailer 14 times and could not lower supply. 10" casing put in water well 18'10".

Size of hole below casing, 8 1/2".