

P

0 1 2 3 Latitude 39 05'


1

2

3

Longitude 81 30'

~~1,30 S. 1,29-S~~
~~3,83 W. 3,81-W~~
 7 NW (G-5)

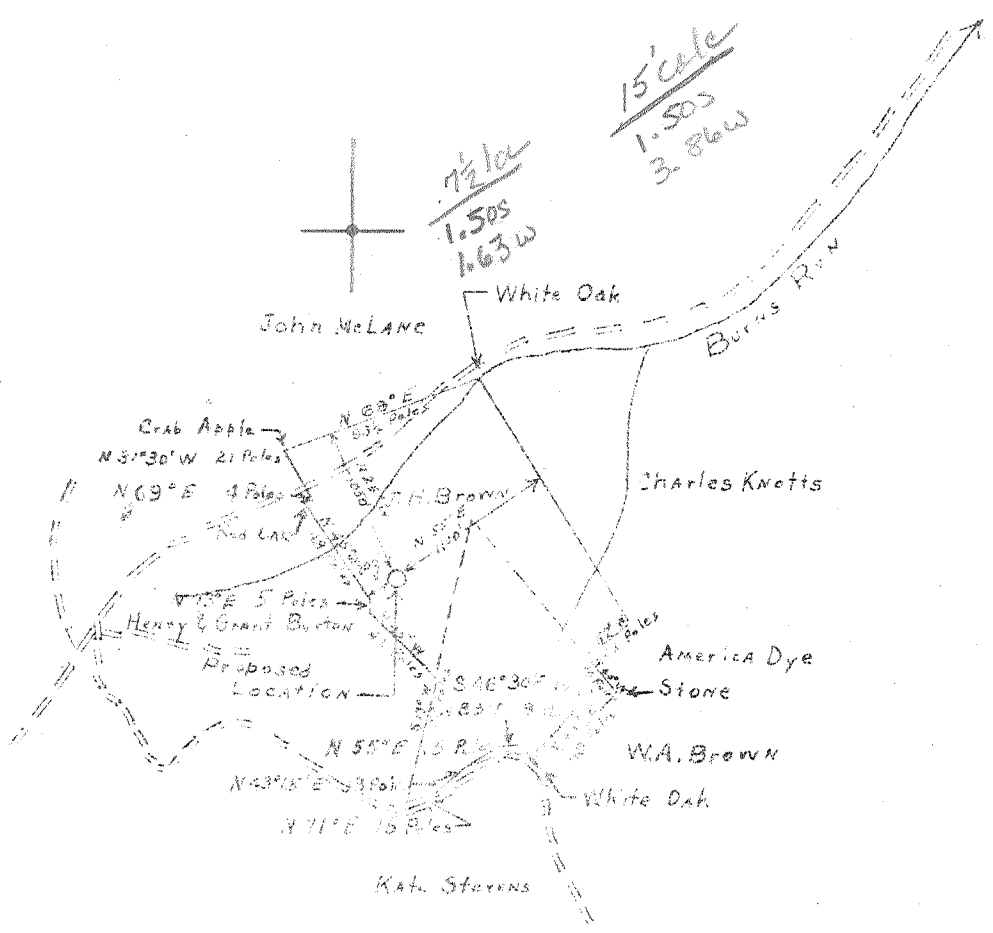

New Location
 Drill Deeper
 Abandonment

Company Godfrey L. Cabot, Inc.
 Address 900 Union Bldg, Charleston, W. Va.
 Farm J. H. Brown
 Tract _____ Acres 70 Lease No. 2-177
 Well (Farm) No. 1 Serial No. S-4380
 Elevation (Spirit Level) 878.6'
 Quadrangle Belleville - SE
 County West District Steele
 Engineer A. H. Simmons, Jr.
 Engineer's Registration No. 1652
 File No. _____ Drawing No. _____
 Date 19 JAN 1950 Scale 1" = 1320'

STATE OF WEST VIRGINIA
 DEPARTMENT OF MINES
 OIL AND GAS DIVISION
 CHARLESTON

WELL LOCATION MAP
 FILE NO. W00-303

+ Denotes location of well on United States Topographic Maps, scale 1 to 62,500, latitude and longitude lines being represented by border lines as shown.
 - Denotes one inch spaces on border line of original tracing.

No Driller's Log submitted

(Farm use) Deep Well

Dex Hole

✓ Corn. Ls 4859-4976

✓ Oriskany 4976-5021 (small show of gas)

TD 5024' (8/8/59)

485

NEW YORK
STATE DEPARTMENT OF
THE ENVIRONMENT
DIVISION OF CONSERVATION

Ballantine - 2E

Prep Well