

Antero Resources

Well No. Chambers 1H

As-Drilled

Antero Resources Corporation

Page 1 of 2

ALLEGHENY

SURVEYS, INC.

I, the undersigned, hereby certify that this plat is correct to the best of my knowledge and belief and shows all the information required by law and the rules issued and prescribed by the Department of Environmental Protection.

Bradley D. Miller, P.S. 2167

BRADLEY D. MILLER

LICENSED

No. 2167

STATE OF WEST VIRGINIA

PROFESSIONAL SURVEYOR

SEAL

Water Well

47-033-01066

47-033-00916

Water Well (5)

47-033-01088

47-033-03897

As-Drilled Well No.

Chambers Unit 1H

Water Well (2)

47-033-03833

47-033-03896

47-033-05180

47-033-00951

Note: Eight (8) water wells were found within 2000' of proposed well. No occupied dwellings or buildings 2,500 square feet or larger used to house or shelter dairy cattle or poultry husbandry are located within 625' of the center of the well pad.

10,057' to Bottom Hole

5,825' to Top Hole

TOP LATITUDE 39 - 22 - 30

BTM LATITUDE 39 - 25 - 00

Tag	Bearing	Dist.	Description
L1	S 75°51' E	1,902.3'	47-033-03897
L2	S 61°57' W	1,180.8'	47-033-01088
L3	N 51°10' W	995.6'	47-033-03896
L4	N 52°06' E	1,422.6'	47-033-05180

Top Hole Coordinates, As-drilled data, and information was provided by Antero Resources Corporation. Allegheny Surveys Inc. (ASI) is not certifying the data and information provided. ASI is not responsible for any errors or inaccuracies with the data and information that has been provided.

TOP HOLE LONGITUDE 80 - 22 - 30

BTM HOLE LONGITUDE 80 - 22 - 30

10,603' to Top Hole

10,951' to Bottom Hole

Chambers Unit 1H Bottom Hole

47-033-02118

500' Buffer

500' Buffer

Top Hole 7.5' Spot

Approx. N 17°55' W

47-033-03895

47-033-03833

47-033-03835

As-Drilled Well No. Chambers 1H

Isaac Creek

Gregory Run

Little Tenmile Creek

Sardis District

Eagle District

FILE NO: 171-36-EO-17

DRAWING NO: Chambers Unit 1H As-Drilled

SCALE: 1" = 2000'

MINIMUM DEGREE OF ACCURACY: Submeter

PROVEN SOURCE OF ELEVATION: WVDOT, Harrisville, WV

STATE OF WEST VIRGINIA

DEPARTMENT OF ENVIRONMENTAL PROTECTION

OIL AND GAS DIVISION

DATE: May 28 20 26

OPERATOR'S WELL NO. Chambers Unit 1H

API WELL NO

47 - 033 - 06120

STATE COUNTY PERMIT

WELL TYPE: ☐ OIL ☒ GAS ☐ LIQUID INJECTION ☐ WASTE DISPOSAL

(IF GAS) PRODUCTION: ☐ STORAGE ☐ DEEP ☒ SHALLOW

LOCATION: ELEVATION: As-Built 1,154.4' WATERSHED: Tenmile Creek QUADRANGLE: Wolf Summit

DISTRICT: Eagle COUNTY: Harrison

SURFACE OWNER: Robert G. & Christine E. Flanigan, et al ACREAGE: 129.00

ROYALTY OWNER: A.W. & Susan C. Coffman LEASE NO: ACREAGE: 129.00

PROPOSED WORK: ☐ DRILL ☐ CONVERT ☐ DRILL DEEPER ☐ FRACTURE OR STIMULATE ☐ PLUG OFF OLD FORMATION

☐ PERFORATE NEW FORMATION ☒ OTHER PHYSICAL CHANGE IN WELL (SPECIFY) As-Drilled 6,916' TVD

☐ PLUG AND ABANDON ☐ CLEAN OUT AND REPLUG TARGET FORMATION: Marcellus Shale ESTIMATED DEPTH: 22,272' MD

WELL OPERATOR: Antero Resources Corporation

DESIGNATED AGENT: Conrad Baston

ADDRESS: 1615 Wynkoop Street

ADDRESS: 535 White Oaks Blvd.

Denver, CO 80202


Bridgeport, WV 26330



Tag	Lease
A	Louisa C. Robinson & D.D. Robinson, her husband
B	J.N. Swiger & H.J. Swiger
D	J.C. & Mandora V. Bartlett
E	A.G. Swiger
F	Blanche R. Atkinson
G	E.L. Coffman & F.O. Coffman, his wife
H	Samuel A. Elliott & Bashie A. Elliott
I	Anson Cain & Ida S. Cain, his wife
J	L.C. Harbert, et al
K	C. Garnett Ritter, et al
L	Dennis C. Bates, et al
M	A.W. & Susan C. Coffman
N	David E. Nay & Rebecca L. Nay
P	Rebecca L. Nay, et al

Harrison County				
No.	TM / Par	Owner	Bk / Pg	Ac.
1	205 / 11	Tenmile Ranch, LLC	1754 / 249	81.35
2	205 / 12	Romona A. & Richard P. Swiger, Jr.	1184 / 420	21.80
3	205 / 13	Maxine K. & James G. Ice, II	1234 / 770	29.98
4	205 / 32	Romona A. & Richard P. Swiger, Jr.	1184 / 420	50.15
5	205 / 38	Maxine K. & James G. Ice, II	1234 / 770	40.42
6	205 / 32.1	Nickole R. & Richard P. Swiger, III	1461 / 409	3.54
7	205 / 37	Nickole R. & Richard P. Swiger, III	1463 / 438	14.58
8	205 / 38.1	David E. & Rebecca L. Nay	1741 / 767	17.58
9	205 / 39	Michael S. & Vickie L. Holt	1663 / 1159	87.07
10	205 / 56	David E. & Rebecca L. Nay	1425 / 782	6.04
11	205 / 61	David E. & Rebecca L. Nay	1208 / 843	89.26
12	205 / 79.1	David E. & Rebecca L. Nay	1741 / 762	88.00
13	205 / 61.1	David E. & Rebecca L. Nay	1208 / 843	3.21
14	225 / 20.1	Ten-A-Coal Co.	1157 / 964	1.35
15	205 / 79	Larry Hood	1784 / 1193	4.82
16	225 / 20	Mildred I. Leasure (LE)	1757 / 632	5.20
17	225 / 21	Patrick H. & Frank O. Cunningham	W203 / 413	64.00
18	225 / 23	Lyndon Holdings, LLC, et al	1613 / 135,152	35.82
19	225 / 36	Jason C. & Kristin A. Cunningham	1610 / 1185	18.47
20	226 / 14	Charles J. Nay	W184 / 59	61.70
21	225 / 57	Jason C. & Kristin A. Cunningham	1610 / 1185	67.52
22	226 / 36	Julia F. Zirkle	W167 / 267	53.50
23	226 / 56.9	Drayke A. Martin & Jacye D. Laxton	1776 / 1001	2.07
24	226 / 56.13	Corey J. & Tara A. Wright	1625 / 1225	5.80
25	226 / 56.12	Harold Q. & Ronda M. Frye	1582 / 246	1.00
26	226 / 56.5	Gary & Susan Ross	1234 / 645	9.59
27	225 / 73	Jason C. & Kristin A. Cunningham	1610 / 1185	24.12
28	225 / 74	Kevin Owens & Kristy D. Sendling	1396 / 687	23.06
29	226 / 88	Jason C. & Kristin A. Cunningham	1610 / 1185	9.98
30	226 / 89	David J. Robey	1444 / 1293	12.35
31	246 / 30	James A. Varner	1261 / 957	397.42
32	245 / 26	Robert G. & Christine E. Flanigan, et al	W216 / 842	129.00

Legend	
	Proposed gas well
	Well Reference, as noted
	Monument, as noted
	Existing Well, as noted
	Digitized Well, as noted
	Creek or Drain
	Existing road
	Surface boundary (approx.)
	District line (approx.)

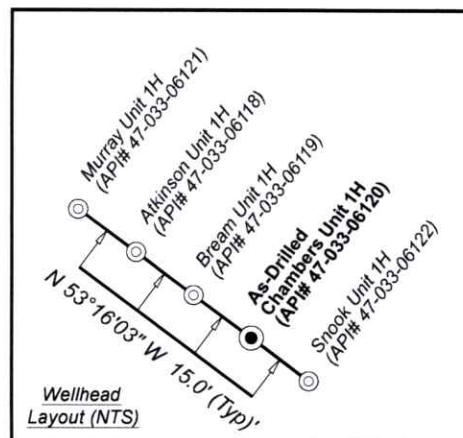

Notes
West Virginia Coordinate System
of 1927, North Zone
based upon Differential GPS Measurements.
Well No. Chambers Unit 1H Top Hole coordinates are
N: 309,352.59' Latitude: 39°20'45.20"
E: 1,746,719.20' Longitude: 80°23'44.14"
Bottom Hole coordinates are
N: 324,222.76' Latitude: 39°23'11.77"
E: 1,742,631.93' Longitude: 80°24'38.09"
UTM Zone 17, NAD 1983
Top Hole Coordinates Bottom Hole Coordinates
N: 4,355,345.491m N: 4,359,855.090m
E: 552,096.947m E: 550,776.265m
Plat orientation and corner and well references
are based upon the grid north meridian.
Well location references are based upon the magnetic
meridian.

Notes:
Well No. Chambers Unit 1H
As-Drilled POE Coordinates
WV Coordinate System
of 1927, North Zone
N: 309,962.16'
E: 1,747,243.39'
Lat: 39°20'51.28"
Lon: 80°23'37.55"
UTM Zone 17, NAD 1983
N: 4,355,533.864m
E: 552,253.556m

FILE NO: 171-36-EO-17
DRAWING NO: Chambers Unit 1H As-Drilled
SCALE: 1" = 2000'
MINIMUM DEGREE OF ACCURACY:
Submeter
PROVEN SOURCE OF ELEVATION:
WVDOT, Harrisville, WV

STATE OF WEST VIRGINIA
DEPARTMENT OF ENVIRONMENTAL PROTECTION
OIL AND GAS DIVISION

DATE: May 28 20 26
OPERATOR'S WELL NO. Chambers Unit 1H
API WELL NO
47 - 033 - 06120
STATE COUNTY PERMIT

WELL TYPE: ☐ OIL ☒ GAS ☐ LIQUID INJECTION ☐ WASTE DISPOSAL
(IF GAS) PRODUCTION: ☐ STORAGE ☐ DEEP ☒ SHALLOW

LOCATION: ELEVATION: As-Built 1,154.4' WATERSHED: Tenmile Creek QUADRANGLE: Wolf Summit

DISTRICT: Eagle COUNTY: Harrison

SURFACE OWNER: Robert G. & Christine E. Flanigan, et al

ROYALTY OWNER: A.W. & Susan C. Coffman LEASE NO: ACREAGE: 129.00

PROPOSED WORK: ☐ DRILL ☐ CONVERT ☐ DRILL DEEPER ☐ FRACTURE OR STIMULATE ☐ PLUG OFF OLD FORMATION
☐ PERFORATE NEW FORMATION ☒ OTHER PHYSICAL CHANGE IN WELL (SPECIFY) As-Drilled 6,916' TVD

☐ PLUG AND ABANDON ☐ CLEAN OUT AND REPLUG TARGET FORMATION: Marcellus Shale ESTIMATED DEPTH: 22,272' MD

WELL OPERATOR: Antero Resources Corporation DESIGNATED AGENT: Conrad Baston
ADDRESS: 1615 Wynkoop Street ADDRESS: 535 White Oaks Blvd.
Denver, CO 80202 Bridgeport, WV 26330