



west virginia department of environmental protection

Office of Oil and Gas
601 57th Street, S.E.
Charleston, WV 25304
(304) 926-0450
fax: (304) 926-0452

Harold D. Ward, Cabinet Secretary
www.dep.wv.gov

Friday, March 14, 2025
PERMIT MODIFICATION APPROVAL
Horizontal 6A / New Drill

HG ENERGY II APPALACHIA, LLC
5260 DUPONT ROAD

PARKERSBURG, WV 26101

Re: Permit Modification Approval for Van Wie 1221 N-10H
47-041-05769-00-00

Adding an access road

HG ENERGY II APPALACHIA, LLC

The Office of Oil and Gas has reviewed the attached permit modification for the above referenced permit. The attached modification has been approved and well work may begin. Please be reminded that the oil and gas inspector is to be notified twenty-four (24) hours before permitted well work is commenced.

If there are any questions, please feel free to contact me at (304) 926- 0450.

A blue ink signature of James A. Martin.

James A. Martin
Chief

Operator's Well Number: Van Wie 1221 N-10H
Farm Name: HG Energy II Appalachia, LLC
U.S. WELL NUMBER: 47-041-05769-00-00
Horizontal 6A New Drill
Date Modification Issued: 3/14/2025

Promoting a healthy environment.

03/14/2025

WEST VIRGINIA
COUNTY MAP

PROJECT LOCATION

Straight Run Entrance

WV-N NAD 83 N: 76309.00
WV-N NAD 83 E: 2063742.91
WV-N NAD 27 N: 763559.77
WV-N NAD 27 E: 2095194.65
Lat. NAD 83: 39.09644219
Lon. NAD 83: -80.66444248
Lat. NAD 27: 39.09635249
Lon. NAD 27: -80.66462154
UTM 17 NAD 83 N: 4327532.55
UTM 17 NAD 83 E: 529017.06

Fink Creek Exit

WV-N NAD 83 N: 763385.30
WV-N NAD 83 E: 2059634.99
WV-N NAD 27 N: 763536.16
WV-N NAD 27 E: 2091086.79
Lat. NAD 83: 39.10135871
Lon. NAD 83: -80.67889360
Lat. NAD 27: 39.10126936
Lon. NAD 27: -80.67907206
UTM 17 NAD 83 N: 4328073.64
UTM 17 NAD 83 E: 527765.48

Staging Area Entrance

WV-N NAD 83 N: 763388.38
WV-N NAD 83 E: 2059640.55
WV-N NAD 27 N: 765339.25
WV-N NAD 27 E: 2091092.35
Lat. NAD 83: 39.10136711
Lon. NAD 83: -80.67887397
Lat. NAD 27: 39.10127776
Lon. NAD 27: -80.67905242
UTM 17 NAD 83 N: 4328074.58
UTM 17 NAD 83 E: 527767.18

Staging Area Exit

WV-N NAD 83 N: 765364.74
WV-N NAD 83 E: 2059939.87
WV-N NAD 27 N: 765315.60
WV-N NAD 27 E: 2091391.67
Lat. NAD 83: 39.10129937
Lon. NAD 83: -80.67781963
Lat. NAD 27: 39.10121000
Lon. NAD 27: -80.67799812
UTM 17 NAD 83 N: 4328067.38
UTM 17 NAD 83 E: 527858.37

Site Entrance

WV-N NAD 83 N: 762954.49
WV-N NAD 83 E: 2063348.90
WV-N NAD 27 N: 762905.26
WV-N NAD 27 E: 2094800.64
Lat. NAD 83: 39.09464922
Lon. NAD 83: -80.66583893
Lat. NAD 27: 39.09455950
Lon. NAD 27: -80.66501796
UTM 17 NAD 83 N: 4327333.13
UTM 17 NAD 83 E: 528897.04

Center of Well Pad

WV-N NAD 83 N: 762961.19
WV-N NAD 83 E: 2062544.18
WV-N NAD 27 N: 762973.41
WV-N NAD 27 E: 2094800.64
Lat. NAD 83: 39.09467556
Lon. NAD 83: -80.66867393
Lat. NAD 27: 39.09458589
Lon. NAD 27: -80.66885286
UTM 17 NAD 83 N: 4327335.16
UTM 17 NAD 83 E: 528651.86
Pad Elev.: 1251.77

Center of AST Pad

WV-N NAD 83 N: 762692.43
WV-N NAD 83 E: 2061991.36
WV-N NAD 27 N: 762931.59
WV-N NAD 27 E: 2093995.92
Lat. NAD 83: 39.09394312
Lon. NAD 83: -80.67062491
Lat. NAD 27: 39.09385347
Lon. NAD 27: -80.67080378
UTM 17 NAD 83 N: 4327253.26
UTM 17 NAD 83 E: 528483.45
Pad Elev.: 1229.00

ASTs to consist of (2) 10,000 bbl (76" diameter) tanks with secondary containment 12,000 bbl (83" diameter) for processed water

Site Entrance

WV-N NAD 83 N: 762954.49
WV-N NAD 83 E: 2063348.90
WV-N NAD 27 N: 762905.26
WV-N NAD 27 E: 2094800.64
Lat. NAD 83: 39.09464922
Lon. NAD 83: -80.66583893
Lat. NAD 27: 39.09455950
Lon. NAD 27: -80.66501796
UTM 17 NAD 83 N: 4327333.13
UTM 17 NAD 83 E: 528897.04

Center of Well Pad

WV-N NAD 83 N: 762961.19
WV-N NAD 83 E: 2062544.18
WV-N NAD 27 N: 762973.41
WV-N NAD 27 E: 2094800.64
Lat. NAD 83: 39.09467556
Lon. NAD 83: -80.66867393
Lat. NAD 27: 39.09458589
Lon. NAD 27: -80.66885286
UTM 17 NAD 83 N: 4327335.16
UTM 17 NAD 83 E: 528651.86
Pad Elev.: 1251.77

Center of AST Pad

WV-N NAD 83 N: 762692.43
WV-N NAD 83 E: 2061991.36
WV-N NAD 27 N: 762931.59
WV-N NAD 27 E: 2093995.92
Lat. NAD 83: 39.09394312
Lon. NAD 83: -80.67062491
Lat. NAD 27: 39.09385347
Lon. NAD 27: -80.67080378
UTM 17 NAD 83 N: 4327253.26
UTM 17 NAD 83 E: 528483.45
Pad Elev.: 1229.00

ASTs to consist of (2) 10,000 bbl (76" diameter) tanks with secondary containment 12,000 bbl (83" diameter) for processed water

1221 Well Site Fink Creek Access

Site Design, Construction Plan, & Erosion and Sediment Control Plans

HG Energy LLC


Lewis County


Freemans Creek District

Latitude 39.09467556°

Longitude -80.66867393°

Leading Creek Watershed

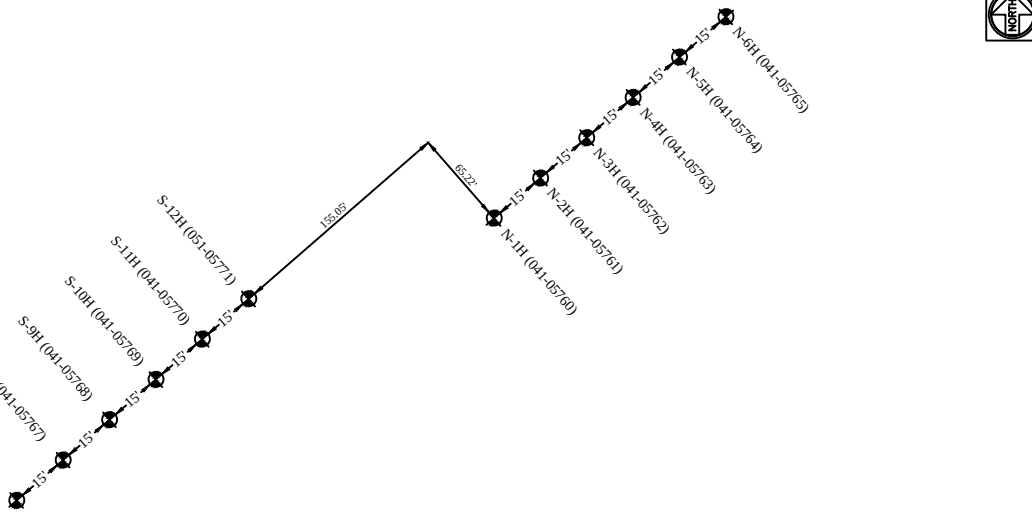Site Entrance WV-N NAD 83 N: 762954.49 WV-N NAD 83 E: 2063348.90 WV-N NAD 27 N: 762905.26 WV-N NAD 27 E: 2094800.64 Lat. NAD 83: 39.09464922 Lon. NAD 83: -80.66583893 Lat. NAD 27: 39.09455950 Lon. NAD 27: -80.66601796 UTM 17 NAD 83 N: 4327333.13 UTM 17 NAD 83 E: 528897.04	Center of Well Pad WV-N NAD 83 N: 762961.19 WV-N NAD 83 E: 2062544.18 WV-N NAD 27 N: 762971.99 WV-N NAD 27 E: 2093995.92 Lat. NAD 83: 39.09467556 Lon. NAD 83: -80.66867393 Lat. NAD 27: 39.09458589 Lon. NAD 27: -80.66885286 UTM 17 NAD 83 N: 4327335.16 UTM 17 NAD 83 E: 528651.86 Pad Elev.: 1251.77	Center of AST Pad WV-N NAD 83 N: 762692.43 WV-N NAD 83 E: 2061991.36 WV-N NAD 27 N: 762654.24 WV-N NAD 27 E: 2093443.10 Lat. NAD 83: 39.09394312 Lon. NAD 83: -80.67062491 Lat. NAD 27: 39.09385347 Lon. NAD 27: -80.67080378 UTM 17 NAD 83 N: 4327253.26 UTM 17 NAD 83 E: 528483.45 Pad Elev.: 1229.00	ASTs to consist of (2) 10,000 bbl (76" diameter) tanks with secondary containment 12,000 bbl (83" diameter) for processed water	
				
Well Table				
N-1H WV-N NAD 83 N: 763022.62 WV-N NAD 83 E: 2062599.14 WV-N NAD 27 N: 762973.41 WV-N NAD 27 E: 2094050.89 Lat. NAD 83: 39.09484365 Lon. NAD 83: -80.66847951 Lat. NAD 27: 39.09475397 Lon. NAD 27: -80.66863945 UTM 17 NAD 83 (m) N: 4327353.87 UTM 17 NAD 83 (m) E: 528668.61	N-2H WV-N NAD 83 N: 763032.46 WV-N NAD 83 E: 2062610.47 WV-N NAD 27 N: 762983.25 WV-N NAD 27 E: 2094062.21 Lat. NAD 83: 39.09487055 Lon. NAD 83: -80.66843950 Lat. NAD 27: 39.09478088 Lon. NAD 27: -80.66861844 UTM 17 NAD 83 (m) N: 4327356.87 UTM 17 NAD 83 (m) E: 528672.06	N-3H WV-N NAD 83 N: 763042.30 WV-N NAD 83 E: 2062621.79 WV-N NAD 27 N: 762993.09 WV-N NAD 27 E: 2094073.53 Lat. NAD 83: 39.09489745 Lon. NAD 83: -80.66839949 Lat. NAD 27: 39.09480778 Lon. NAD 27: -80.66857843 UTM 17 NAD 83 (m) N: 4327359.87 UTM 17 NAD 83 (m) E: 528675.51	N-4H WV-N NAD 83 N: 763052.14 WV-N NAD 83 E: 2062633.11 WV-N NAD 27 N: 763002.93 WV-N NAD 27 E: 2094084.85 Lat. NAD 83: 39.09492436 Lon. NAD 83: -80.66835948 Lat. NAD 27: 39.09483468 Lon. NAD 27: -80.66849841 UTM 17 NAD 83 (m) N: 4327362.87 UTM 17 NAD 83 (m) E: 528678.96	N-5H WV-N NAD 83 N: 763061.98 WV-N NAD 83 E: 2062644.43 WV-N NAD 27 N: 763012.77 WV-N NAD 27 E: 2094096.17 Lat. NAD 83: 39.09495126 Lon. NAD 83: -80.66831947 Lat. NAD 27: 39.09486159 Lon. NAD 27: -80.66849841 UTM 17 NAD 83 (m) N: 4327365.87 UTM 17 NAD 83 (m) E: 528682.41
N-6H WV-N NAD 83 N: 763071.82 WV-N NAD 83 E: 2062655.75 WV-N NAD 27 N: 763022.61 WV-N NAD 27 E: 2094107.49 Lat. NAD 83: 39.09487816 Lon. NAD 83: -80.66827946 Lat. NAD 27: 39.09488849 Lon. NAD 27: -80.66845840 UTM 17 NAD 83 (m) N: 4327368.86 UTM 17 NAD 83 (m) E: 528685.85	S-7H WV-N NAD 83 N: 762920.92 WV-N NAD 83 E: 2062382.73 WV-N NAD 27 N: 762871.72 WV-N NAD 27 E: 2093834.47 Lat. NAD 83: 39.09456558 Lon. NAD 83: -80.66924324 Lat. NAD 27: 39.09447691 Lon. NAD 27: -80.66942215 UTM 17 NAD 83 (m) N: 4327322.89 UTM 17 NAD 83 (m) E: 528602.68	S-8H WV-N NAD 83 N: 762930.76 WV-N NAD 83 E: 2062394.05 WV-N NAD 27 N: 762881.56 WV-N NAD 27 E: 2093845.79 Lat. NAD 83: 39.09455948 Lon. NAD 83: -80.66920323 Lat. NAD 27: 39.09450382 Lon. NAD 27: -80.66938214 UTM 17 NAD 83 (m) N: 4327325.88 UTM 17 NAD 83 (m) E: 528606.13	S-9H WV-N NAD 83 N: 762940.60 WV-N NAD 83 E: 2062405.37 WV-N NAD 27 N: 762891.40 WV-N NAD 27 E: 2093857.11 Lat. NAD 83: 39.09459348 Lon. NAD 83: -80.66916322 Lat. NAD 27: 39.09453072 Lon. NAD 27: -80.66934213 UTM 17 NAD 83 (m) N: 4327328.88 UTM 17 NAD 83 (m) E: 528609.57	S-10H WV-N NAD 83 N: 762950.44 WV-N NAD 83 E: 2062416.69 WV-N NAD 27 N: 762901.24 WV-N NAD 27 E: 2093868.44 Lat. NAD 83: 39.09467429 Lon. NAD 83: -80.66912321 Lat. NAD 27: 39.09457563 Lon. NAD 27: -80.66930213 UTM 17 NAD 83 (m) N: 4327331.88 UTM 17 NAD 83 (m) E: 528613.02
S-11H WV-N NAD 83 N: 762960.28 WV-N NAD 83 E: 2062428.01 WV-N NAD 27 N: 762911.08 WV-N NAD 27 E: 2093879.76 Lat. NAD 83: 39.09467420 Lon. NAD 83: -80.66908020 Lat. NAD 27: 39.09458453 Lon. NAD 27: -80.66926212 UTM 17 NAD 83 (m) N: 4327334.88 UTM 17 NAD 83 (m) E: 528616.47	S-12H WV-N NAD 83 N: 762970.12 WV-N NAD 83 E: 2062439.33 WV-N NAD 27 N: 762920.92 WV-N NAD 27 E: 2093891.08 Lat. NAD 83: 39.09470110 Lon. NAD 83: -80.66904319 Lat. NAD 27: 39.09461143 Lon. NAD 27: -80.66922211 UTM 17 NAD 83 (m) N: 4327337.88 UTM 17 NAD 83 (m) E: 528619.92			

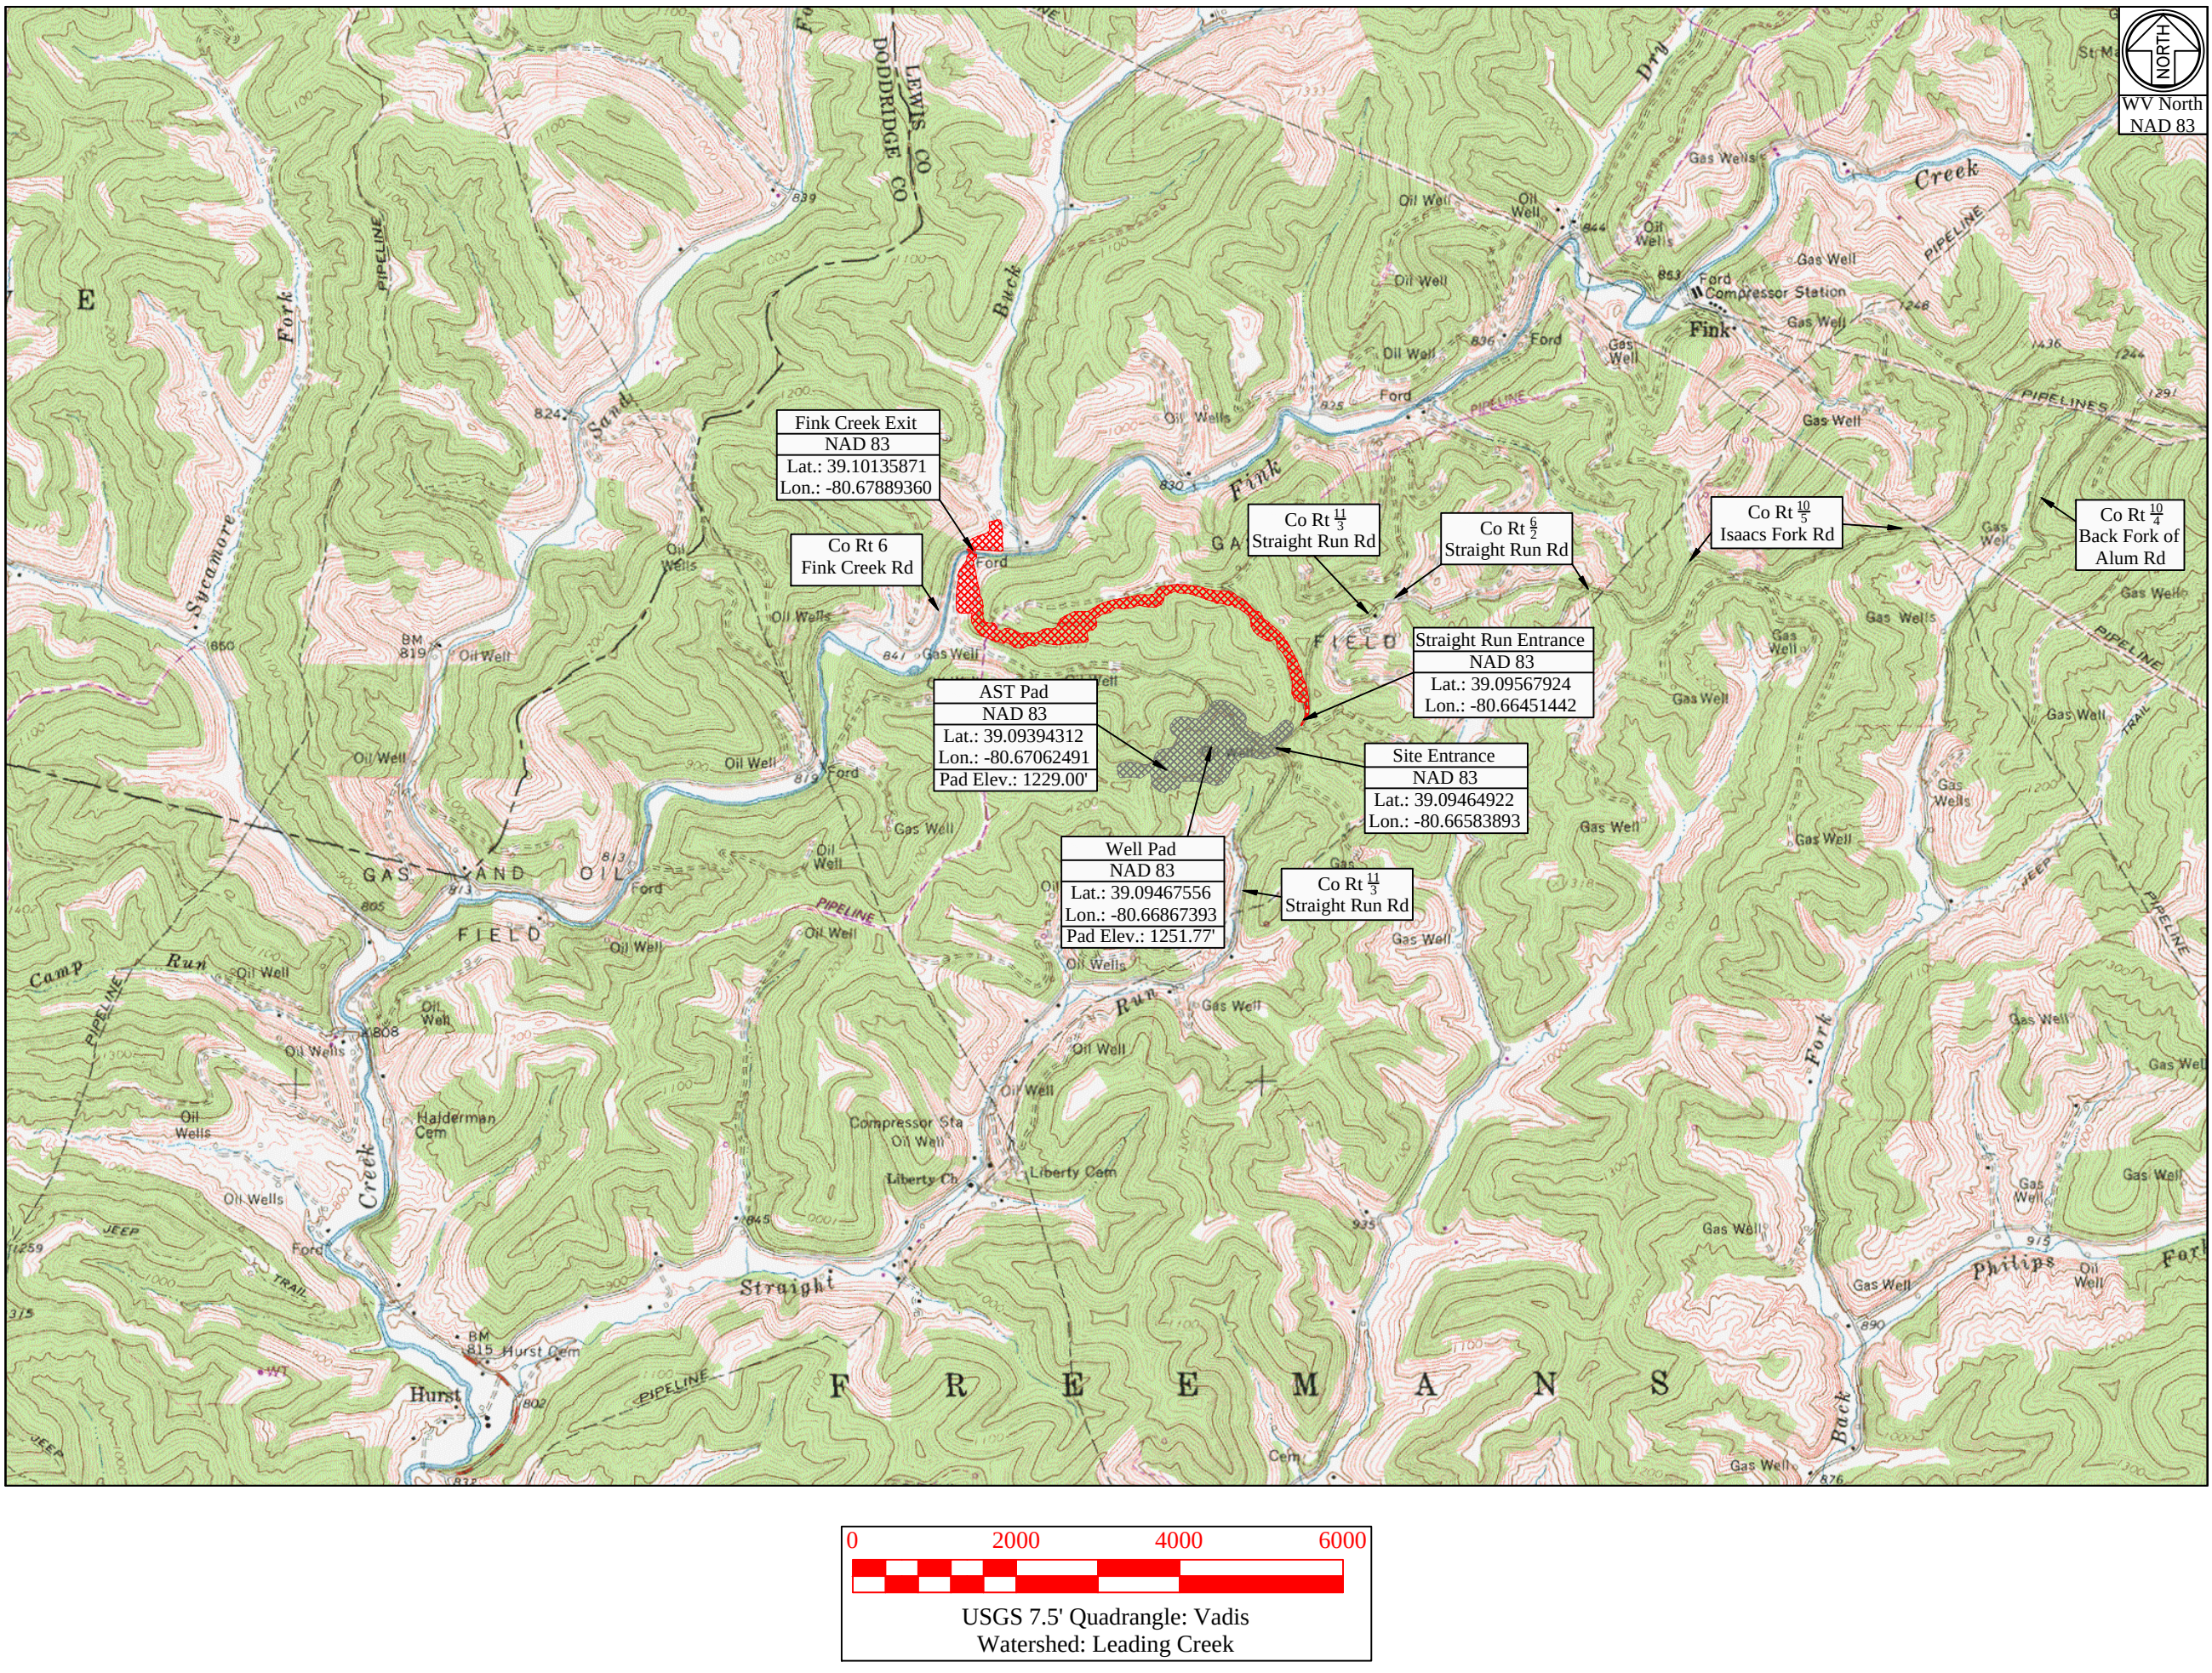

APPROVED
WVDEP OOG
Modification
3/14/2025

Project Contacts

HG Energy LLC

Jared Stemple - Construction Manager
740-336-2477

Survey and Engineer

Kenneth Kelly
304-338-6985 Off.

John P. See
304-442-0220 Off.

Zackary Summerfield
304-338-6987 Off.

HG Energy, LLC

5260 Dupont Road
Parkersburg, WV 26101
PH: 304-420-1100
Fax: 304-863-3175

Environmental:

Wetland Delineations as provided by Palustris Environmental dated June 20, 2023

Topographic Information:

The topographic information shown herein is based on aerial photography by Blue Mountain Aerial Mapping, Burton, WV

MISS UTILITY OF WEST VIRGINIA
1-800-245-4848
West Virginia State Law
Section XIV, Chapter 24-C requires
that you call two business days
before
you dig in the state of West Virginia.
IT'S THE LAW
Know what's below.
Call before you dig.

811

HG Energy LLC will obtain an Encroachment Permit (Form MM-109) from the WV Department of Transportation, Division of Highways, prior to the commencement of any construction activities

The WV Mines Website was consulted. Previous mining activities are not within the AOI.

WVDEP Website files show that there are active and/or abandoned gas wells within the AOI

Approach Routes:

From I-79 North near Jane Lew, WV. Take Exit 99 and turn left at the end of the exit onto Co Rt 7, Hackers Creek Rd. Follow Co Rt 7 for 0.9 mi. Turn Left onto US Rt 19 South. Follow US Rt 19 South for 4.9 mi. Turn Right onto Co Rt 12, Jackson Mill Rd. Follow Co Rt 12 for 2.4 mi. Slight Left onto Co Rt 10, Old Mill Rd. Follow Co Rt 10 for 0.6 mi. Turn Left onto Co Rt 10, Old Mill Rd (at Jacksons Mill Fire Station). Follow Co Rt 10 for 500'. Turn Right onto Co Rt 10, Valley Chapel Rd. Follow Co Rt 10 for 4.4 mi. Turn Right onto Co Rt 10, Freemans Creek Rd. Follow Co Rt 10 for 3.8 mi. Turn Right onto Co Rt 9, Churchville Road. Follow Churchville road for 0.2 mi. Turn left onto Co Rt 10, Isaacs Fork Rd. Follow Co Rt 10 for 1.0 mi. Turn Right onto Co Rt 1/2, Isaacs Fork Rd. Follow Co Rt 1/2 for 3.6 mi. Continue Straight onto Co Rt 1/2, Straight Run Rd. Follow Co Rt 1/2 for 0.5 mi. Continue Straight onto Co Rt 1/2, Straight Run Rd. Follow Co Rt 1/2 for 0.5 mi. The site entrance will be on the Right, northwest, side of the road

Well Location Restrictions

All Pad construction complies with the following restrictions.

- *250' from an existing well or developed spring used for human or domestic animals.
- *625' from an occupied dwelling or barn greater than 2,500 SF used for poultry or dairy measured from the center of the pad.
- *300' from the edge of disturbance to a naturally reproducing trout stream.
- *1,000' of a surface or ground water intake to a public water supply.

(Well Location Restrictions of WV Code 22-6A-12)

The drawings, construction notes and reference diagrams attached hereto have been prepared in accordance with the West Virginia Code of State Rules, Division of Environmental Protection, Office of Oil and Gas, 25-CC-20. All Plans, Sheets, and/or Reference Diagrams included in this design constitute a complete set of plans. A complete set of plans is necessary to construct the site in accordance with the design.

Zackary C. Summerfield
RPE 22214
Kelly Surveying PLLC
CO#0338-0965

Date: 02-04-2025

Ephemeral Stream Impact (Linear Feet) - Fink Creek Access Road						
Stream and Impact Cause	Culvert (LF)	Inter/Outlet Structures Fill (LF)	Slope Fill (LF)	Const. Disturb. to LOD (LF)	Total Impact (LF)	
Watercourse FE (Access Road)	10.00	86.60	12.43	109.03		
Watercourse FA (Access Road)	-	12.21	45.95	5.00	63.16	
Total Stream Impacts					172.19	

Sheet	Description
1	Cover Sheet
V1	Schedule of Quantities
N1-N4	Site Notes
2-3	Pre-Construction Site Conditions
4-5	Site Soil Map
6	Clearing Exhibit
7-8	Overall Plan View
9-14	E&S Plan View
15	Toe Key Exhibit
16-23	Plan View
24-27	Cross Sections - Well Pad
28	Cross Sections - Well Pad Access Road
29	Cross Sections - Staging Area
30-32	Cross Sections - Access Road
G1-G2	Geotechnical Exhibit
L1	Landowner Disturbed Area Exhibit
S1	Site Reclamation
M1-M2	Production Exhibit
D1-D2	Erosion and Sediment Control Details
R1	Access Road Details
P1	Pad Details

Pertinent Site Information

1221 Site

Emergency Number: 304-269-8241

Freemans Creek District, Lewis County, WV

Watershed: Leading Creek Watershed

Site 911 Address:

HG Energy Contact Number: 304-420-1100

Property Owner Information - 1221 Well Site						
Freemans Creek District - Lewis County						
Owner	TM - Parcel	Well Pad	Access Road	Stockpiles	Add. Clearing	Total Disturbed
HG Energy II Appalachia, LLC	2D-3.1	0.00	0.00	0.03	0.10	0.13
HG Energy II Appalachia, LLC	2D-3	4.94	0.75	0.14	2.65	13.97
Anthony & Dawn Van Wie	2D-29	4.56	1.59	0.67	2.48	9.30
Site Totals (Ac)	9.50	2.34	0.81	2.68	8.07	23.40

Property Owner Information - 1221 Fink Creek Access						
Freemans Creek District - Lewis County						
Owner	TM - Parcel	Staging Area	Access Road	Topsoil/Excess	Add. Clearing	Total Disturbed
Alice Keely et al	2D-48	1.09	0.23	0.24	1.19	2.75
James II & Sheila Gum	2D-3.4	0.00	5.32	1.37	7.47	14.16
James II & Sheila Gum	2C-7	0.00	3.31	0.47	3.81	7.59
Site Totals (Ac)	1.09	8.86	2.08	12.47	24.50	

Well Site Access Road			
Surface Owner	TM - Parcel	Road Length	Type
HG Energy II Appalachia, LLC	2D-3	111.47'	New Access Road Construction
Anthony & Dawn Van Wie	2D-29	644.05'	New Access Road Construction

Fink Creek Access Road			
Surface Owner	TM - Parcel	Road Length	Type
Alice Keely et al	2D-48	286.52'	New Access Road Construction
James II & Sheila Gum	2D-3.4	3,108.37'	New Access Road Construction
James II & Sheila Gum	2C-7	2,555.68'	New Access Road Construction

Disturbed Area - Well Pad			
Well Pad Construction	9.50 Ac		
AST Pad Construction	2.34 Ac		
Access Road Construction	0.81 Ac		
Spill/Excess Material	2.68 Ac		
Additional Clearing	8.07 Ac		
Total Disturbed Area	23.40 Ac		
Additional Information			
Total Wooded Acres Disturbed	21.65 Ac		
Total Linear Feet of Access Road	7,555.52'		

Disturbed Area - Fink Creek Rd			
Staging Area Construction	1.09 Ac		
New Access Road Construction	8.86 Ac		
Topsoil/Excess Material	2.08 Ac		
Additional Clearing	12.47 Ac		
Total Disturbed Area	24.50 Ac		
Additional Information			
Total Wooded Acres Disturbed	22.50 Ac		
Total Linear Feet of Access Road	5,950.57'		

1221 Well Site Quantities - Well Site						
Description	Cut (CY)	Fill (CY)	Spill (CY)	Borrow (CY)	Max. Slope	Length of Slope (ft)
Well Pad	127,216.91	75,685.35	51,531.56	-	N/A	15,000.00
AST Pad	142.57	26,303.50	-	26,160.93	N/A	3,800.00
Well Pad Access Road	39.80	7,064.90	-	7,025.10	13.45%	255.18'
AST Pad Access Road	3.04	1,730.01	-	1,726.97	14.55%	169.46'
Landowner Access Road	-	-	-	-	-	-
Excess Material Stockpiles	-	27,				

Schedule of Quantities

Fink Access Road Pipe Schedule					
Pipe Crossing	Station	Length (ft)	Diameter (ft)	Type	Slope (%)
1	3+62	35	1.5	HDPE	2
2	7+26	35	1.5	HDPE	2
3	9+36	35	1.5	HDPE	2
4	12+37	30	1.5	HDPE	2
5	15+63	35	1.5	HDPE	2
6	18+68	35	1.5	HDPE	2
7	24+93	38	1.5	HDPE	2
8	28+25	40	1.5	HDPE	2
9	34+05	45	1.5	HDPE	2
10	39+30	30	1.5	HDPE	2
11	41+30	35	1.5	HDPE	2
12	46+00	35	1.5	HDPE	2
13	50+39	30	1.5	HDPE	2
14	51+95	32	1.5	HDPE	2
15	53+50	40	1.5	HDPE	2
16	56+83	45	1.5	HDPE	2
17	46+98	80	1.5	HDPE	2
18	51+27	55	1.5	HDPE	2
19	0+14	60	1.5	HDPE	2
20	0+10	80	1.5	HDPE	2

1221 Well Site Fink Creek Access



HG Energy LLC

Exhibit A: As-Built Modification

18" Filter Sock			1875
FS18 #1	19	FS18 #22	74
FS18 #2	25	FS18 #23	60
FS18 #3	45	FS18 #24	29
FS18 #4	35	FS18 #25	21
FS18 #5	50	FS18 #26	55
FS18 #6	63	FS18 #27	92
FS18 #7	45	FS18 #28	27
FS18 #8	36	FS18 #29	28
FS18 #9	26	FS18 #30	31
FS18 #10	41	FS18 #31	22
FS18 #11	69	FS18 #32	31
FS18 #12	71	FS18 #33	47
FS18 #13	65	FS18 #34	61
FS18 #14	56	FS18 #35	59
FS18 #15	26	FS18 #36	56
FS18 #16	54	FS18 #37	56
FS18 #17	22	FS18 #38	79
FS18 #18	42	FS18 #39	34
FS18 #19	30	FS18 #40	39
FS18 #20	31	FS18 #41	52
FS18 #21	23	FS18 #42	48

Belted Silt Retention Fence			1757
BSRF #1	27	BSRF #17	31
BSRF #2	30	BSRF #18	35
BSRF #3	49	BSRF #19	129
BSRF #4	39	BSRF #20	216
BSRF #5	55	BSRF #21	41
BSRF #6	68	BSRF #22	37
BSRF #7	50	BSRF #23	42
BSRF #8	37	BSRF #24	35
BSRF #9	31	BSRF #25	26
BSRF #10	46	BSRF #26	69
BSRF #11	127	BSRF #27	58
BSRF #12	54	BSRF #28	58
BSRF #13	41	BSRF #29	48
BSRF #14	68	BSRF #30	50
BSRF #15	48	BSRF #31	29
BSRF #16	58	BSRF #32	25

Super Silt Fence			3918
SSF #1	34	SSF #23	63
SSF #2	36	SSF #24	67
SSF #3	27	SSF #25	52
SSF #4	52	SSF #26	51
SSF #5	57	SSF #27	43
SSF #6	137	SSF #28	35
SSF #7	77	SSF #29	27
SSF #8	104	SSF #30	33
SSF #9	216	SSF #31	34
SSF #10	39	SSF #32	32
SSF #11	52	SSF #33	36
SSF #12	58	SSF #34	33
SSF #13	41	SSF #35	98
SSF #14	39	SSF #36	57
SSF #15	83	SSF #37	33
SSF #16	60	SSF #38	63
SSF #17	61	SSF #39	82
SSF #18	88	SSF #40	30
SSF #19	121	SSF #41	30
SSF #20	58	SSF #42	38
SSF #21	64	SSF #43	47
SSF #22	38	SSF #44	32

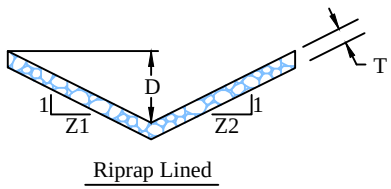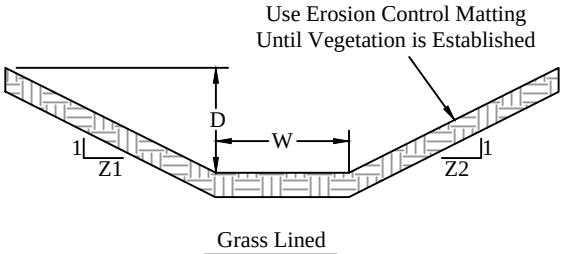

Rock Lined Channel						
Channel ID	Min Depth (D) (ft)	Width (W) (ft)	z1	z2	T (ft)	Riprap Size D50 (in)
Sump A Outlet	2	4	2	2	1	R4
Sump B Outlet	2	4	2	2	1	R4
Sump C Outlet	2	4	2	2	1	R4
Bench 1 Outlet	2	0	2	2	0.75	R3
AST Drain A	2	0	2	2	1	R4
AST Drain B	2	0	2	2	1	R4
AST Drain C	2	0	2	2	1	R4

Toe Keys	
Toe Key	Toe Key Length (ft)
A	383
B	2037
C	237
D	287
E	255
F	430
G	137
H	340
J	183
K	313
L	1394
M	306
N	470
O	87

Surface Areas			
Area Name	Area (Ac.)	Area (SF)	Area (SY)
Well Pad	5.62	244,841	27,205
Well Pad Access Road	0.40	17,596	1,956
AST Pad	1.05	45,567	5,063
AST Pad Access Road	0.14	6,306	701

Earthwork & Capacity Reports

The earthwork quantities provided are an estimate for consideration. The quantities shown are calculated using a 1:1 Cut / Swell & Shrink factor. The quantities shown may be greater or less than actually excavated. The engineer is not responsible for variances from the estimated quantities and does not certify to their accuracy.

<u>Well Pad Report</u> Top of pad elevation: 1251.77 Cut Slope: 50.00% 2.00:1 Fill Slope: 50.00% 2.00:1 Pad Earthwork Volumes Total cut : 3,434,856.5 C.F., 127,216.91 C.Y. Total fill: 2,043,504.5 C.F., 75,685.35 C.Y.	<u>Stockpile #1 Pad Report</u> Cut Slope: 50.00% 2.00:1 Fill Slope: 50.00% 2.00:1 Pad Earthwork Volumes Total cut : 0.0 C.F., 0.00 C.Y. Total fill: 216,002.9 C.F., 8,000.11 C.Y.
<u>AST Pad Report</u> Top of pad elevation: 1229.00 Cut Slope: 50.00% 2.00:1 Fill Slope: 50.00% 2.00:1 Pad Earthwork Volumes Total cut : 3,849.3 C.F., 142.57 C.Y. Total fill: 710,194.6 C.F., 26,303.50 C.Y.	<u>Stockpile #2 Pad Report</u> Cut Slope: 50.00% 2.00:1 26.57° Fill Slope: 50.00% 2.00:1 26.57° Pad Earthwork Volumes Total cut : 35.1 C.F., 1.30 C.Y. Total fill: 135,399.7 C.F., 5,014.80 C.Y.
<u>Well Pad Access Road Report</u> Processing 0+00.000 to 5+08.218 Total Cut : 991.983 C.F., 36,740 C.Y. Total Fill: 144042.971 C.F., 5334.925 C.Y.	<u>Stockpile #3 Pad Report</u> Cut Slope: 50.00% 2.00:1 26.57° Fill Slope: 50.00% 2.00:1 26.57° Pad Earthwork Volumes Total cut : 0.0 C.F., 0.00 C.Y. Total fill: 22,588.2 C.F., 836.60 C.Y.
<u>AST Access Road Report</u> Processing 0+00.000 to 2+47.299 Total Cut : 81.956 C.F., 3.035 C.Y. Total Fill: 46710.155 C.F., 1730.006 C.Y.	<u>Stockpile #4 Pad Report</u> Cut Slope: 50.00% 2.00:1 26.57° Fill Slope: 50.00% 2.00:1 26.57° Pad Earthwork Volumes Total cut : 1.2 C.F., 0.05 C.Y. Total fill: 243,167.5 C.F., 9,006.20 C.Y.
	<u>Stockpile #5 Pad Report</u> Cut Slope: 50.00% 2.00:1 26.57° Fill Slope: 50.00% 2.00:1 26.57° Pad Earthwork Volumes Total cut : 0.0 C.F., 0.00 C.Y. Total fill: 121,529.5 C.F., 4,501.09 C.Y.

1221 Fink Bypass Access Road Report

Processing 0+00.00 to 58+33.53
Total Cut : 600804.45 C.F., 22252.02 C.Y.
Total Fill: 509939.04 C.F., 18886.63 C.Y.

Staging Area Pad Report

Cut Slope: 50.00% 2.00:1
Fill Slope: 50.00% 2.00:1

Pad Earthwork Volumes
Total cut : 62,647.5 C.F., 2,320.28 C.Y.
Total fill: 22,138.6 C.F., 819.95 C.Y.

Staging Area East Access Road Report

Processing 0+00.00 to 0+72.40
Total Cut : 8.81 C.F., 0.33 C.Y.
Total Fill: 800.61 C.F., 29.65 C.Y.

Staging Area West Access Road Report

Processing 0+00.00 to 0+44.64
Total Cut : 59.78 C.F., 2.21 C.Y.
Total Fill: 187.21 C.F., 6.93 C.Y.

Staging Area Stockpile Pad Report

Cut Slope: 50.00% 2.00:1
Fill Slope: 50.00% 2.00:1

Pad Earthwork Volumes
Total cut : 0.0 C.F., 0.00 C.Y.
Total fill: 81,002.5 C.F., 3,000.09 C.Y.

Stockpile #1 Report

Cut Slope: 50.00% 2.00:1
Fill Slope: 50.00% 2.00:1

Pad Earthwork Volumes
Total cut : 0.0 C.F., 0.00 C.Y.
Total fill: 215,999.4 C.F., 8,000.00 C.Y.

Stockpile #2 Report

Cut Slope: 50.00% 2.00:1
Fill Slope: 50.00% 2.00:1

Pad Earthwork Volumes
Total cut : 0.0 C.F., 0.00 C.Y.
Total fill: 162,000.2 C.F., 6,000.01 C.Y.

Stockpile #3 Report

Cut Slope: 50.00% 2.00:1
Fill Slope: 50.00% 2.00:1

Pad Earthwork Volumes
Total cut : 0.5 C.F., 0.02 C.Y.
Total fill: 135,003.2 C.F., 5,000.12 C.Y.

03/14/2025



Revision
Design
Date
02-04-2025



THIS DOCUMENT
PREPARED FOR
HG ENERGY LLC



Schedule of Quantities
1221 Well Site
Freemans Creek District
Lewis County, WV

Date: 02/04/2025
Scale: As Shown
Designed By: ZS
File No.
Sheet V1 of V1

<div>1. WORK INCLUDED, BUT NOT LIMITED TO: EXCAVATE, GRADE, CUT, INSTALL OR ANY ACTIVITY ASSOCIATED WITH THE GRADING, EXCAVATION, CUTTING OR INSTALLATION OF EARTH MATERIAL TO DEVELOP A SITE ACCEPTABLE TO PERFORM WITHOUT DETRIMENTAL IMPACTS TO THE ENVIRONMENT AND OPERATE/FUNCTION SAFELY AS A WELL DRILL PAD OR ASSOCIATED FRESH WATER IMPOUNDMENT OR ANY ASSOCIATED FACILITY OR MAINTENANCE OF SUCH FACILITIES. ALL THE NOTES SHALL APPLY TO WORK ASSOCIATED WITH ACTIVITIES RELATED TO THE OIL AND GAS INDUSTRY, AS SHOWN ON THE PROJECT PLAN SET AND WITHIN THE WELL SITE BOUNDARIES, SPECIFIED THEREOF AND HEREIN, WHICH SHALL INCLUDE BUT NOT BE LIMITED TO, THE FOLLOWING: EXCAVATION AND SITE PREPARATION, INCLUDING INSTALLATION OF E&S CONTROLS, INSTALLATION OF SUBSURFACE DRAINAGE FEATURES, GRADING TO ESTABLISH SUBGRADES, AND FINAL GRADES, PAVEMENTS, GRAVEL SURFACES, AND GRASSED AREAS. EXCAVATION, FILLING AND BACKFILLING AND COMPACTION. DEWATERING OR ADDITION OF WATER AS REQUIRED. ADDITIONAL WORK AS SPECIFIED BY THE OWNER PLACING OF TOPSOIL AND FINISH GRADING.</div> <div>2. PROJECT CONDITION: a. INCLEMENT WEATHER: WHEN FILL OPERATIONS ARE CEASED DUE TO WEATHER (RAIN, FREEZING, SNOW, ETC.), CONSTRUCTION SHALL NOT BE RESUMED UNTIL THE GEOTECHNICAL ENGINEER OR HIS REPRESENTATIVE OR THE KELLY SURVEYING PLLC REPRESENTATIVE HAS VERIFIED SOIL STRENGTH HAS NOT BEEN ADVERSELY AFFECTED. IF SOIL STRENGTH HAS BEEN DECREASED, THE AFFECTED PORTION OF FILL SHALL BE RESCARIFIED, MOISTENED, OR DRIED AS REQUIRED AND RECOMPACTED TO THE SPECIFIED DENSITY.</div> <div>b. UTILITIES: PRIOR TO ANY EXCAVATION THE CONTRACTOR SHALL VERIFY THE LOCATIONS OF ALL UTILITIES WHICH MAY BE IN THE AREA. SHOULD UNCHARTED, INCORRECTLY CHARTED, UNMARKED IN FIELD, OR INCORRECTLY MARKED IN THE FIELD, PIPING OR OTHER UTILITIES BE ENCOUNTERED DURING EXCAVATION, CONTRACTOR SHALL CONSULT UTILITY OWNER IMMEDIATELY FOR DIRECTIONS. CONTRACTOR SHALL COOPERATE WITH OWNER AND UTILITY COMPANIES IN KEEPING RESPECTIVE SERVICES AND FACILITIES IN OPERATION, AND SHALL REPAIR OR ARRANGE FOR REPAIR, DAMAGED UTILITIES TO SATISFACTION OF UTILITY OWNER.</div> <div>c. DRAINAGE: THE CONTRACTOR SHALL BE RESPONSIBLE FOR THE PROPER DRAINAGE OF THE SITE DURING CONSTRUCTION OF THE PROJECT. WATER SHALL NOT BE ALLOWED TO ACCUMULATE IN ANY OF THE EXCAVATED AREAS. STORM OR GROUND WATER COLLECTING ON SITE DURING CONSTRUCTION SHALL BE REMOVED BY PUMPING, DITCHING, OR OTHER SUITABLE MEANS.</div> <div>d. COORDINATION: THE CONTRACTOR SHALL COORDINATE THE WORK WITH THE GEOTECHNICAL ENGINEER OR HIS REPRESENTATIVE OR THE KELLY SURVEYING PLLC REPRESENTATIVE BY NOTIFYING THE INSPECTOR OF SCHEDULED WORK IN ADVANCE. THE CONTRACTOR SHALL COORDINATE WORK WITH OTHER TRADES WHOSE WORK WILL BE AFFECTED ON THE SITE.</div> <div>3. DEFINITIONS: a. GEOTECHNICAL ENGINEER: A LICENSED INDEPENDENT GEOTECHNICAL ENGINEER AND TEST LABORATORY APPROVED BY THE OWNER WORKING WITH THE DESIGN ENGINEER TO ENSURE THAT EARTHWORK AND THE PROJECT PLAN SET REFLECTS THE AVAILABLE ONSITE MATERIAL. THAT THE AVAILABLE ONSITE MATERIAL AND COMMERCIAL MATERIAL IS TESTED TO MEET OR EXCEED THE SPECIFICATIONS FOR DENSITY AND MOISTURE CONTENT AND THE PARTICLE SIZE IS MAINTAINED OR APPROVED BY THE GEOTECHNICAL ENGINEER OR HIS REPRESENTATIVE OR THE KELLY SURVEYING PLLC REPRESENTATIVE. THE GEOTECHNICAL ENGINEER SHALL PREPARE A REPORT OF THEIR FINDINGS AND RECOMMENDATIONS, IT IS THE CONTRACTORS RESPONSIBILITY TO READ THE GEOTECHNICAL REPORT BEFORE BIDDING THE PROJECT, THE GEOTECHNICAL REPORT AND THE RECOMMENDATIONS PROVIDED SHALL GOVERN ALL ENGINEERED FILL OR CONTROLLED FILLS THE GEOTECHNICAL ENGINEER SHALL ATTEND THE PRE-CONSTRUCTION CONFERENCE ENGINEERED FILL, CONTROLLED FILL: CONTROLLED FILL IS DEFINED AS MATERIAL REQUIRED IN ALL AREAS ON WHICH FINAL GRADE IS NOT PLACED ON ORIGINAL OR EXCAVATED SOIL. MATERIAL SHALL BE PLACED OR MAXIMUM LOOSE LIFT THICKNESS 15 INCHES COMPACTED TO 12 INCHES.</div> <div>b. ROCK: FOR THE PURPOSES OF CLASSIFIED EXCAVATION, ROCK SHALL BE DEFINED AS MATERIAL THAT CANNOT BE DISLODGED BY A CATERPILLAR MODEL NO. D-8N, HEAVY DUTY TRACK-TYPE TRACTOR, OR OF EQUALLY RATED AT NOT LESS THAN 285 HP FLYWHEEL POWER AND EQUIPPED WITH A SINGLE SHANK HYDRAULIC RIPPER, CAPABLE OF EXERTING NOT LESS THAN 45,000 LBS BREAKOUT FORCE. THIS DEFINITION OF ROCK DOES NOT INCLUDE MATERIALS SUCH AS HARDPAN, LOOSE ROCK, OR OTHER MATERIALS THAT CAN BE REMOVED BY MEANS OTHER THAN DRILLING AND BLASTING, BUT WHICH FOR REASONS OF ECONOMY IN EXCAVATING THE CONTRACTOR CHOOSES TO REMOVE BY DRILLING AND BLASTING. IT IS THE CONTRACTORS RESPONSIBILITY TO DETERMINE ROCK AND IF BLASTING IS REQUIRED FOR THIS PROJECT. IF THE CONTRACTOR DETERMINES THAT BLASTING IS NECESSARY OR FOR REASONS OF ECONOMY DETERMINES TO BLAST THE MATERIAL THE CONTRACTOR SHALL PROTECT STRUCTURES, UTILITIES, SIDEWALKS, PAVEMENTS, TREES AND OTHER FACILITIES FROM DAMAGE CAUSED BY SETTLEMENT, LATERAL MOVEMENT, UNDERMINING, WASHOUT AND OTHER HAZARDS CREATED BY BLASTING OPERATIONS.</div> <div>c. UNSUITABLE MATERIAL: UNSUITABLE MATERIAL SHALL BE DEFINED AS MATERIAL THAT EXHIBITS EXCESSIVE PUMPING OR THAT DOES NOT MEET DENSITY REQUIREMENTS, THE MATERIAL CAN NOT MEET THE COMPACTION REQUIREMENTS OR AS DETERMINED BY THE GEOTECHNICAL ENGINEER OR HIS REPRESENTATIVE OR THE KELLY SURVEYING PLLC REPRESENTATIVE</div> <div>d. SATISFACTORY MATERIALS: MATERIALS ARE SATISFACTORY AS FILL MATERIAL WHEN THEY CAN MEET THE STANDARD PROCTOR FOR THE MATERIAL CLASSIFICATION IN THE GEOTECHNICAL REPORT, CLASS A, CLASS B, CLASS C, USED AS PER THE GEOTECHNICAL REPORT, (THE MOST DURABLE MATERIAL FOUND ON THE PROJECT SHALL BE PLACED IN THE TOE KEY AREAS, WORKING UPWARDS TO FINISHED GRADE WITH THE LOWER CLASS MATERIAL) MEET THE DENSITY REQUIREMENT, SATISFACTORY MATERIAL SHALL BE ABLE TO COMPACT TO 95 PERCENT OF THE STANDARD PROCTOR PER ASTM D 698 SHALL BE WITHIN +/-4 PERCENT POINTS OF OPTIMUM MAXIMUM DRY DENSITY AS DETERMINED BY ASTM D 698, BE THE CORRECT PARTICLE SIZE PER THE PROJECT PLAN SET OR AS DETERMINED BY THE GEOTECHNICAL ENGINEER OR HIS REPRESENTATIVE OR THE KELLY SURVEYING PLLC REPRESENTATIVE.</div> <div>e. UNSATISFACTORY MATERIALS: INCLUDE THOSE MATERIALS CONTAINING ROOTS AND OTHER ORGANIC MATTER, TRASH, DEBRIS, FROZEN MATERIALS, EXCESSIVELY WET MATERIAL, MATERIAL THAT EXCEEDS THE PARTICLE SIZE OR MATERIAL DETERMINE UNSATISFACTORY BY THE GEOTECHNICAL ENGINEER OR HIS REPRESENTATIVE OR THE KELLY SURVEYING PLLC REPRESENTATIVE.</div> <div>f. DEGREE OF COMPACTION: IS A PERCENTAGE OF THE MAXIMUM DENSITY OBTAINED BY THE TEST PROCEDURE PRESENTED IN ASTM D 698, AS A PERCENT OF LABORATORY MAXIMUM DENSITY, OR AS DETERMINED BY THE GEOTECHNICAL ENGINEER OR HIS REPRESENTATIVE OR THE KELLY SURVEYING PLLC REPRESENTATIVE</div> <div>g. OPTIMUM MOISTURE: MAXIMUM DENSITY CURVE FOR EACH TYPE OF SOIL USED FOR ENGINEERED CONTROLLED FILL.</div> <div>h. TOPSOIL: MATERIAL OBTAINED FROM EXCAVATIONS, SUITABLE FOR TOP SOILS SHALL CONSIST OF FRIABLE CLAY LOAM, FREE FROM ROOTS, STONES, OTHER UNDESIRABLE MATERIAL AND SHALL BE CAPABLE OF SUPPORTING A GOOD GROWTH OF GRASS.</div> <div>i. SOIL BEARING CAPACITY: SOIL UNDERNEATH ALL FOOTINGS AND STRUCTURES SHALL HAVE A MINIMUM BEARING CAPACITY OF 2000 POUNDS PER SQUARE FOOT. AS DETERMINED BY THE GEOTECHNICAL ENGINEER OR HIS REPRESENTATIVE.</div> <div>4. TEST BORINGS: A SUBSURFACE INVESTIGATION HAS BEEN MADE AT THE SITE OF THE PROJECT IN ORDER TO ASCERTAIN CHARACTER OF MATERIALS TO BE EXCAVATED. THIS INFORMATION IS PROVIDED FOR GENERAL INFORMATION ONLY. ATTENTION IS DIRECTED TO THE FACT THAT THESE LOGS INDICATE MATERIALS ENCOUNTERED AT BORING LOCATIONS ONLY. NOTHING IN THE PLANS OR SPECIFICATIONS SHALL BE TAKEN AS A GUARANTEE THAT MATERIALS OTHER THAN THOSE DISCLOSED BY BORINGS WILL BE ENCOUNTERED OR THAT PROPORTIONS OF VARIOUS MATERIALS WILL NOT VARY FROM THOSE INDICATED. IF THE CONTRACTOR HAS ANY QUESTIONS OR DESIRES ADDITIONAL INFORMATION IT IS HIS RESPONSIBILITY TO ACQUIRE THIS INFORMATION AT HIS OWN EXPENSE. ALL EXCAVATION FOR PROJECT IS TO BE CONSIDERED AS BID AND NO ALLOWANCES WILL BE MADE FOR ROCK ENCOUNTERED OR REMOVAL AND REPLACEMENT OF UNSUITABLE MATERIAL.</div> <div>5. CONSTRUCTION: a. CONSERVATION OF TOPSOIL: TOPSOIL SHALL BE REMOVED AS REQUIRED WITHOUT CONTAMINATION WITH SUBSOIL AND STOCKPILED AT CONVENIENT AREAS FOR LATER APPLICATION OR AT LOCATIONS SPECIFIED IN THE PROJECT PLAN SET. ANY SURPLUS OF TOPSOIL FROM EXCAVATIONS AND GRADING SHALL BE STOCKPILED IN A LOCATION APPROVED BY THE GEOTECHNICAL ENGINEER OR HIS REPRESENTATIVE OR THE KELLY SURVEYING PLLC REPRESENTATIVE</div> <div>b. PLACING TOPSOIL: ON AREAS TO RECEIVE TOPSOIL, THE COMPACTED AREA SHALL BE SCARIFIED TO A 2 INCH DEPTH FOR BONDING OF TOPSOIL WITH SUBSOIL. TOPSOIL THEN SHALL BE SPREAD EVENLY AND GRADED TO THE ELEVATIONS AND SLOPES SHOWN. TOPSOIL SHALL NOT BE SPREAD WHEN FROZEN OR EXCESSIVELY WET OR DRY OR EXCEED FOUR (4) INCHES IN DEPTH ON SLOPES STEEPER THAN THREE TO ONE (3:1)</div> <div>c. EXCAVATION: EXCAVATION SHALL BE FOR THOSE ITEMS SPECIFICALLY INDICATED IN THE PROJECT PLAN SET, AFTER TOPSOIL REMOVAL HAS BEEN COMPLETED, EXCAVATION OF EVERY DESCRIPTION, REGARDLESS OF MATERIAL ENCOUNTERED, WITHIN THE GRADING LIMITS OF THE PROJECT SHALL BE PERFORMED TO REASONABLE CONFORMANCE TO THE LINES AND GRADES INDICATED IN THE PROJECT PLAN SET. SATISFACTORY EXCAVATED MATERIAL SHALL BE TRANSPORTED TO AND PLACED IN FILL AREAS WITHIN THE LIMITS OF THE WORK. UNSATISFACTORY MATERIAL SOFT OR OTHERWISE UNSATISFACTORY MATERIAL SHALL BE REPLACED WITH SATISFACTORY MATERIAL EXCAVATED MATERIAL OR OTHER APPROVED MATERIALS. ALL UNSUITABLE MATERIAL INCLUDING ANY SOIL WHICH IS DISTURBED BY THE CONTRACTOR'S OPERATIONS AND SURPLUS MATERIAL SHALL BE REGRADED SEEDED AND MULCHED EXCAVATION AND FILLING SHALL BE PERFORMED IN A MANNER AND SEQUENCE THAT WILL PROVIDE DRAINAGE AT ALL TIMES. EXCAVATIONS SHALL BE KEPT FREE FROM WATER WHILE CONSTRUCTION THEREIN IS IN PROGRESS. IF THE CONTRACTOR FAILS TO PROVIDE ADEQUATE DRAINAGE AND THE MATERIAL BECOMES SOFT OR OTHERWISE UNSUITABLE AS A RESULT, SUCH MATERIAL SHALL BE REMOVED AND REPLACED WITH SATISFACTORY ON SITE MATERIAL OR BORROW MATERIAL FROM APPROVED LOCATIONS, OR SHALL BE DRIED AND RECOMPACTED AS DIRECTED BY THE GEOTECHNICAL ENGINEER OR HIS REPRESENTATIVE OR THE KELLY SURVEYING PLLC REPRESENTATIVE</div> <div>d. DITCHES, GUTTERS, AND CHANNEL CHANGES: DITCHES, GUTTERS, AND CHANNEL CHANGES OR ANY SIMILAR CONSTRUCTED CONVEYANCE SHALL BE CUT ACCURATELY TO THE CROSS SECTIONS AND GRADES INDICATED. ALL ROOTS, STUMPS, ROCK, AND FOREIGN MATTER IN THE SIDES AND BOTTOM OF DITCHES, GUTTERS, AND CHANNEL CHANGES SHALL BE TRIMMED AND DRESSED OR REMOVED TO CONFORM TO THE SLOPE, GRADE, AND SHAPE OF THE SECTION INDICATED. CARE SHALL BE TAKEN TO EXCAVATE DITCHES AND GUTTERS TO THE GRADES INDICATED. EXCESSIVE DITCH AND GUTTER EXCAVATION SHALL BE BACKFILLED TO GRADE EITHER WITH COMPACTED TO SPECIFIED DENSITIES MATERIAL OR WITH SUITABLE STONE OR AGGREGATE TO FORM AN ADEQUATE CONVEYANCE STRUCTURE AS DIRECTED. ALL DITCHES AND GUTTERS EXCAVATED SHALL BE MAINTAINED UNTIL FINAL ACCEPTANCE OF THE WORK. SATISFACTORY MATERIAL EXCAVATED FROM DITCHES AND CHANNEL CHANGES SHALL BE PLACED IN FILL AREAS OR AREAS APPROVED BY THE GEOTECHNICAL ENGINEER OR HIS REPRESENTATIVE OR THE KELLY SURVEYING PLLC REPRESENTATIVE UNSUITABLE AND EXCESS MATERIAL SHALL BE DISPOSED OF IN DESIGNATED WASTE AREAS OR AS DIRECTED THE GEOTECHNICAL ENGINEER OR HIS REPRESENTATIVE OR THE KELLY SURVEYING PLLC REPRESENTATIVE</div> <div>e. STABILITY OF EXCAVATIONS: MAINTAIN SIDES AND SLOPES OF EXCAVATIONS IN A MANNER SUCH THAT THE EXCAVATION PROVIDES SAFETY OF PERSONNEL, CFR 29 PART 1926 SUBPART P PROTECTION OF WORK, AND COMPLIANCE WITH REQUIREMENTS OF ALL JURISDICTIONAL AGENCIES.</div> <div>f. PREPARATION OF GROUND SURFACE FOR FILL: ALL VEGETATION SUCH AS ROOTS, BRUSH, HEAVY SODS, HEAVY GROWTH OF GRASS, AND ALL DECAYED VEGETATIVE MATTER, RUBBISH, AND OTHER UNSATISFACTORY MATERIAL WITHIN THE AREA UPON WHICH FILL IS TO BE PLACED, SHALL BE STRIPPED OR OTHERWISE REMOVED BEFORE THE FILL IS STARTED. IN NO CASE WILL UNSATISFACTORY MATERIAL REMAIN IN OR UNDER THE FILL AREA. THE AREAS SHALL THEN BE EXCAVATED TO DURABLE MATERIAL CAPABLE OF ACCEPTING SUPPORTING THE FILL. THE DEPTH SHALL BE AS DIRECTED BY THE GEOTECHNICAL ENGINEER OR HIS REPRESENTATIVE OR THE KELLY SURVEYING PLLC REPRESENTATIVE ALL AREAS TO RECEIVE FILL SHALL BE COMPACTED WITH VIBRATORY ROLLERS, PNEUMATIC ROLLERS, SHEEPSFOOT ROLLERS OR OTHER MECHANICAL MEANS ACCEPTABLE TO THE GEOTECHNICAL ENGINEER OR SITE INSPECTOR. GROUND SURFACES ON WHICH FILL IS TO BE PLACED SHALL BE PLOWED, STEPPED, BENCHED, OR BROKEN UP, AS DIRECTED, IN SUCH MANNER THAT THE FILL MATERIAL WILL BOND WITH THE EXISTING SURFACE. PREPARED SURFACES ON WHICH COMPACTED FILL IS TO BE PLACED SHALL BE WETTED OR DRIED AS MAY BE REQUIRED TO OBTAIN THE SPECIFIED MOISTURE CONTENT AND DENSITY. BEFORE ANY AREA CAN RECEIVE FILL IT MUST BE APPROVED BY THE GEOTECHNICAL ENGINEER OR HIS REPRESENTATIVE OR THE KELLY SURVEYING PLLC REPRESENTATIVE</div> <div>g. FILLS AND EMBANKMENTS: FILLS AND EMBANKMENTS SHALL BE CONSTRUCTED AT THE LOCATIONS AND TO LINES AND GRADES INDICATED. THE COMPLETED FILL SHALL CONFORM TO THE PROJECT PLAN SET. APPROVED MATERIAL OBTAINED DURING EXCAVATION MAY BE USED IN FORMING REQUIRED FILL. FILL SHALL BE CONSTRUCTED WITH SATISFACTORY MATERIAL AND SHALL BE FREE FROM ROOTS, OTHER ORGANIC MATERIAL. NO FROZEN MATERIAL WILL BE PERMITTED IN THE FILL. ALL FILL MATERIAL SHALL BE APPROVED BY THE GEOTECHNICAL ENGINEER OR HIS REPRESENTATIVE OR THE KELLY SURVEYING PLLC REPRESENTATIVE</div> <div>h. COMPACTION: EACH LAYER OF THE FILL SHALL BE COMPACTED TO AT LEAST 95 PERCENT OF THE MAXIMUM THEORETICAL DENSITY AS DETERMINED BY ASTM D 698. MOISTURE CONTENT SHALL BE WITHIN +/-4 PERCENT POINTS OF OPTIMUM MAXIMUM DRY DENSITY AS DETERMINED BY ASTM D 698.</div> <div>i. FINISHED GRADE : ALL AREAS COVERED BY THE PROJECT PLAN SET, INCLUDING EXCAVATED AND FILLED SECTIONS AND ADJACENT TRANSITION AREAS, SHALL BE UNIFORMLY SMOOTH-GRADED. THE FINISHED SURFACE SHALL BE REASONABLY SMOOTH, COMPACTED, AND FREE FROM IRREGULAR SURFACE CHANGES. THE DEGREE OF FINISH SHALL BE WITHIN THE TOLERANCES LISTED IN THE PROJECT PLAN SET EXCEPT AS APPROVED BY THE THE GEOTECHNICAL ENGINEER OR HIS REPRESENTATIVE OR THE KELLY SURVEYING PLLC REPRESENTATIVE DITCHES AND GUTTERS SHALL BE FINISHED TO PERMIT ADEQUATE DRAINAGE AND WITHIN THE TOLERANCES LISTED IN THE PROJECT PLAN SET LOW AREAS RESULTING FROM REMOVAL OF UNSUITABLE MATERIAL OR FROM EXCAVATION OF ROCK SHALL BE BROUGHT UP TO REQUIRED GRADE WITH SATISFACTORY MATERIALS, AND THE ENTIRE AREA SHALL BE SHAPED TO LINE, GRADE, AND CROSS SECTION AND SHALL BE COMPACTED AS SPECIFIED</div> <div>j. PROTECTION SITE PRESERVATION: THE CONTRACTOR, PRIOR TO FINAL ACCEPTANCE OF THE WORK SHALL MAINTAIN GRADE OR REPAIR ALL AREAS TO THE LINES, GRADES, AND CROSS SECTIONS SHOWN IN THE PROJECT PLAN SET AND PROTECT FROM TRAFFIC, WIND, WATER EROSION, WASHOUTS, SETTLEMENT, SUBSIDENCE, OR OTHER MISHAPS WHICH MAY OCCUR, REPAIR ANY SLIDES, AND ANY SETTLEMENT OR WASHING AWAY THAT MAY OCCUR FROM ANY CAUSE, PRIOR TO THE ACCEPTANCE,</div> <div>k. TESTING: THE CONTRACTOR SHALL GIVE THE OWNER OR HIS REPRESENTATIVE AT LEAST 48 HOURS NOTICE PRIOR TO OPENING ANY NEW SOIL EXCAVATION AND/OR BARROW AREAS TO BE USED IN EMBANKMENT/FILL CONSTRUCTION. SAID NOTICE IS REQUIRED TO GIVE THE OWNER ADEQUATE TIME TO OBTAIN SOIL SAMPLES FOR MOISTURE DENSITY TESTING (COMPACTION TEST) TO MONITOR FILL PLACEMENT. IF REQUIRED, THE CONTRACTOR SHALL SUPPLY THE NECESSARY EQUIPMENT AND OPERATOR TO OBTAIN THE SOIL SAMPLES. TEST SHALL BE MADE BY THE GEOTECHNICAL ENGINEER OR HIS REPRESENTATIVE</div> <div>h. TESTING FREQUENCY: A MINIMUM OF ONE MOISTURE-DENSITY TEST SHALL BE PERFORMED FOR EACH CLASSIFICATION OF FILL MATERIAL, A MINIMUM OF ONE TEST PER LIFT OR PER 1000 SQUARE FEET OR FRACTION THEREOF IS REQUIRED FOR FILL MATERIAL OR AS DETERMINED BY THE GEOTECHNICAL ENGINEER.</div> <div>i. VISUAL INSPECTION: UPON COMPLETION OF AND DURING THE INSTALLATION OF ANY PRODUCT OR MATERIAL OR ALL EARTH WORK OPERATIONS, CUTTING, FILLING ETC. THE GEOTECHNICAL ENGINEER OR HIS REPRESENTATIVE OR THE KELLY SURVEYING PLLC REPRESENTATIVE SHALL VISUALLY INSPECT ALL MATERIALS AND EXCAVATIONS. THE VISUAL INSPECTION SHALL BE CONDUCTED TO ASSURE THAT THE DATA OBTAINED FROM THE TEST RESULTS AND THE PROJECT PLAN SET ARE REPRESENTATIVE OF THE SITE CONDITIONS.</div> <div>6 PARTICLE SIZE USED IN FILL AREAS: THE MATERIAL SHALL BE PLACED IN SUCCESSIVE HORIZONTAL LAYERS OF 15 INCHES IN LOOSE DEPTH, 12 INCHES COMPACTED FOR THE FULL WIDTH OF THE CROSS SECTION AND SHALL BE COMPACTED AS SPECIFIED. EACH LAYER SHALL BE COMPACTED AND TESTED BEFORE THE OVERLAYING LIFT IS PLACED. MOISTURE CONTENT OF THE FILL OR BACKFILL MATERIAL SHALL BE ADJUSTED BY WETTING OR AERATING AS NECESSARY TO PROVIDE THE MOISTURE CONTENT SPECIFIED, OR AS DETERMINED BY GEOTECHNICAL ENGINEER OR HIS REPRESENTATIVE OR THE KELLY SURVEYING PLLC INSPECTOR.</div> <div>a. CONSTRUCTION OF FRESH WATER IMPOUNDMENTS: CONSTRUCT THE EMBANKMENT USING MAXIMUM PARTICLE SIZES (IN ANY DIMENSION) AS IN TOP 36 INCHES: 3 INCHES (IN ANY DIMENSION). 36 TO 48 INCHES: 6 INCHES (IN ANY DIMENSION). IN THE DEPTH BELOW 24 INCHES: NOT TO EXCEED 12 INCHES (IN ANY DIMENSION), THE ENTIRE LIFT SHALL NOT BE CONSTRUCTED WITH 12 INCH MATERIAL OR THE COMPACTED THICKNESS OF THE LAYER BEING PLACED, WHICHEVER IS LESS, THE 12 INCH MATERIAL SHALL BE MIXED WITH SMALLER PARTICLES TO PRODUCE A UNIFORM VOID FREE LIFT SPREAD ALL MATERIAL SO THAT THE LARGER PARTICLES ARE SEPARATED FROM EACH OTHER TO MINIMIZE VOIDS BETWEEN THEM DURING COMPACTION. COMPACT AROUND THESE ROCKS IN ACCORDANCE WITH THE COMPACTION REQUIREMENTS. EXCEPTING THAT LARGER MATERIAL, LESS THAN 18 INCHES IN ANY DIMENSIONS CAN BE USED IN THE TOE KEY AREA TO A POINT MEASURED ON THE LOWEST POINT OF THE SLOPE 24 INCHES BELOW ORIGINAL GROUND. IN AREAS THAT EXCEED 12 INCH LIFT THICKNESS, PROOF ROLLING MAY BE USED TO SATISFY THE COMPACTION REQUIREMENTS</div> <div>ALL MATERIAL WILL BE AT THE DISCRETION OF THE GEOTECHNICAL ENGINEER OR HIS REPRESENTATIVE OR THE KELLY SURVEYING PLLC REPRESENTATIVE.</div> <div>b. CONSTRUCTION OF THE WELL DRILL PAD OR FACILITY PAD: CONSTRUCT THE PAD BASE USING MAXIMUM PARTICLE SIZES (IN ANY DIMENSION) AS IN TOP 48 INCHES: 3 INCHES (IN ANY DIMENSION). 48 INCHES AND BELOW : 6 TO 12 INCHES (IN ANY DIMENSION). IN THE DEPTH BELOW 48 INCHES: NOT TO EXCEED 12 INCHES (IN ANY DIMENSION), THE ENTIRE LIFT SHALL NOT BE CONSTRUCTED WITH 12 INCH MATERIAL OR THE COMPACTED THICKNESS OF THE LAYER BEING PLACED, WHICHEVER IS LESS, THE 12 INCH MATERIAL SHALL BE MIXED WITH SMALLER PARTICLES TO PRODUCE A UNIFORM VOID FREE LIFT SPREAD ALL MATERIAL SO THAT THE LARGER PARTICLES ARE SEPARATED FROM EACH OTHER TO MINIMIZE VOIDS BETWEEN THEM DURING COMPACTION. COMPACT AROUND THESE ROCKS IN ACCORDANCE WITH THE COMPACTION REQUIREMENTS. EXCEPTING THAT LARGER MATERIAL, LESS THAN 18 INCHES IN ANY DIMENSION CAN BE USED IN THE TOE KEY AREA TO A POINT MEASURED ON THE LOWEST POINT OF THE SLOPE 24 INCHES BELOW ORIGINAL GROUND. IN AREAS THAT EXCEED 12 INCH LIFT THICKNESS, PROOF ROLLING MAY BE USED TO SATISFY THE COMPACTION REQUIREMENTS ALL MATERIAL WILL BE AT THE DISCRETION OF THE GEOTECHNICAL ENGINEER OR HIS REPRESENTATIVE OR THE KELLY SURVEYING PLLC REPRESENTATIVE.</div> <div>c. ENGINEERED ADDITIONAL FILL AREAS: 3 TO 12 INCHES OR SMALLER EXCEPTING THAT LARGER MATERIAL, LESS THAN 18 INCHES IN ANY DIMENSION CAN BE USED IN THE TOE KEY AREA TO A POINT MEASURED ON THE LOWEST POINT OF THE SLOPE 24 INCHES BELOW ORIGINAL GROUND. WHEN AND WHERE APPROVED BY THE ENGINEER, LARGER ROCKS (NOT TO EXCEED 18 INCHES IN ANY DIMENSION) MAY BE PLACED AT THE DISCRETION OF THE GEOTECHNICAL ENGINEER OR HIS REPRESENTATIVE OR THE KELLY SURVEYING PLLC REPRESENTATIVE. COMPACT AROUND THESE ROCKS TO A FIRMNESS EQUAL TO THAT OF THE SUPPORTING SOIL. IN AREAS THAT EXCEED 12 INCH LIFT THICKNESS, PROOF ROLLING MAY BE USED TO SATISFY THE COMPACTION REQUIREMENTS</div> <div data-cs="2" data-kind="parent">1221 Well Site Fink Creek Access HG Energy LLC Exhibit A: As-Built Modification</div> <div>7. PROOF ROLLING: IMMEDIATELY FOLLOWING THE COMPLETION OF EARTH WORK OR COMPLETION OF THE LIFT IN THE AREA TO BE PROOF ROLLED AND ONLY FOR THE LIFT THAT THE GEOTECHNICAL ENGINEER OR KELLY SURVEYING PLLC HAVE GRANTED A WAIVER ON THE MATERIAL PARTICLE SIZE FOLLOWING A VISUAL INSPECTION, CONTRACTOR SHALL DEMONSTRATE THE FINISHED LIFT DOES NOT CONTAIN PREVIOUSLY UNIDENTIFIED SOFT AREAS, OBSERVING THE SURFACE FOR DISPLACEMENT OR DEFORMATION. THE COVERAGE AREAS AND METHODS SHALL BE AS DIRECTED BY THE GEOTECHNICAL ENGINEER OR HIS REPRESENTATIVE OR THE KELLY SURVEYING PLLC REPRESENTATIVE THE LIFT SHALL THEN BE PROOF ROLLED. PROOF ROLLING SHALL BE DONE WITH ONE PASS OF A FULLY LOADED TANDEM DUMP TRUCK EQUAL TO OR EXCEEDING 50,000 LBS OR EQUALLY SIZED APPROVED CONSTRUCTION EQUIPMENT THE EQUIPMENT SHALL BE OPERATED AT A SPEED THAT THE GEOTECHNICAL ENGINEER OR HIS REPRESENTATIVE OR THE KELLY SURVEYING PLLC REPRESENTATIVE CAN COMFORTABLY AND SLOWLY WALK ALONG SIDE THE EQUIPMENT; ANY AREAS WHICH DEFLECT, RUT OR PUMP UNDER THE LOADED DUMP TRUCK SHALL BE UNDERCUT AND REPLACED WITH COMPACTED FILL MATERIAL OR OR SMALLER MATERIAL WORKED UNTIL A RELATIVELY UNYIELDING SURFACE IS ACHIEVED</div> <div><div>Revision Design</div><div>Date 02-04-2025</div><div></div><div>THIS DOCUMENT PREPARED FOR HG ENERGY LLC</div><div><div>PO Box 254 Biller, WV 26209 606338-0965</div></div><div>Construction and Earth Work General Notes</div><div>1221 Well Site Freemans Creek District Lewis County, WV</div><div>APPROVED WVDEP OOG Modification 3/14/2025</div><div>Date: 02/04/2025 Scale: As Shown Designed By: ZS File No. Sheet N3 of N4</div></div>	
--	--

1. OBJECTIVES

VEGETATIVE COVER OF 70% OR GREATER WOULD GENERALLY MEET THIS REQUIREMENT. CONSIDERATIONS FOR THE IMPROVEMENT OF WATER QUALITY AND WILDLIFE HABITAT ARE INCORPORATED INTO THIS SECTION. WITH PRIOR AND DOCUMENTED APPROVAL, THESE STANDARDS MAY BE ADJUSTED AND MODIFIED TO MEET INDIVIDUAL SITE REQUIREMENTS.

1. WATER CONTROL

2. SEEDBED PREPARATION

THE SEEDBED MUST BE LOOSE AT THE TIME OF SEEDING. APPLICATIONS OF SEED ON HARD GROUND WILL RESULT IN A POOR STAND OF VEGETATION. THE SOIL SURFACE MUST BE LOOSENEED (MINIMUM OF 3 INCHES) BY DISKING ON THE CONTOUR, OR BY BULLDOZER TRACKING UP AND DOWN THE SLOPE. BACKLAPPING IS ACCEPTABLE ON GENTLE SLOPES SUCH AS THE BENCH OR ROAD BED. IF SEEDBED PREPARED BY DISKING, 50% MORE SEED SHALL BE ADDED TO THE RECOMMENDED RATES SHOWN IN TABLES 3-4. WHERE HYDROSEEDING SEEDBED PREPARATION MAY NOT BE NECESSARY IF ADEQUATE SITE PREPARATION WAS PERFORMED. APPLY ALL NUTRIENT REQUIREMENTS IMMEDIATELY PRIOR TO SEEDING. SOIL FERTILITY AND pH LEVELS SHOULD BE TESTED AND ADJUSTED ACCORDING TO THE SEED SPECIES PLANTED. WHERE SAMPLING IS IMPRACTICAL OR NOT FEASIBLE, AN ALL-INCLUSIVE FERTILIZER RECOMMENDATION MAY BE USED AS SHOWN IN TABLE 1.

APPLY LIME TO BRING SOIL pH TO A RANGE SUITABLE (pH 6.0) FOR THE PLANNED SPECIES. IN ABSENCE OF A SOIL TEST, 3 TONS / ACRE OF LIME MAY BE APPLIED (150 LBS / 1,000 SF). INCORPORATE THE APPROPRIATE AMOUNT OF LIME AND/OR FERTILIZER IN THE SLURRY MIX WHEN HYDROSEEDING.

1. TEMPORARY SEEDING

WITH SEDIMENT CONTROLS MUST BE ESTABLISHED WHERE RUNOFF WILL GO DIRECTLY INTO A STREAM. IMMEDIATELY UPON CONSTRUCTION OF THE SITE (SITE INCLUDES ROADS AND LOCATION), VEGETATION MUST BE ESTABLISHED ON ROAD BANK AND LOCATION SLOPES. A PERMANENT VEGETATIVE COVER SHALL BE APPLIED TO ALL AREAS THAT WILL BE LEFT UNWORKED FOR A PERIOD OF MORE THAN 6 MONTHS.

PERMANENT PLANT SPECIES, AND PLANTING RATES. TABLE 3 GIVES RECOMMENDED TYPES OF TEMPORARY VEGETATION, RATES OF APPLICATION, AND OPTIMUM SEEDING DATES. IN SITUATIONS WHERE ANOTHER COVER IS DESIRED, CONTACT THE LOCAL SOIL CONSERVATION DISTRICT FOR SEEDING RECOMMENDATIONS.

APPLIED BY BROADCASTING, DRILLING, OR BY HYDROSEEDING ACCORDING TO THE RATES INDICATED IN TABLE 1. FERTILIZER ALL PLANTING OPERATIONS AT RIGHT ANGLES TO THE SLOPE. NECESSARY SITE PREPARATION, ROUGHENING OF THE SOIL SURFACE, SHOULD BE PERFORMED JUST PRIOR TO SEEDING. SEEDBED PREPARATION MAY NOT BE REQUIRED ON NEWLY DISTURBED AREAS.

Species	N (lb/ac)	P2O5 (lb/ac)	K2O (lb/ac)	Example Rec. (per ac)
Cool Season Grass	40.00	80.00	80.00	400 lbs. 10-20-20
Cool Season Grass & Legume	30.00	60.00	60.00	300 lbs. 10-20-20
Temporary Cover	40.00	40.00	40.00	200 lbs. 19-19-19

Note: These rates should be increased by 50% if planted Apr 15 - Aug 1 and Oct 1 - Mar 1

A. GENERAL

PERMANENT VEGETATIVE COVER WILL BE ESTABLISHED WHERE NO FURTHER SOIL DISTURBANCE IS ANTICIPATED OR NEEDED. SOIL FERTILITY AND pH LEVEL SHOULD BE TESTED AND ADJUSTED ACCORDING TO THE SEED SPECIES PLANTED. PLANTING OF PERMANENT VEGETATIVE COVERS MUST BE PERFORMED ON ALL DISTURBED AREAS AFTER THE COMPLETION OF THE DRILLING PROCESS. ANY SITE THAT CONTAINS SIGNIFICANT AMOUNTS OF TOPSOIL SHALL HAVE THE TOPSOIL REMOVED AND STOCKPILED WHEN FEASIBLE. TOPSOIL SHOULD NOT BE ADDED TO SLOPES STEEPER THAN 2:1 UNLESS A GOOD BONDING TO THE SUB-LAYER CAN BE ACHIEVED. AFTER PROPER GRADING AND SEEDBED PREPARATION, THE VEGETATION WILL REESTABLISH GROUND COVER FOR THE CONTROL OF SURFACE WATER RUNOFF AND EROSION.

ALL REQUIRED SEEDBED PREPARATION, LOOSENING OF SOIL BY DISKING OR DOZER TRACKING, SHOULD BE PERFORMED JUST PRIOR TO SEEDING. IF SEEDBED PREPARATION IS NOT FEASIBLE, 50% MORE SEED SHALL BE ADDED TO THE RECOMMENDED RATES SHOWN IN TABLES IV 3-4.

WHEN HYDROSEEDING, SEEDBED PREPARATIONS MAY NOT BE NECESSARY IF ADEQUATE SITE PREPARATION WAS PERFORMED. INCORPORATE THE APPROPRIATE AMOUNT OF LIME AND/OR FERTILIZER IN THE SLURRY MIX WHEN HYDROSEEDING. WHEN HYDROSEEDING, FIRST MIX THE LIME, FERTILIZER, AND HYDRO-MULCH IN THE RECOMMENDED AMOUNT OF WATER. MIX THE SEED AND INOCULANT TOGETHER WITHIN ONE HOUR PRIOR TO PLANTING, AND ADD THE SLURRY JUST BEFORE SEEDING. APPLY THE SLURRY UNIFORMLY OVER THE PREPARED SITE. ASSURE THAT AGITATION IS CONTINUOUS THROUGHOUT THE SEEDING OPERATION AND THAT THE MIX IS APPLIED WITHIN ONE HOUR OF INITIAL MIXING.

1. LIME SHALL BE APPLIED TO ALL PERMANENT SEEDINGS. THE pH OF THE SOIL IS TO BE DETERMINED AND LIME APPLIED ACCORDINGLY. ONCE THE pH IS KNOWN, SELECT THE AMOUNT OF LIME TO BE APPLIED FROM TABLE IV-5.
2. FERTILIZER SHALL BE APPLIED IN ALL PERMANENT SEEDINGS. APPLY THE EQUIVALENT OF 500 LBS MINIMUM 10-20-20 FERTILIZER PER ACRE OR USE THE AMOUNT OF FERTILIZER AND LIME RECOMMENDED BY A CERTIFIED SOIL TEST.
3. APPLICATION: FOR BEST RESULTS AND MAXIMUM BENEFITS, THE LIME AND FERTILIZER ARE TO BE APPLIED AT THE TIME OF SEEDBED PREPARATION.

PLANNERS SHOULD TAKE INTO CONSIDERATION THE SPECIES MAKEUP OF THE EXISTING PASTURE AND THE LANDOWNER'S FUTURE PASTURE MANAGEMENT PLANS WHEN RECOMMENDING SEED MIXTURES. SELECTION: FROM TABLES IV 4a AND b. PERMANENT SEEDING MIXTURES SHALL BE SUITABLE FOR ESTABLISHMENT IN WEST VIRGINIA.

2. 'LATHCO' FLATPEA IS POTENTIALLY POISONOUS TO SOME LIVESTOCK
3. ONLY ENDOPHYTE FREE VARIETIES OF TALL FESCUE SHOULD BE USED. TALL FESCUE AND CROWN VETCH ARE ALSO A VERY INVASIVE SPECIES NON-NATIVE TO WEST VIRGINIA.
4. FOR UNPREPARED SEEDBEDS OR SEEDING OUTSIDE THE OPTIMUM TIMEFRAMES, ADD 50% MORE SEED TO THE SPECIFIED RATE. MIXTURES IN TABLE 4b ARE MORE WILDLIFE AND FARM-FRIENDLY; THOSE LISTED IN BOLD ARE SUITABLE FOR USE IN SHADED WOODLAND SETTINGS. MIXTURES IN ITALIC ARE SUITABLE FOR USE IN FILTER STRIPS.

CONSIDER THE USE OF NATIVE PLANTS OR LOCALLY ADAPTED PLANTS WHEN SELECTING COVER TYPES AND SPECIES FOR WILDLIFE HABITAT. WILDLIFE FRIENDLY SPECIES OR MIXES THAT HAVE MULTIPLE VALUES SHOULD BE CONSIDERED. SEE WILDLIFE FRIENDLY SPECIES/MIXTURES IN TABLE IV-4b. CONSIDER SELECTING NO OR LOW MAINTENANCE LONG-LIVED PLANTS ADAPTABLE TO SITES WHICH MAY BE DIFFICULT TO MAINTAIN WITH EQUIPMENT.

THE APPLICATION OF STRAW, HAY, OR OTHER SUITABLE MATERIALS TO THE SOIL SURFACE TO PREVENT EROSION. STRAW MADE FROM WHEAT OR OATS IS THE PREFERRED MULCH, THE USE OF HAY IS PERMISSIBLE, BUT NOT ENCOURAGED DUE TO THE RISK OF SPREADING INVASIVE SPECIES. MULCH MUST BE APPLIED TO ALL TEMPORARY AND PERMANENT SEEDING ON ALL DISTURBED AREA. DEPENDING ON SITE CONDITIONS, IN CRITICAL AREAS SUCH AS WATERWAYS, OR STEEP SLOPES, ADDITIONAL OR SUBSTITUTE SOIL PROTECTIVE MEASURES MAY BE USED IF DEEMED NECESSARY. EXAMPLES INCLUDE JUTE MESH AND SOIL STABILIZATION BLANKETS OR EROSION CONTROL MATTING.

AREAS THAT HAVE BEEN TEMPORARILY OR PERMANENTLY SEEDED SHOULD BE MULCHED IMMEDIATELY FOLLOWING SEEDING. MULCHES CONSERVE DESIRABLE SOIL PROPERTIES, REDUCE SOIL MOISTURE LOSS, PREVENT CRUSTING AND SEALING OF THE SOIL SURFACE AND PROVIDE A SUITABLE MICROCLIMATE FOR SEED GERMINATION.

AREAS THAT CANNOT BE SEEDED BECAUSE OF THE SEASON SHOULD BE MULCHED TO PROVIDE SOME PROTECTION TO THE SOIL SURFACE. AN ORGANIC MULCH, STRAW OR HAY, SHOULD BE USED AND THE AREA THEN SEEDED AS SOON AS WEATHER OR SEASONAL CONDITIONS PERMIT. DO NOT USE FIBER MULCH (CELLULOSE-HYDROSEED) ALONE FOR THIS PRACTICE; AT NORMAL APPLICATION RATES IT WILL NOT GIVE THE SOIL PROTECTION OF OTHER TYPES OF MULCH.

WOOD CELLULOSE FIBER MULCH, IS USED IN HYDROSEEDING APPLICATIONS AND APPLIED AS PART OF THE SLURRY. IT CREATES THE BEST SEED-SOIL CONTACT WHEN APPLIED OVER TOP OF (AS A SEPARATE OPERATION) NEWLY SEEDED AREAS. FIBER MULCH DOES NOT ALONG PROVIDE SUFFICIENT PROTECTION ON HIGHLY ERODIBLE SOILS, OR DURING LESS THAN FAVORABLE GROWING CONDITIONS. FIBER MULCH SHOULD NOT BE USED ALONE DURING THE DRY SUMMER MONTHS OR WHEN USED FOR LATE FALL MULCH COVER. USE STRAW MULCH DURING THESE PERIODS, AND FIBER MULCH MAY BE USED TO TACK (ANCHOR) THE STRAW MULCH. FIBER MULCH IS WELL SUITED FOR STEEP SLOPES, CRITICAL AREAS, AND AREAS SUSCEPTIBLE TO WIND.

A WIDE RANGE OF SYNTHETIC, SPRAY-ON MATERIALS IS MARKETING TO STABILIZE AND PROTECT THE SOIL SURFACE. THESE ARE MIXED WITH WATER AND SPRAYED OVER THE MULCH AND THE SOIL. THEY MAY BE USED ALONE IN SOME CASES AS TEMPORARY STABILIZERS, OR IN CONJUNCTION WITH FIBER MULCH, STRAW OR HAY.

FROM TABLE IV-6 SELECT THE TYPE OF MULCH AND THE RATE OF APPLICATION THAT WILL BEST SUIT THE CONDITIONS AT THE SITE

DEPENDING ON THE FIELD SITUATION, MULCH MAY NOT STAY IN PLACE BECAUSE OF WIND ACTION OR RAPID WATER RUNOFF. IN SUCH CASES, MULCH IS TO BE ANCHORED MECHANICALLY OR WITH MULCH NETTING.

APPLY MULCH AND PULL ANCHORING TOOL OVER THE MULCH. WHEN A DISK IS USED, SET THE DISK STRAIGHT AND PULL ACROSS THE SLOPE. MULCH MATERIAL SHOULD BE TUCKED INTO THE SOIL ABOUT THREE INCHES.

FOLLOW MANUFACTURER'S RECOMMENDATIONS WHEN POSITIONING AND STAKING THE MOLEC NETTING IN THE SOIL.

The pH can be determined with a portable pH testing kit or by sending the soil samples to a soil testing

Material	Minimum Rates per Acre	Coverage	Remarks
Hay or Straw	2 to 3 Tons	Cover 75% to	Subject to Wind blowing
	100 to 150 Bales	90% of Surface	or washing unless tied down
Wood Fiber		Cover all	For Hydroseeding
Pulp Fiber	1,000 to 1,500 lbs	Disturbed Areas	03/14/2025
Wood-Cellulose			
Recirculated Paper			

221 Well Site Fink Creek Access

HG Energy LLC

Exhibit A: As-Built Modification

Table 4a. Permanent seeding mixtures suitable for establishment in WV

Tables IV 1-4 taken from Natural Resources Conservation Service Manual Critical Area Planting

Mixtures listed in bold are suitable for use in shaded woodland settings; those in italics are suitable for use in filter strips

*'Lathco' Flatpea is potentially poisonous to some livestock. All legumes should be planted with proper inoculants prior

to seeding. For unprepared seedbeds or seeding outside the optimum timeframes, add 50% more seed to the specified



THIS DOCUMENT
PREPARED FOR
HG ENERGY LLC



Construction and Earth Work General Notes

1221 Well Site

Freemans Creek District
Lewis County, WV

Lewis County, WV

Date: 02/04/2025
Scale: As Shown
Designed By: ZS
File No.
Sheet N4 of N4



1221 Well Site Fink Creek Access

HG Energy LLC

Exhibit A: As-Built Modification



Revision
Design

Date
02-04-2025




THIS DOCUMENT
PREPARED FOR
HG ENERGY LLC



Pre-Construction Site Conditions
1221 Well Site
Freemans Creek District
Lewis County, WV

Date: 02/04/2025
Scale: As Shown
Designed By: ZS
File No.
Sheet 2 of 32

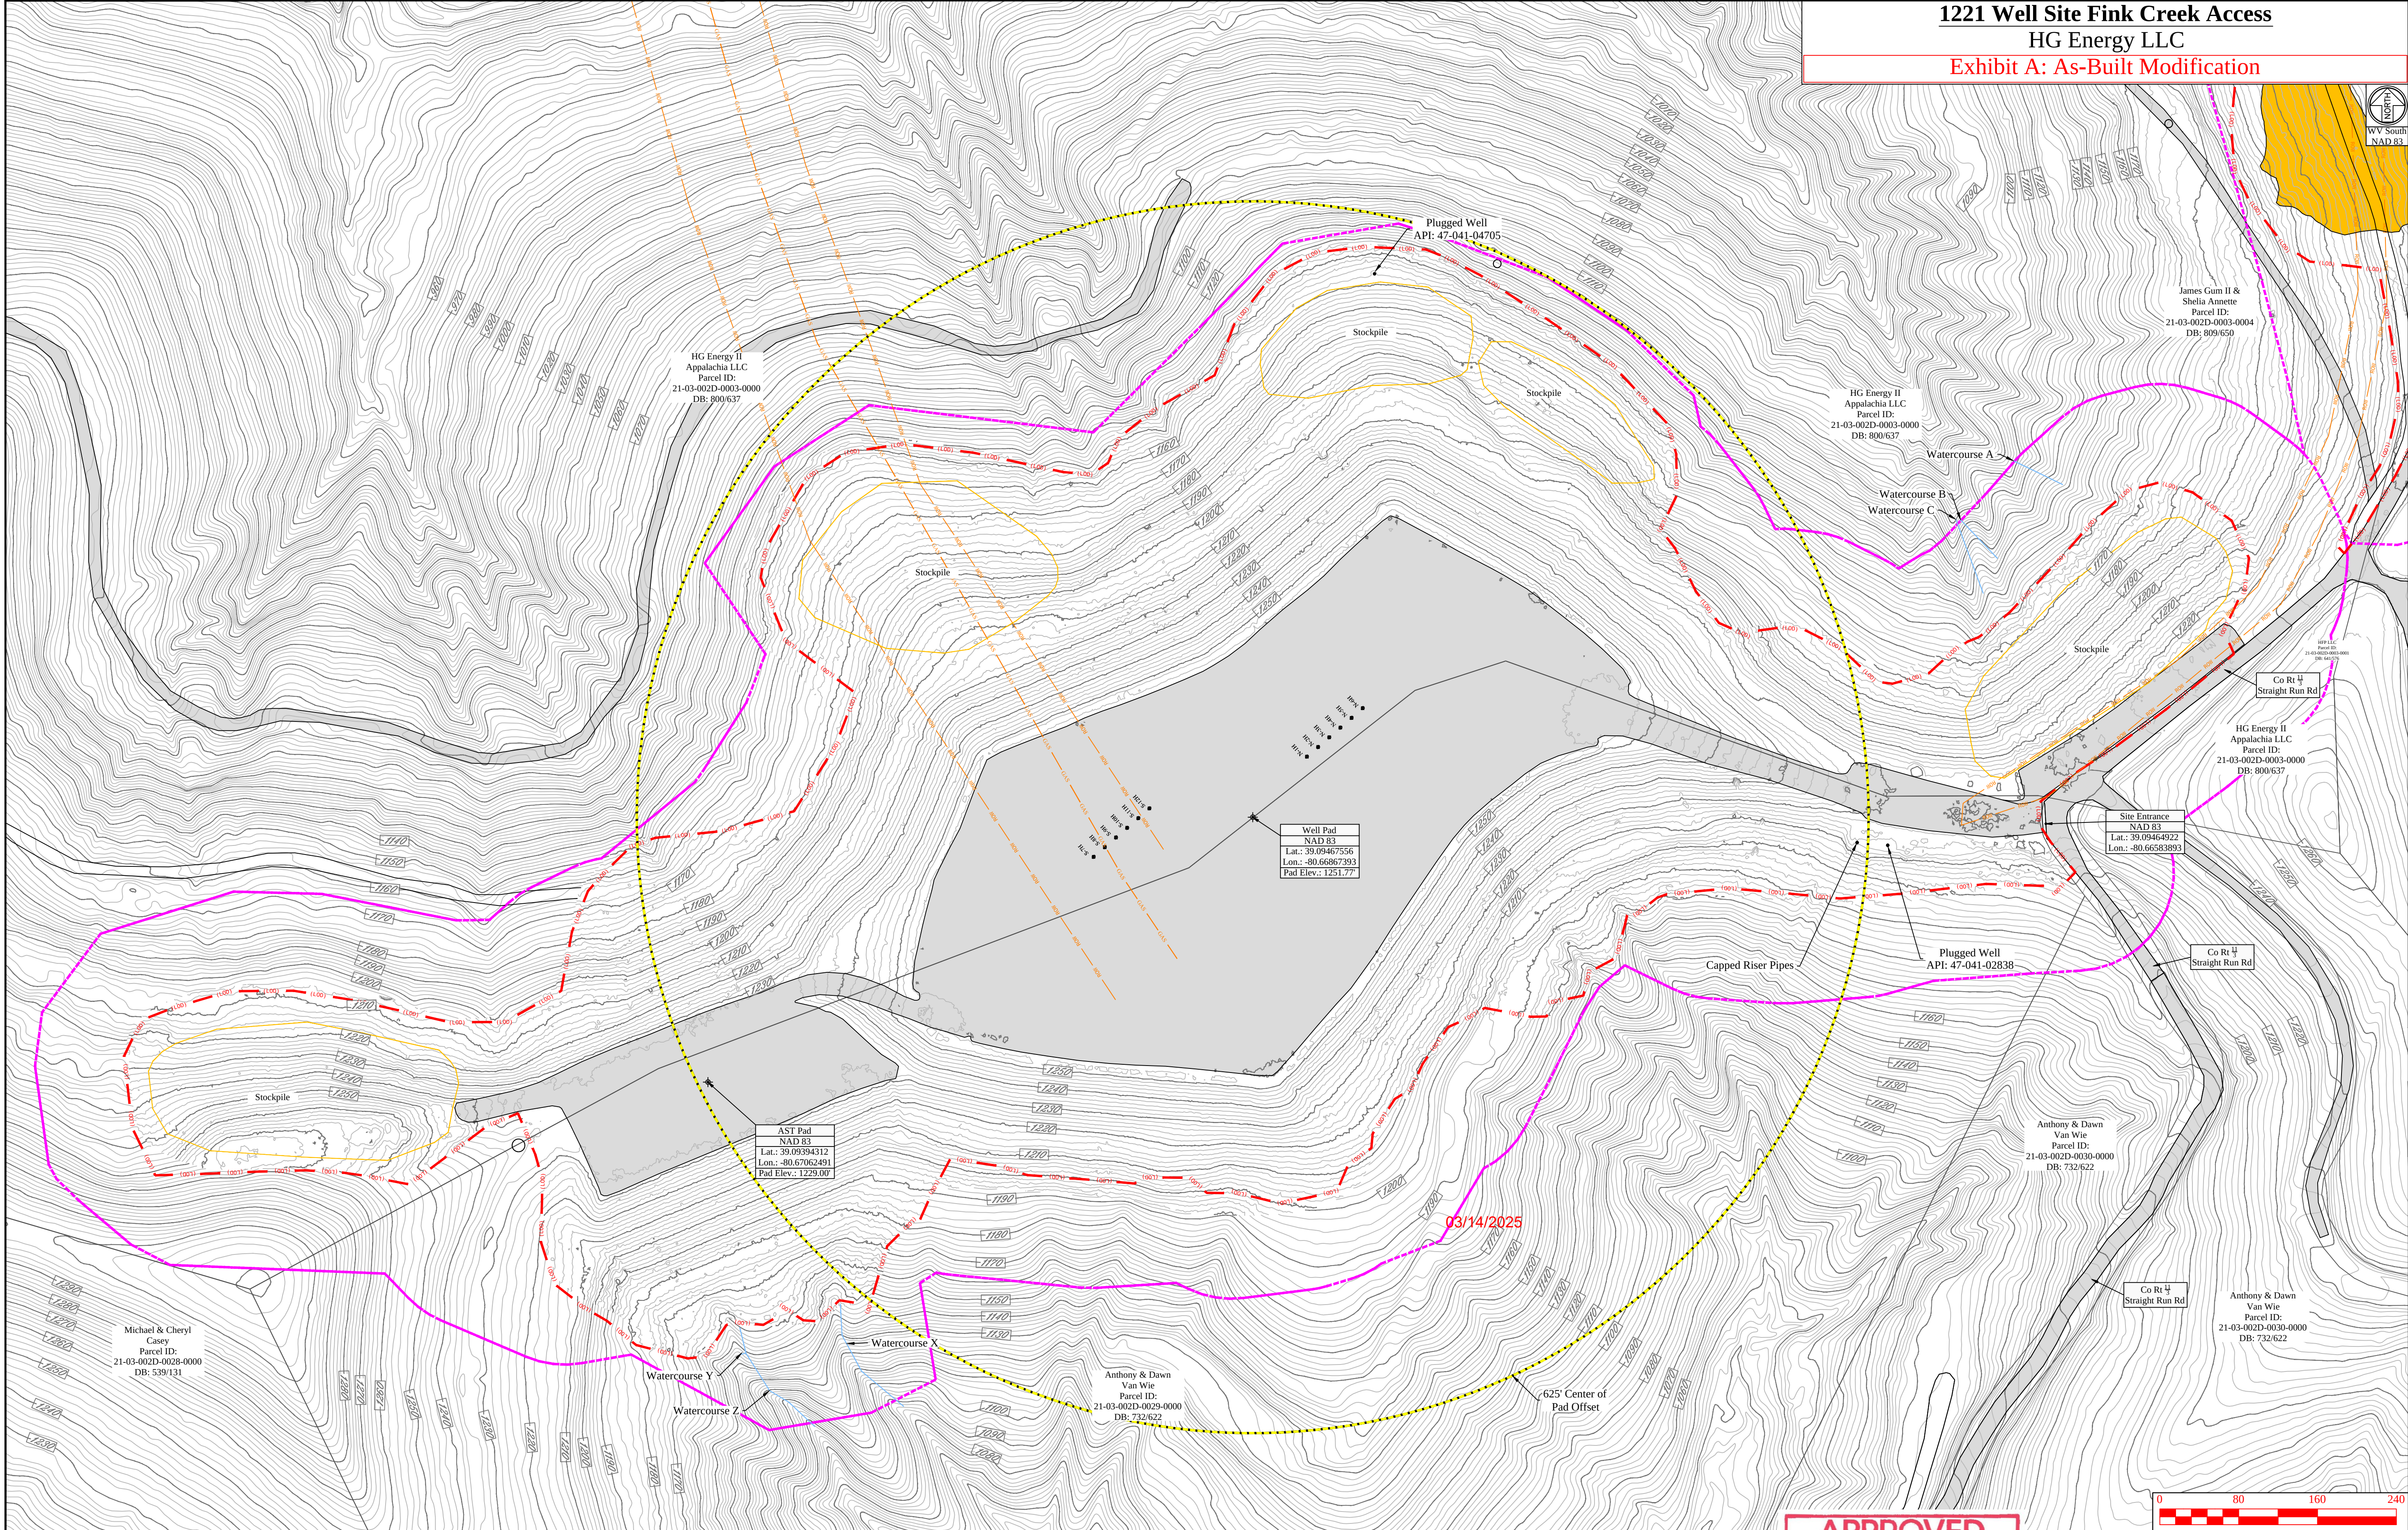


Legend	
	Original Ground 2' Contour
	Original Ground 10' Contour
	Design 2' Contour
	Design 10' Contour
	Property
	Center of Structure
	Belted Silt Retention Fence
	18' Compust Filter Sock
	Super Silt Fence
	Limits of Disturbance
	Area of Interest
	Existing Gas Line
	Existing Utility Pole/Line
	Rock Lined Ditch
	Erosion Control Blanket Lined Ditch
	PEM Wetland
	PDW Wetland
	PSS Wetland
	Perennial Stream
	Intermittent Stream
	Ephemeral Stream
	Toe Key
	Erosion Control Blanket Slope Area
	Stone Check Dam

APPROVED
WVDEP OOG
Modification
3/14/2025

MISS UTILITY OF
WEST VIRGINIA
1-800-245-4848
West Virginia State Law
Section XIV, Chapter 24-C requires
that you call two business days
before
you dig in the state of West Virginia.
IT'S THE LAW



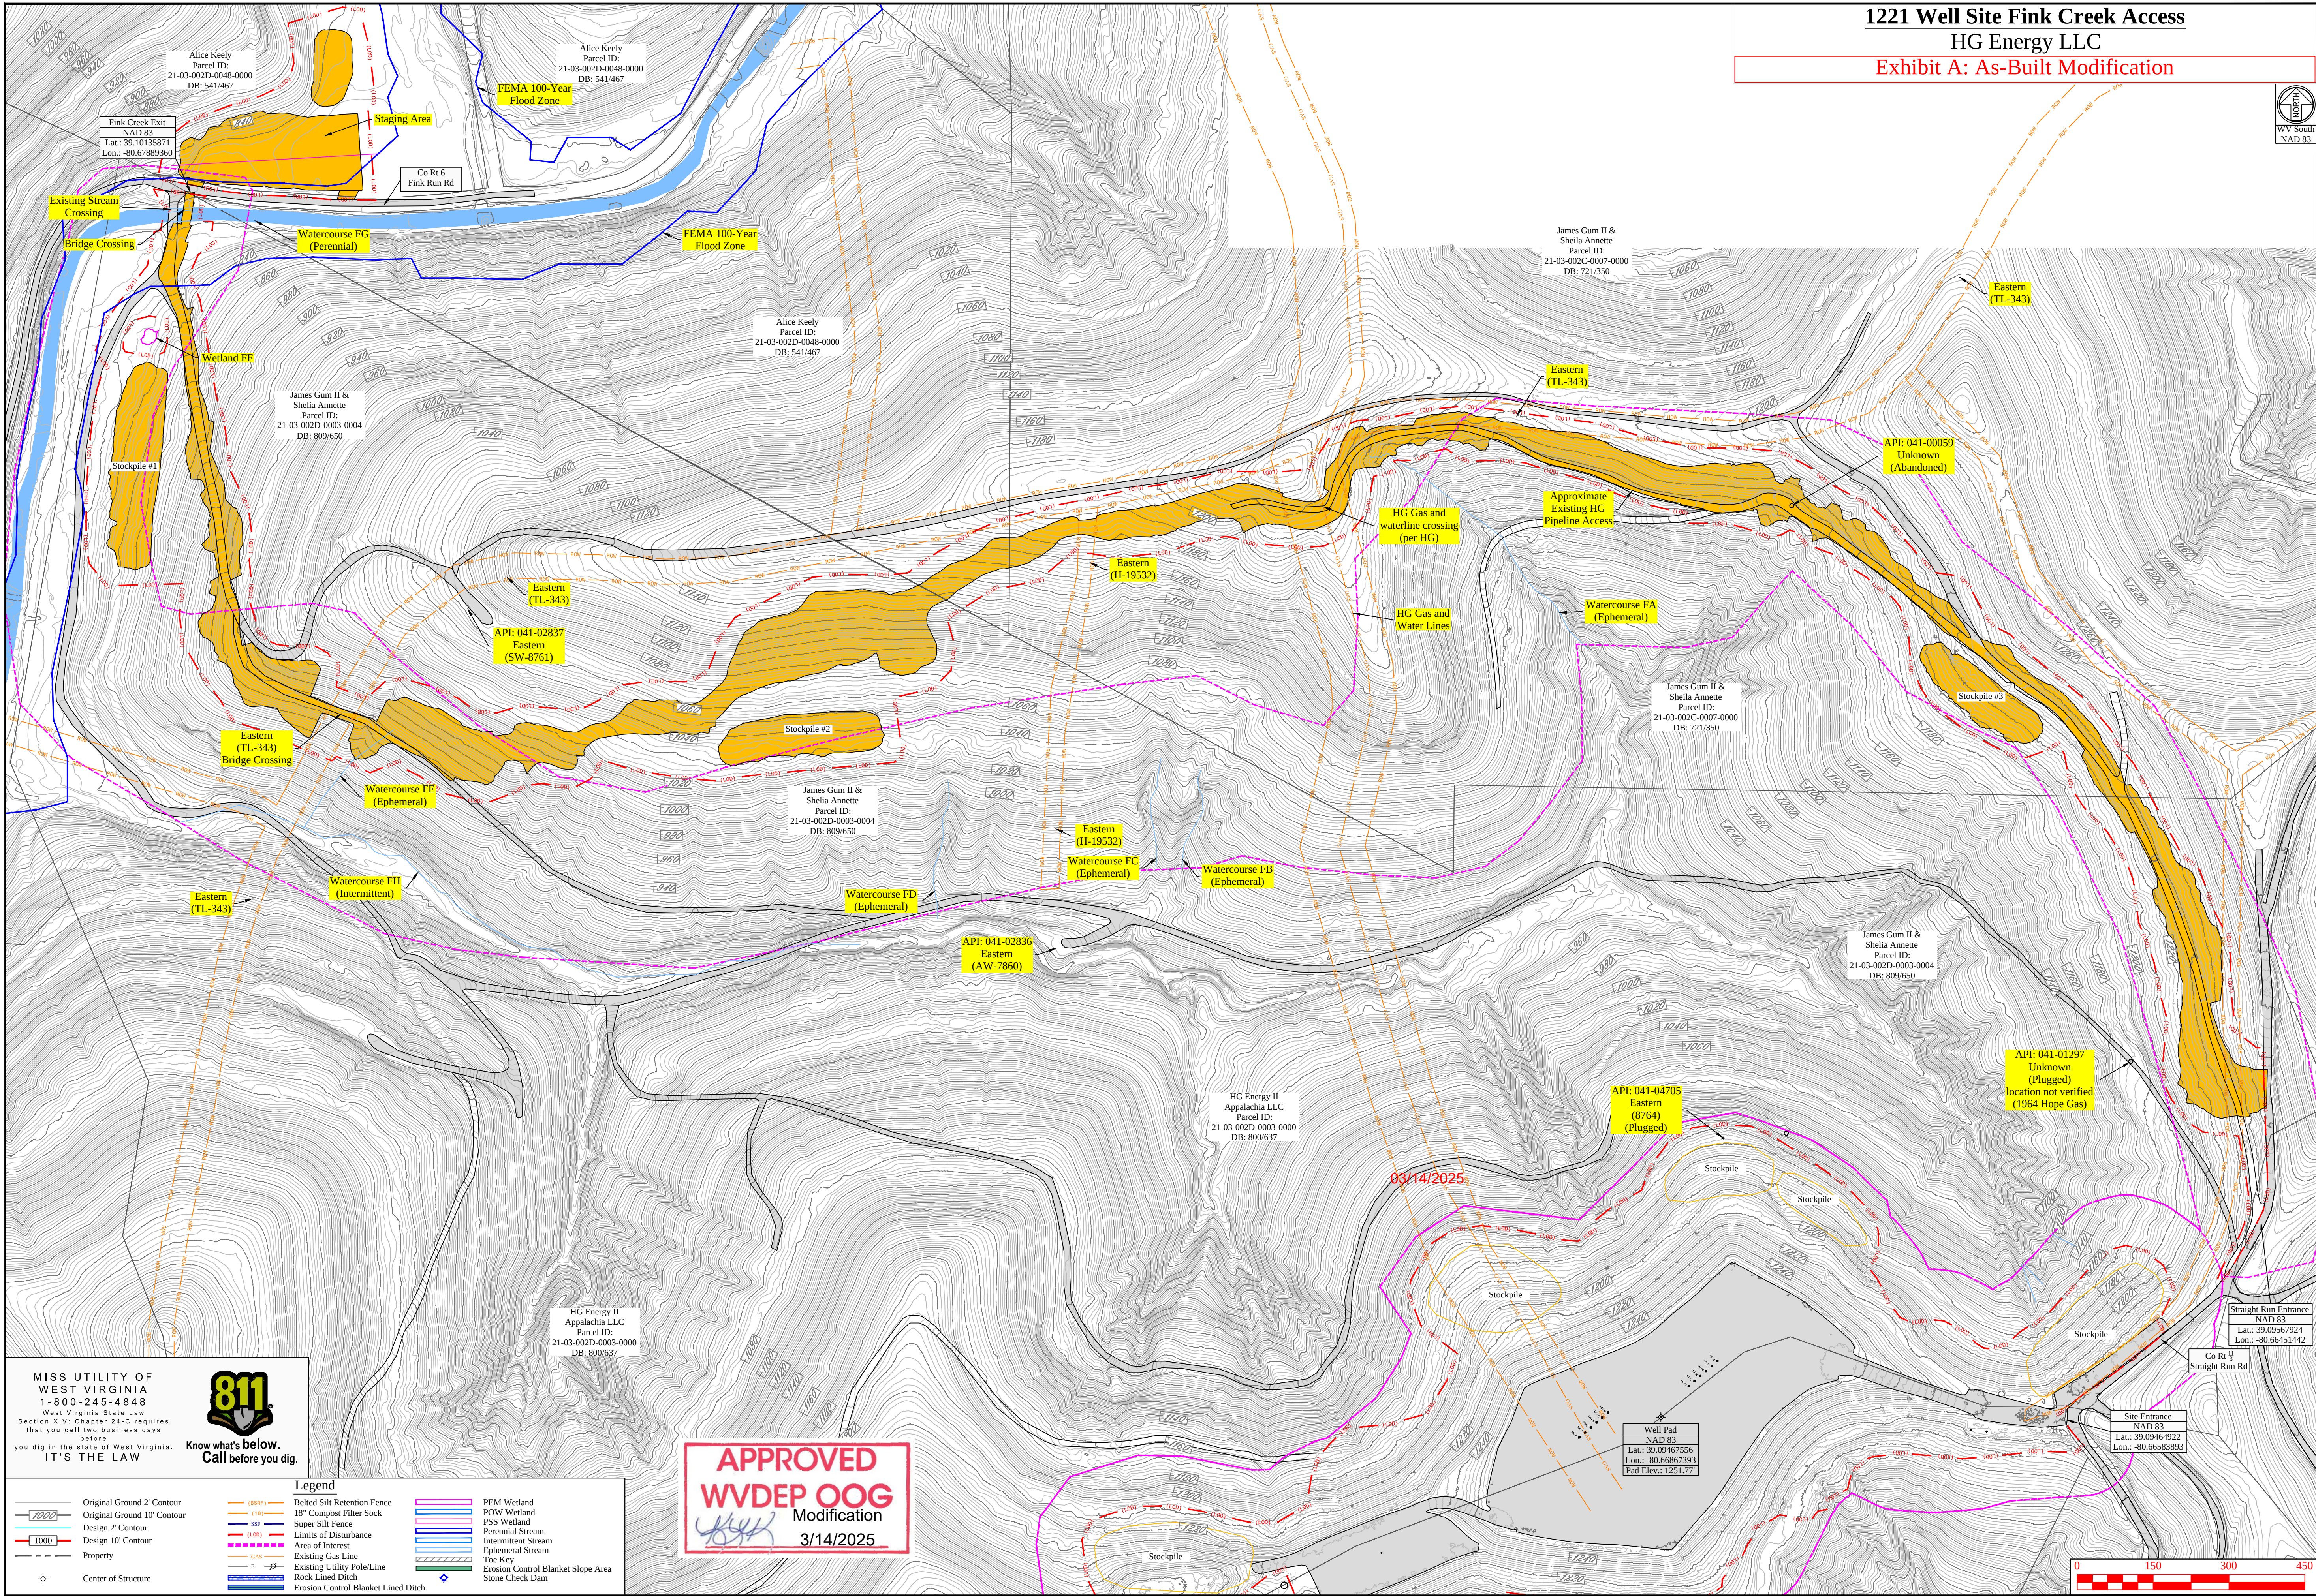

1221 Well Site Fink Creek Access
HG Energy LLC
Exhibit A: As-Built Modification



Revision	Date	Design
	02-04-2025	



THIS DOCUMENT
PREPARED FOR
HG ENERGY LLC



Pre-Construction Site Conditions - Bypass Access Road
1221 Well Site
Freemans Creek District
Lewis County, WV

Date: 02/04/2025
Scale: As Shown
Designed By: ZS
File No.
Sheet 3 of 32

MISS UTILITY OF
WEST VIRGINIA
1-800-245-4848
West Virginia State Law
Section XIV, Chapter 24-C requires
that you call two business days
before
you dig in the state of West Virginia.
IT'S THE LAW



Legend		
Belted Silt Retention Fence		PEM Wetland
18" Compost Filter Sock		POW Wetland
Super Silt Fence		PSS Wetland
Limits of Disturbance		Perennial Stream
Area of Interest		Intermittent Stream
Existing Gas Line		Ephemeral Stream
Existing Utility Pole/Line		Toe Key
Rock Lined Ditch		Erosion Control Blanket Slope Area
Erosion Control Blanket Lined Ditch		Stone Check Dam


APPROVED
WVDEP OOG
Modification
3/14/2025



Exhibit A: As-Built Modification



02-04-2025

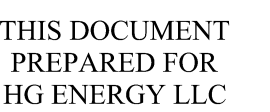

1221 Well Site
Freemans Creek District
Lewis County, WV


Date: 02/04/2025
Scale: As Shown
Designed By: ZS
File No.
Sheet 4 of 32



Exhibit A: As-Built Modification



2-04-2025

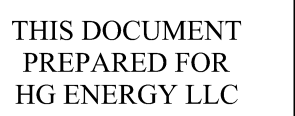


Freemans Creek District
Lewis County, WV

Date: 02/04/2025
Scale: As Shown
Designed By: ZS
File No.
Sheet 5 of 32




Exhibit A: As-Built Modification

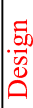

02-04-2025



Date: 02/04/2023
Scale: As Shown
Designed By: ZS
File No.
Sheet 6 of 32

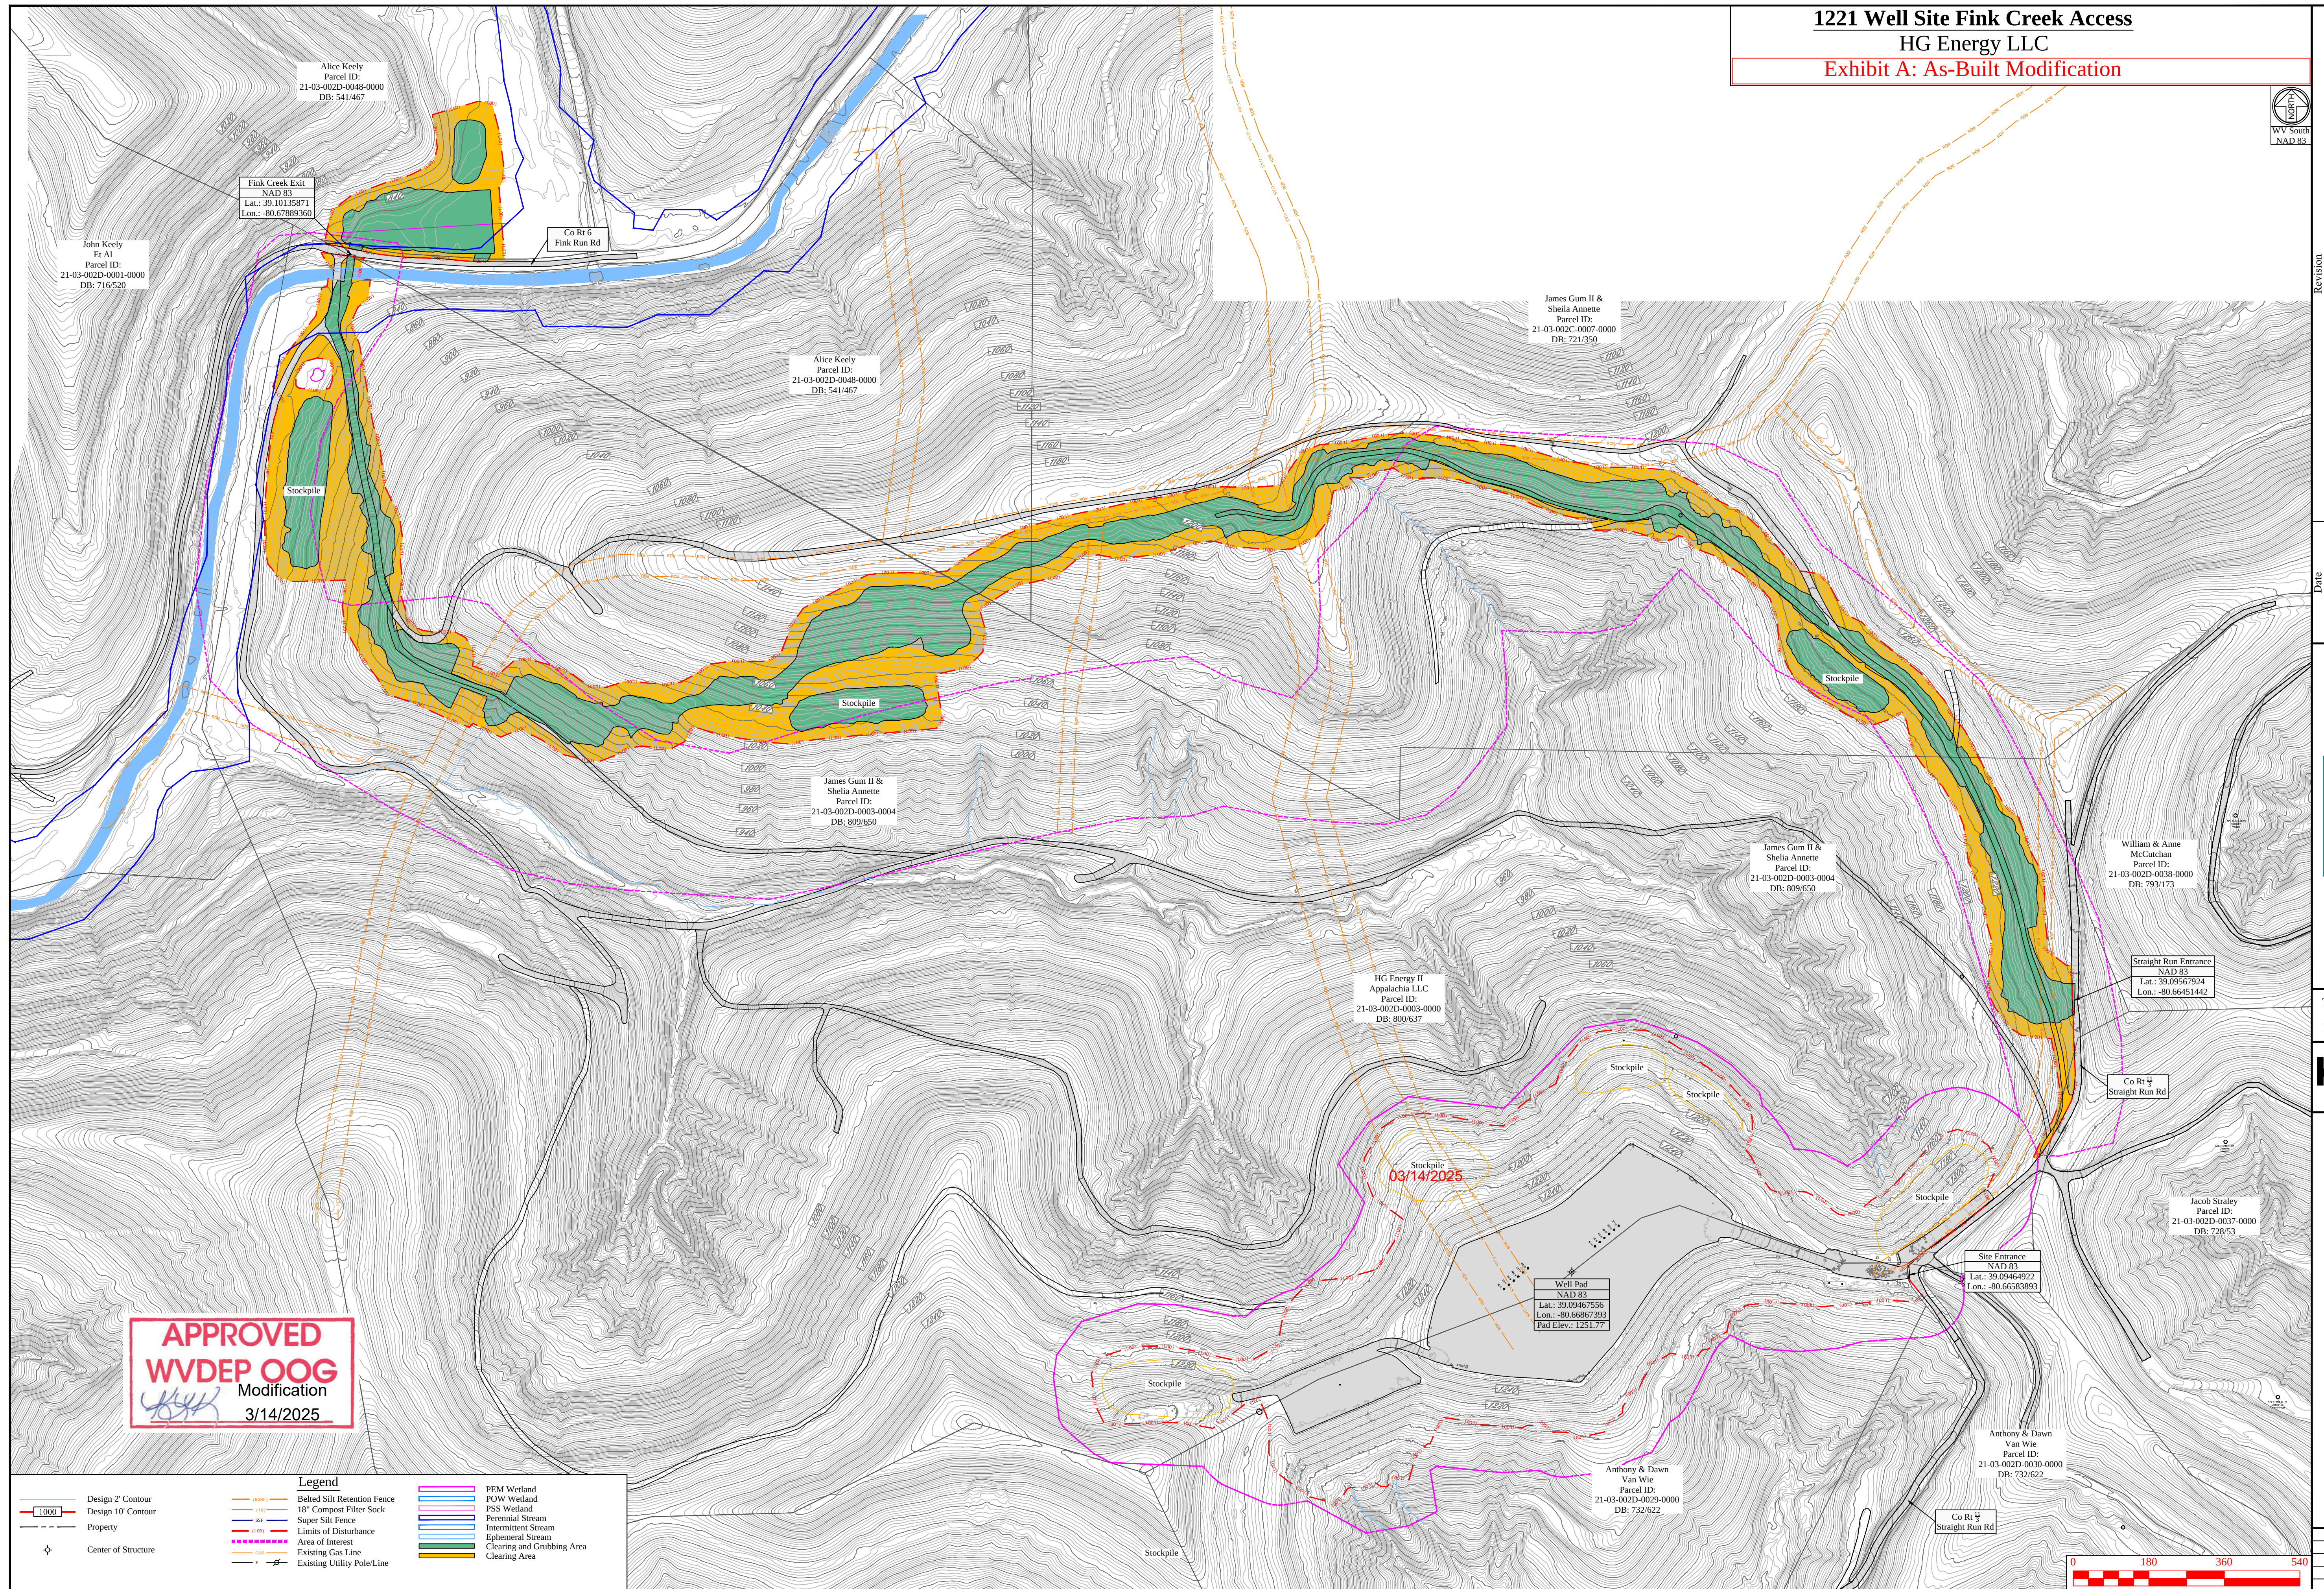

HG Energy LLC

WV South

ISP LLC
Parcel ID:
21-03-000-000

Anthony & Dawn
Van Wie
Parcel ID:
1-03-002D-0030-0000
DB: 732/622

Anthony & Dawn
Van Wie
Parcel ID:
21-03-002D-0029-0000
DB: 732/622

APPROVED
WVDEP OOG
Modification
3/14/2025

3/14/2025

Kelly Surveying
P.O. Box 254
Daley, WV 26259
(304)338-6985

Overall Site File
1221 Well Site
Freemans Creek District
Lewis County, WV

Date: 02/04/2025
Scale: As Shown
Designed By: ZS
File No.
Sheet 7 of 32

The contractor shall not deviate from the above listed construction sequence without the written consent of the design engineer. The contractor must provide a written explanation and provide an updated construction sequence when requesting permission to deviate from the construction sequence.

- Belted Silt Retention Fence
- 18" Compost Filter Sock
- Super Silt Fence
- Limits of Disturbance
- Area of Interest
- Existing Gas Line
- Existing Utility Pole/Line
- Rock Lined Ditch
- Erosion Control Blanket Lin

 PEM Wetland
 POW Wetland
 PSS Wetland
 Perennial Stream
 Intermittent Stream
 Ephermal Stream
 Toe Key
 Erosion Control Blanket
 Stone Check Dam
 Ditch

Exhibit A: As-Built Modification



02-04-2025


THIS DOCUMENT
PREPARED FOR
HG ENERGY LLC




1221 Well Site

Freemans Creek District
Lewis County, WV

Date: 02/04/2025
Scale: As Shown
Designed By: ZS
File No.
Sheet 8 of 32

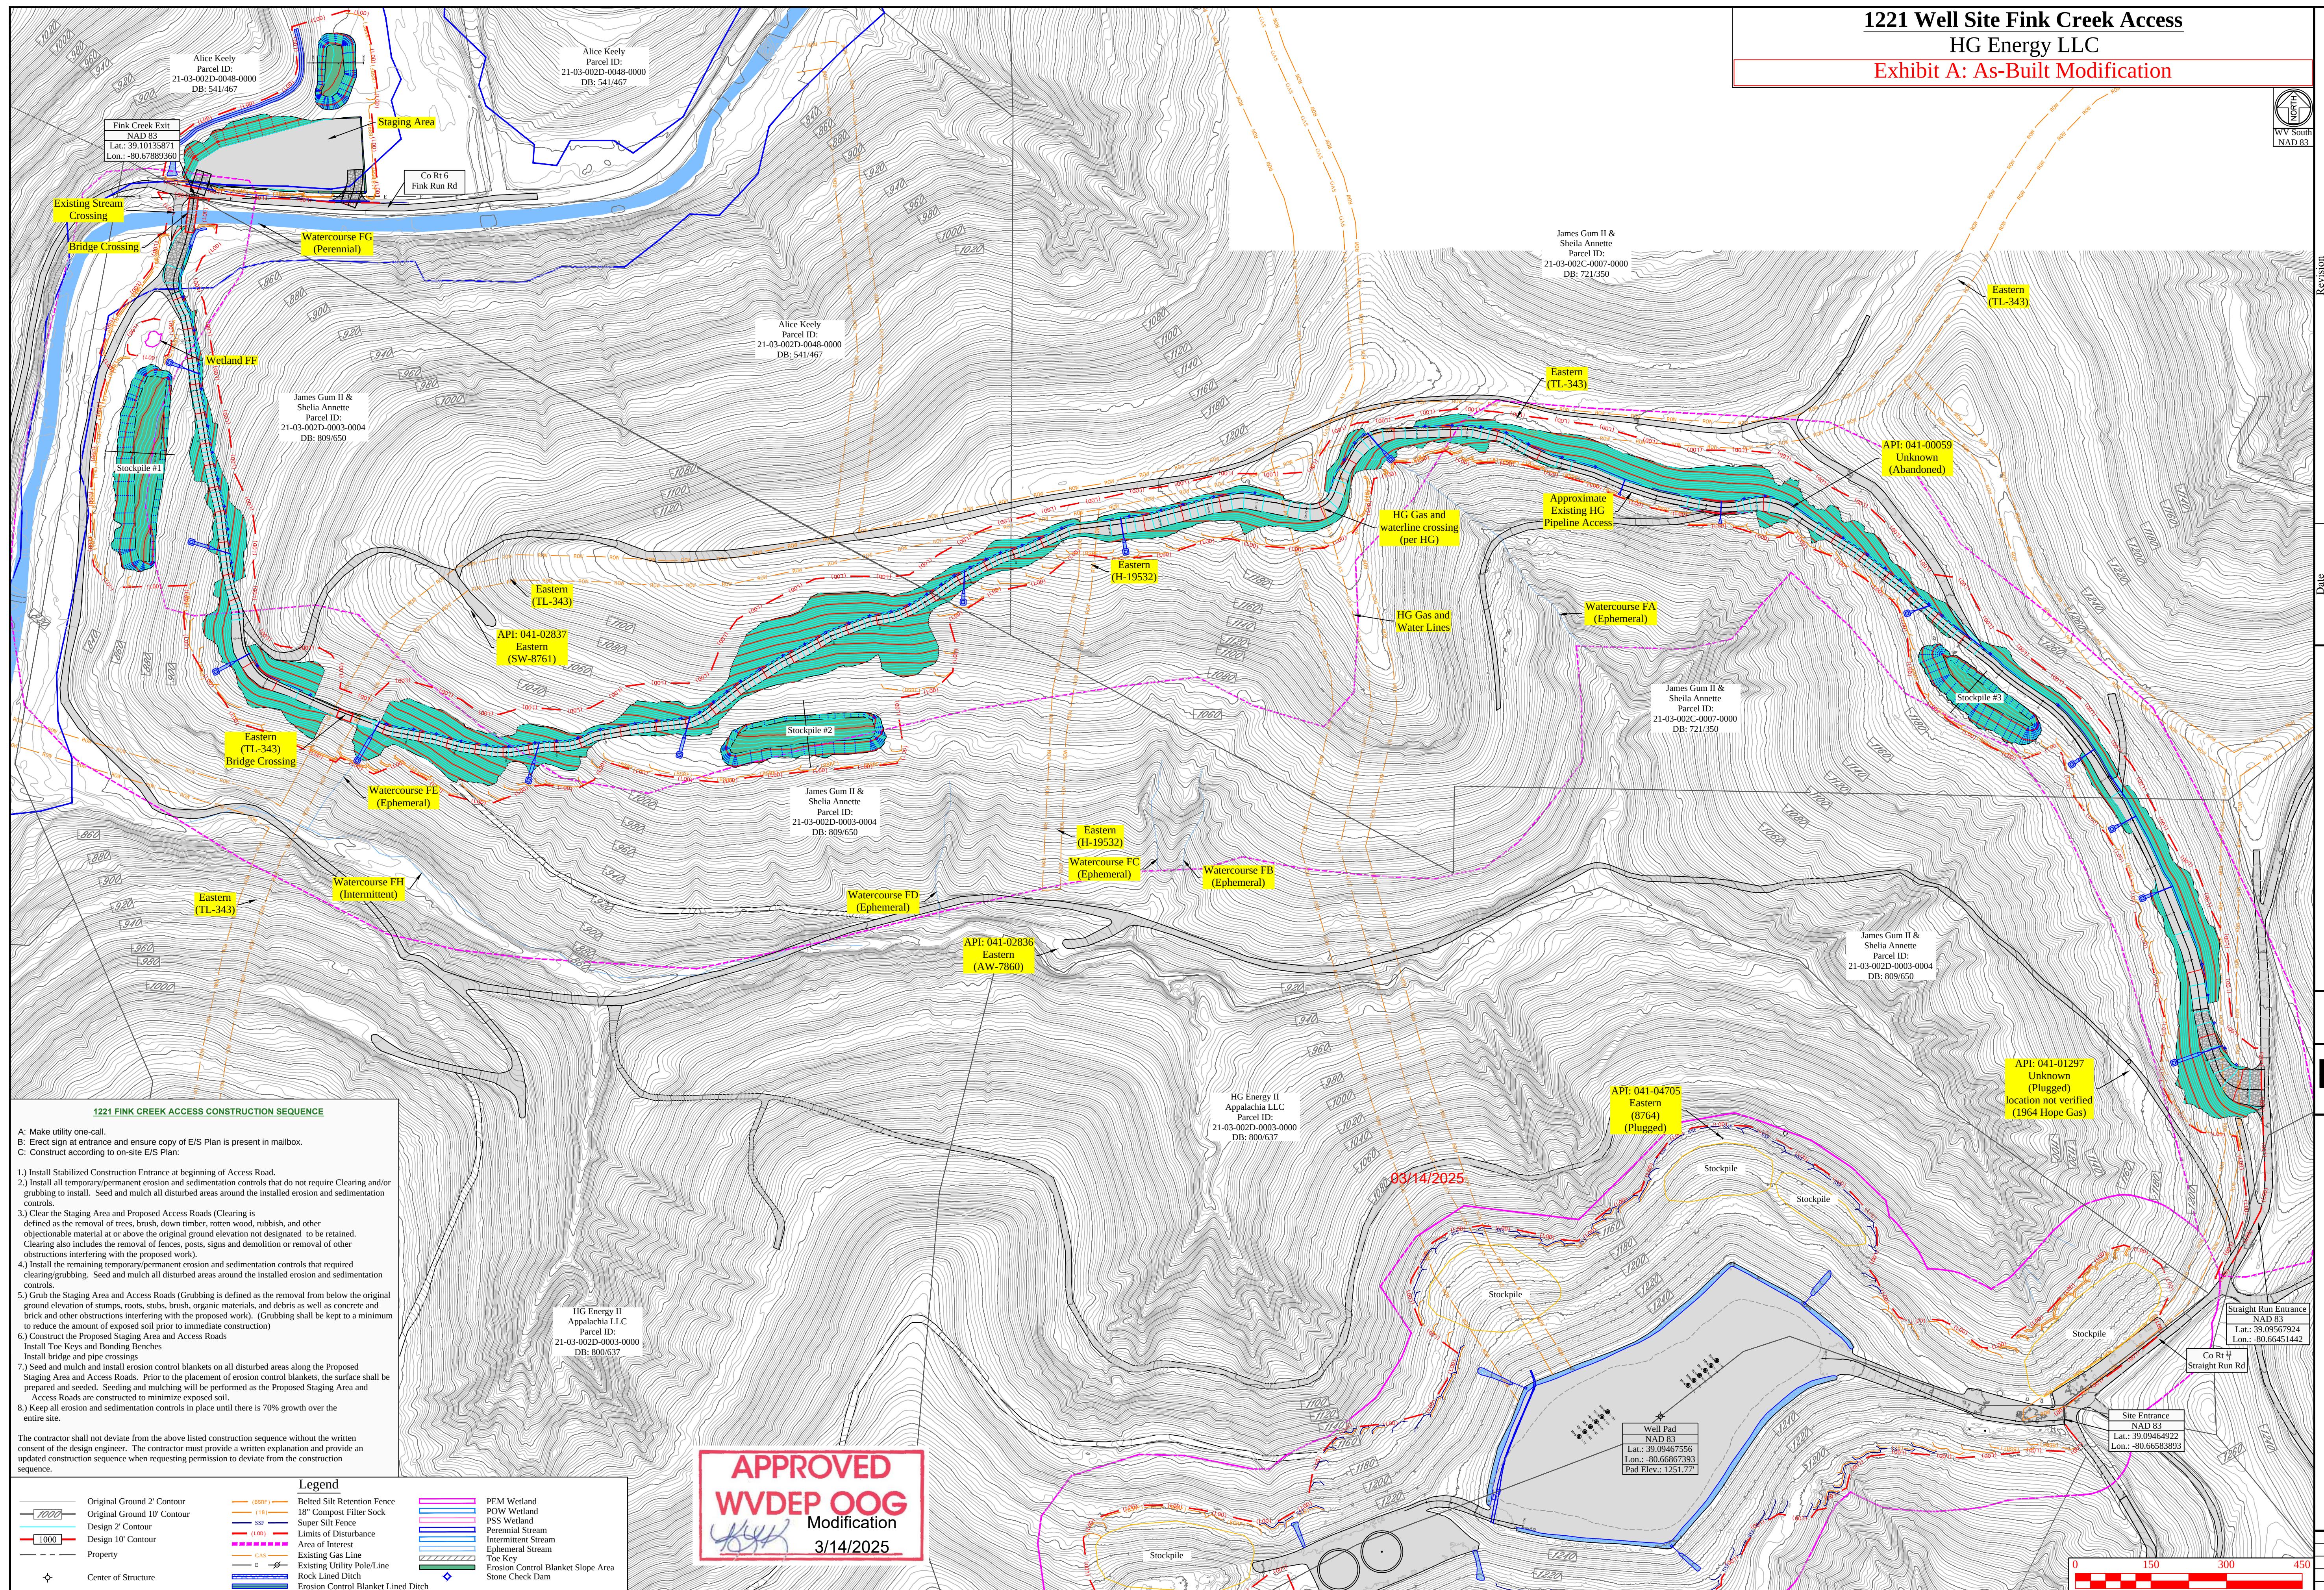

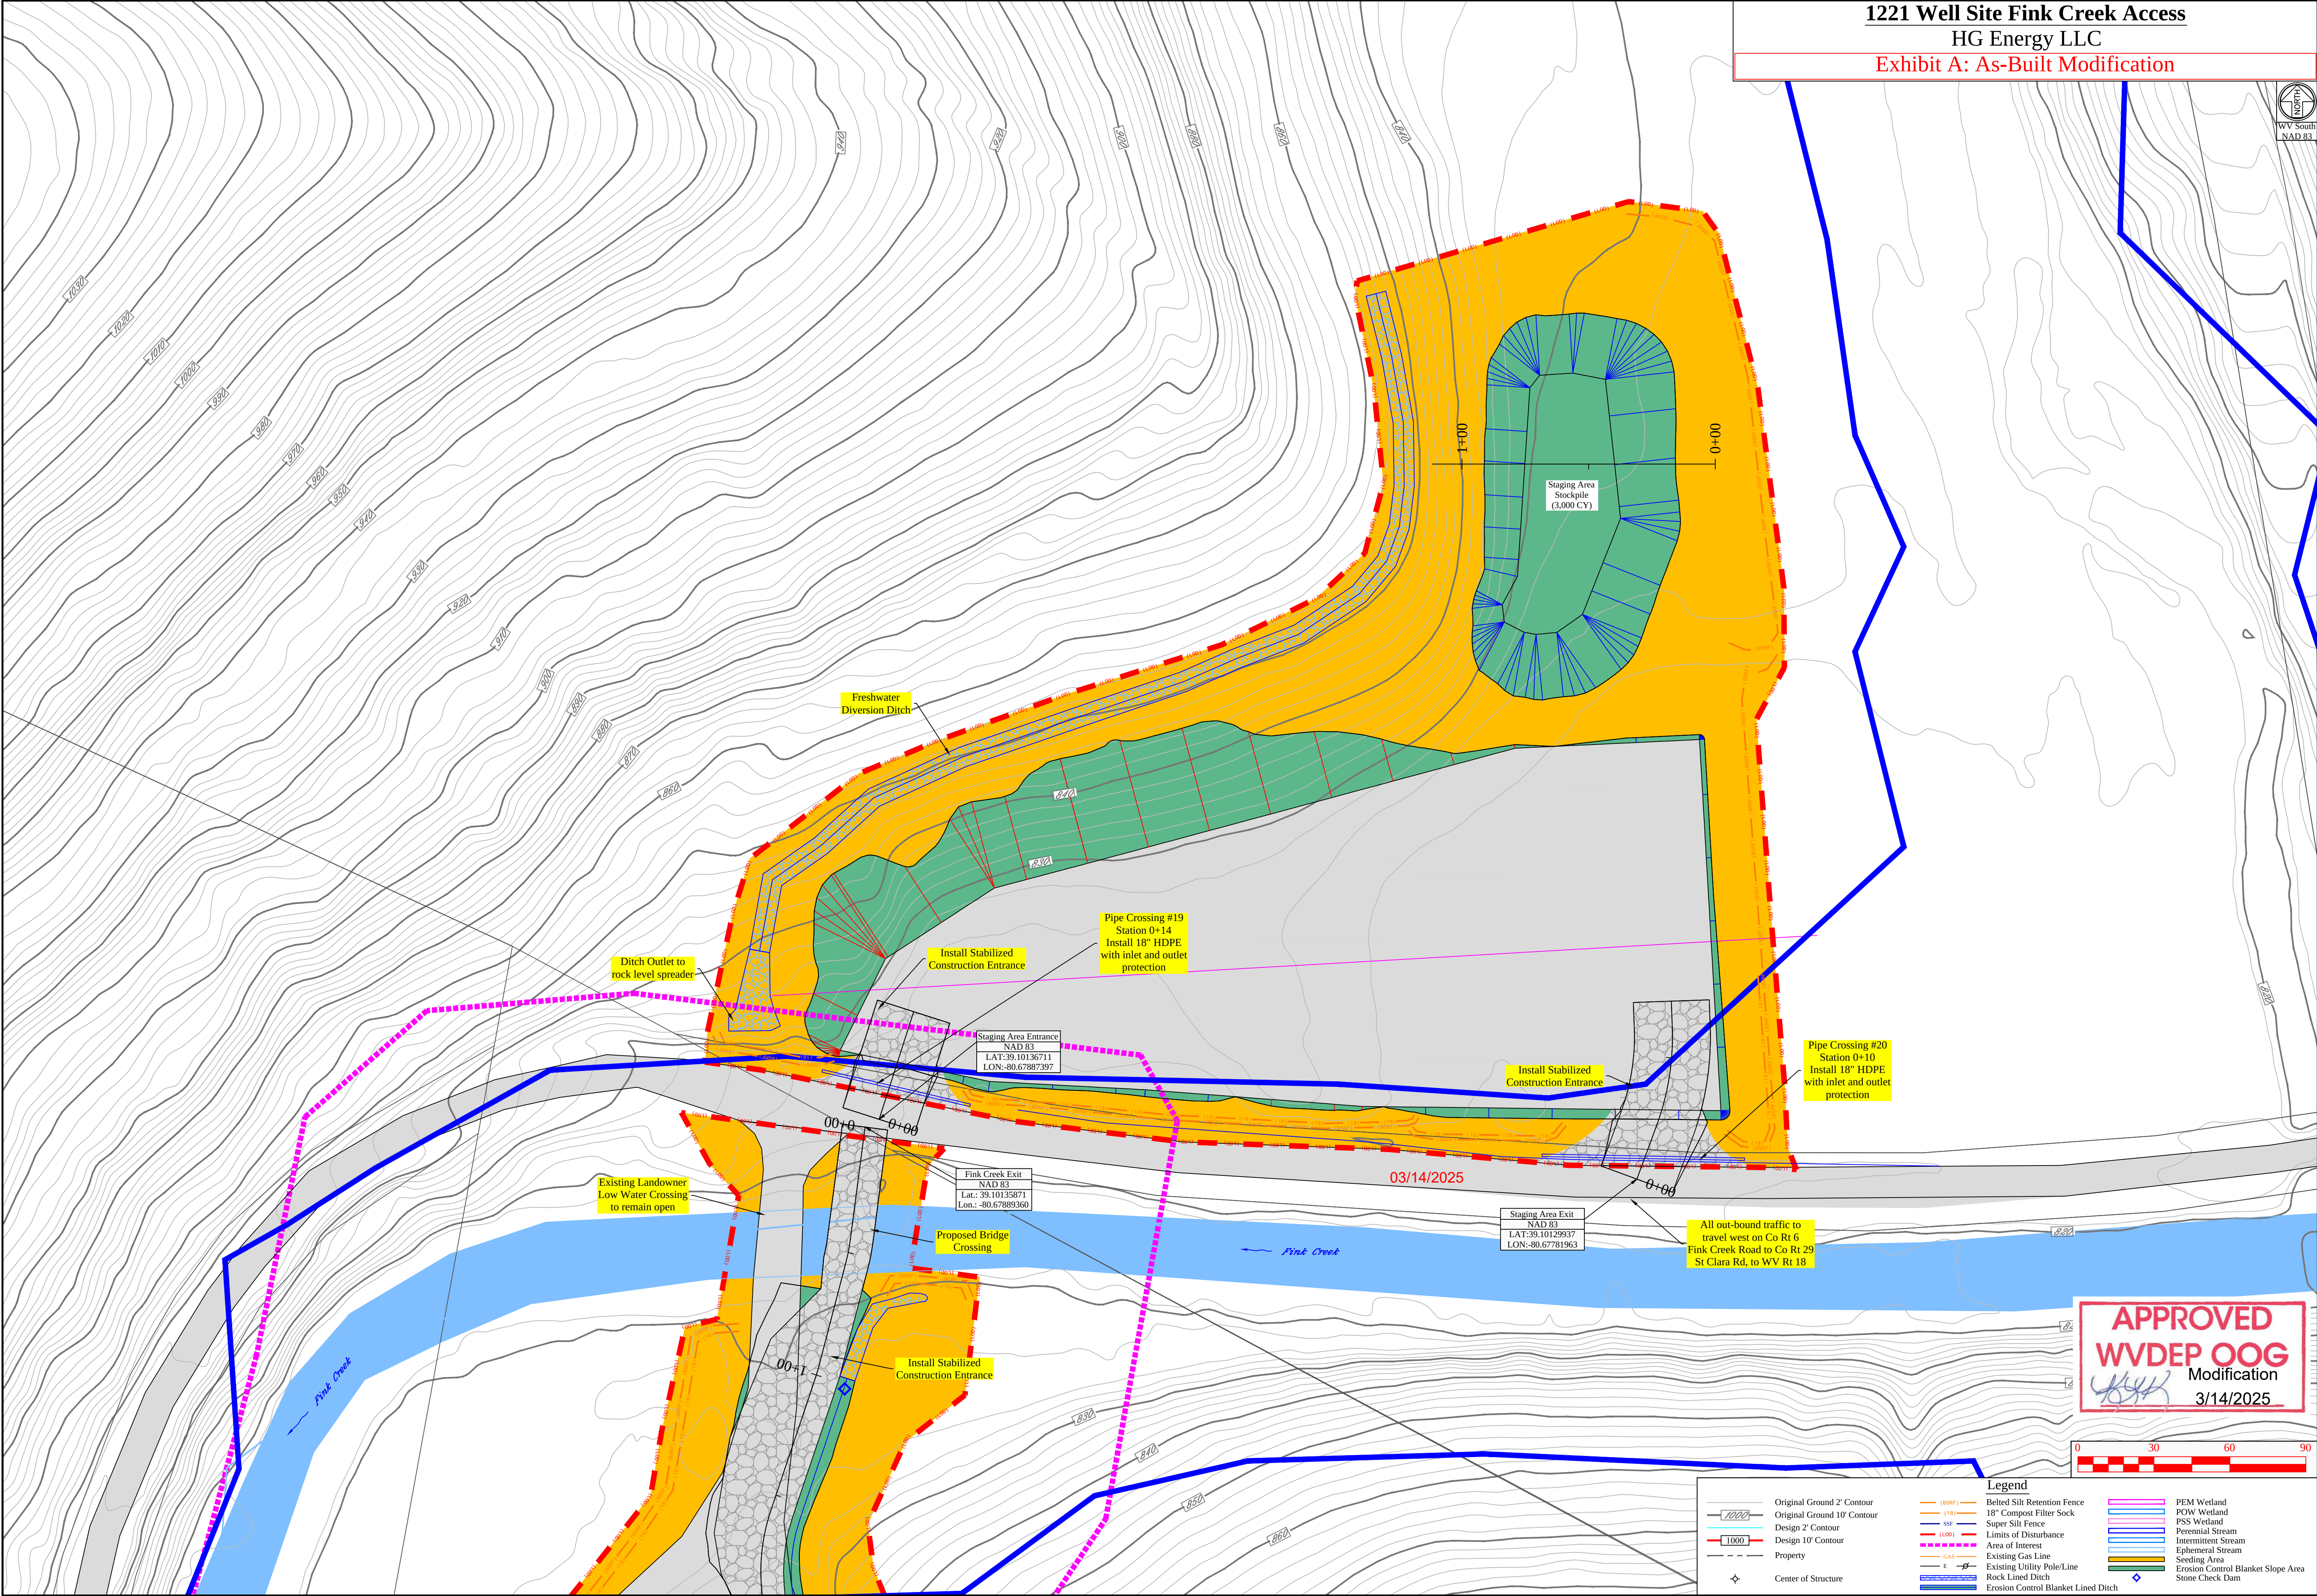

1221 Well Site Fink Creek Access
HG Energy LLC
Exhibit A: As-Built Modification



Revision	Date
Design	02-04-2025



THIS DOCUMENT
PREPARED FOR
HG ENERGY LLC





Erosion and Sediment Control Plan
1221 Fink Creek Access
Freemans Creek District
Lewis County, WV

Date: 02/04/2025
Scale: As Shown
Designed By: ZS
File No.
Sheet 9 of 32

APPROVED
WVDEP OOG
Modification
3/14/2025



Legend		

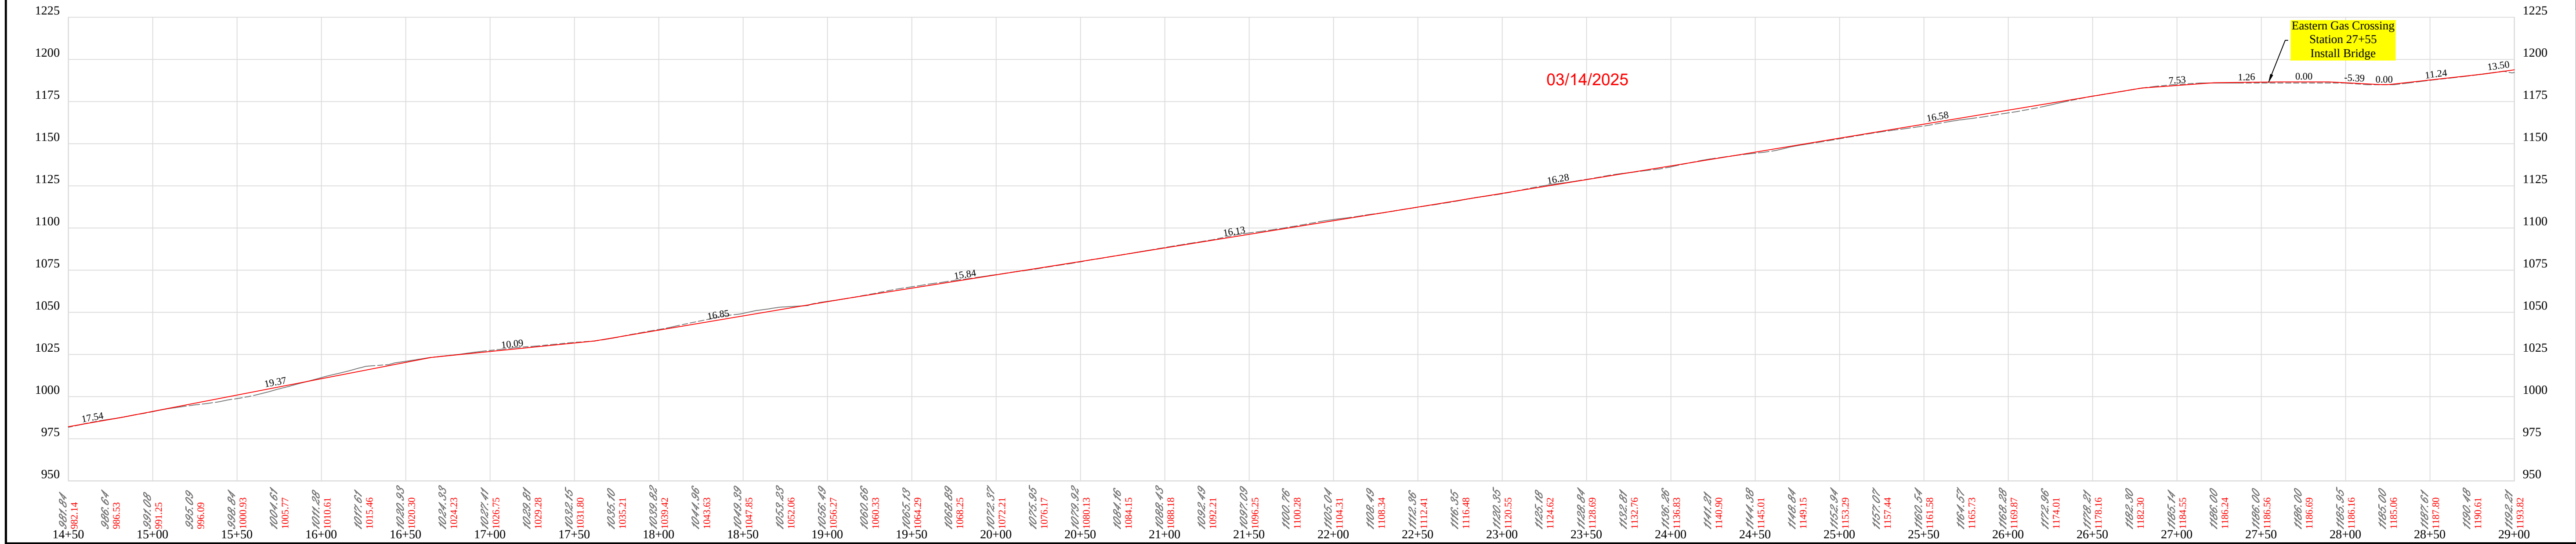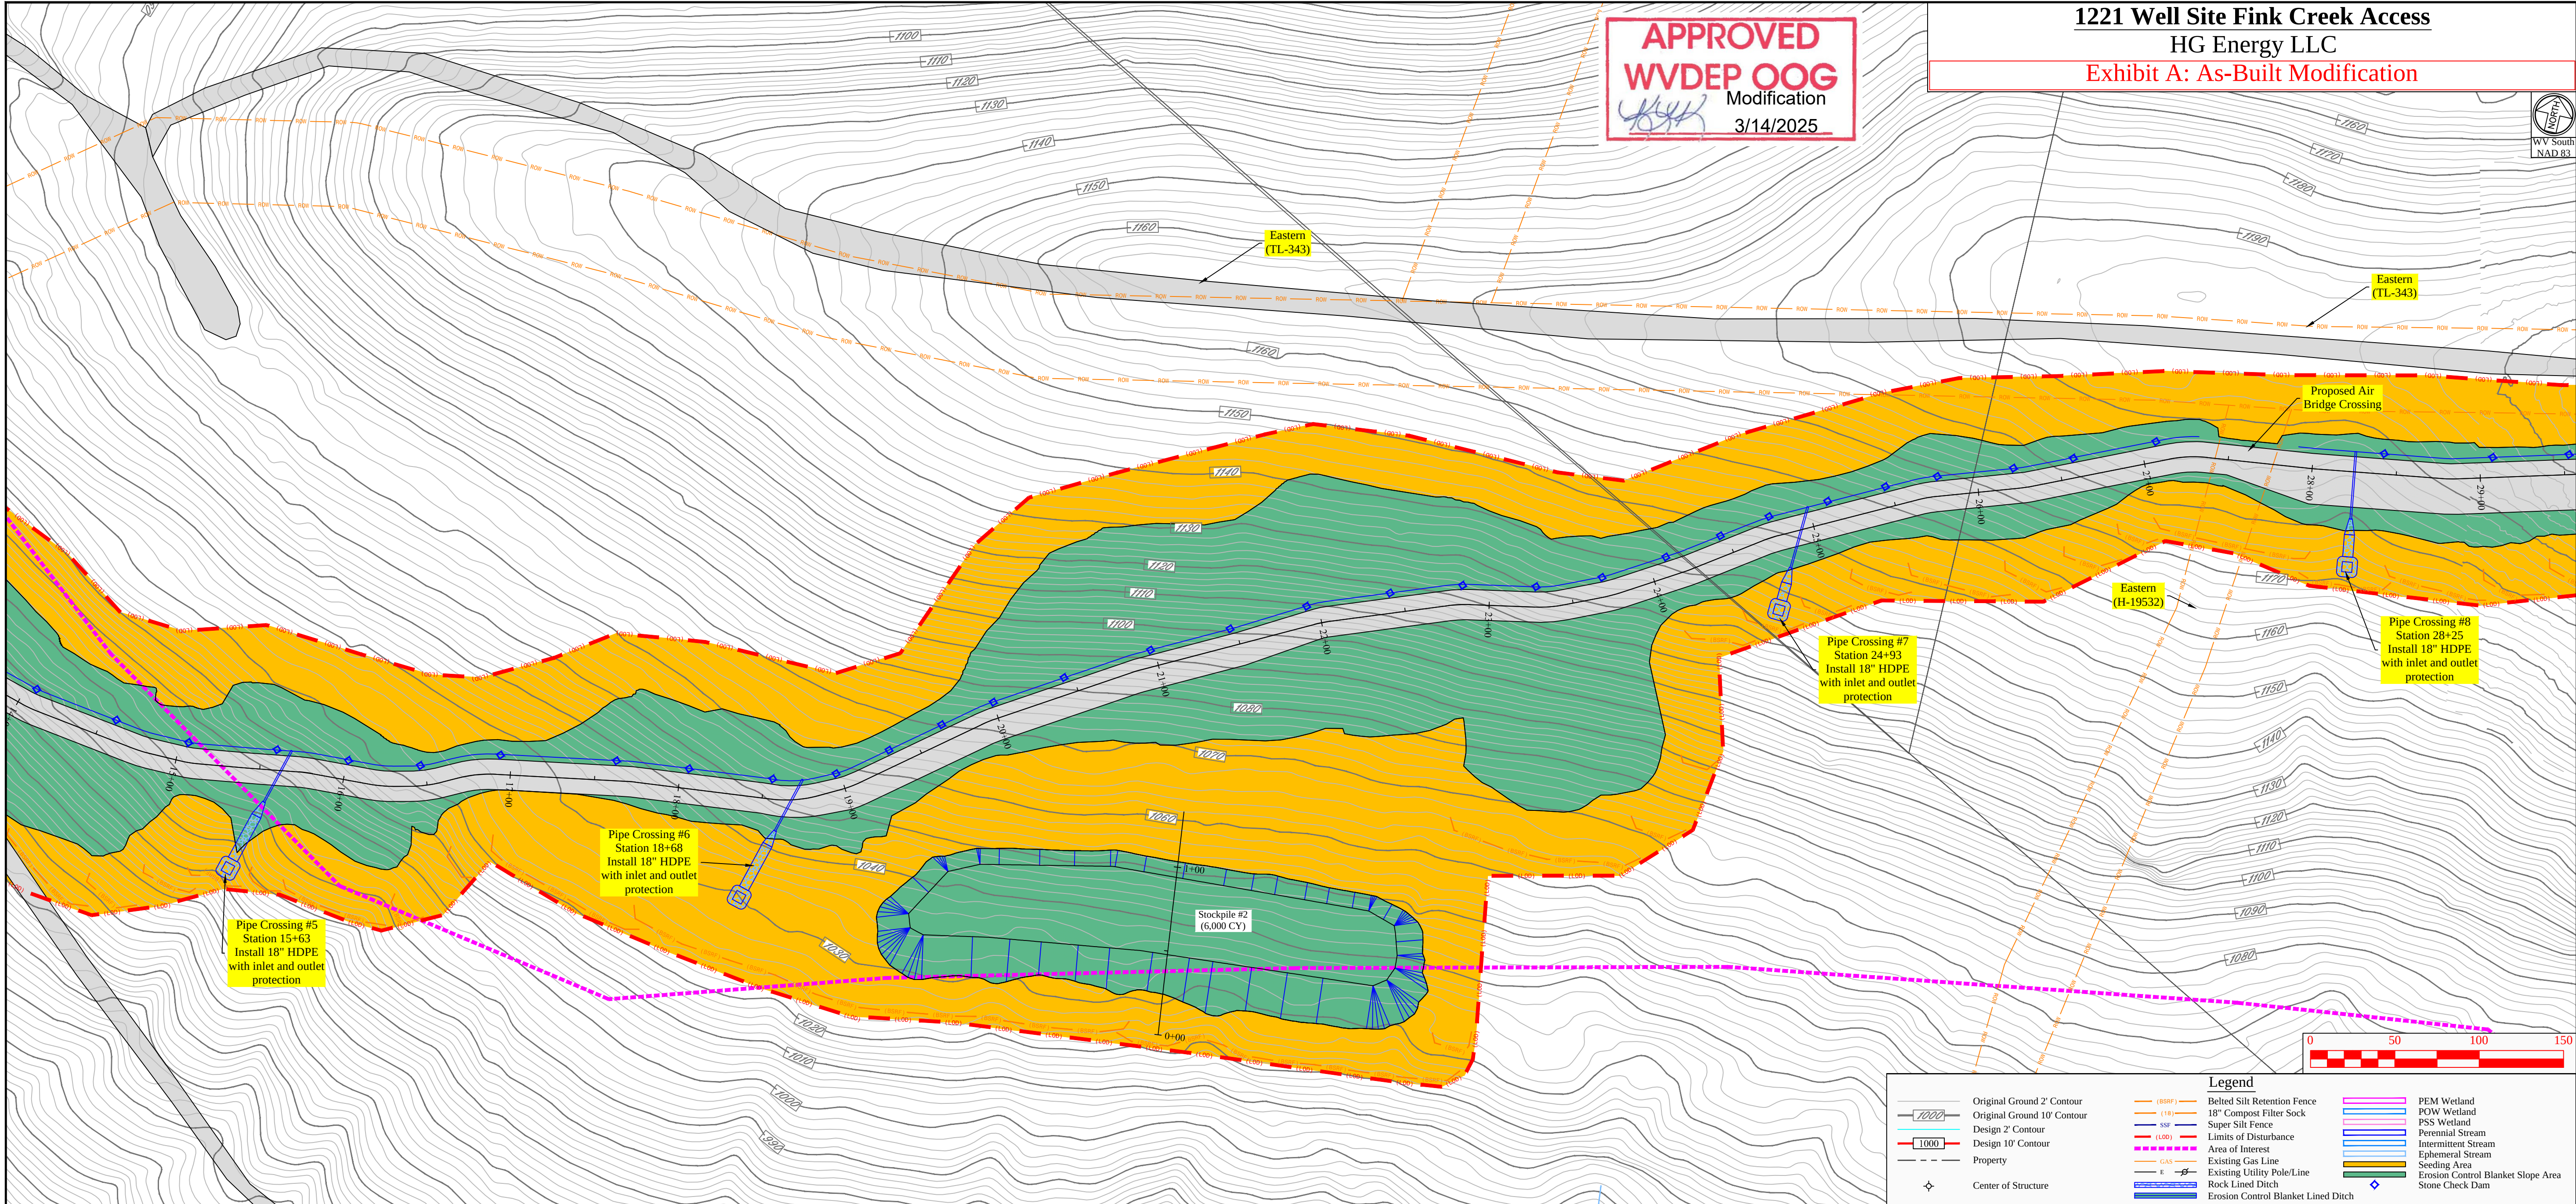

Revision	Date	Design
02-04-2025		



HG ENERGY LLC

THIS DOCUMENT PREPARED FOR HG ENERGY LLC

Kelly Surveying
P.O. Box 254
Delmar, WV 26299
304-338-0985

Erosion and Sediment Control Plan
1221 Fink Creek Access
Freemans Creek District
Lewis County, WV

Date: 02/04/2025
Scale: As Shown
Designed By: ZS
File No.
Sheet 11 of 32

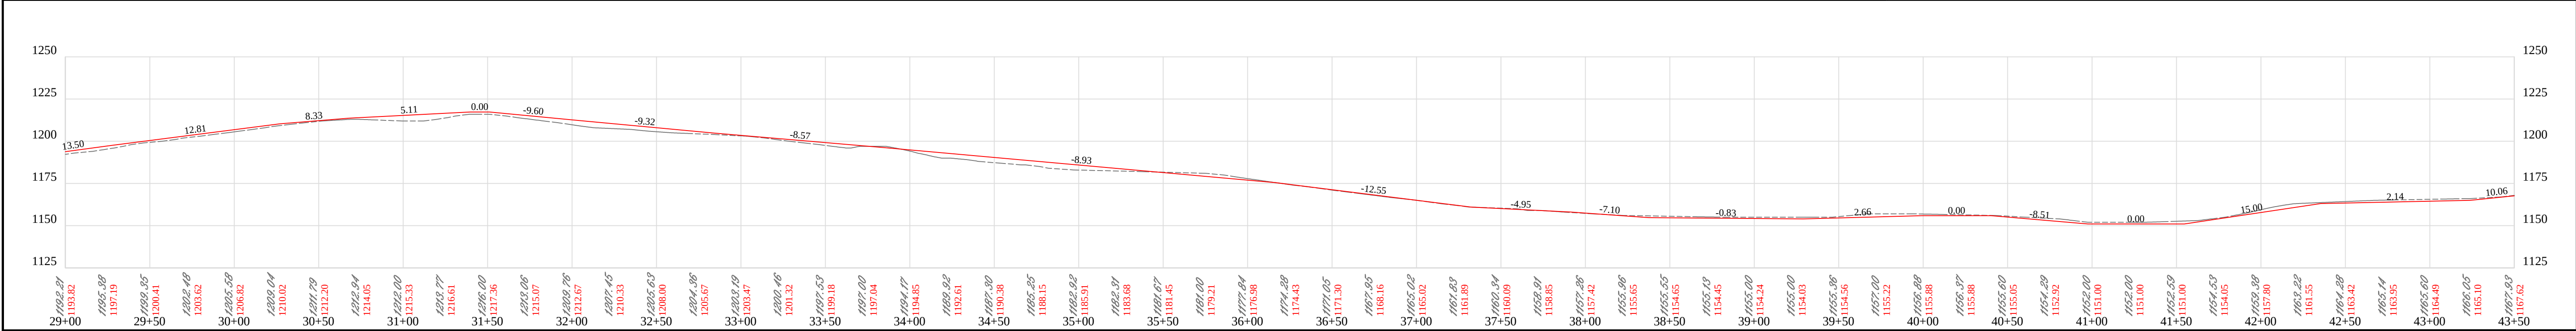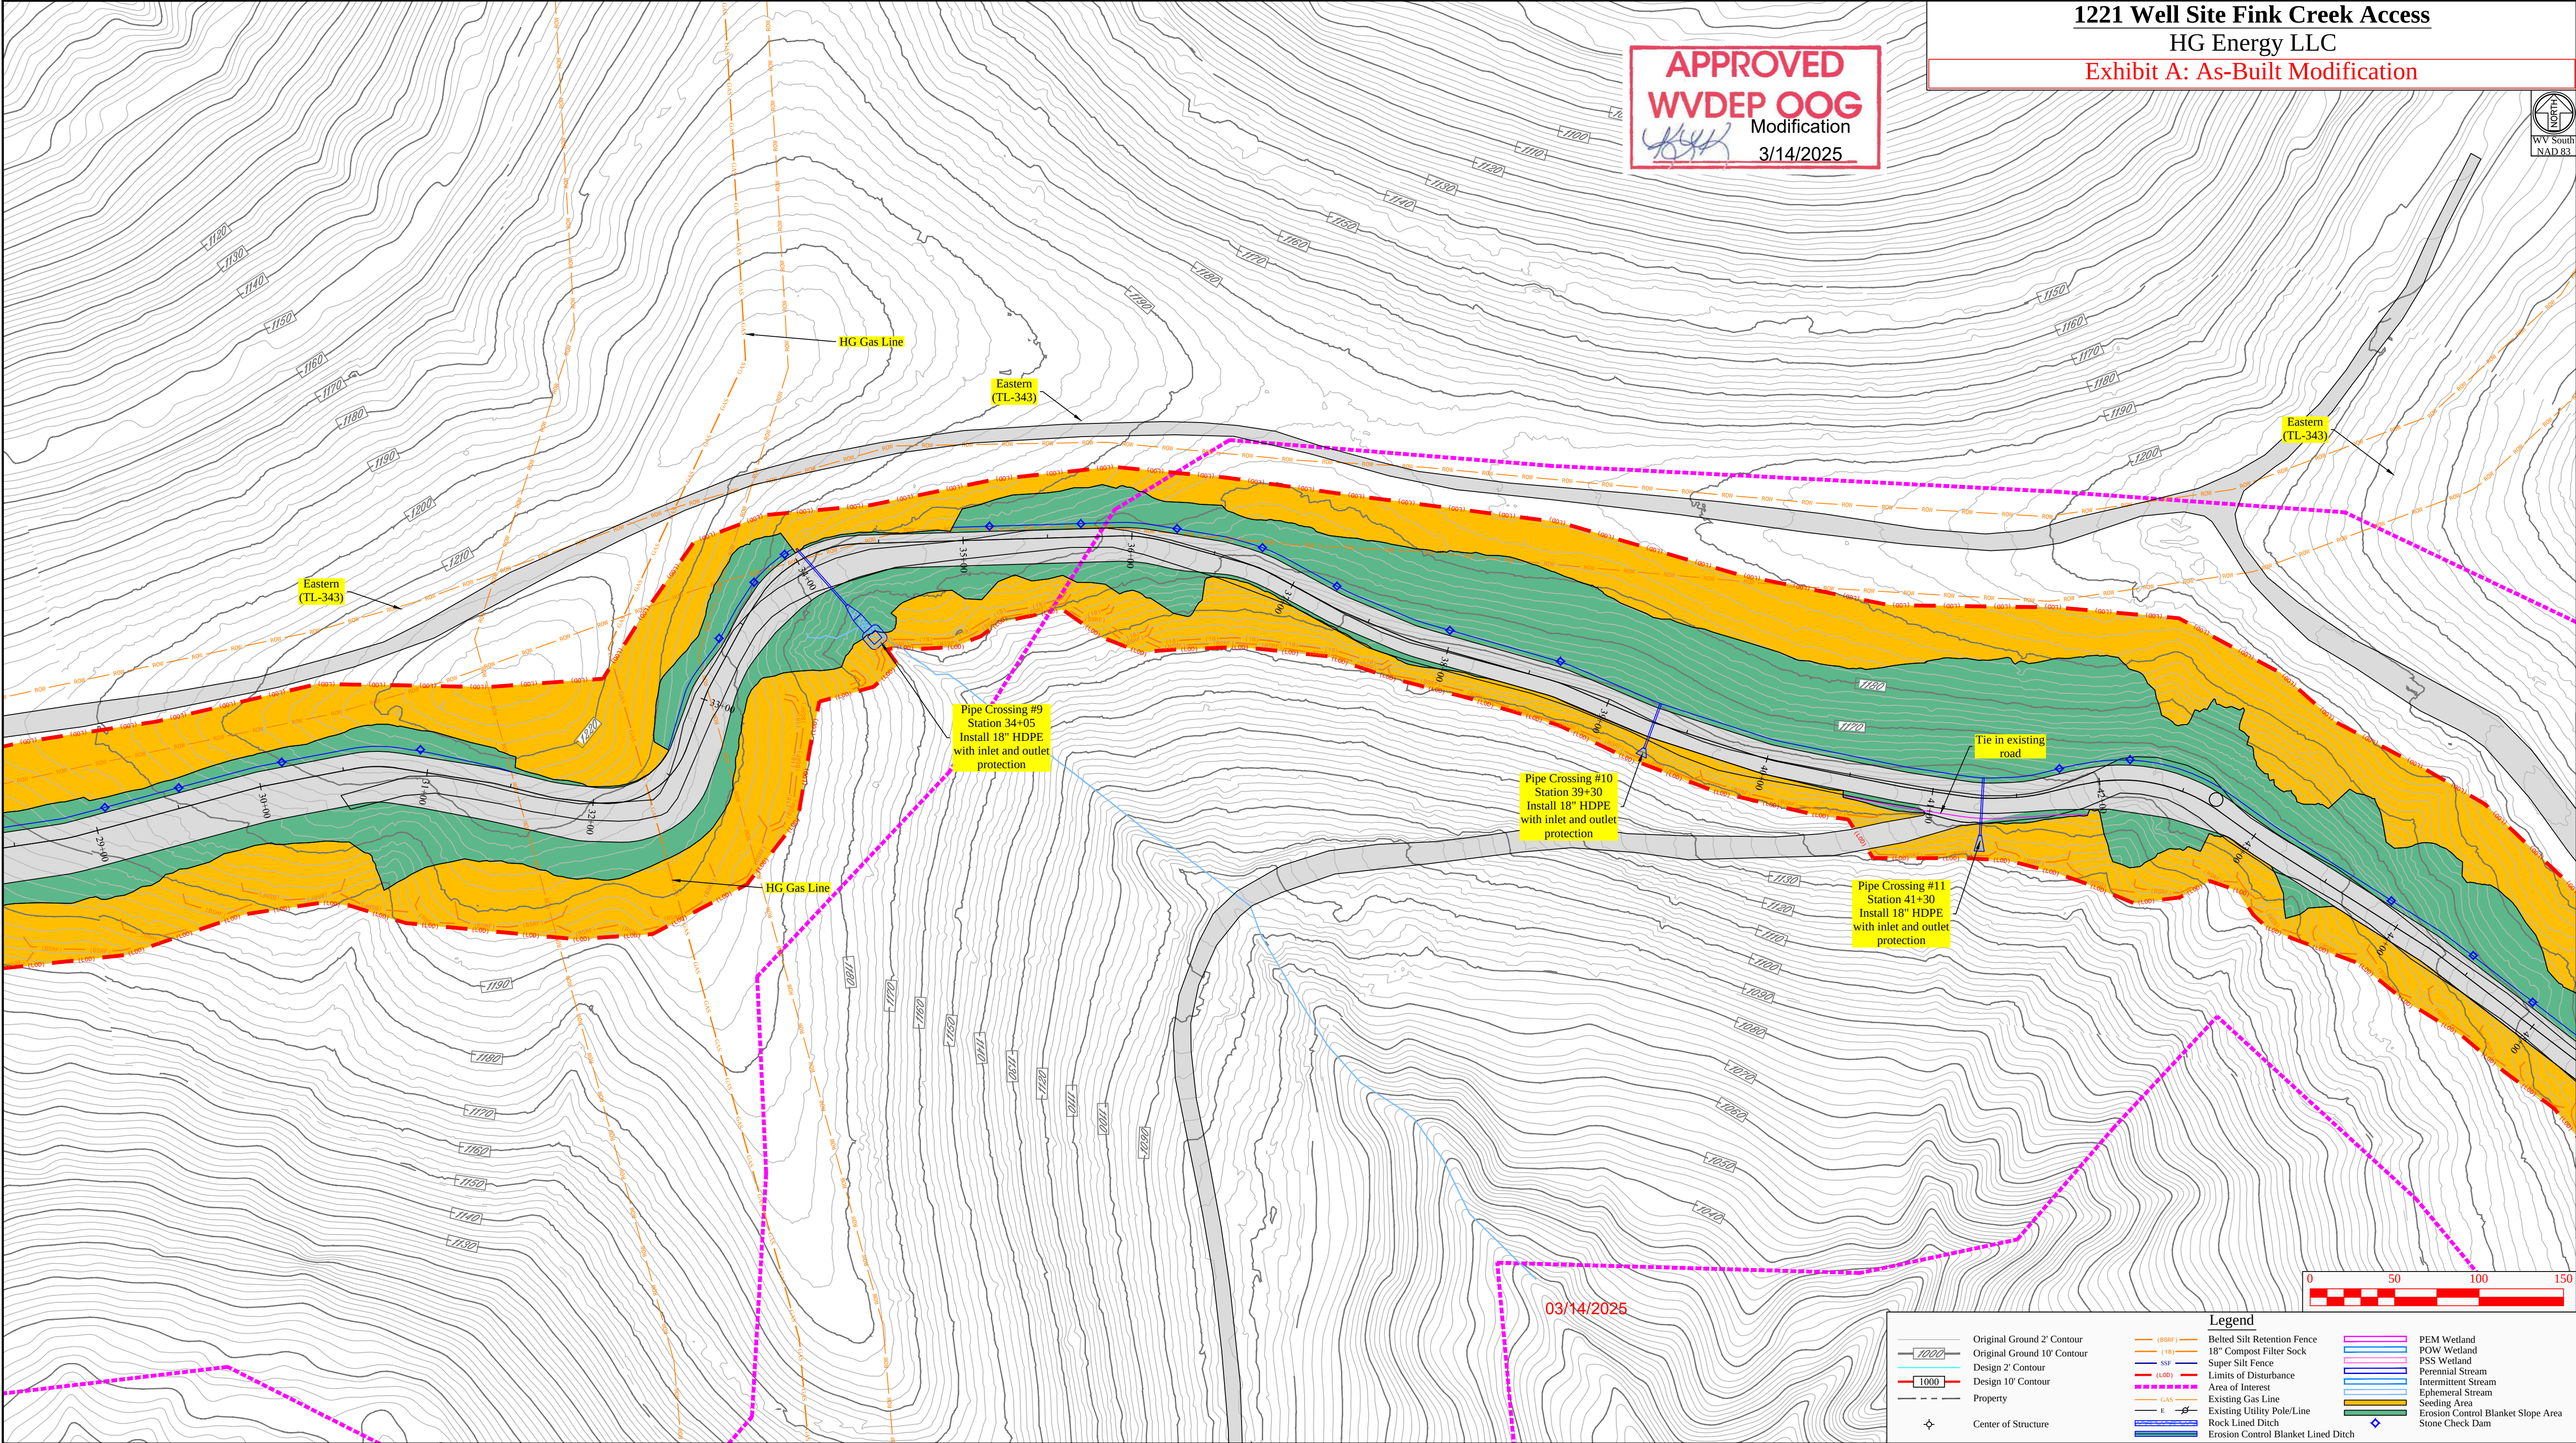

1221 Well Site Fink Creek Access
HG Energy LLC
Exhibit A: As-Built Modification

APPROVED
WVDEP OOG
Modification
3/14/2025





Revision	Date
Design	02-04-2025



THIS DOCUMENT
PREPARED FOR
HG ENERGY LLC



Erosion and Sediment Control Plan
1221 Fink Creek Access
Freemans Creek District
Lewis County, WV

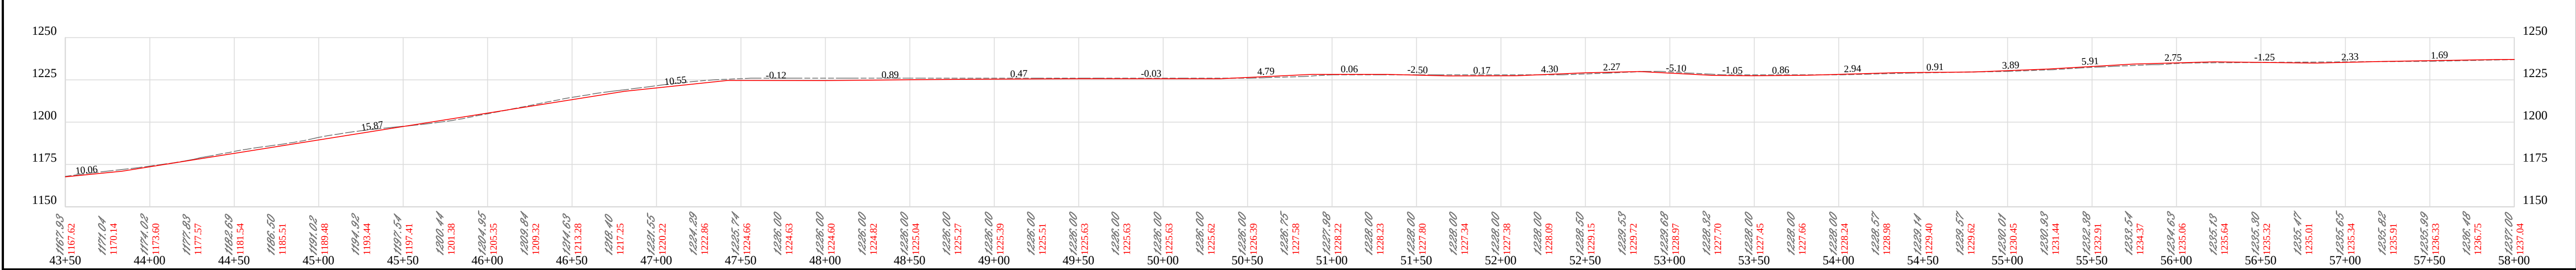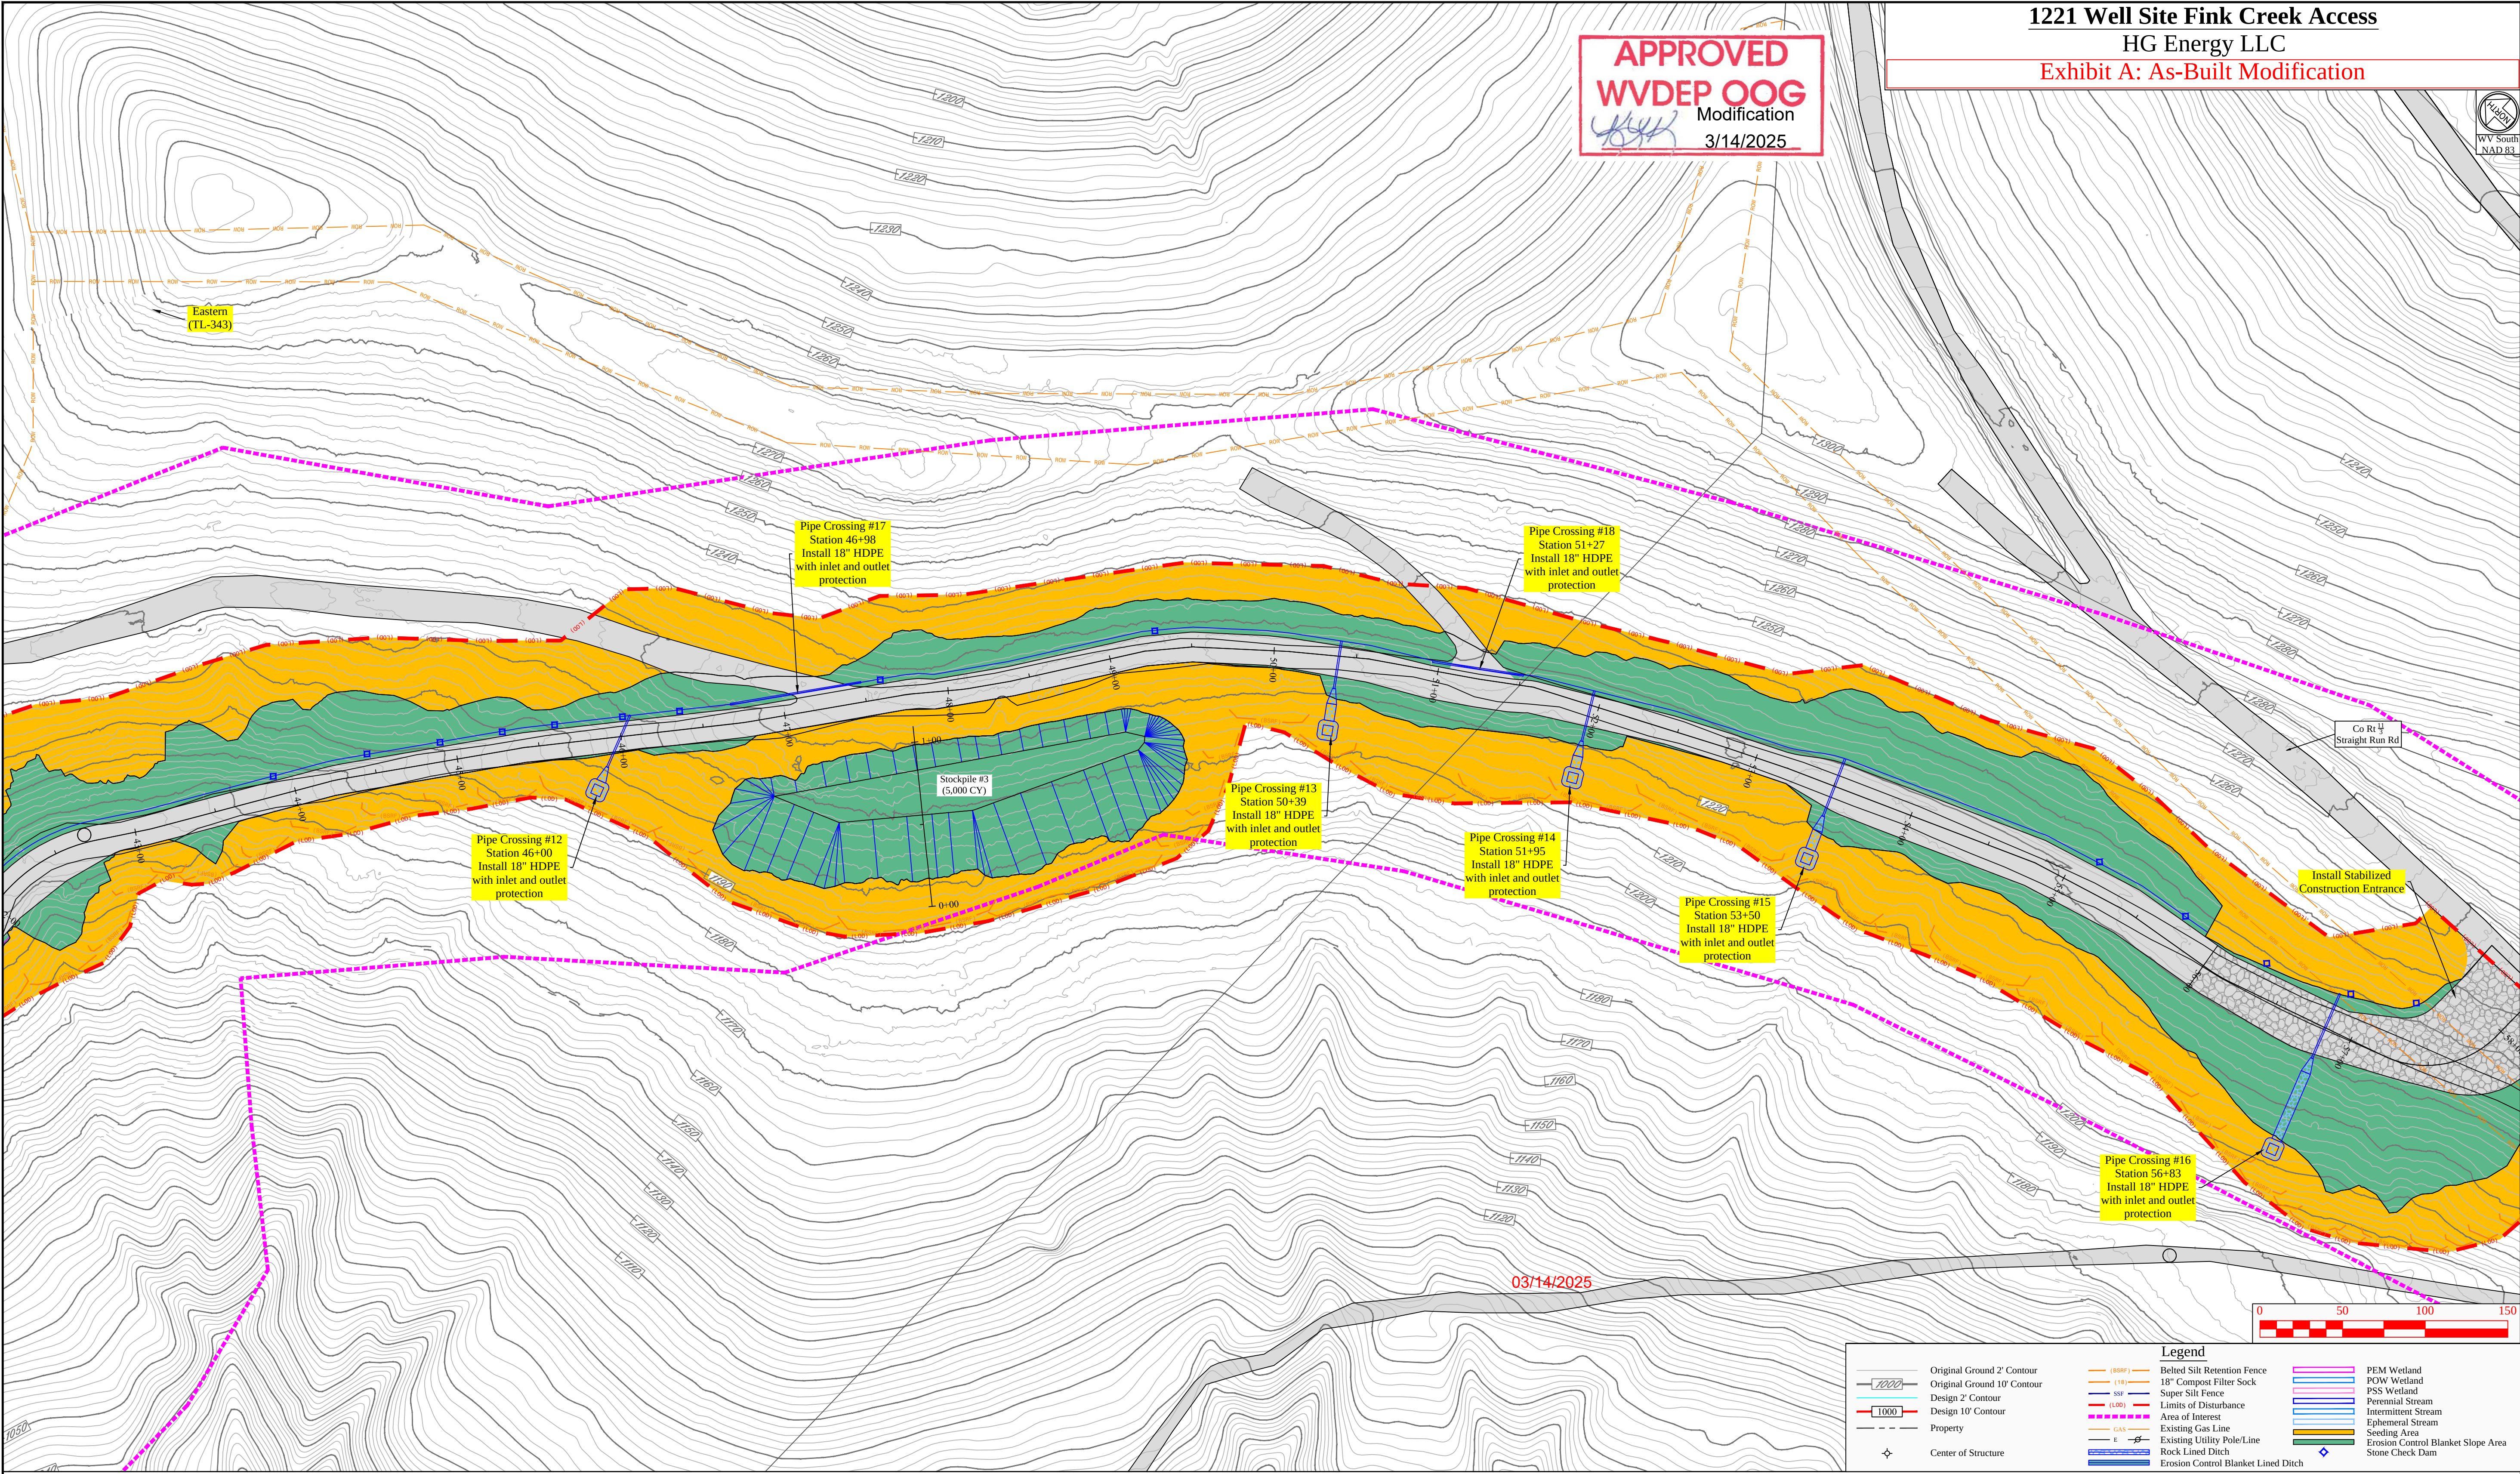

Revision	Design
Date	02-04-2025

THIS DOCUMENT
PREPARED FOR
HG ENERGY LLC



Kelly Surveying
P.O. Box 254
Dolley, WV 26239
304-338-0965

Erosion and Sediment Control Plan

1221 Fink Creek Access

Freemans Creek District
Lewis County, WV

Date:	02/04/2025
Scale:	As Shown
Designed By:	ZS
File No.	
Sheet 13 of 32	

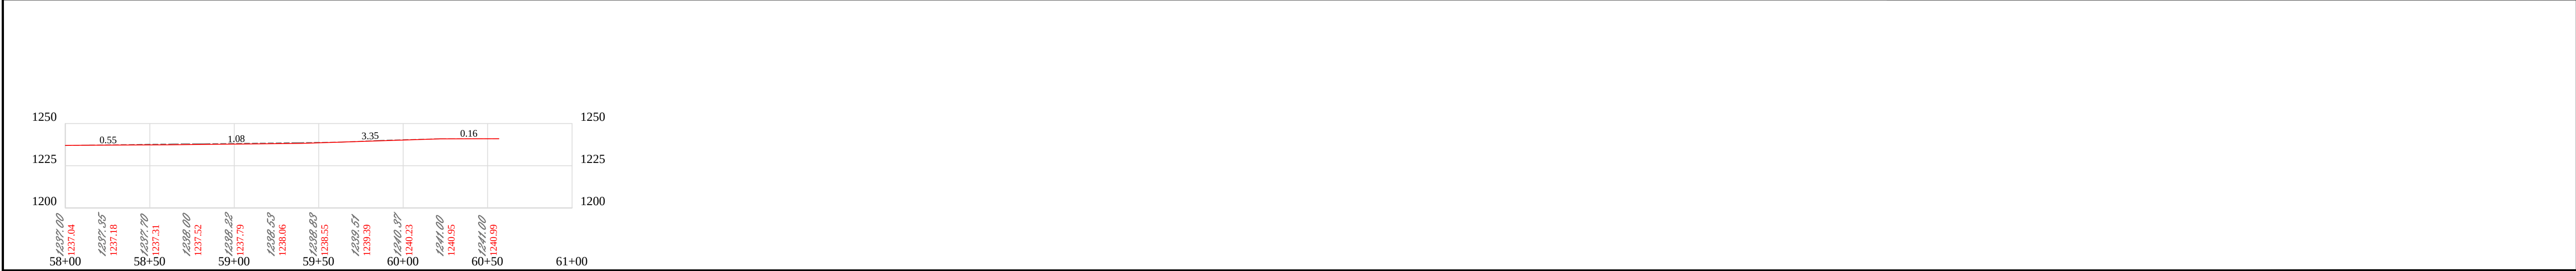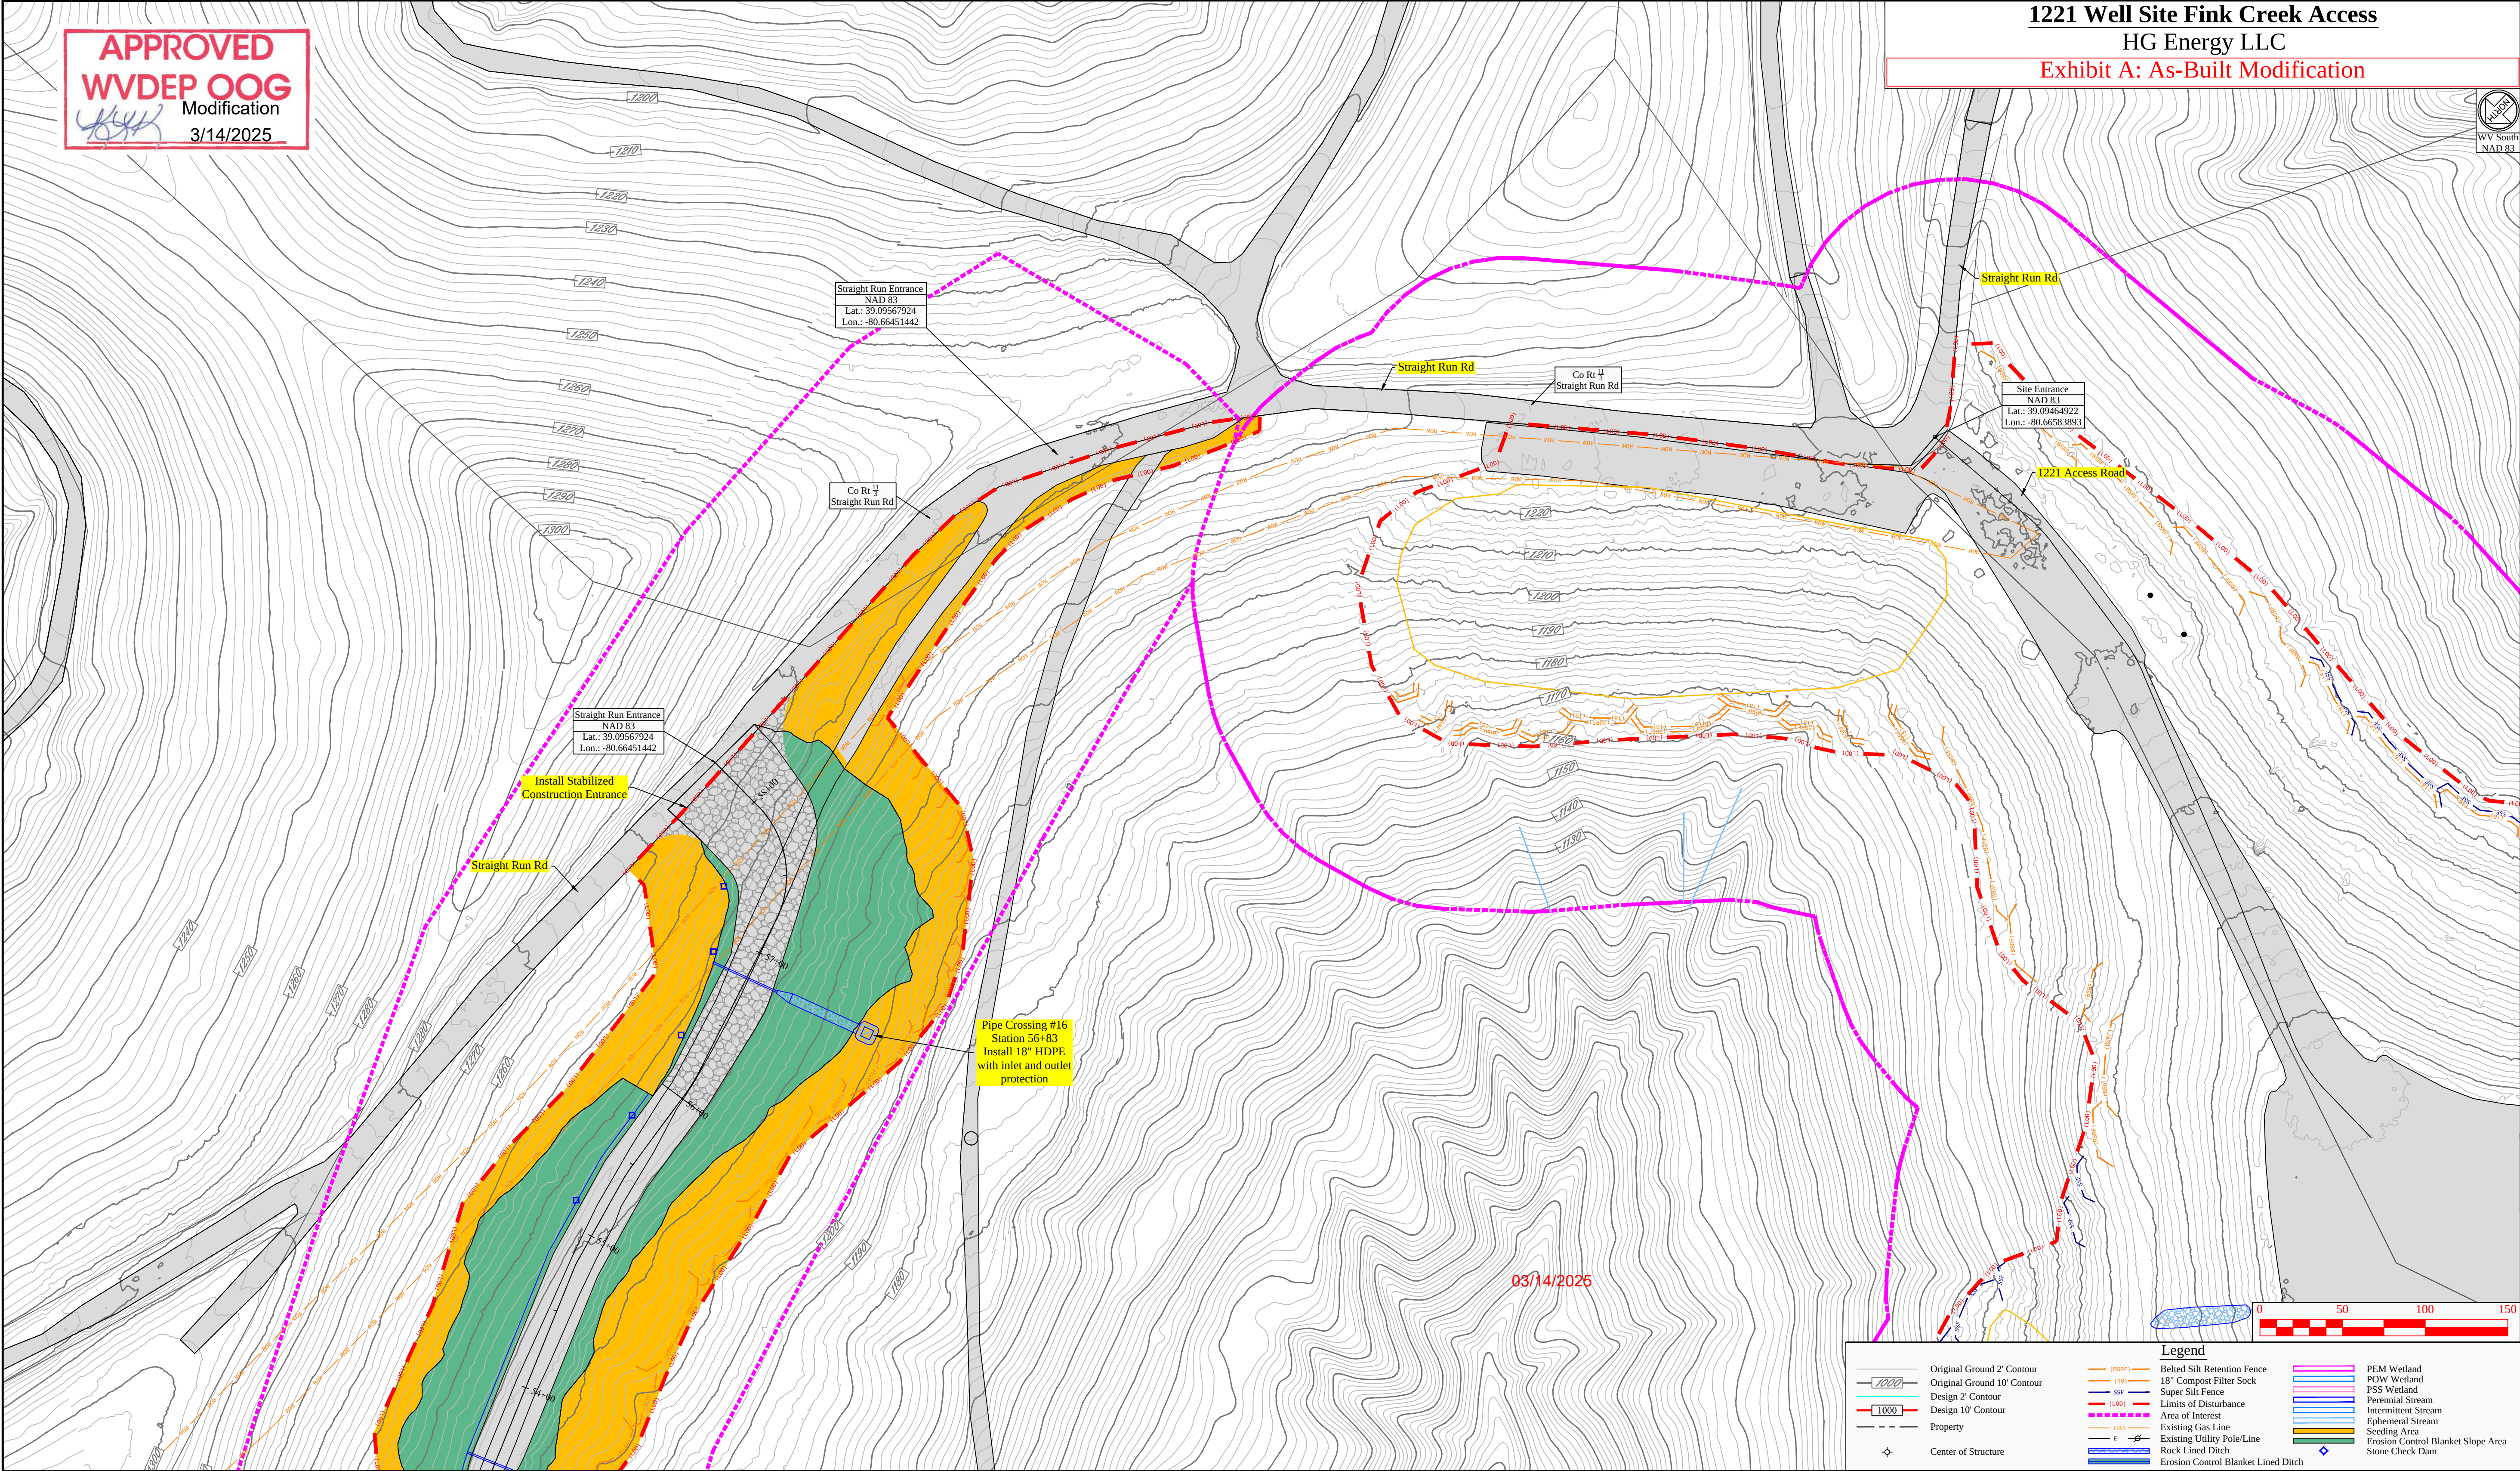

APPROVED
WVDEP OOG
Modification
3/14/2025

1221 Well Site Fink Creek Access
HG Energy LLC
Exhibit A: As-Built Modification

WV South
NAD 83

Revision	Date
Design	02-04-2025




THIS DOCUMENT
PREPARED FOR
HG ENERGY LLC

Kelly Surveying
P.O. Box 254
Dallman, WV 26239
304-338-0965

Erosion and Sediment Control Plan
1221 Fink Creek Access
Freemans Creek District
Lewis County, WV

Date: 02/04/2025
Scale: As Shown
Designed By: ZS
File No.
Sheet 14 of 32

1221 Well Site Fink Creek Access
HG Energy LLC
Exhibit A: As-Built Modification

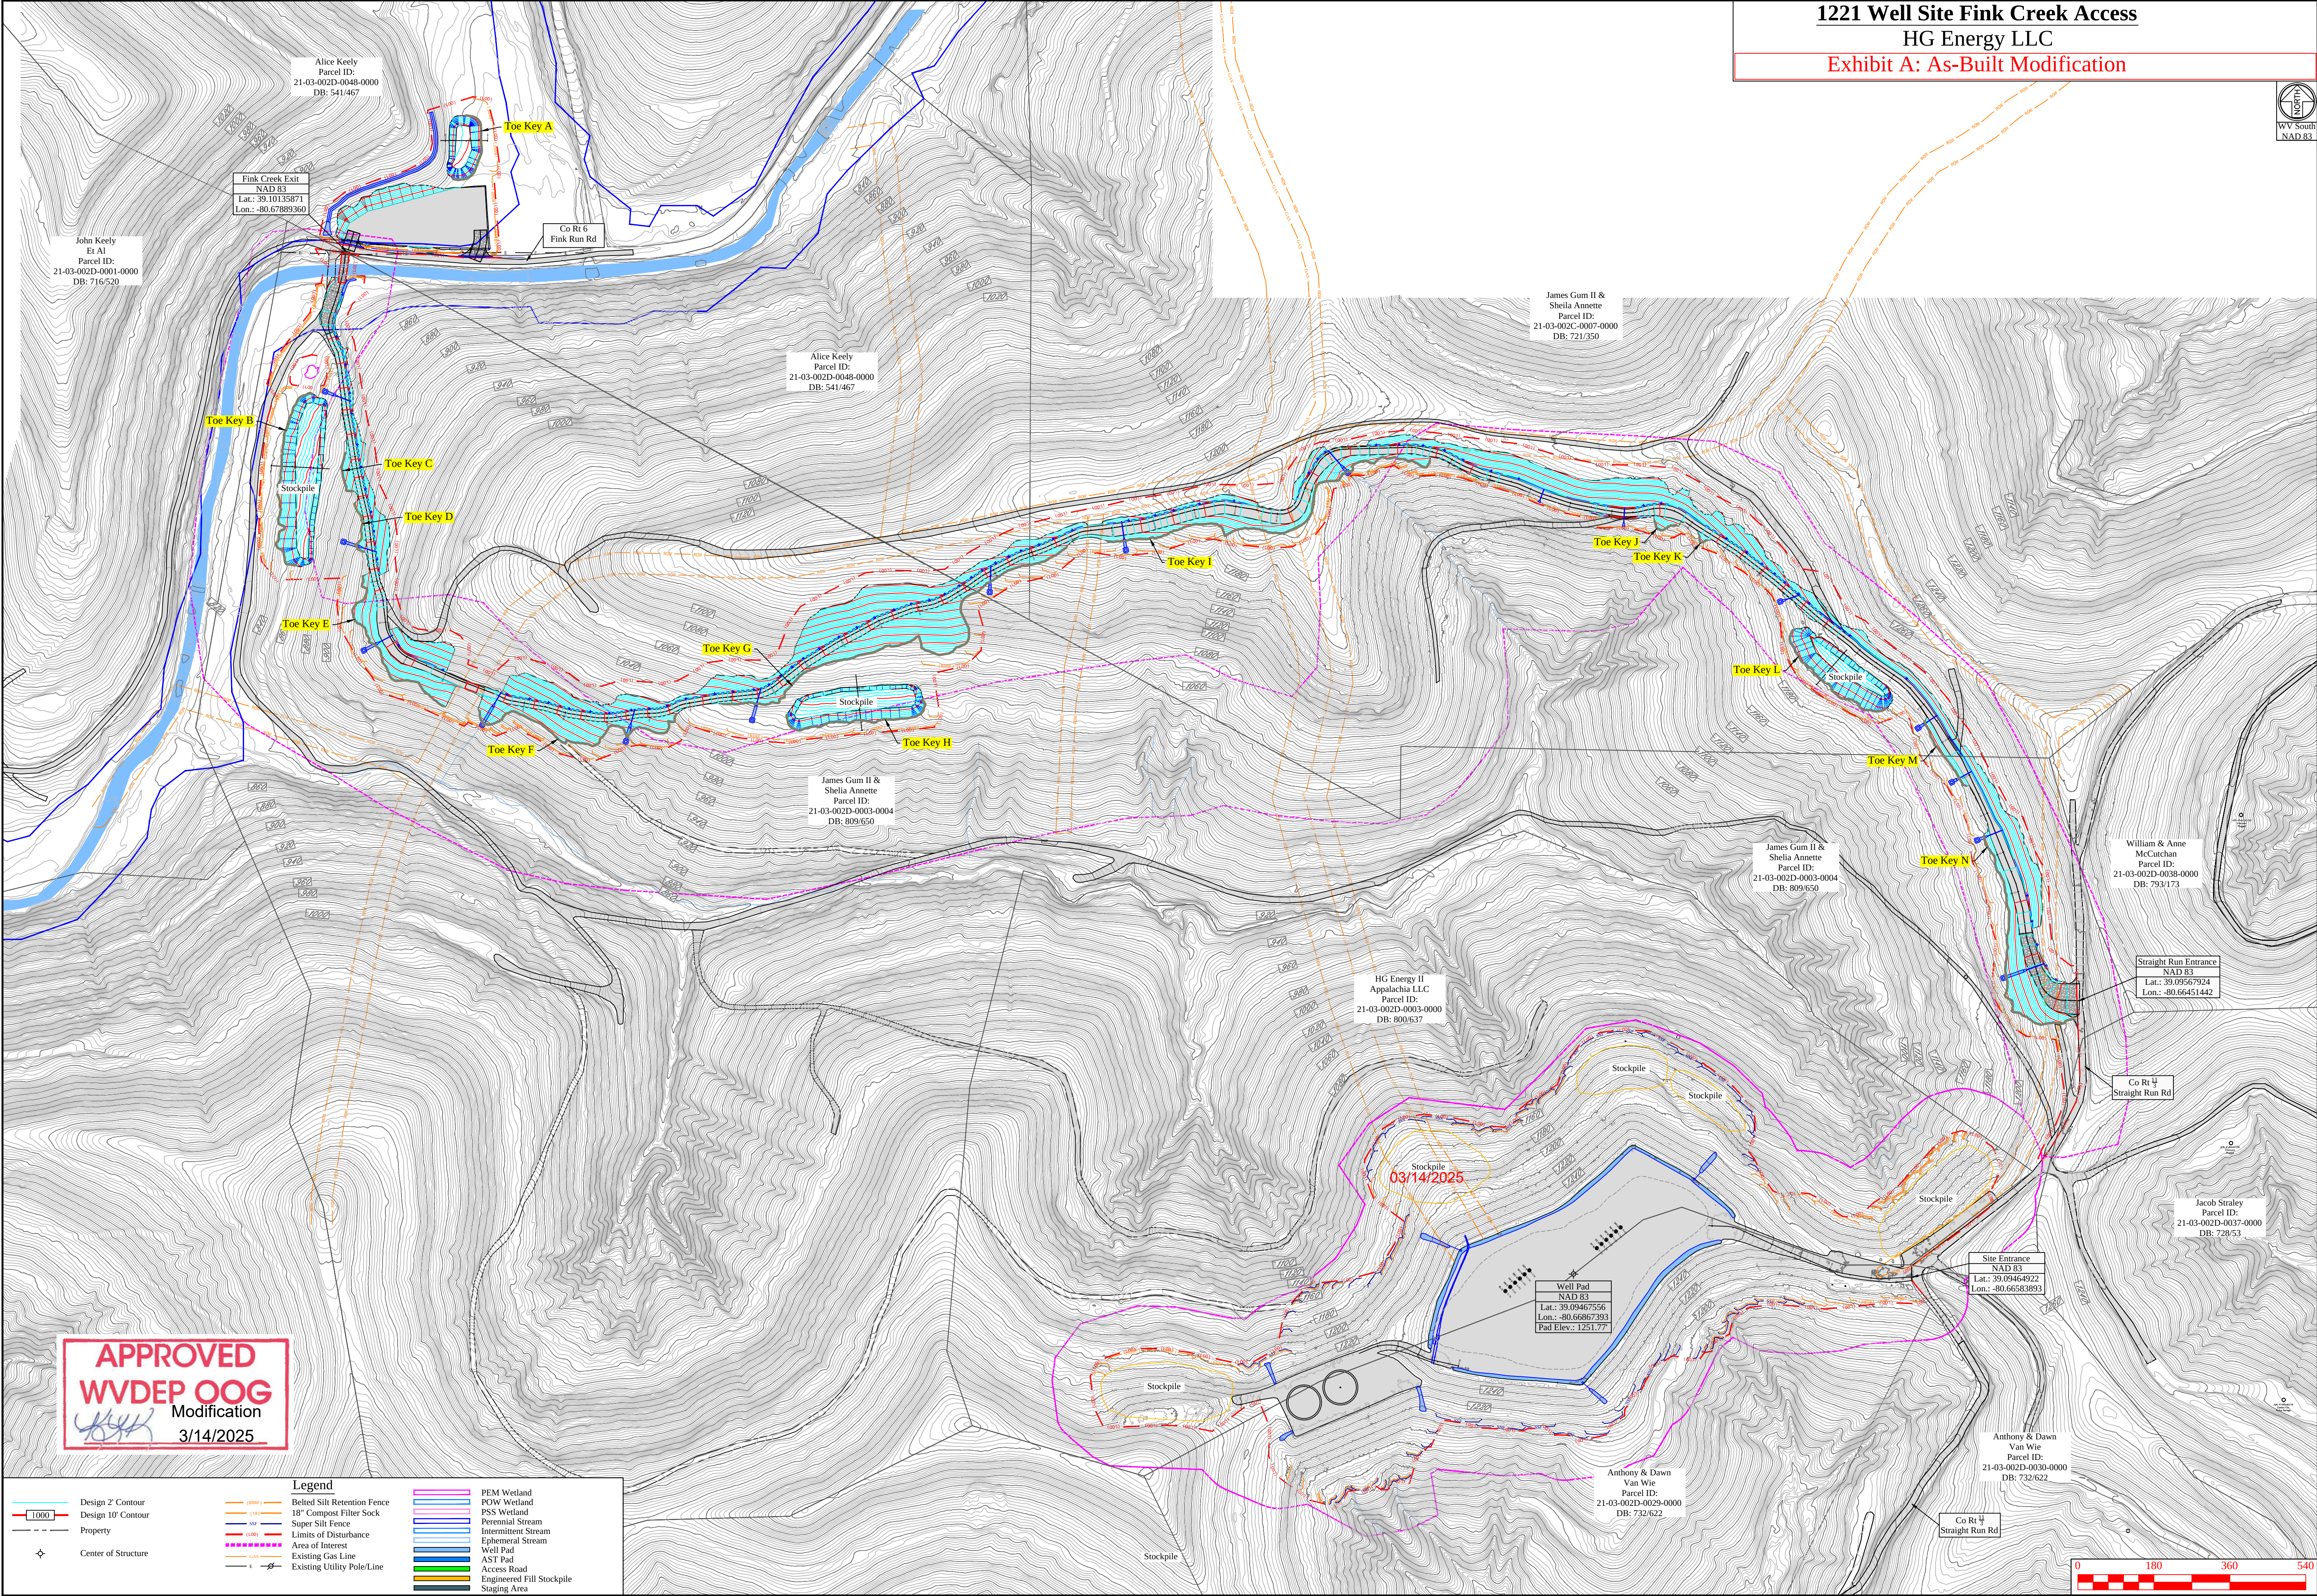

APPROVED
WVDEP OOG
Modification
3/14/2025

Legend

- | | | | |
|---------------------------|----------------------------|-----------------------|---------------------------|
| Design 2' Contour | Design 10' Contour | Property | Center of Structure |
| 18" Composite Filter Sock | Super Silt Fence | Limits of Disturbance | Area of Interest |
| Existing Gas Line | Existing Utility Pole/Line | PEM Wetland | POW Wetland |
| PSS Wetland | Perennial Stream | Intermittent Stream | Ephemeral Stream |
| Well Pad | AST Pad | Access Road | Engineered Fill Stockpile |
| Staging Area | | | |

Revision
Design

Date
02-04-2025



THIS DOCUMENT
PREPARED FOR
HG ENERGY LLC



Toe Key Exhibit
1221 Well Site
Freemans Creek District
Lewis County, WV

Date: 02/04/2025
Scale: As Shown
Designed By: ZS
File No.
Sheet 15 of 32

Exhibit A: As-Built Modification



- Legend**

	Original Ground 2' Contour		
	Original Ground 10' Contour		
	Design 2' Contour		
	Design 10' Contour		
	Property		
	Center of Structure		
	Rock Filter Outlet		

02-04-2025	Design
------------	--------



THIS DOCUMENT
PREPARED FOR
HG ENERGY LLC



Site Plan
1221 Well Site
Freemans Creek District
Lewis County, WV

Date: 02/04/2025
Scale: As Shown
Designed By: ZS
File No.
Sheet 16 of 32

1221 Well Site Fink Creek Access
HG Energy LLC
Exhibit A: As-Built Modification



Revision
Design

Date
02-04-2025



THIS DOCUMENT
PREPARED FOR
HG ENERGY LLC



Site Plan
1221 Well Site
Freemans Creek District
Lewis County, WV

Date: 02/04/2025
Scale: As Shown
Designed By: ZS
File No.
Sheet 17 of 32


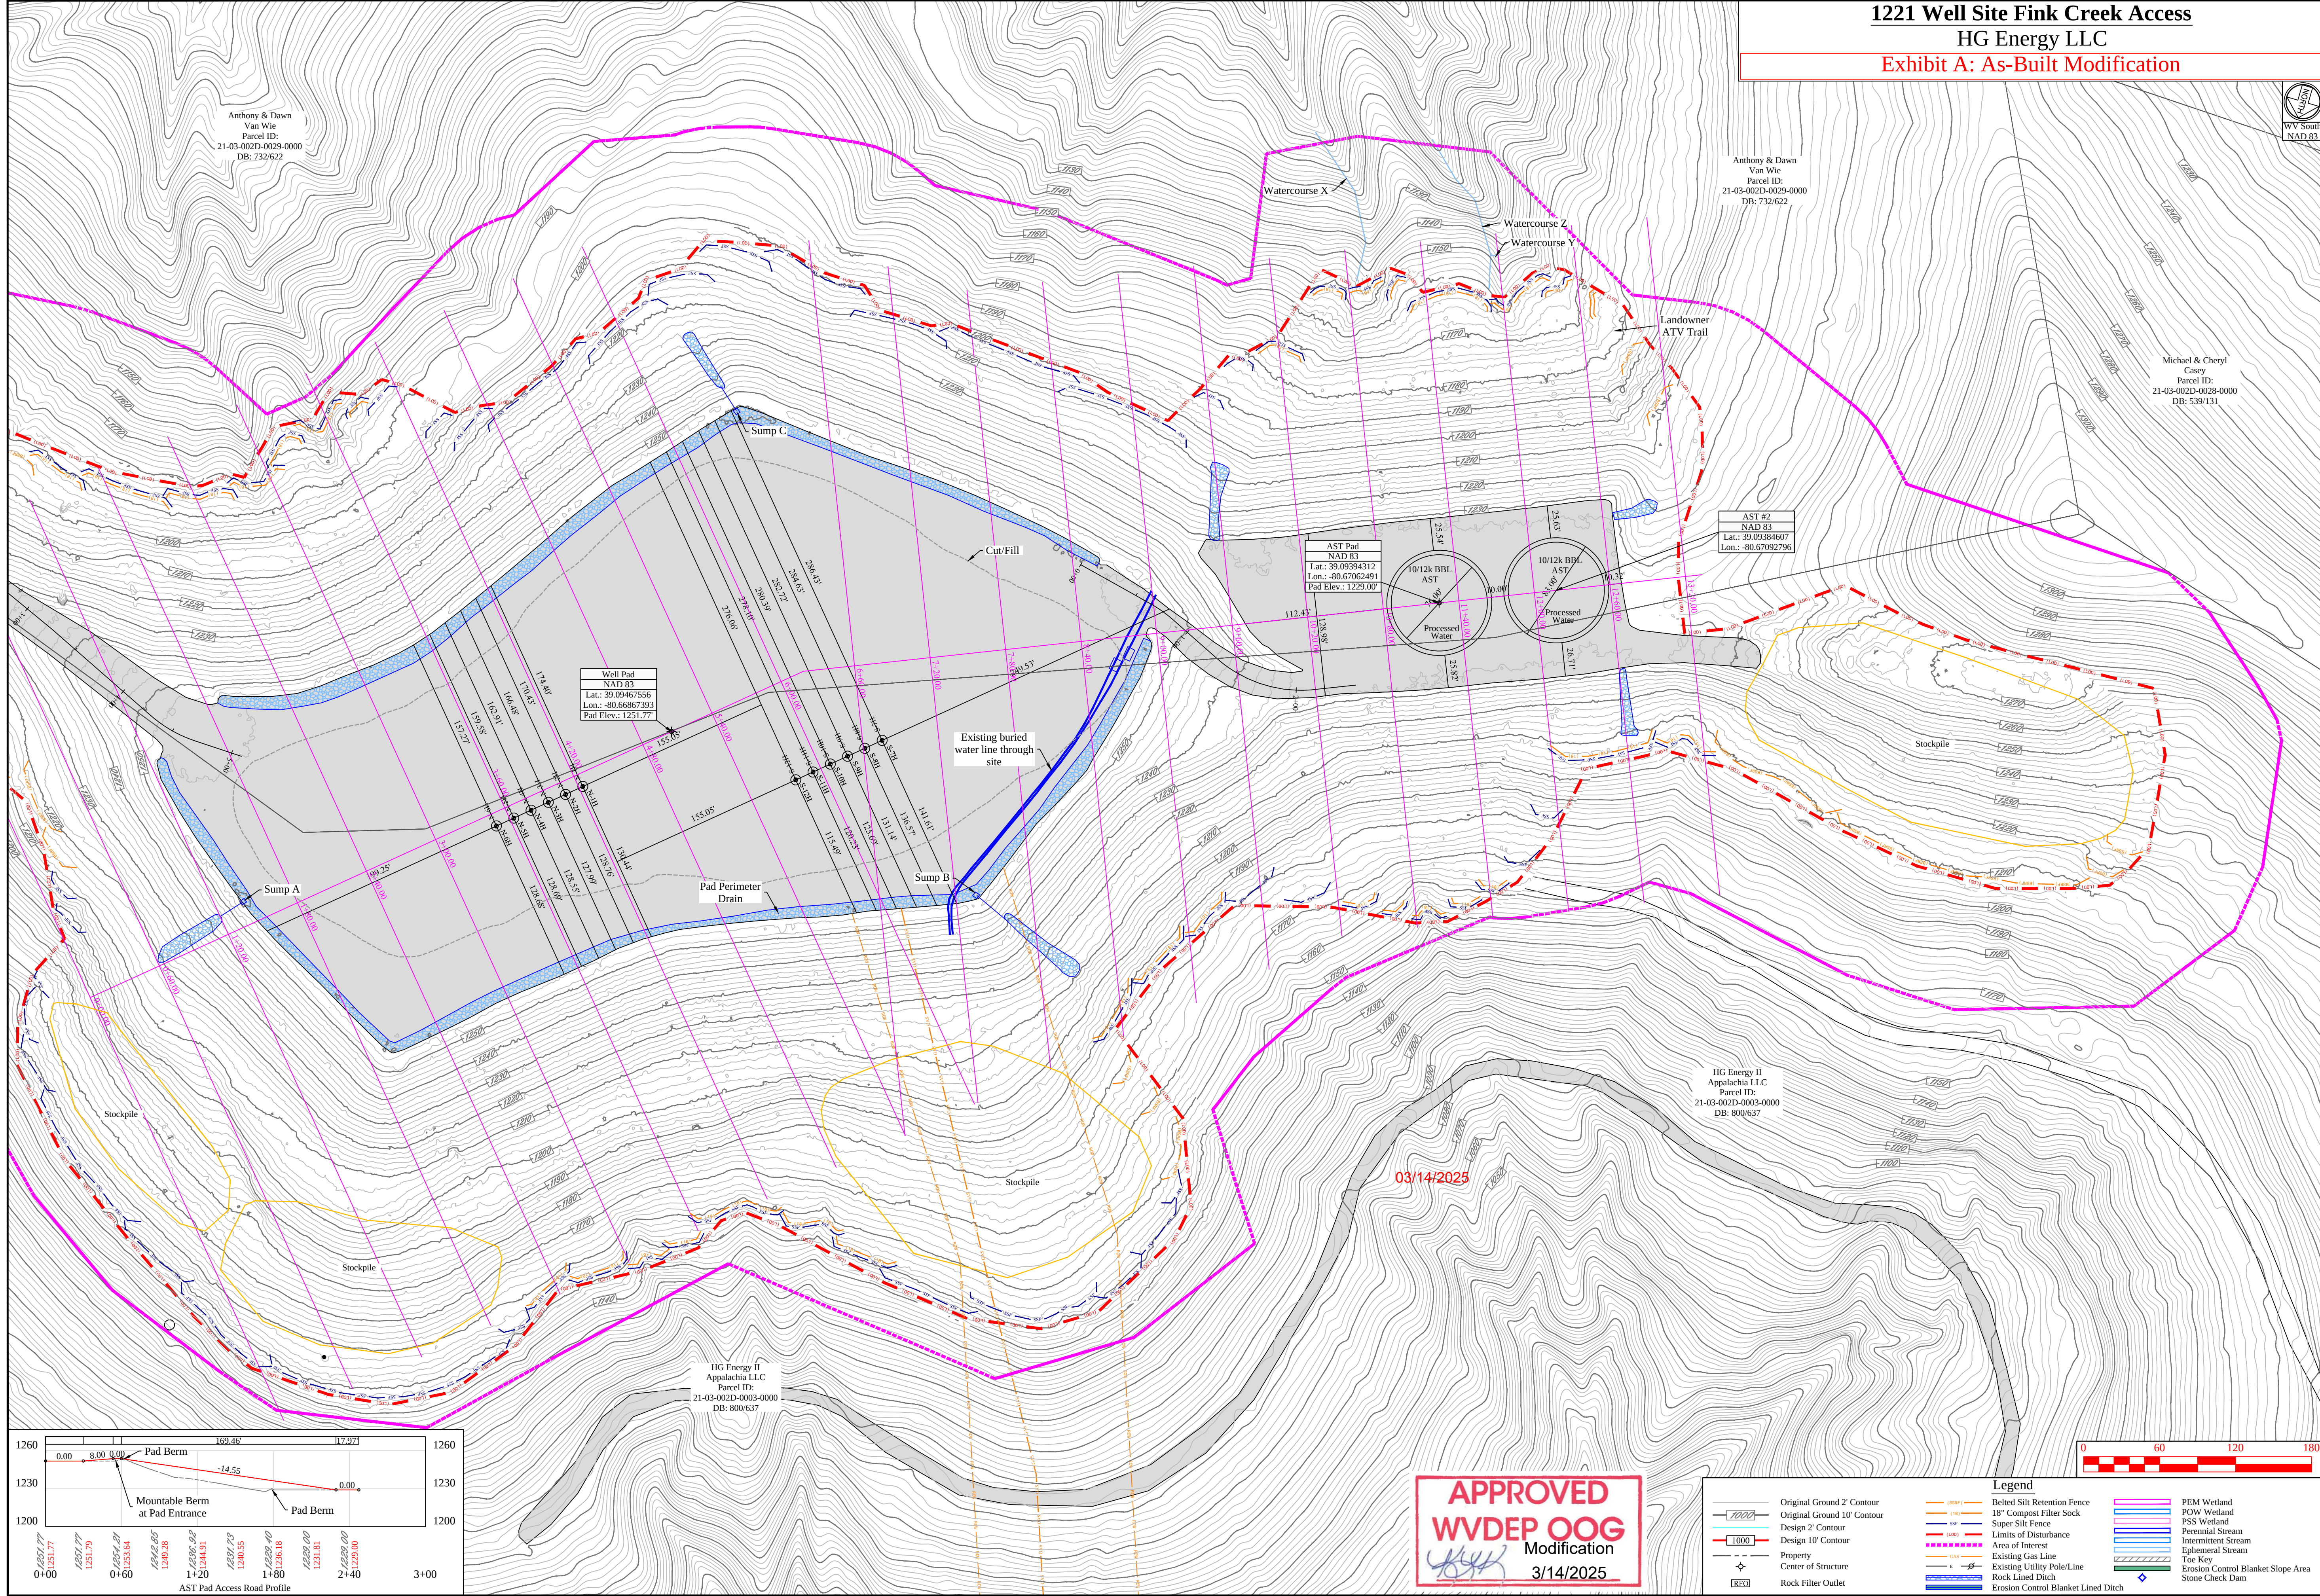


Exhibit A: As-Built Modification



02-04-2025

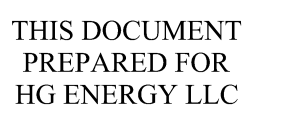




Site Plan - Fink Creek Existing Access



1221 Fink Creek Access

Freemans Creek District
Lewis County, WV

Date: 02/04/2025
Scale: As Shown
Designed By: ZS
File No.
Sheet 18 of 32

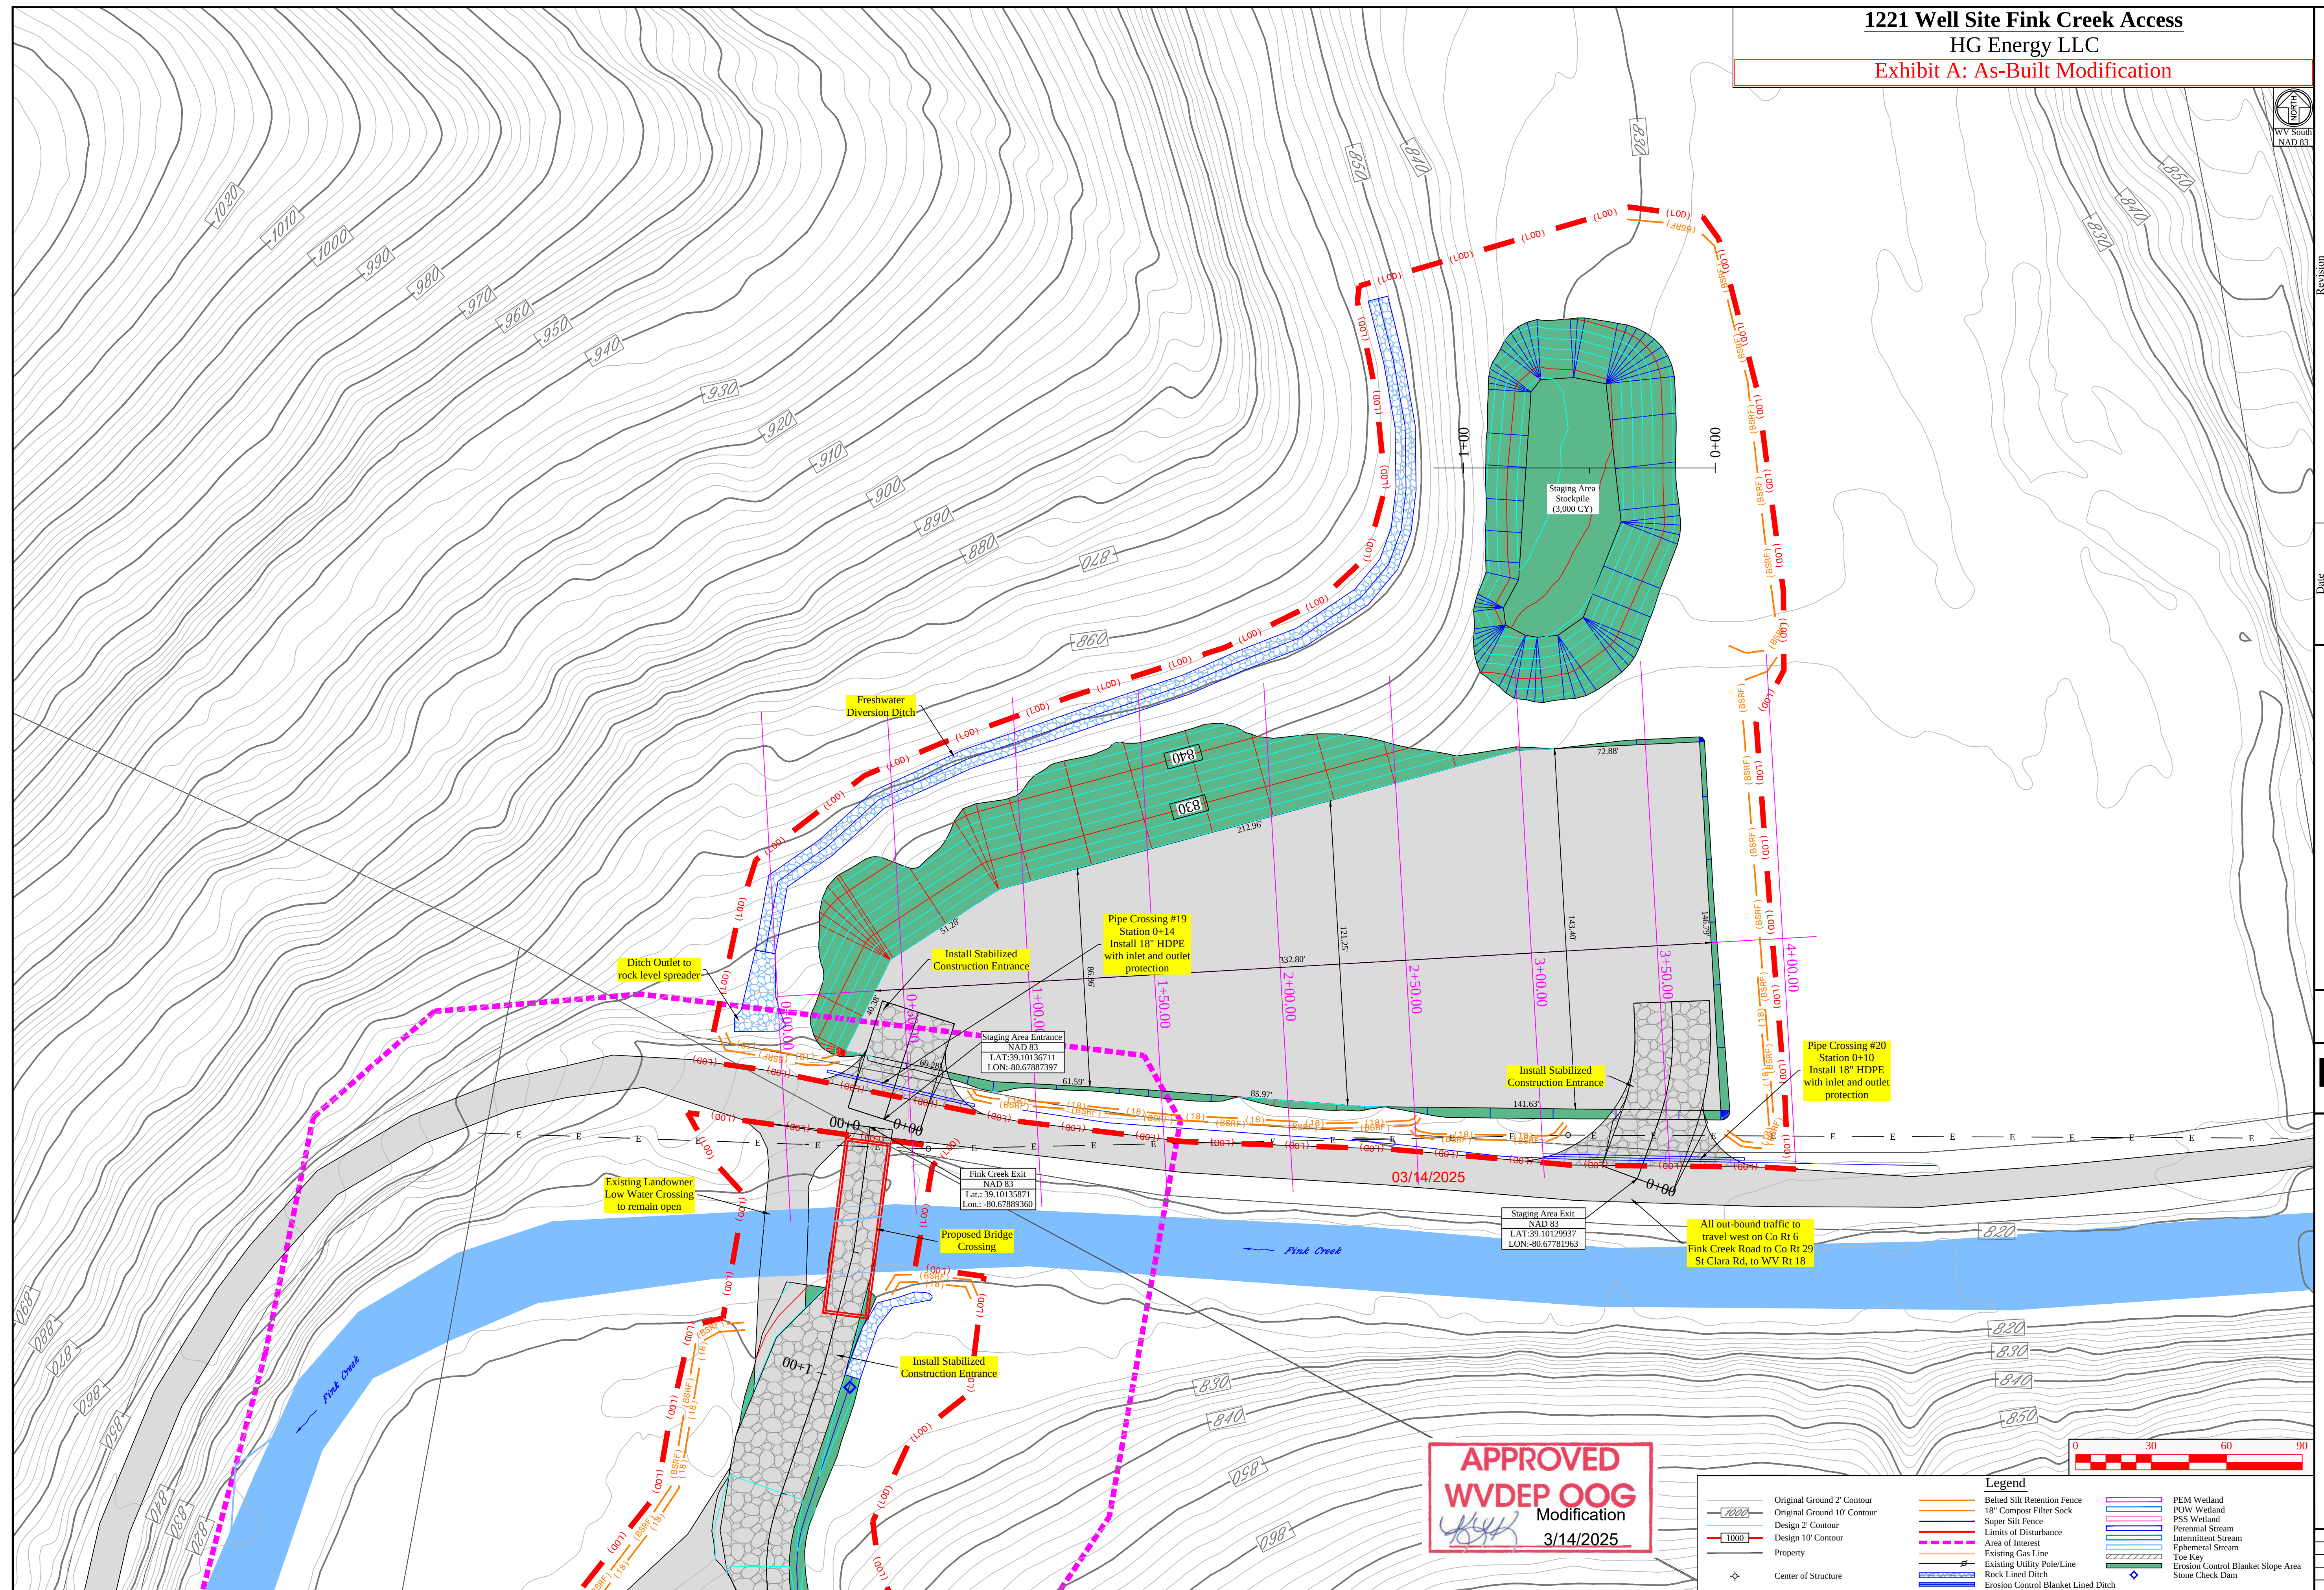

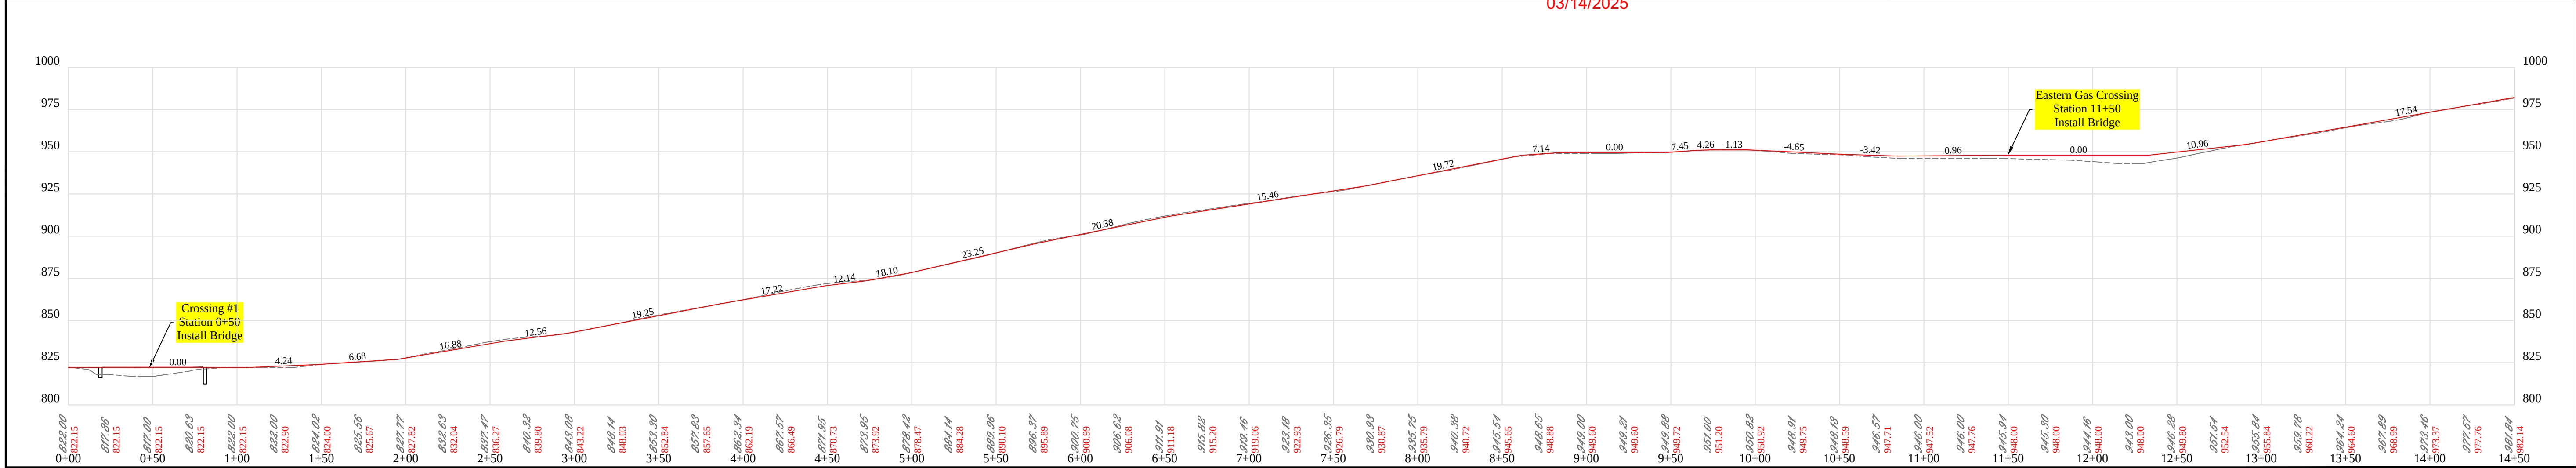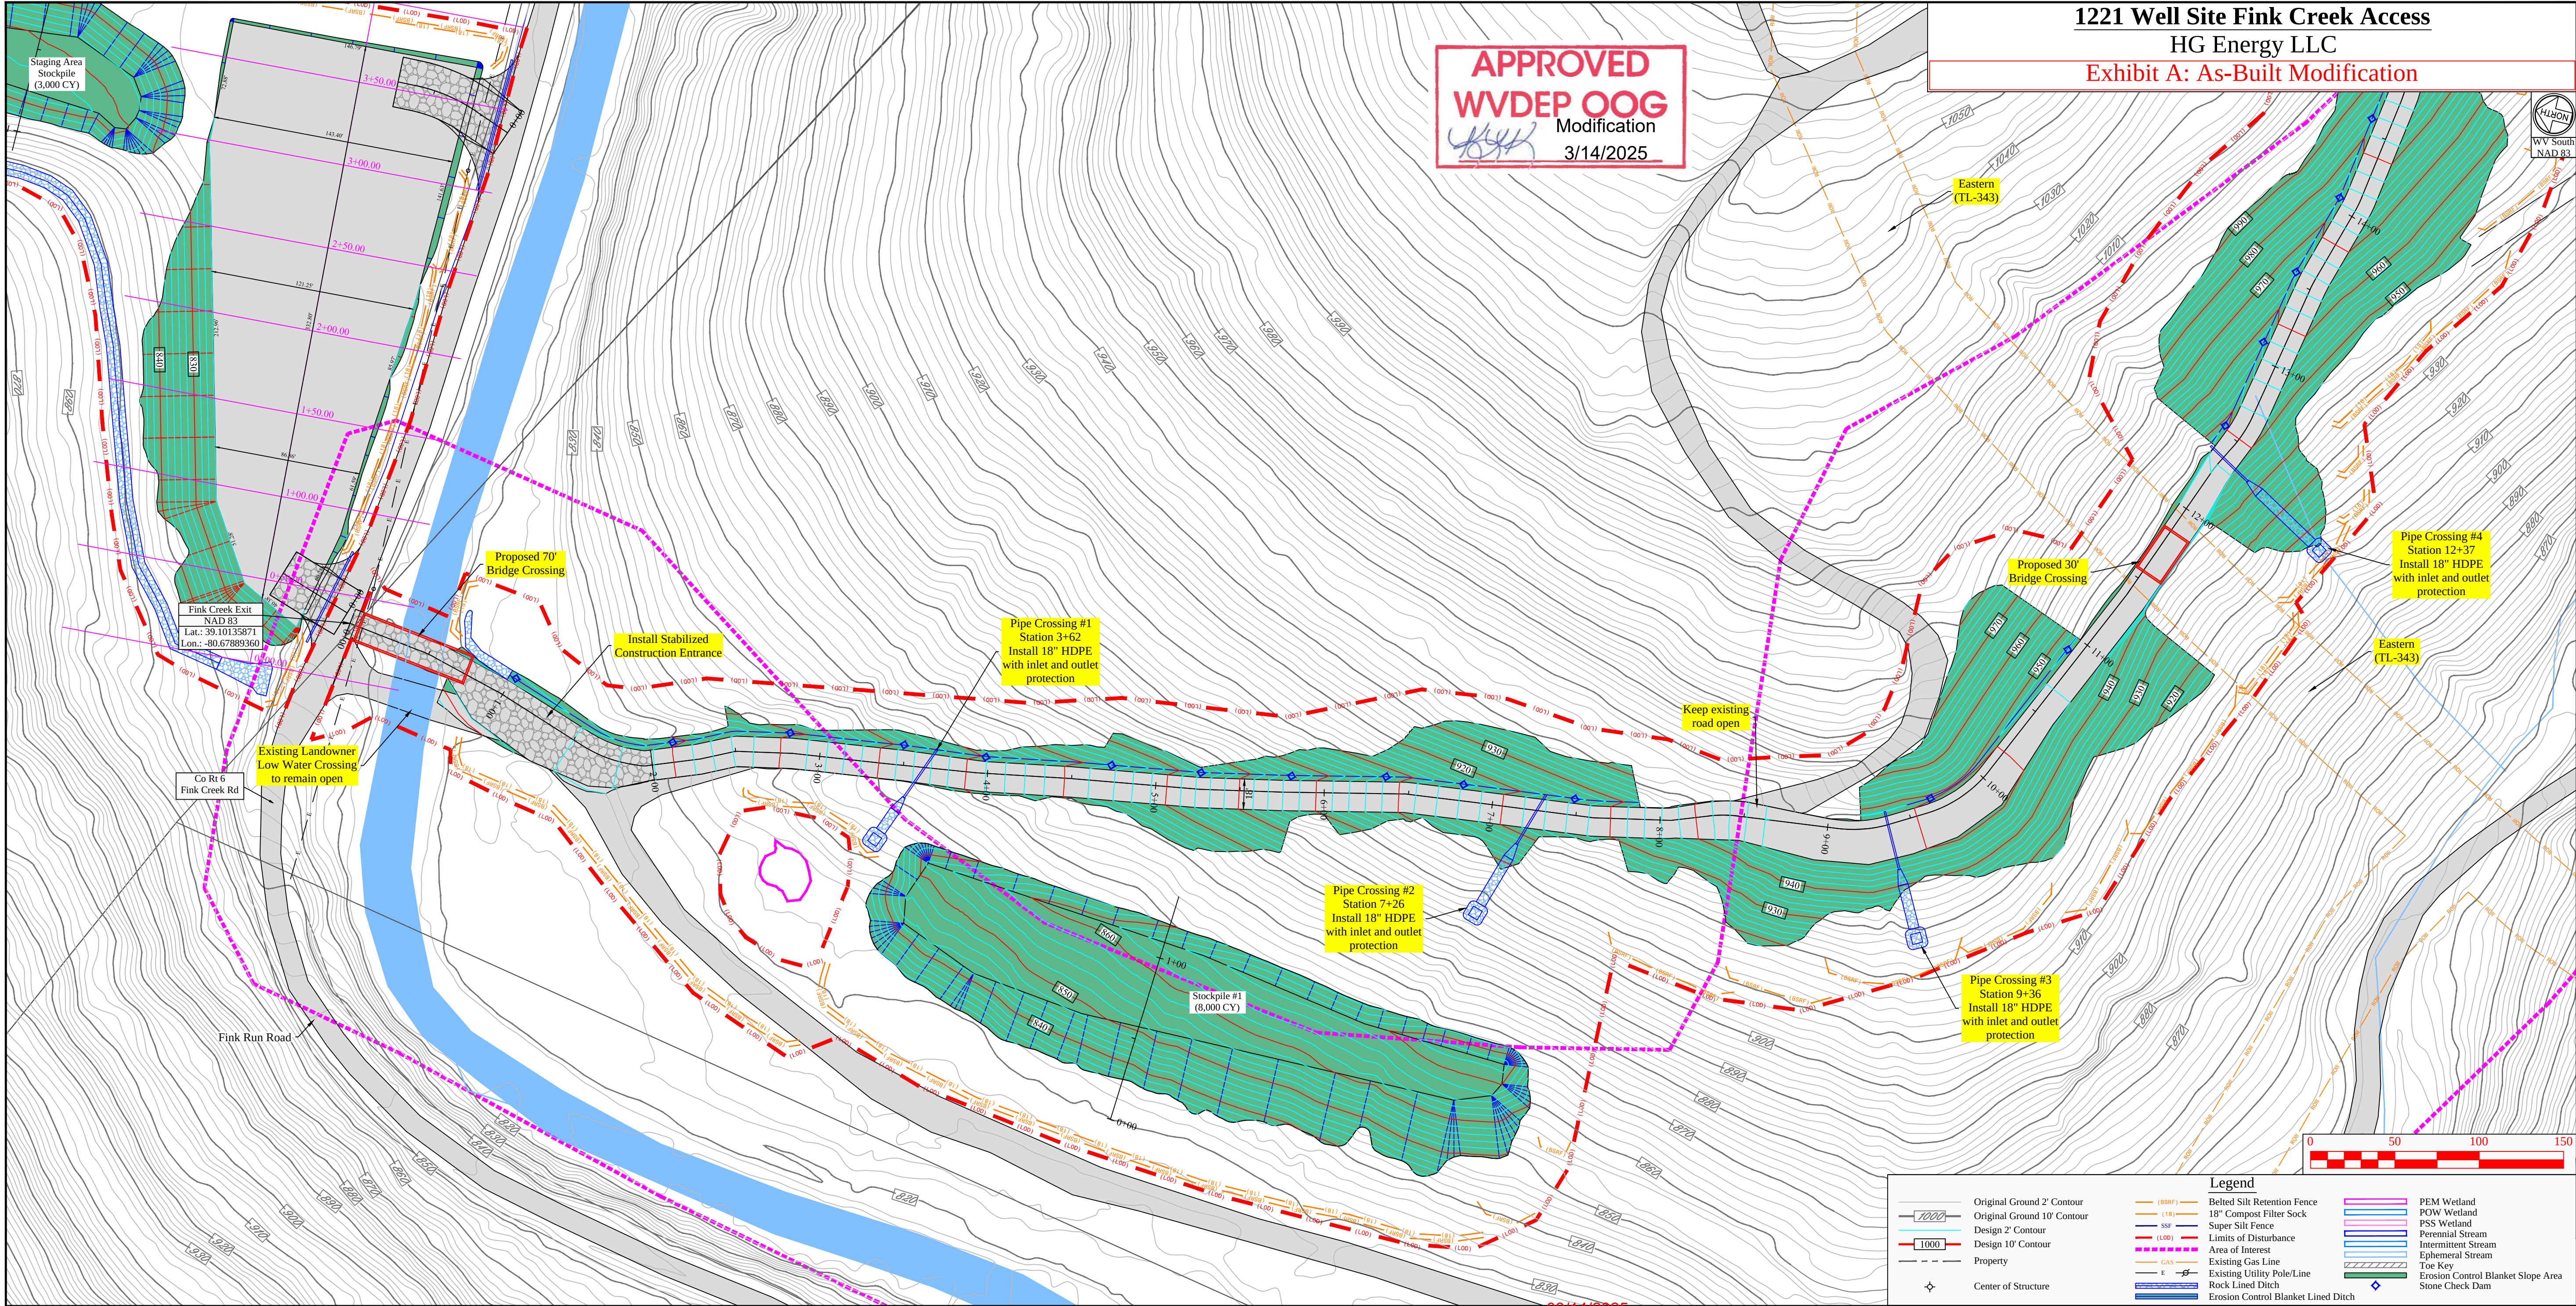

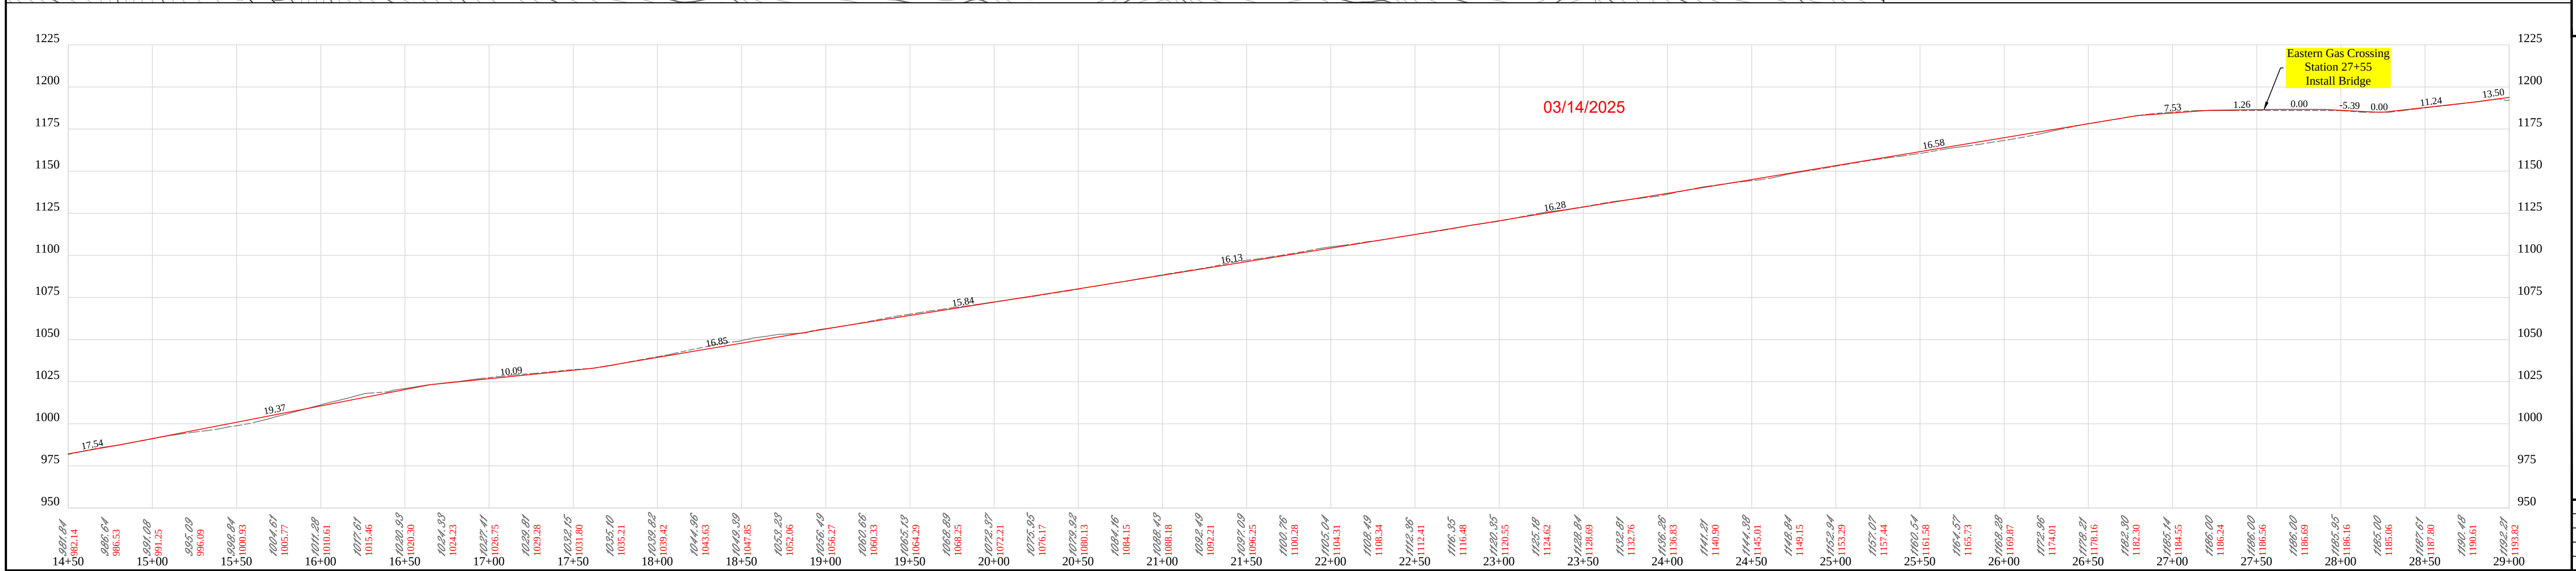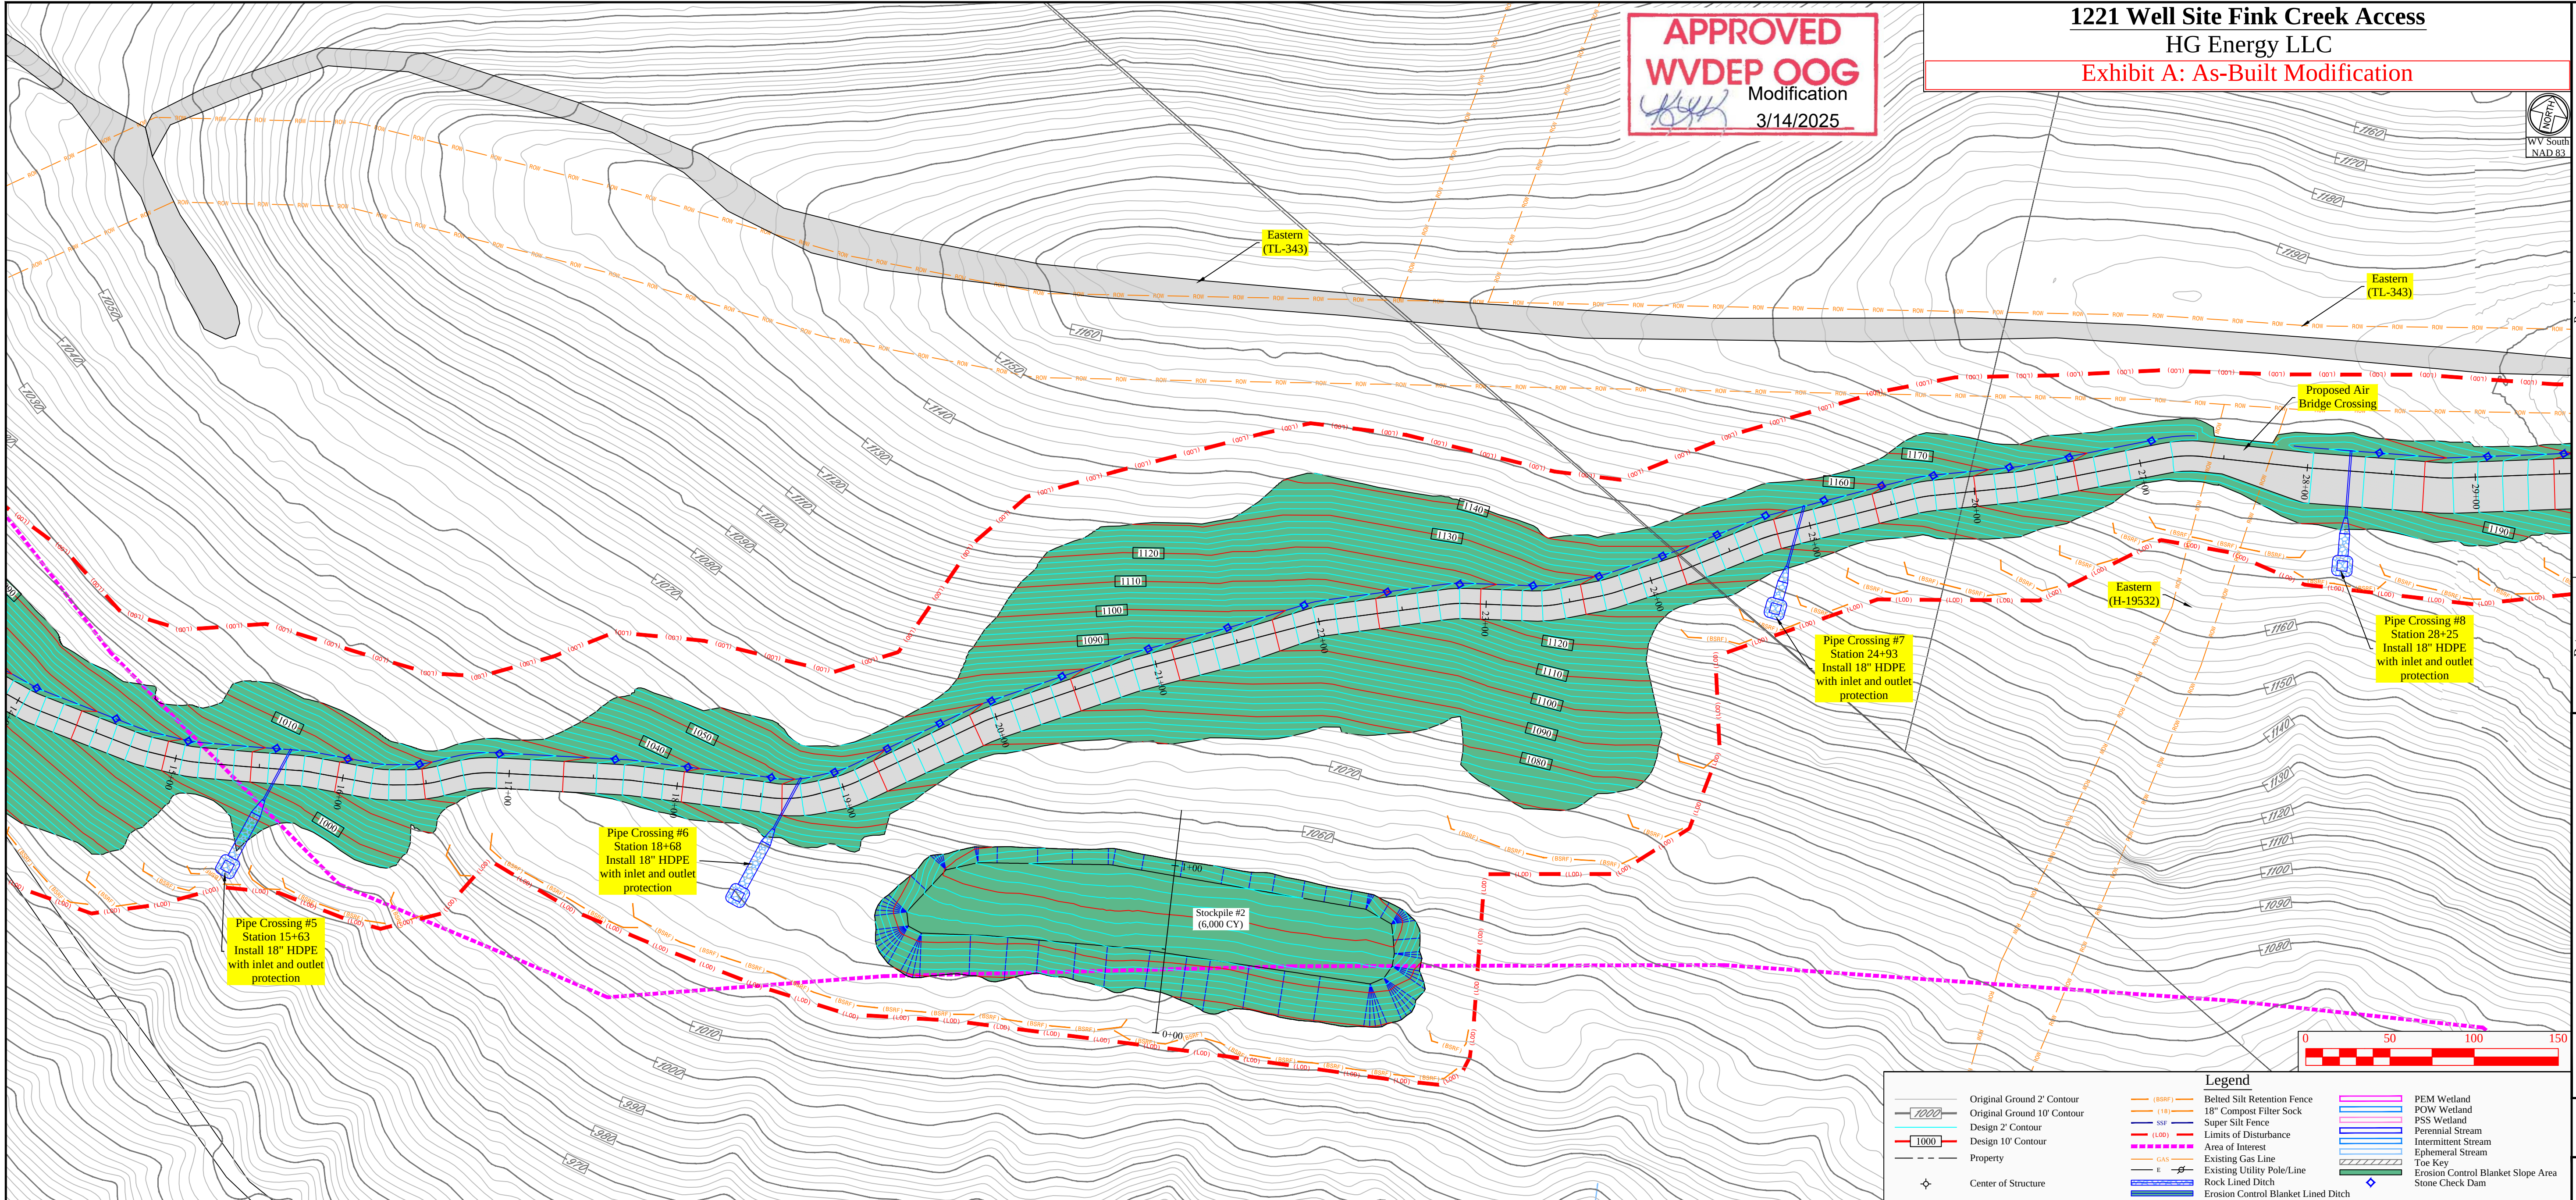

Revision
Design

Date
02-04-2025



THIS DOCUMENT
PREPARED FOR
HG ENERGY LLC

P.O. Box 254
Delmar, WV 26299
(304)338-0985

Site Plan - Fink Creek Access Road

1221 Well Site
Freemans Creek District
Lewis County, WV



Date: 02/04/2025
Scale: As Shown
Designed By: ZS
File No.
Sheet 20 of 32

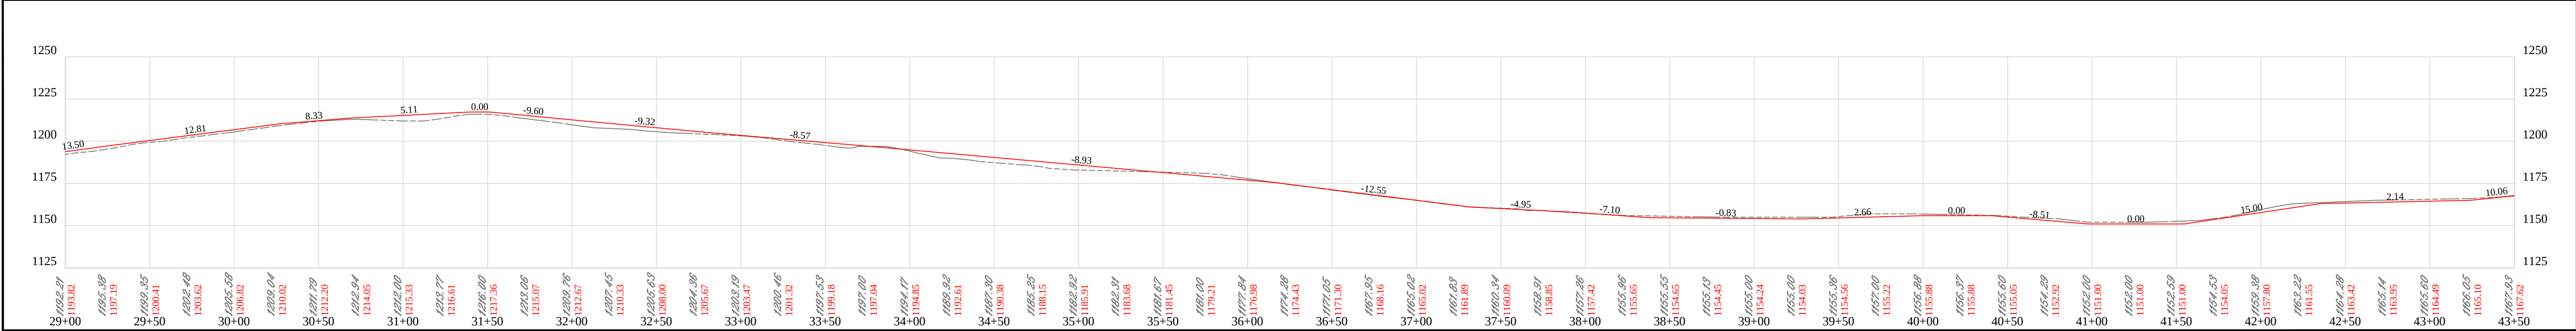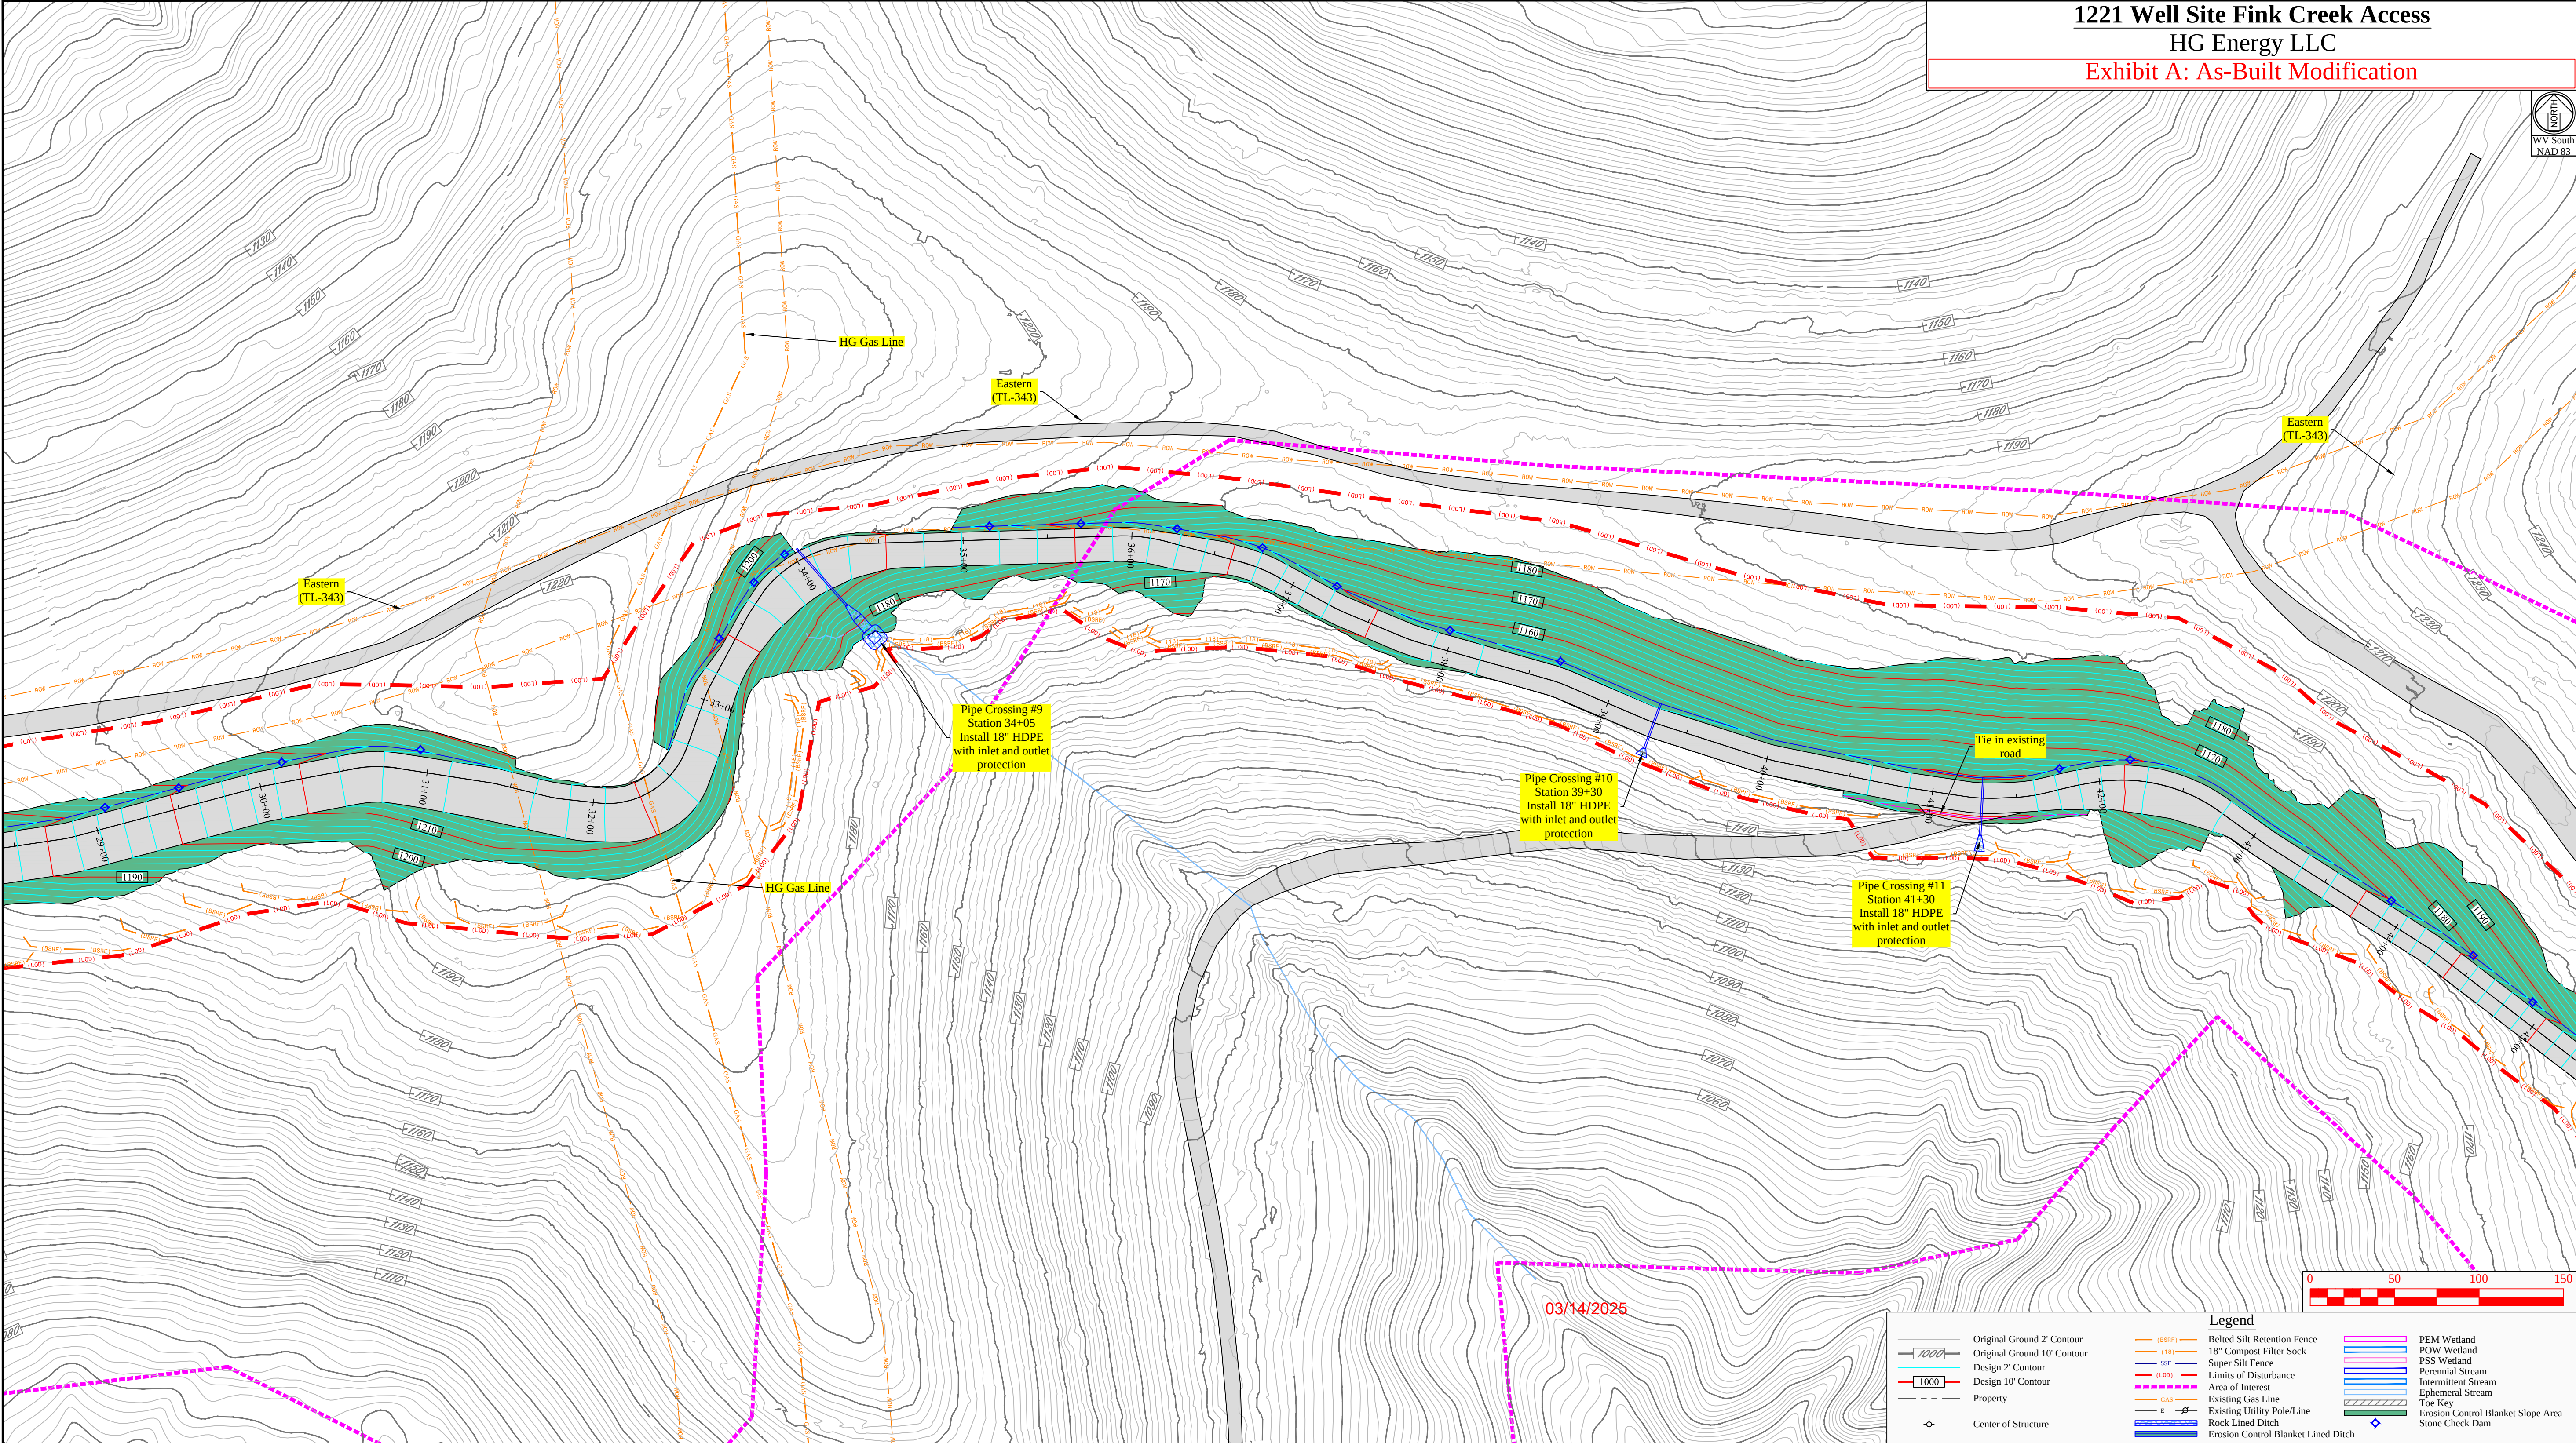

1221 Well Site Fink Creek Access
HG Energy LLC
Exhibit A: As-Built Modification



Revision	Design
Date	02-04-2025
THIS DOCUMENT PREPARED FOR HG ENERGY LLC	
Kelly S urveying P.O. Box 254 Dallman, WV 26239 304-338-0965	
Site Plan - Fink Creek Access Road	
1221 Well Site	
Freemans Creek District Lewis County, WV	
Date: 02/04/2025	
Scale: As Shown	
Designed By: ZS	
File No.	
Sheet 21 of 32	

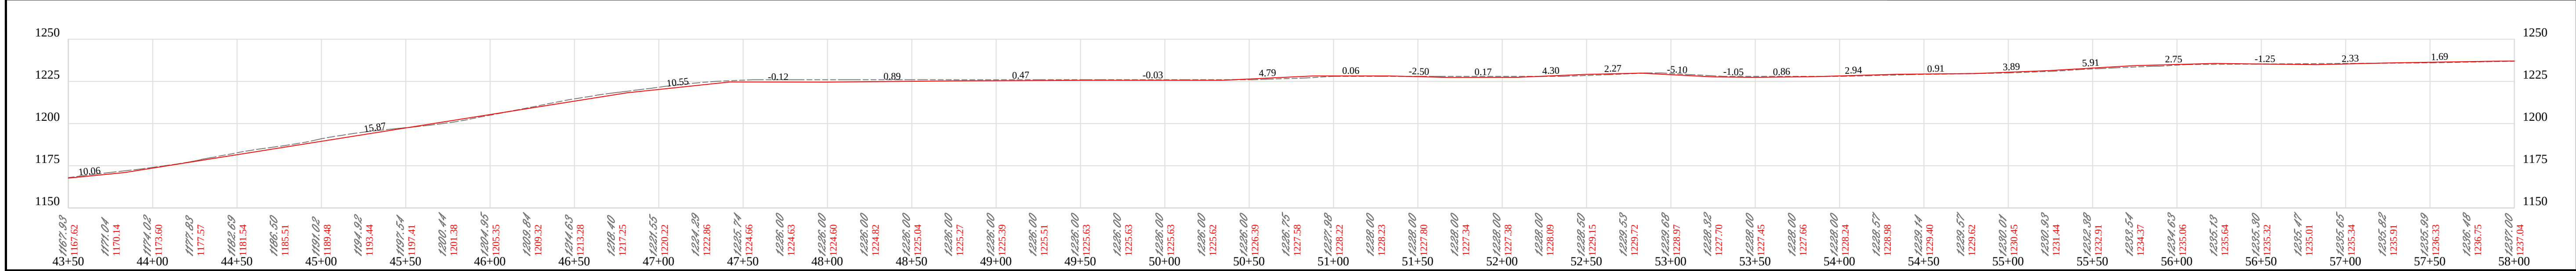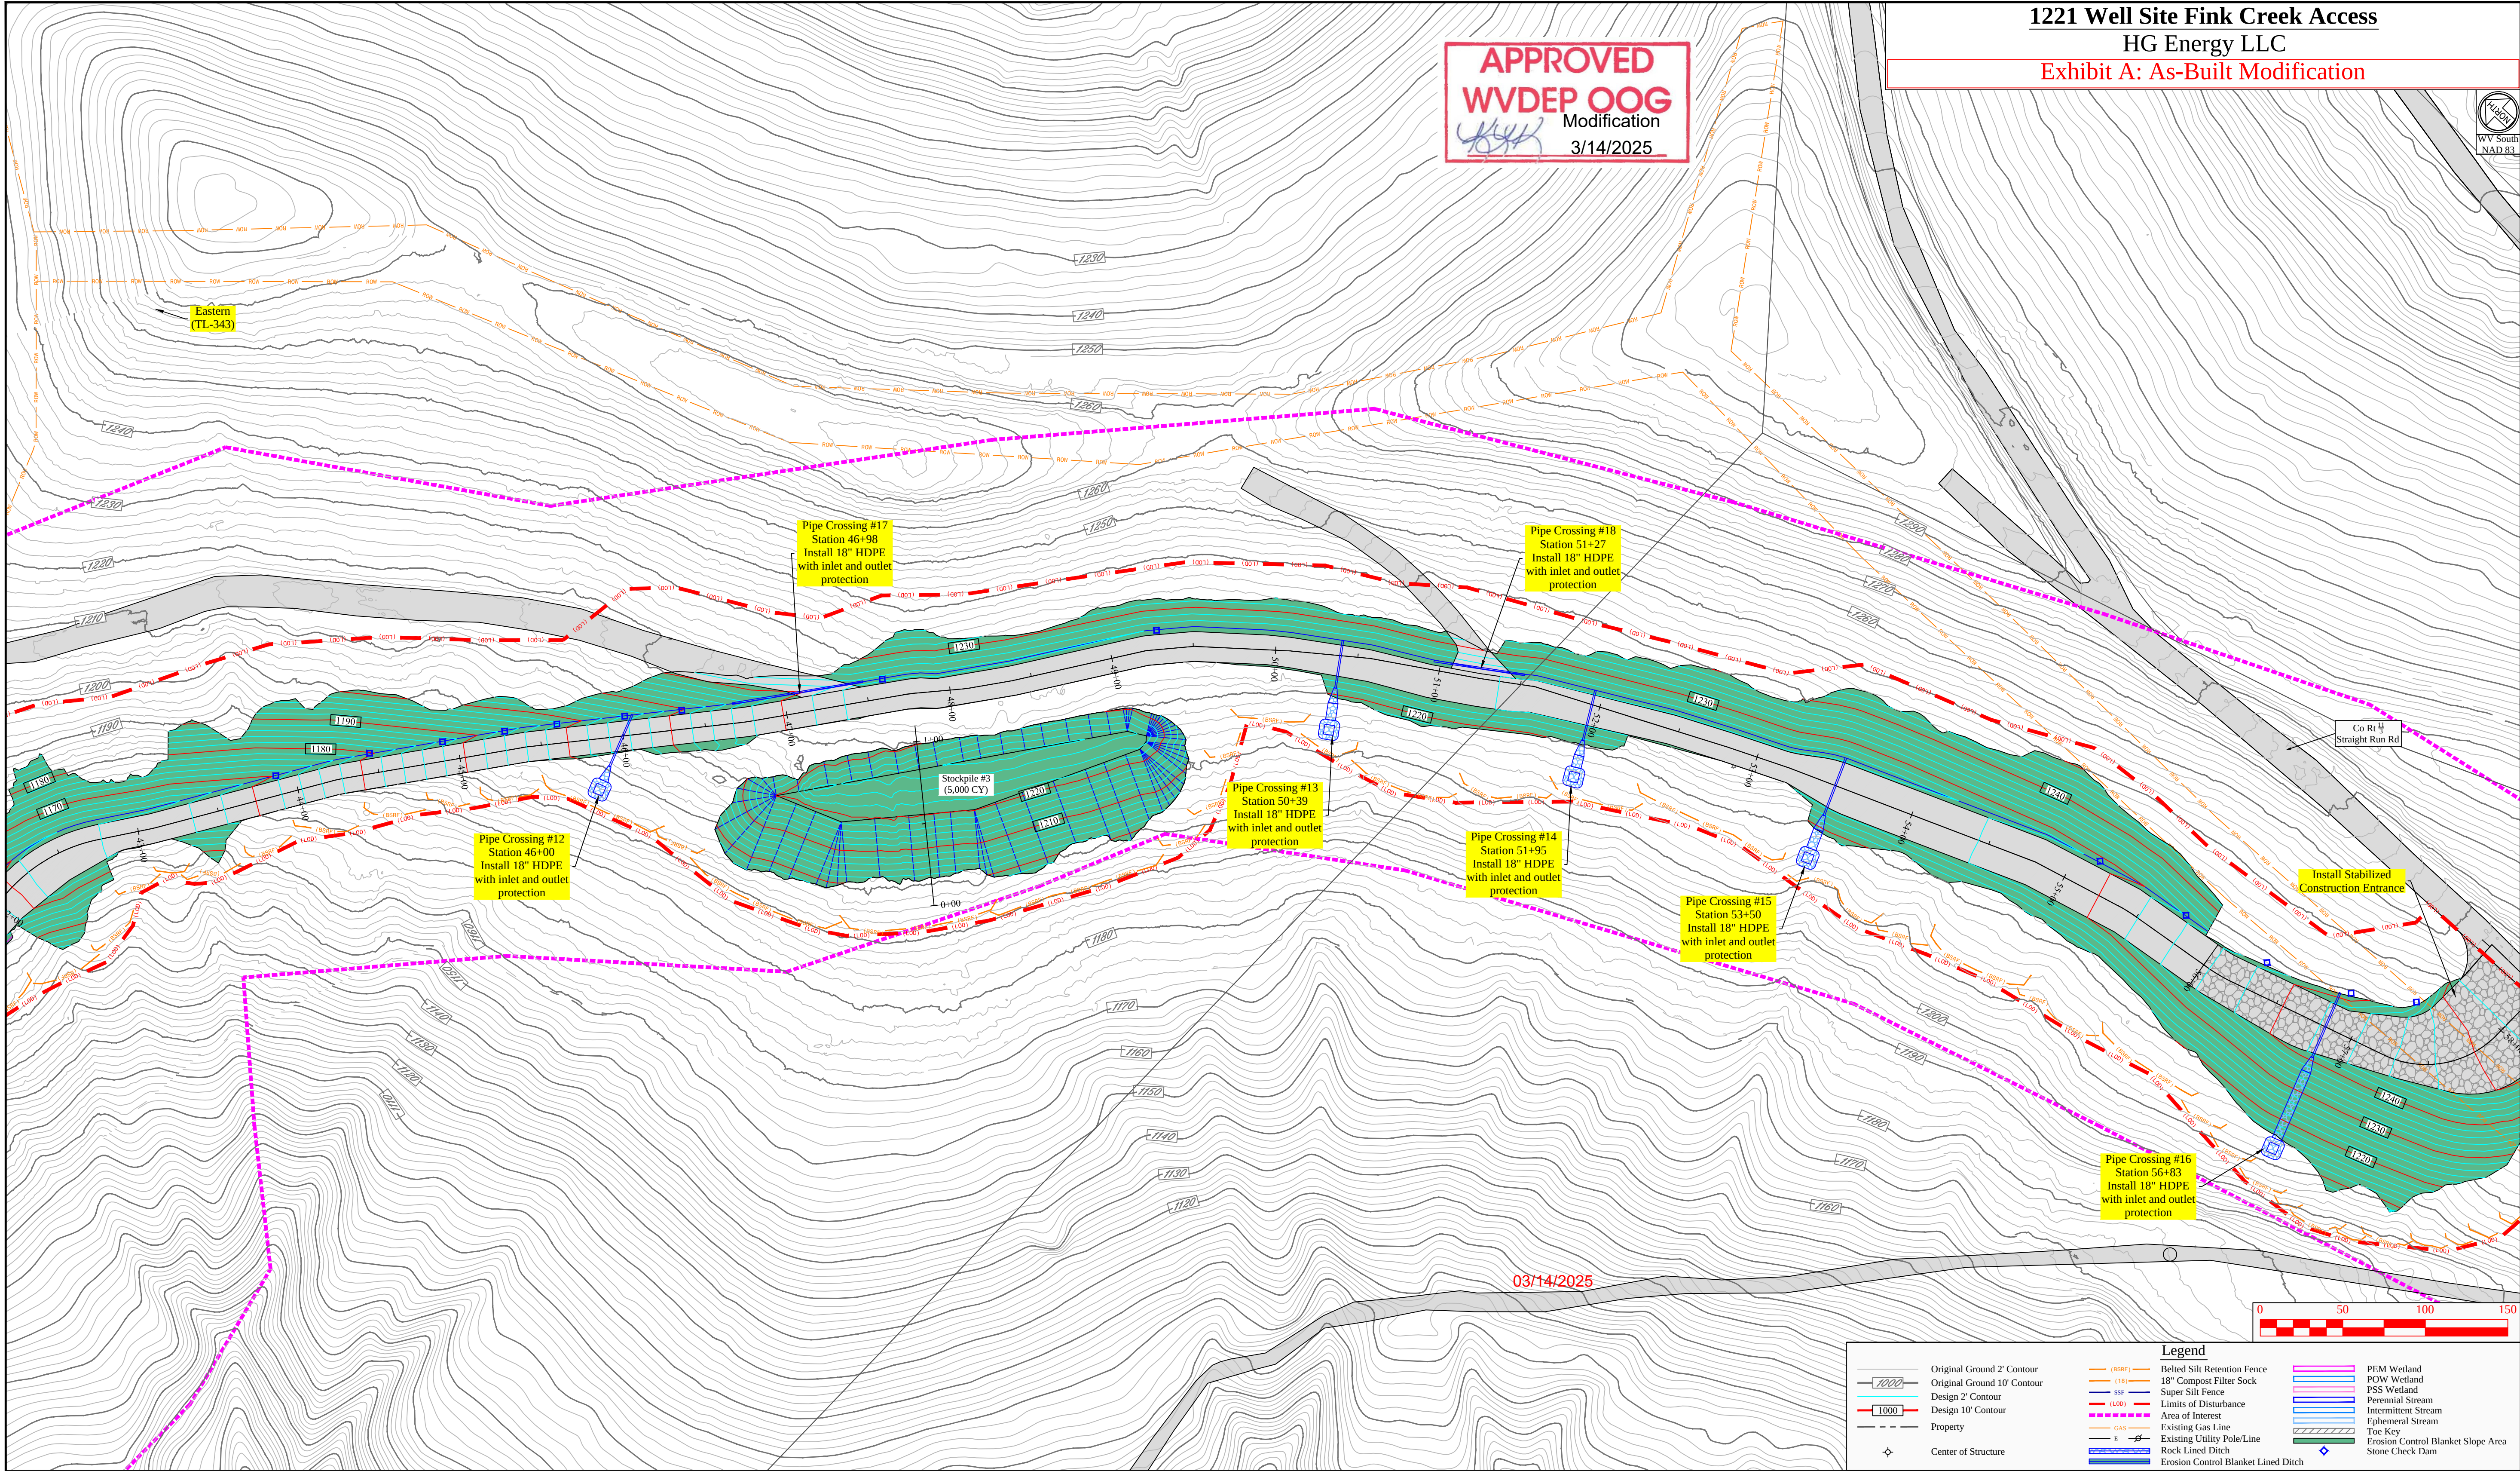

1221 Well Site Fink Creek Access
HG Energy LLC
Exhibit A: As-Built Modification

APPROVED
WVDEP OOG
Modification
3/14/2025

WV South
NAD83

Date
02-04-2025

Revision
Design

HG
ENERGY
LLC

THIS DOCUMENT
PREPARED FOR
HG ENERGY LLC



Kelly S
Surveying

1500 254
Dallan, WV 26039
304-338-0965

Site Plan - Fink Creek Access Road

1221 Well Site
Freemans Creek District
Lewis County, WV

Date: 02/04/2025
Scale: As Shown
Designed By: ZS
File No.
Sheet 22 of 32

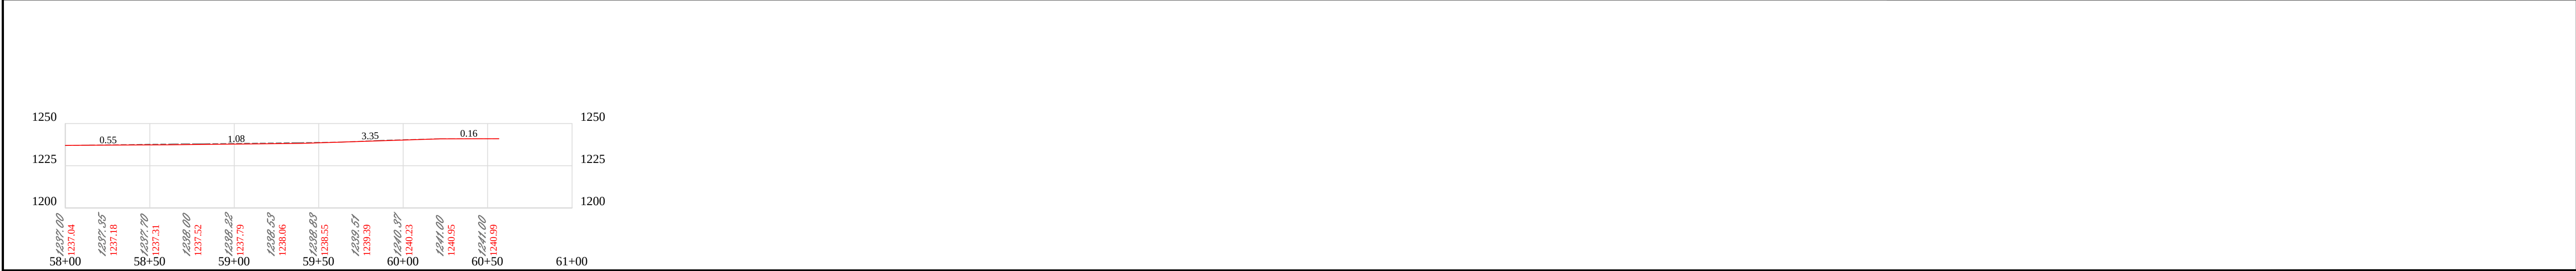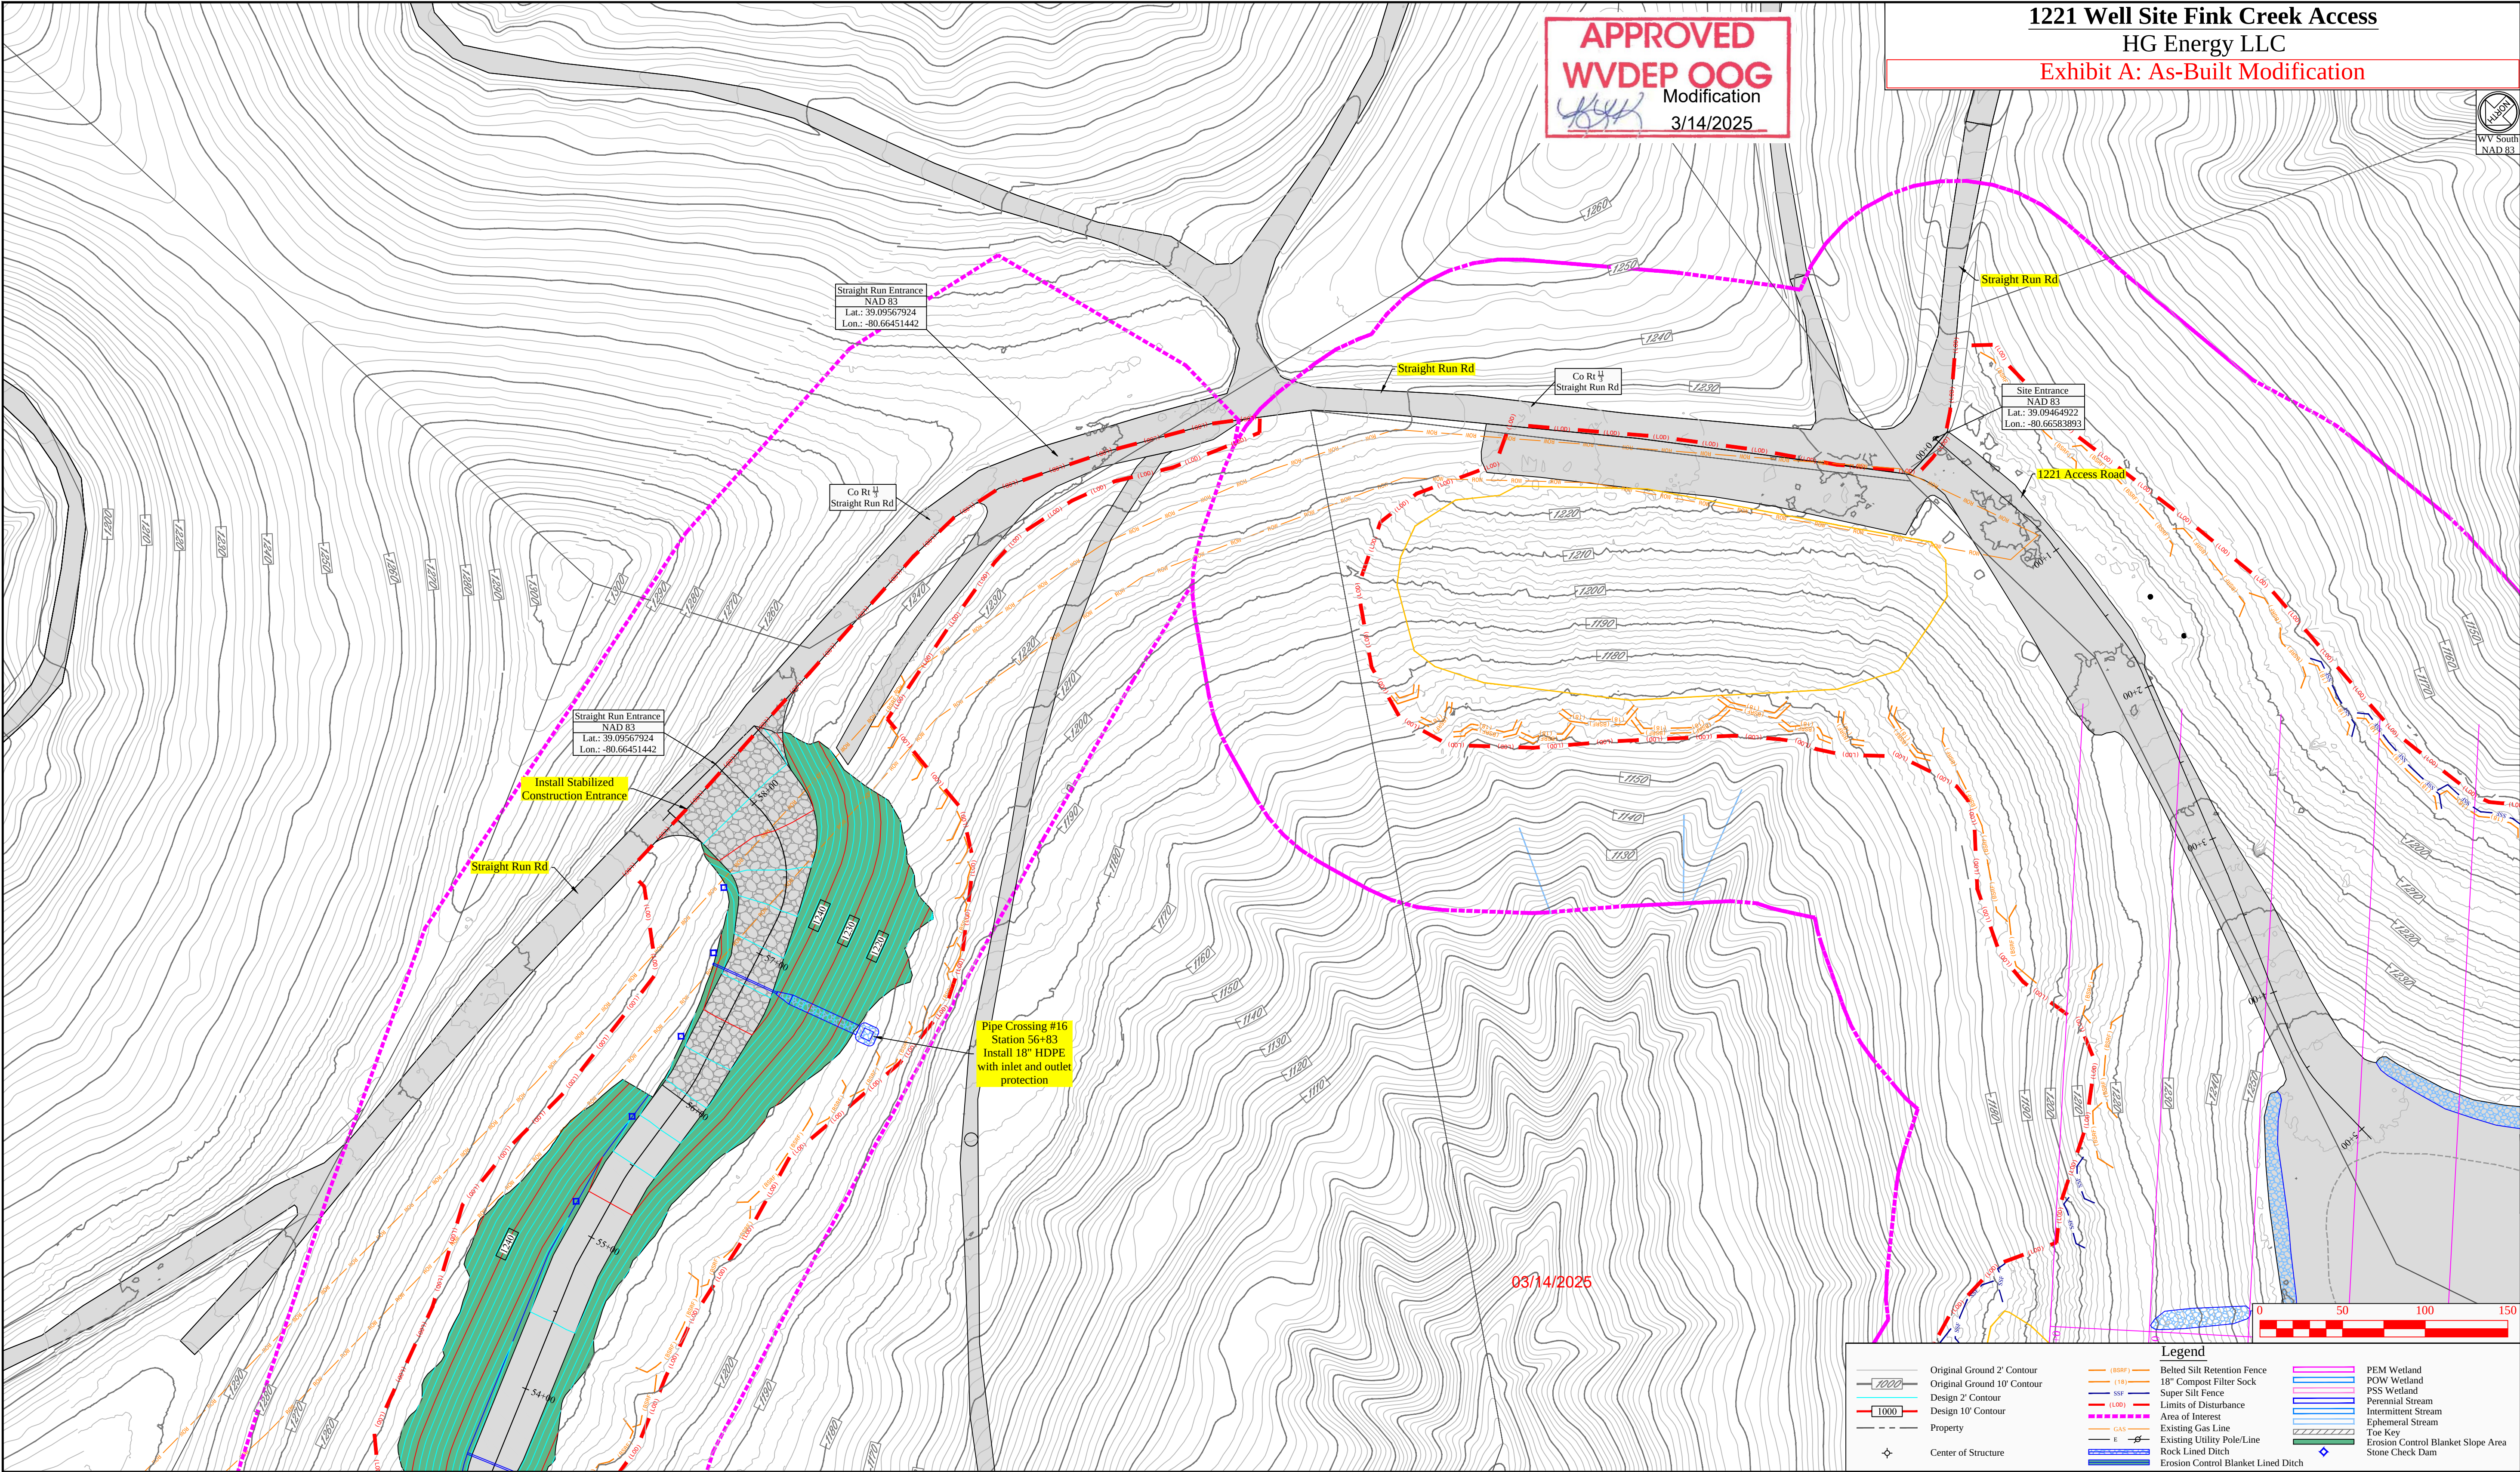

APPROVED
WVDEP OOG
Modification
3/14/2025

1221 Well Site Fink Creek Access
HG Energy LLC
Exhibit A: As-Built Modification

WV South
NAD 83

Revision
Design

Date
02-04-2025





THIS DOCUMENT
PREPARED FOR
HG ENERGY LLC

Kelly Surveying
P.O. Box 254
Dallman, WV 26029
(304) 338-0965


Site Plan - Fink Creek Access Road
1221 Well Site
Freemans Creek District
Lewis County, WV

Date: 02/04/2025
Scale: As Shown
Designed By: ZS
File No.
Sheet 23 of 32

APPROVED
WVDEP OOG
Modification
3/14/2025

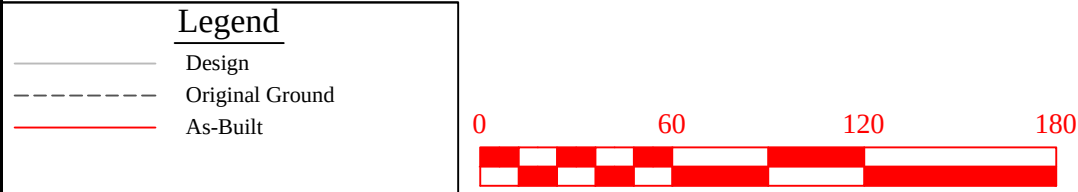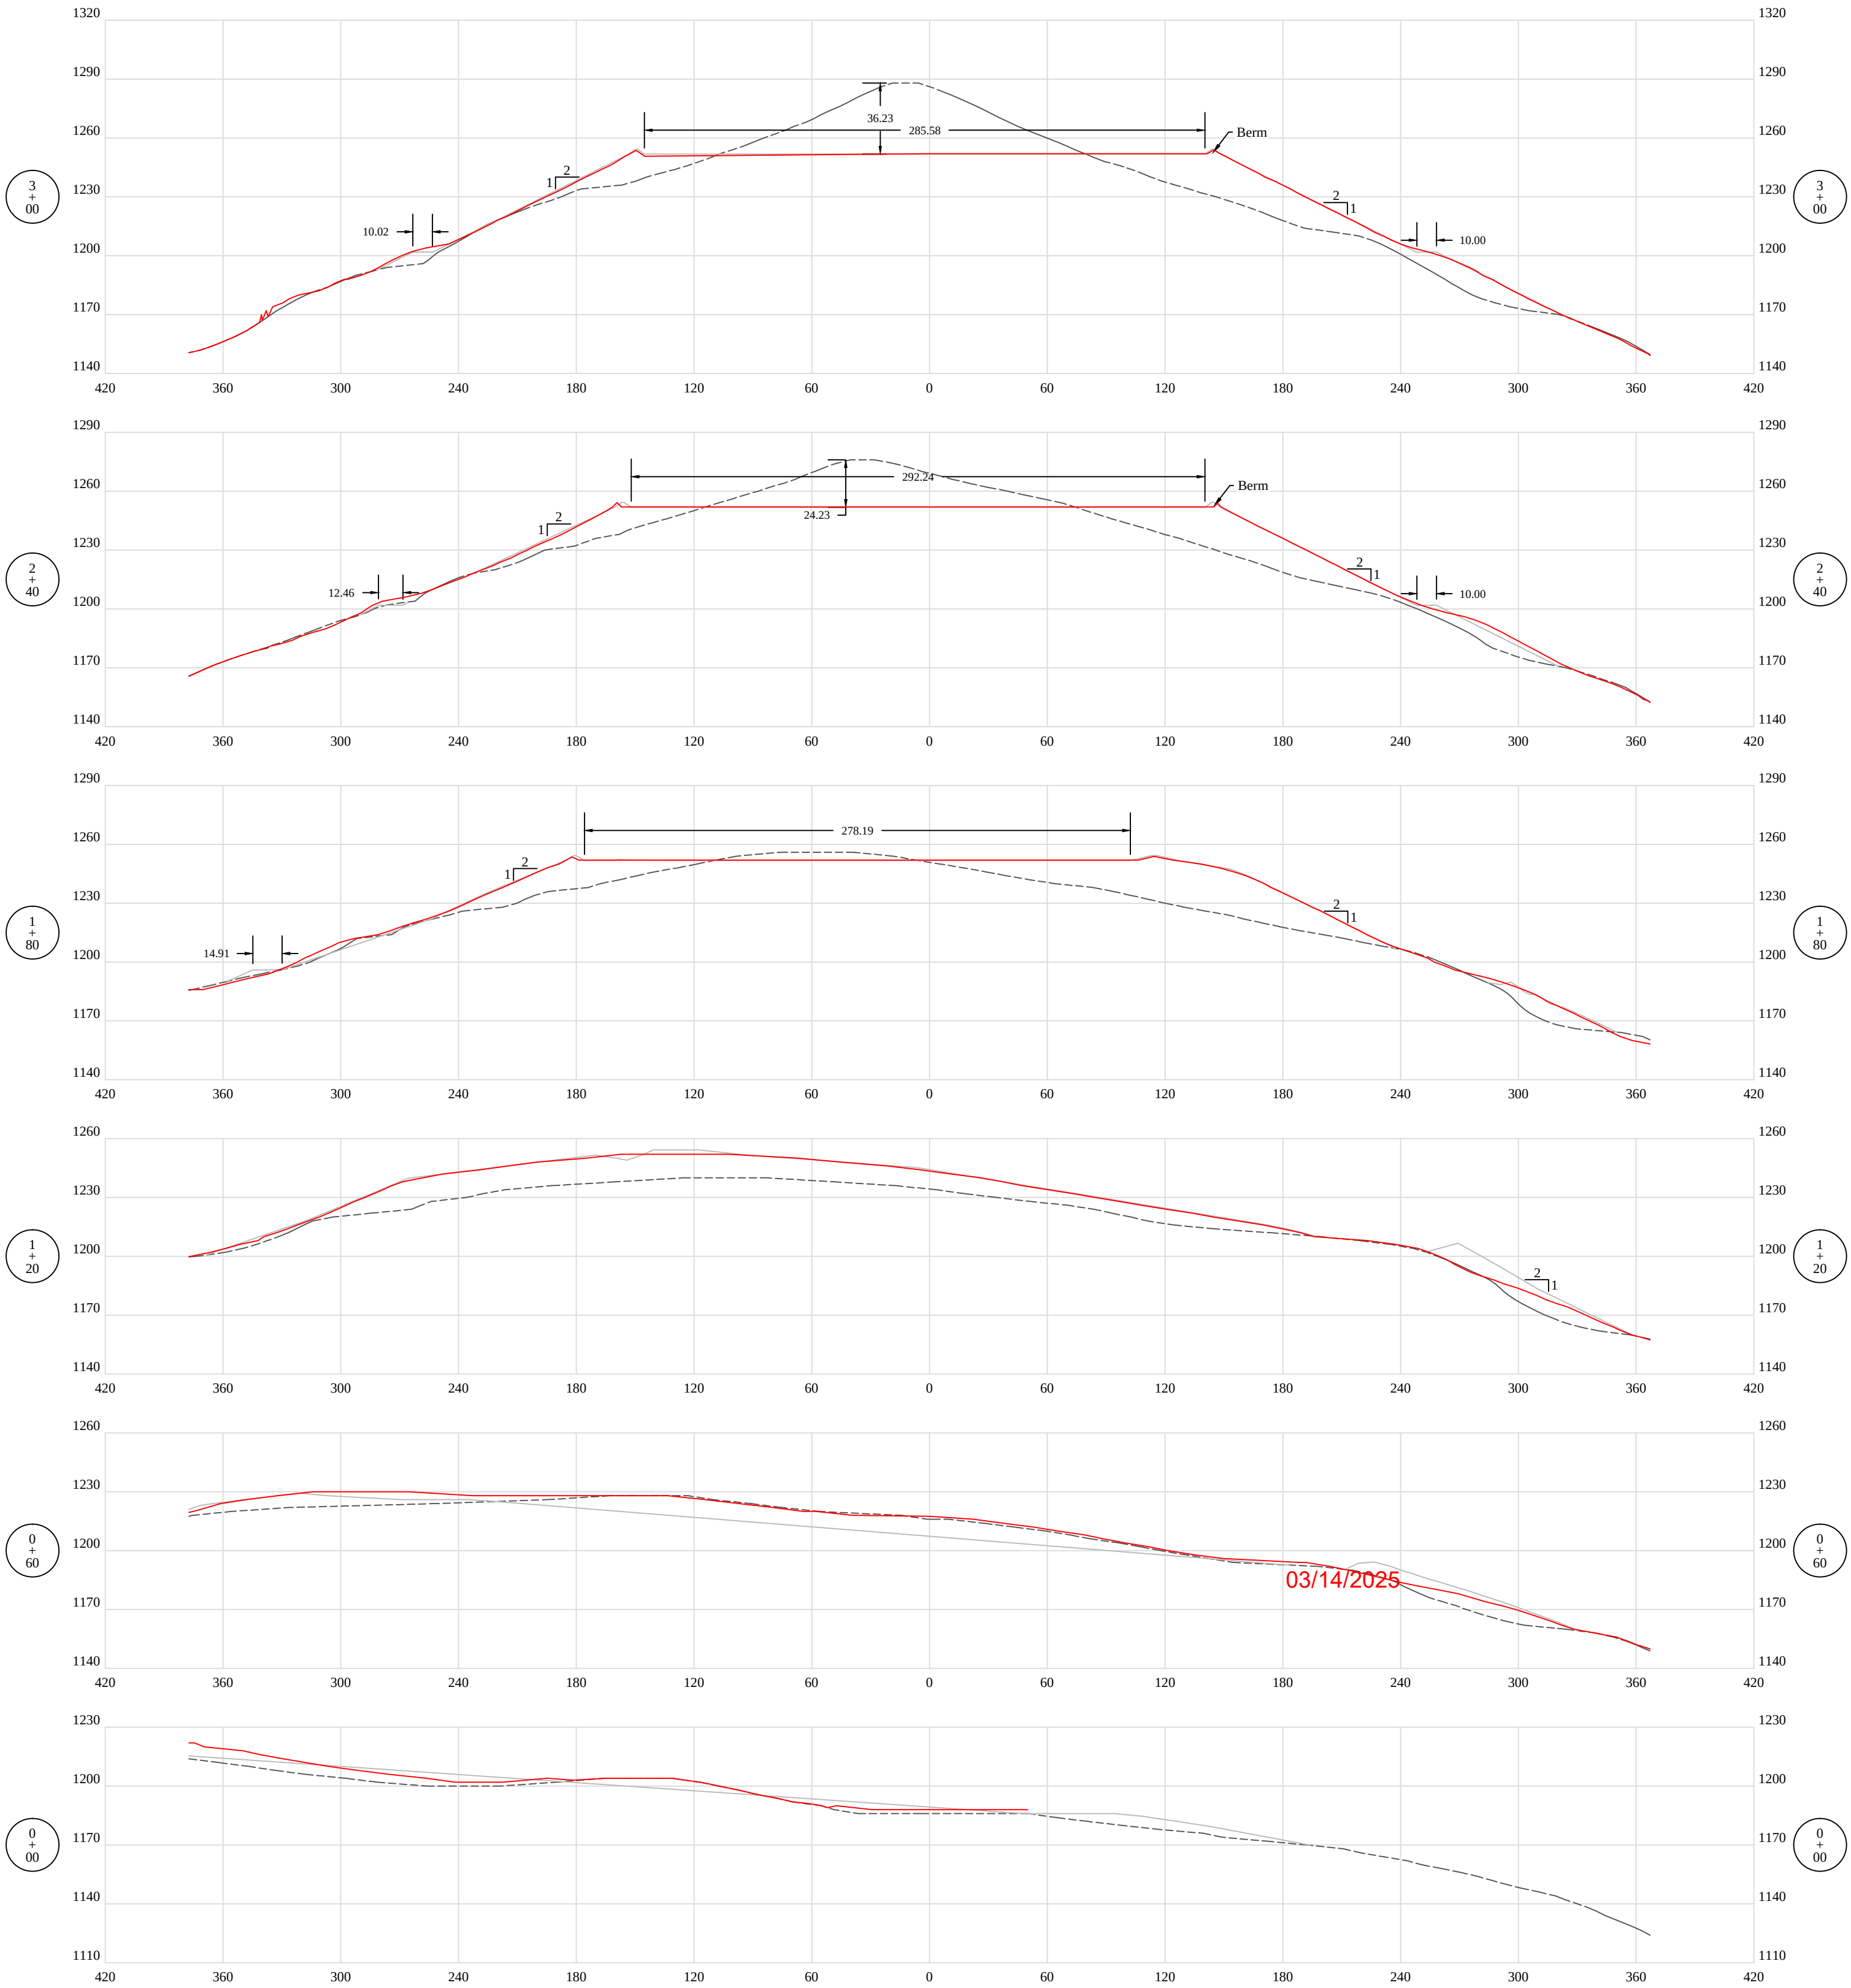

APPROVED
WVDEP OOG
Modification
3/14/2025

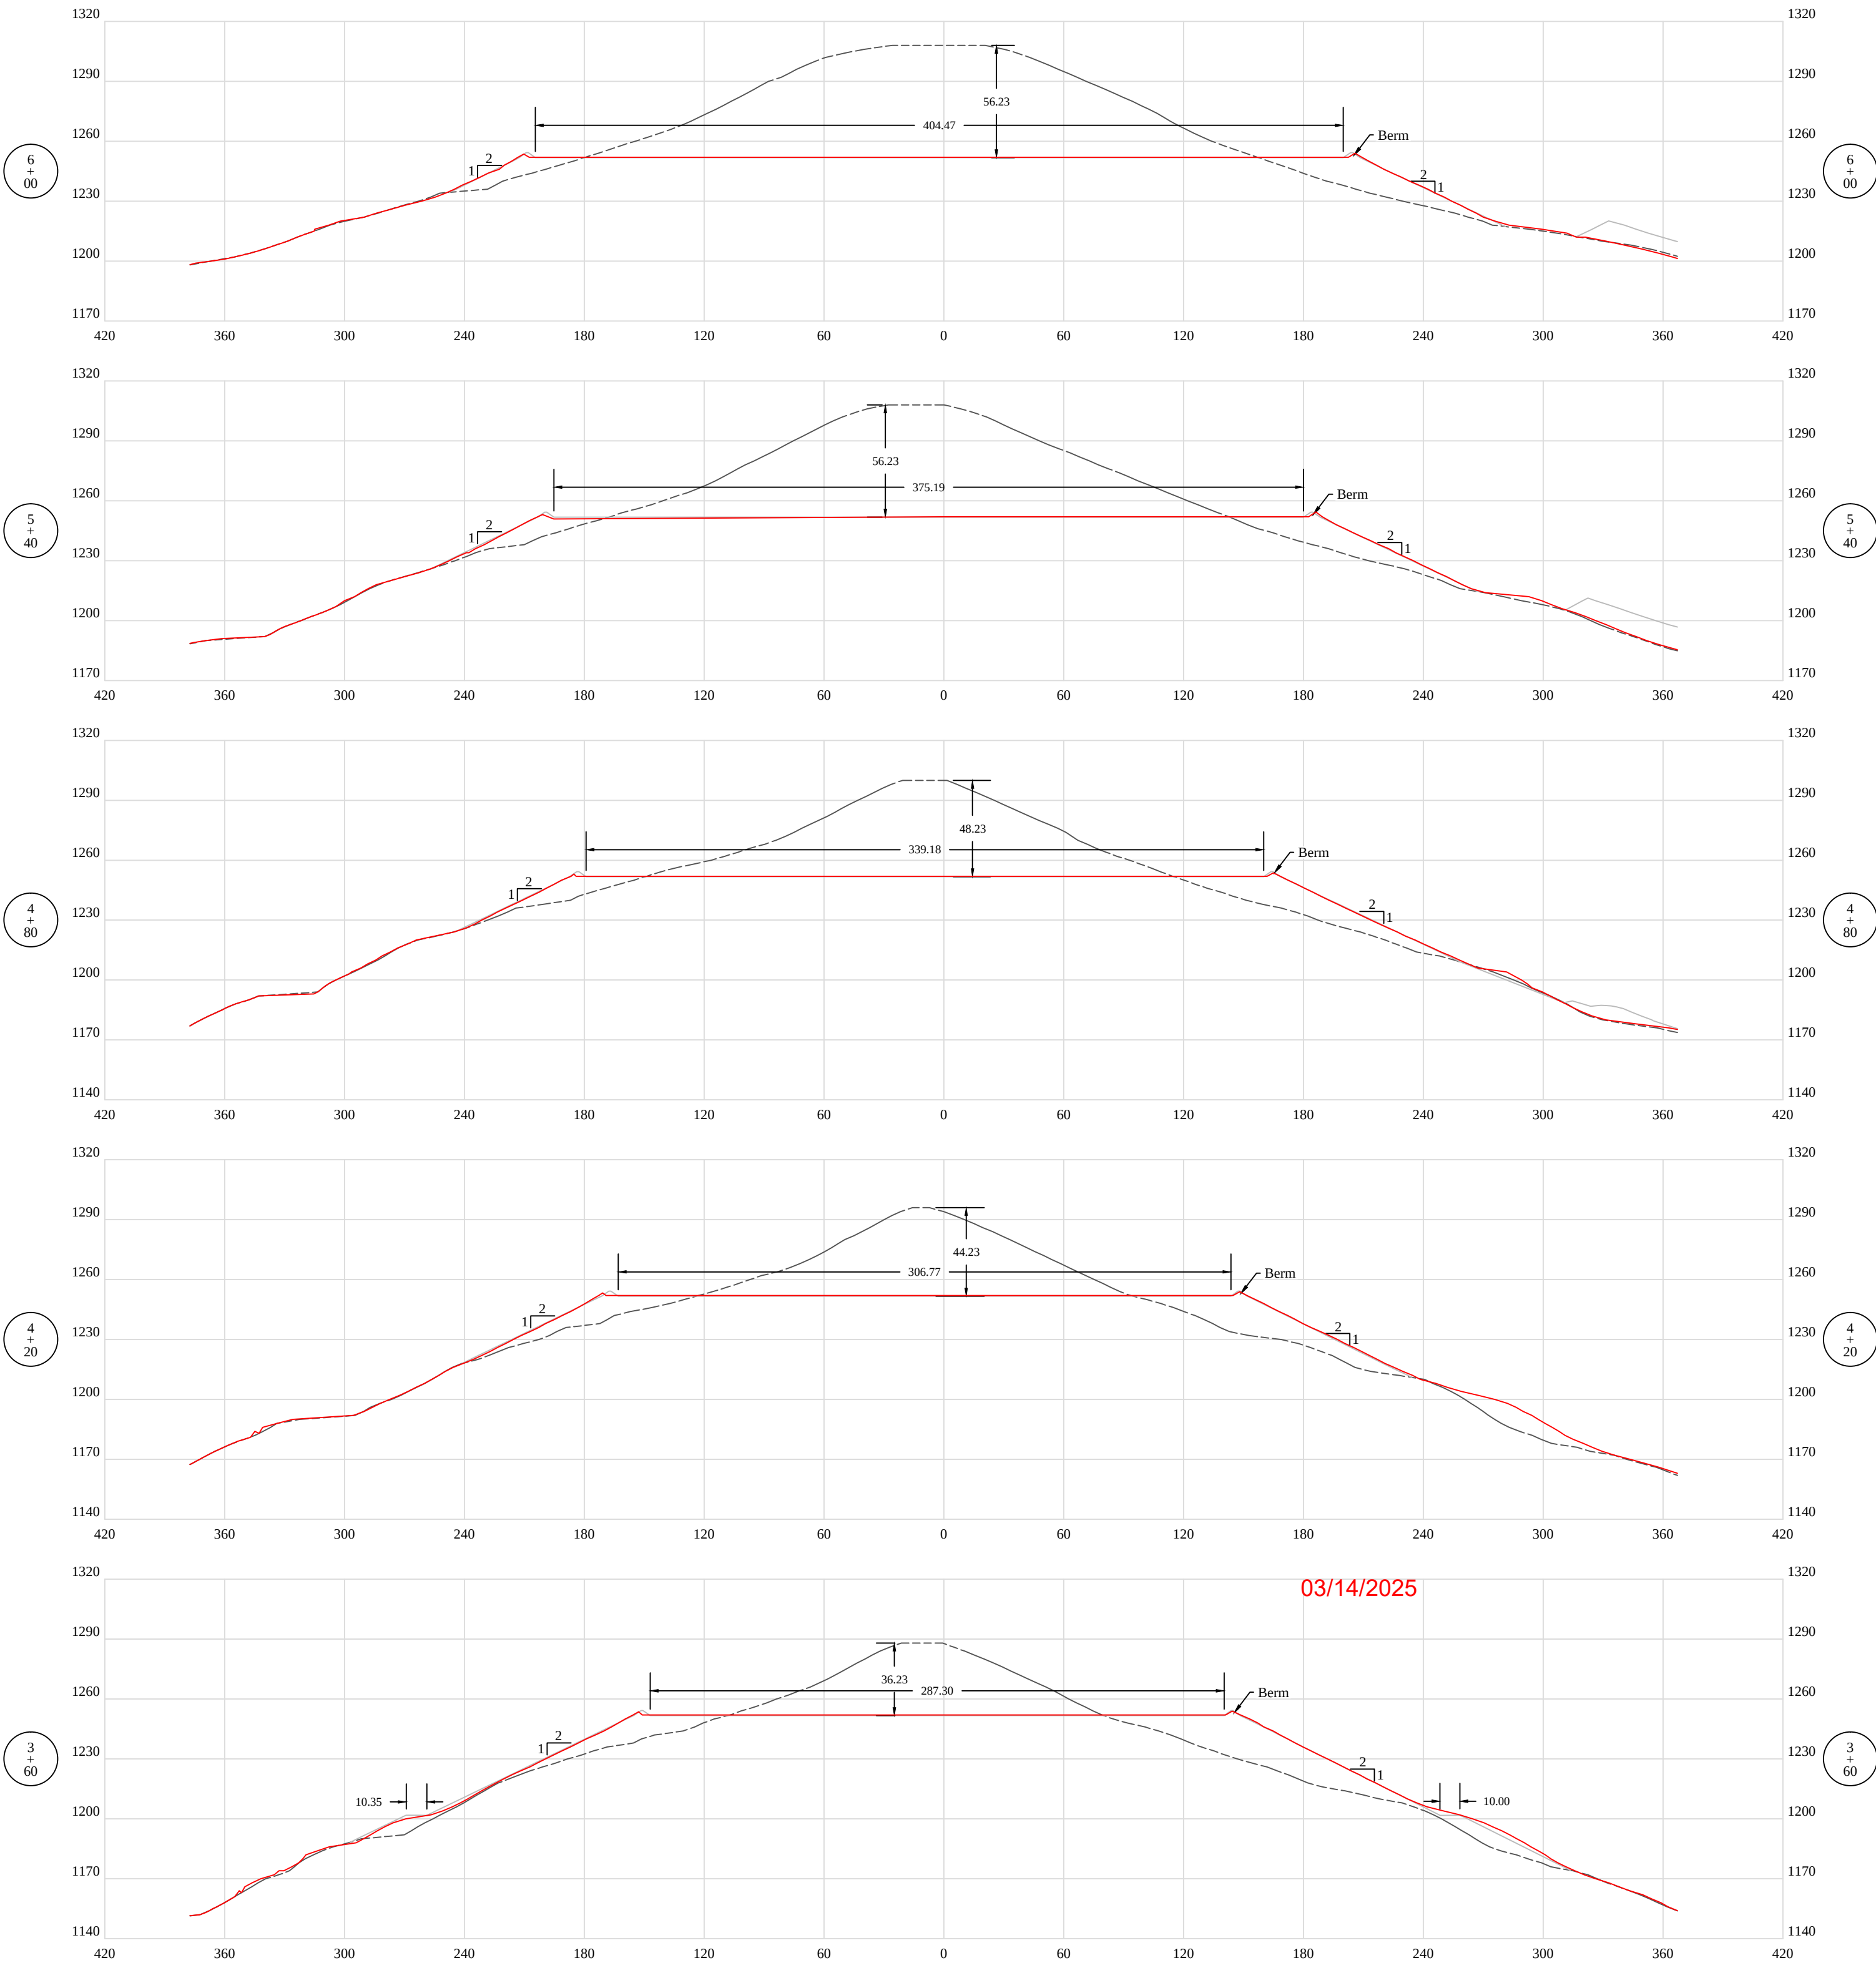

Legend	
	Design
	Original Ground
	As-Built


Date	02-04-2025
Revision	Design
THIS DOCUMENT PREPARED FOR HG ENERGY LLC	
 P.O. Box 254 Delmar, WV 26039 (304)338-0985	
Cross Sections - Well Pad 1221 Well Site Freemans Creek District Lewis County, WV	
Date: 02/04/2025	
Scale: As Shown	
Designed By: ZS	
File No.	
Sheet 25 of 32	

1221 Well Site Fink Creek Access

HG Energy LLC

Exhibit A: As-Built Modification

APPROVED
WVDEP OOG
Modification
3/14/2025

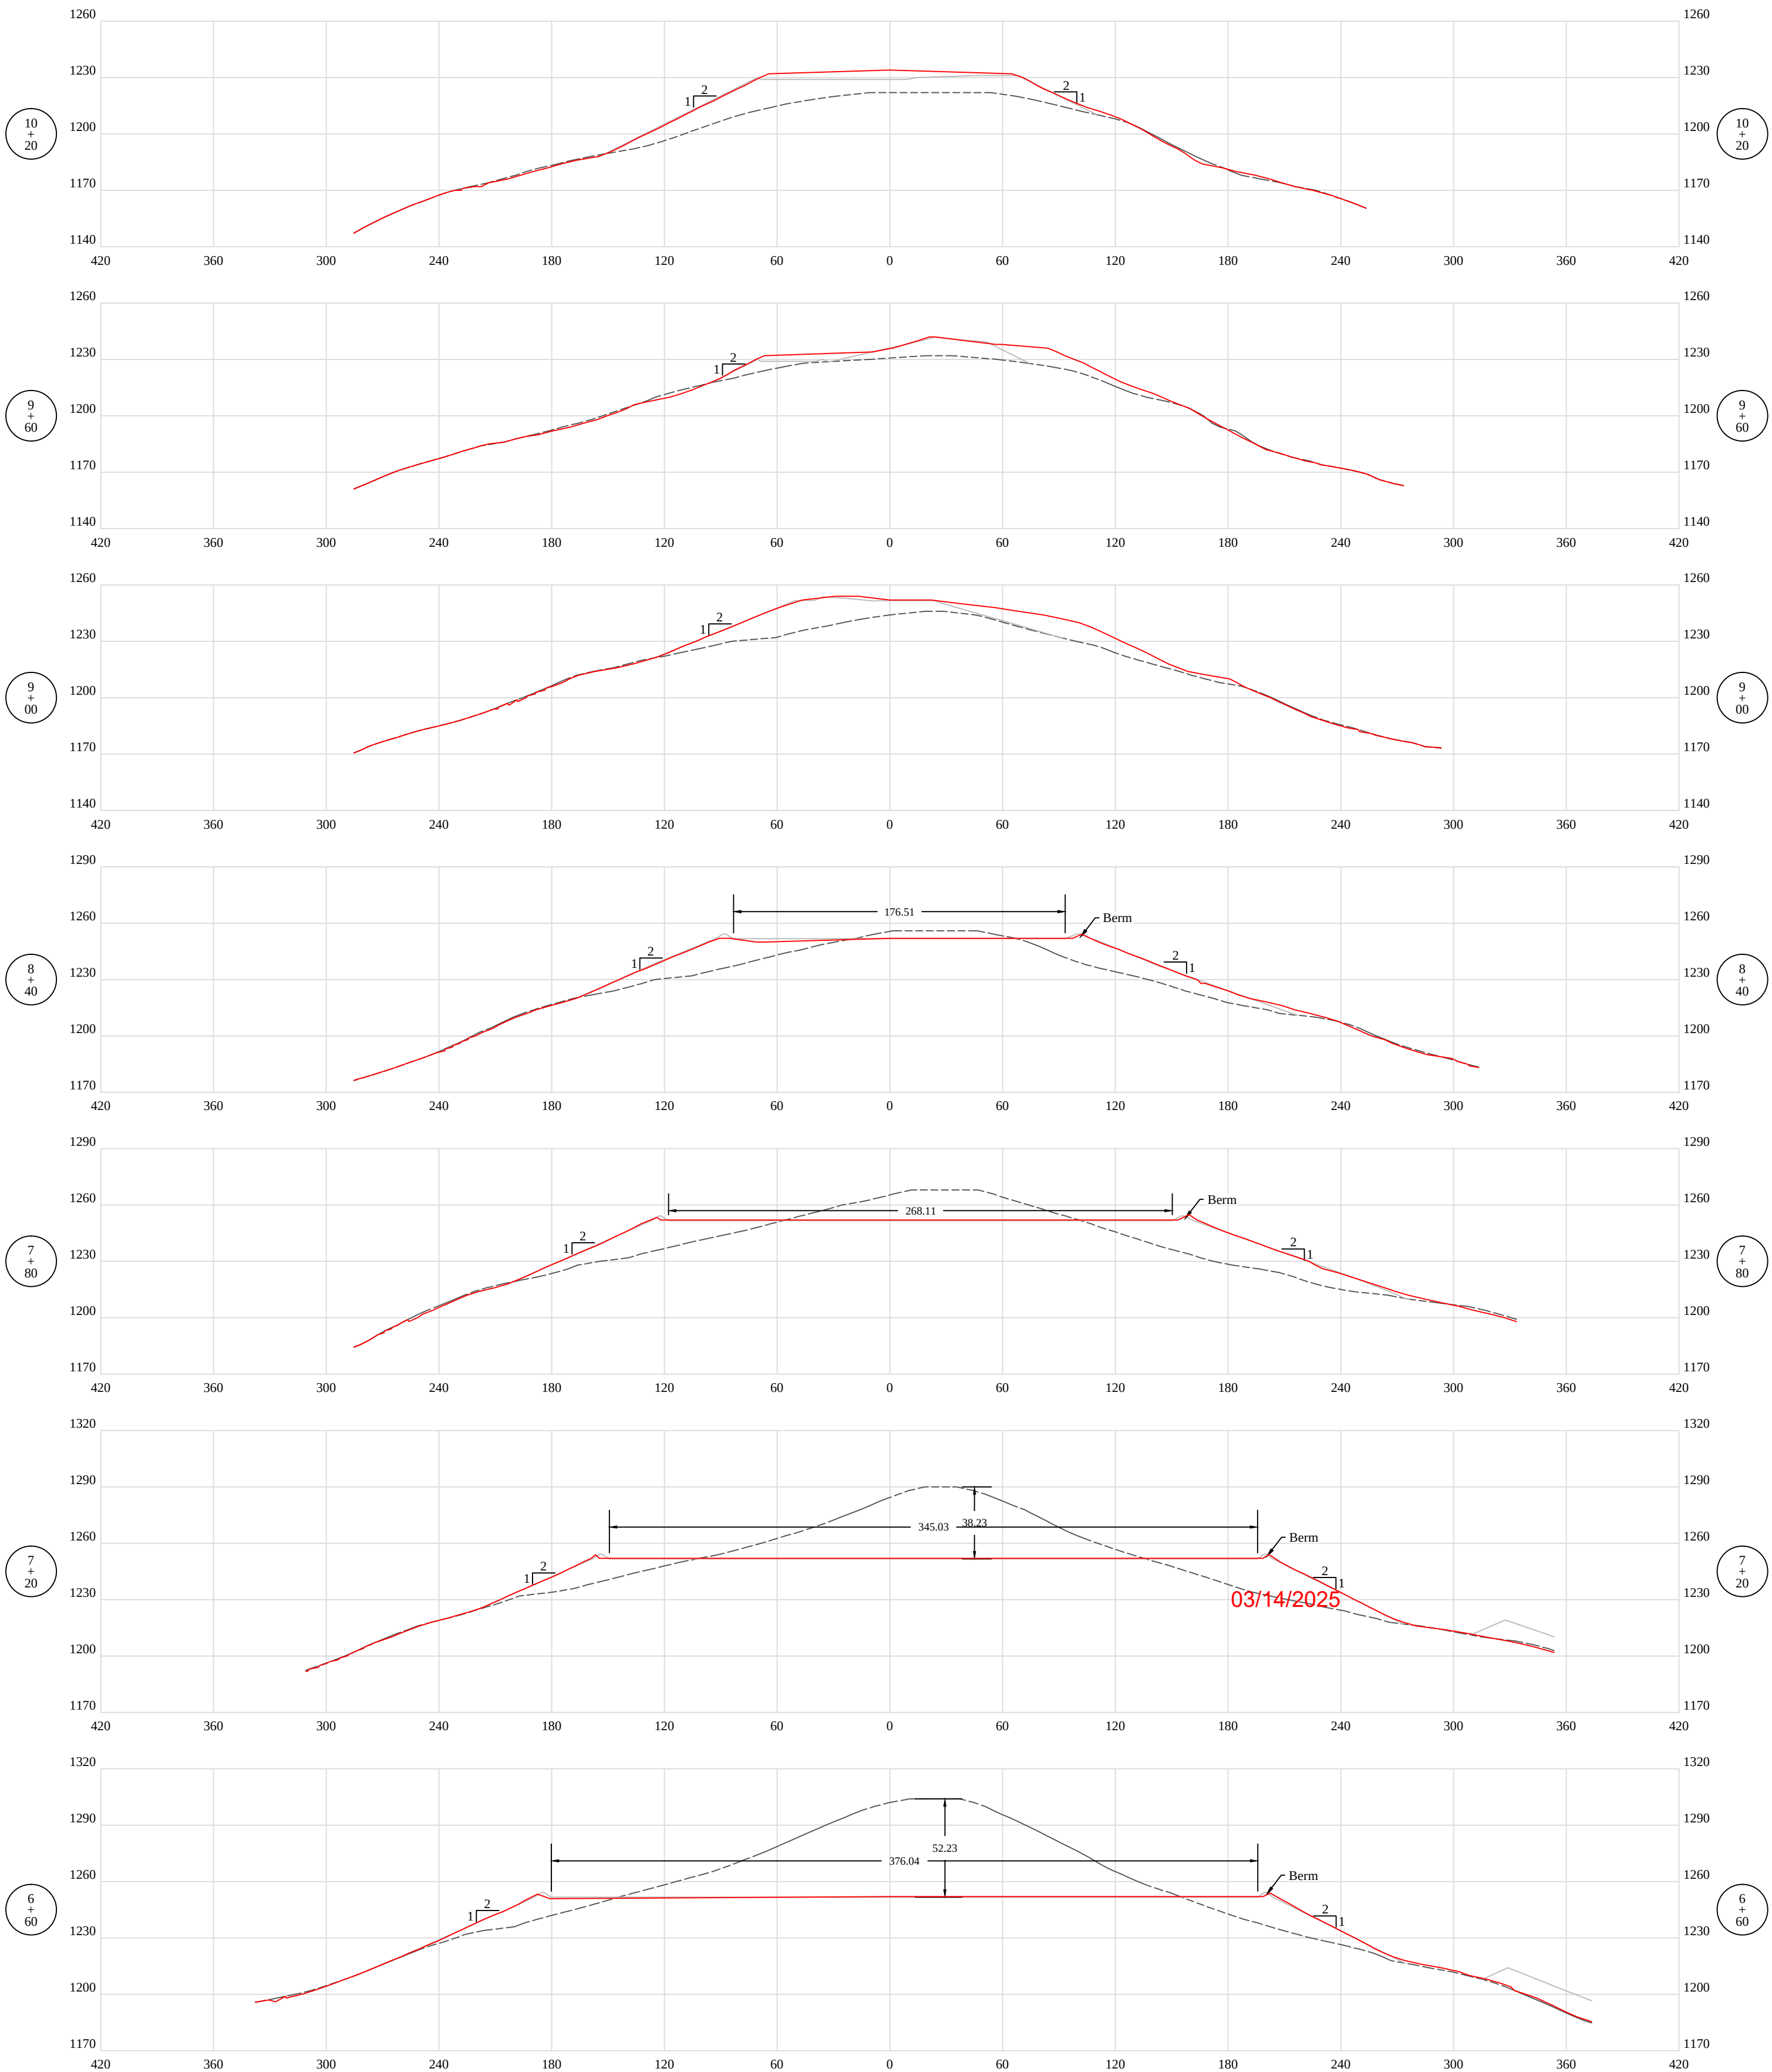

Legend

- Design
- Original Ground
- As-Built



Revision
Design

Date
02-04-2025



THIS DOCUMENT
PREPARED FOR
HG ENERGY LLC





Cross Sections - Well Pad
1221 Well Site
Freemans Creek District
Lewis County, WV

Date: 02/04/2025
Scale: As Shown
Designed By: ZS
File No.
Sheet 26 of 32

1221 Well Site Fink Creek Access

HG Energy LLC

Exhibit A: As-Built Modification

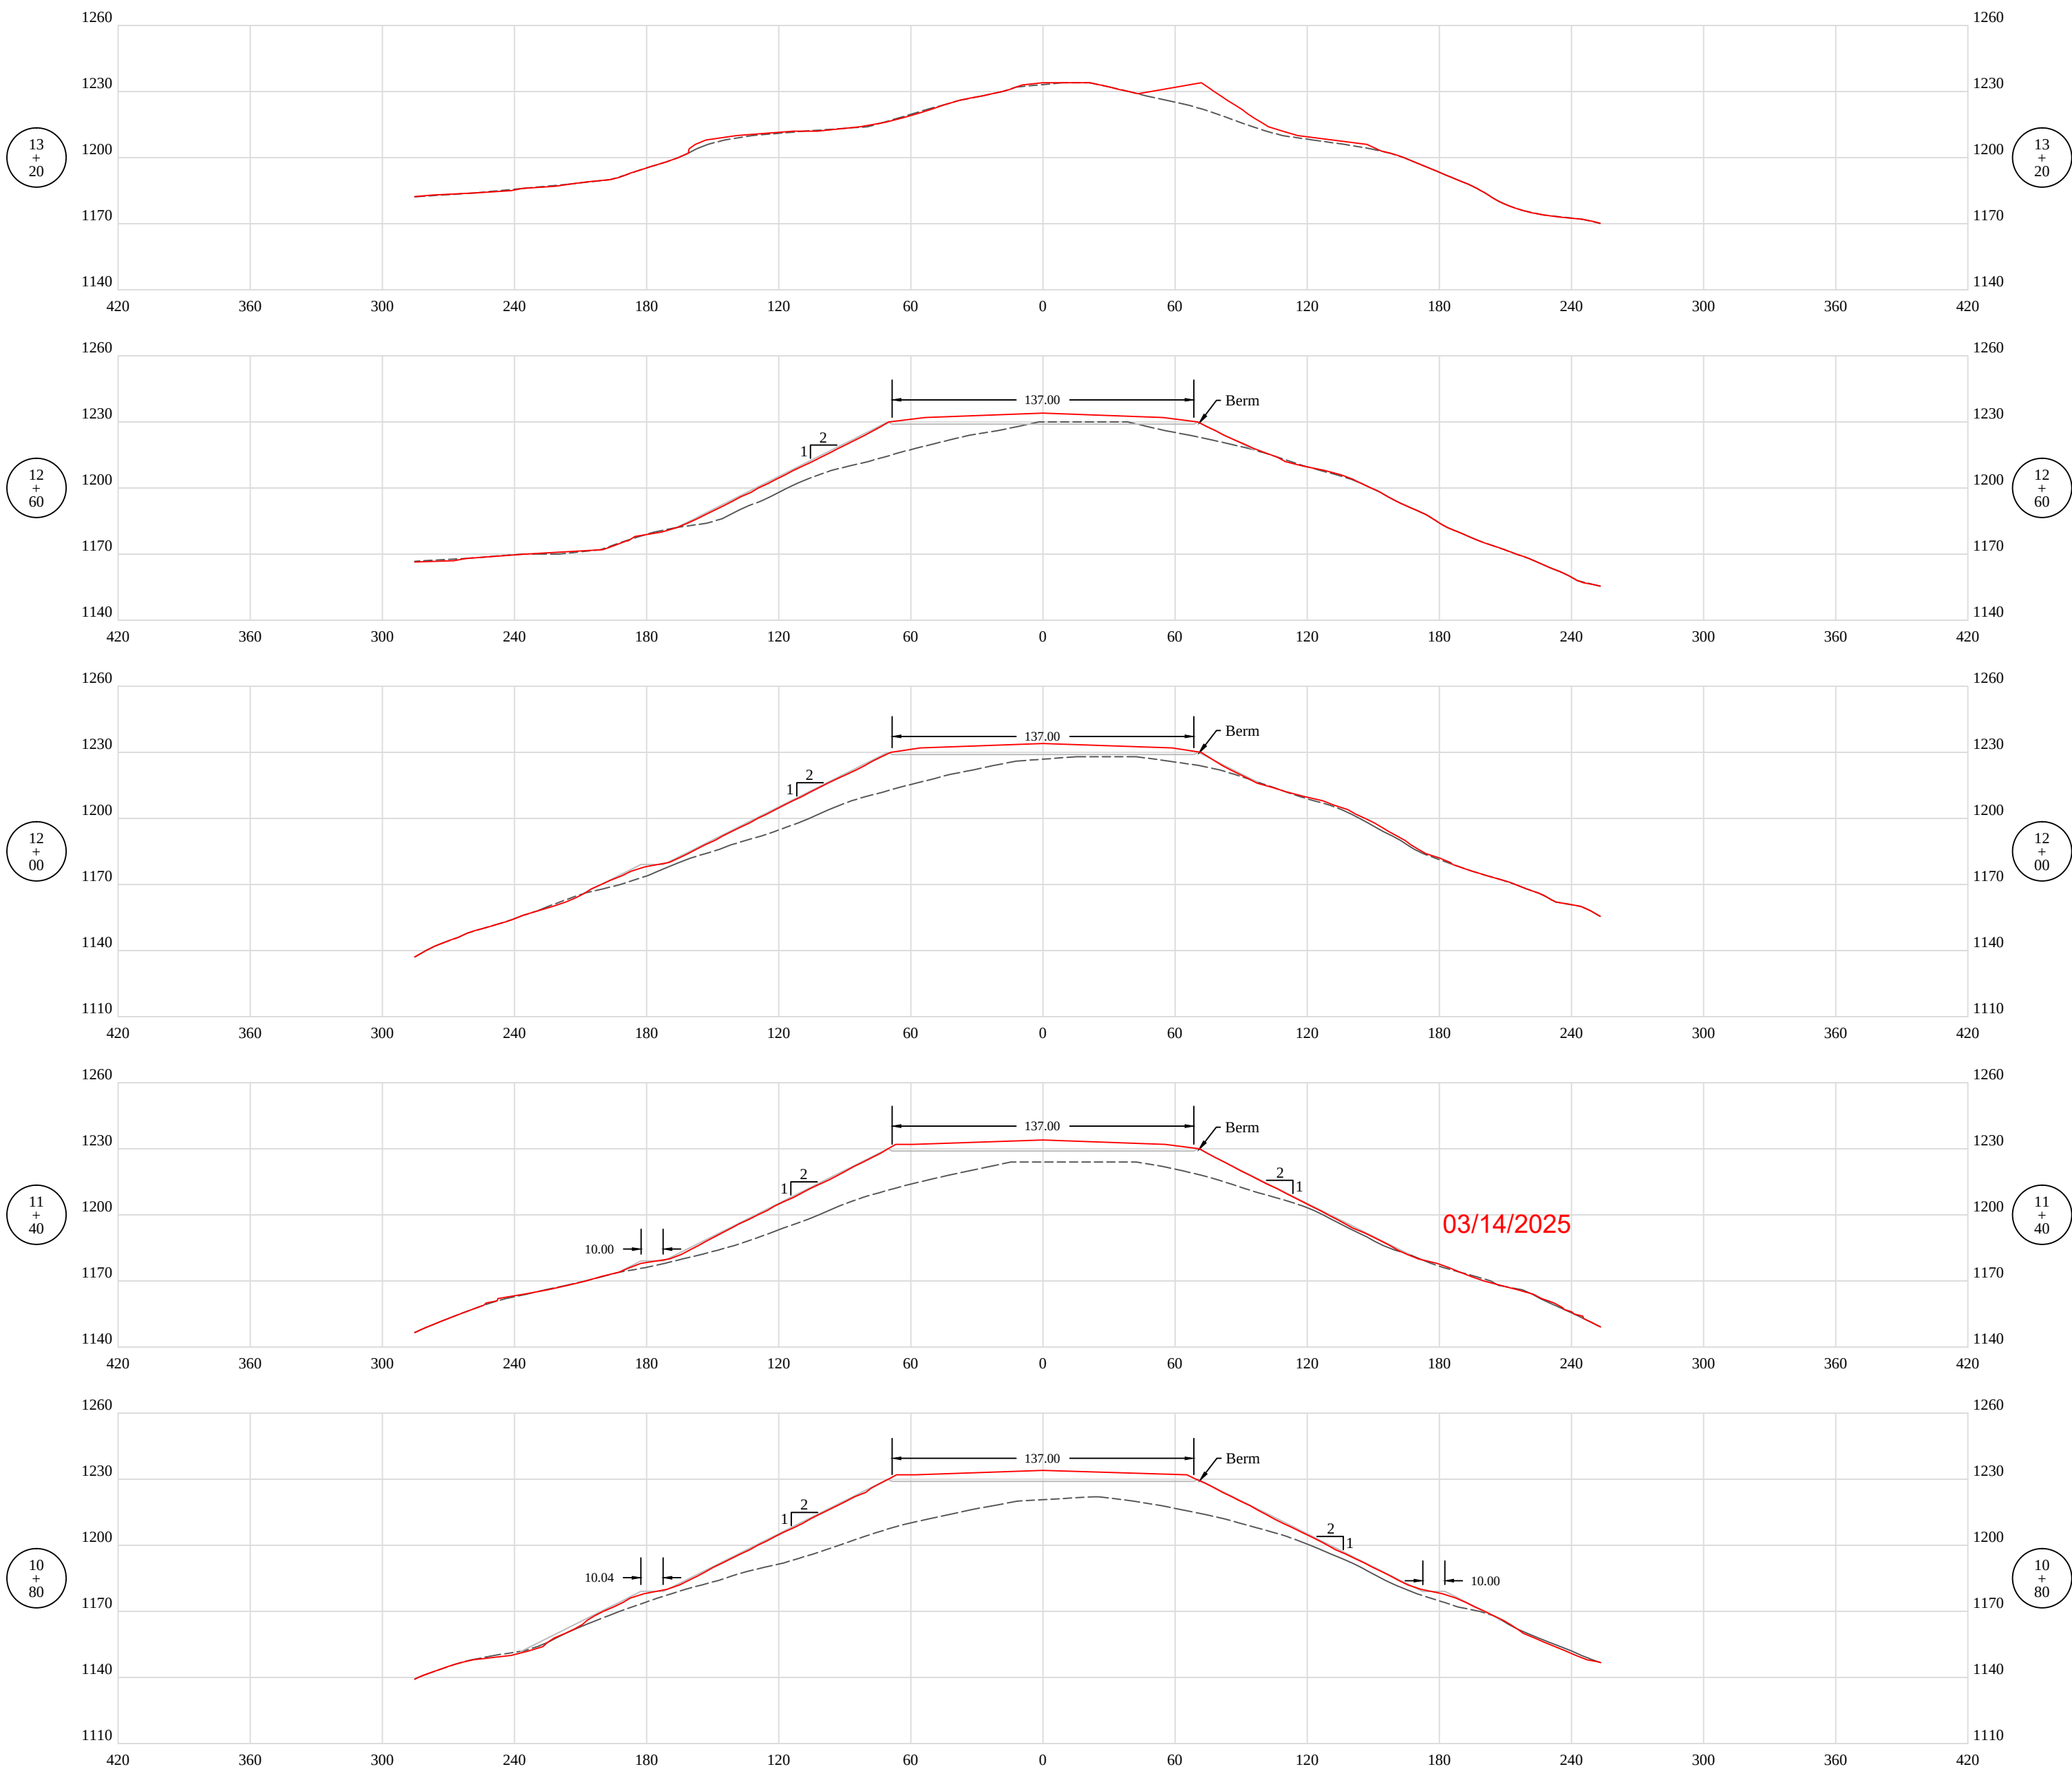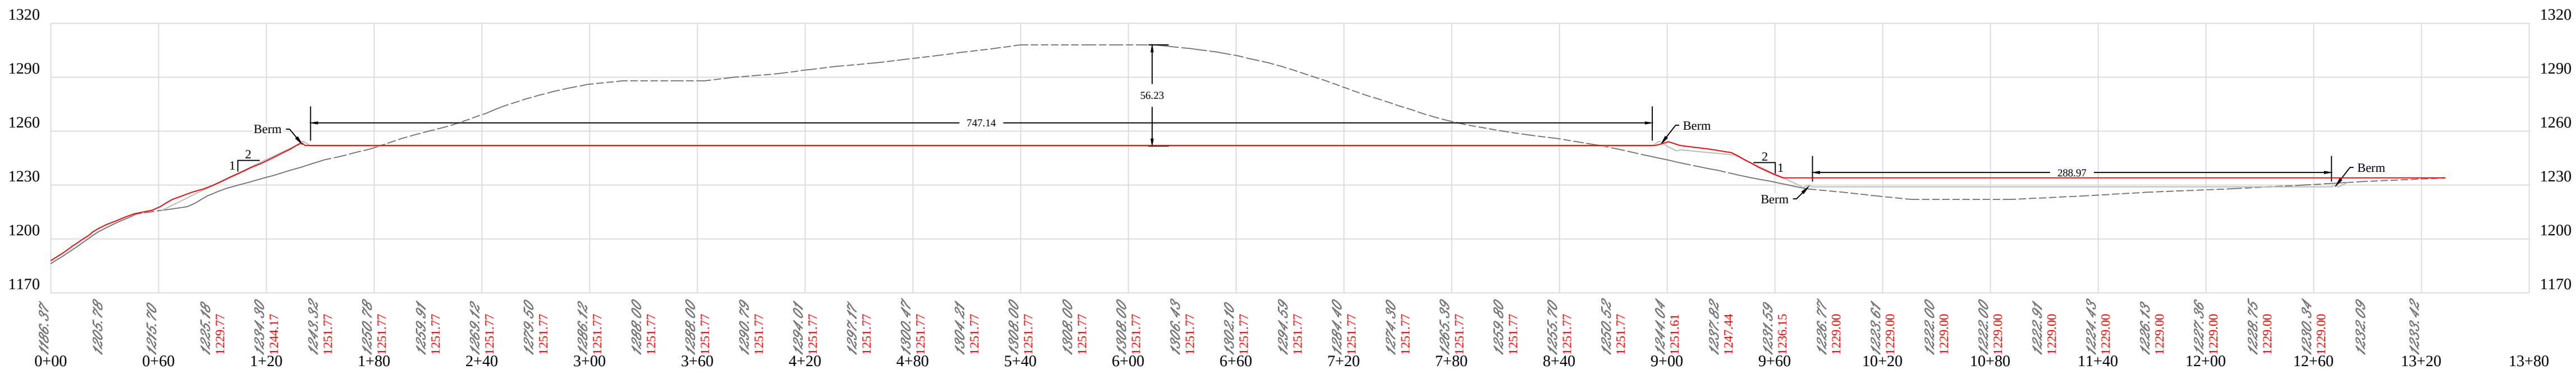

Legend

- Design
- Original Ground
- As-Built

Revision
Design

Date
02-04-2025











THIS DOCUMENT
PREPARED FOR
HG ENERGY LLC




Cross Sections - Well Pad
1221 Well Site
Freemans Creek District
Lewis County, WV












Date: 02/04/2025
Scale: As Shown
Designed By: ZS
File No.
Sheet 27 of 32

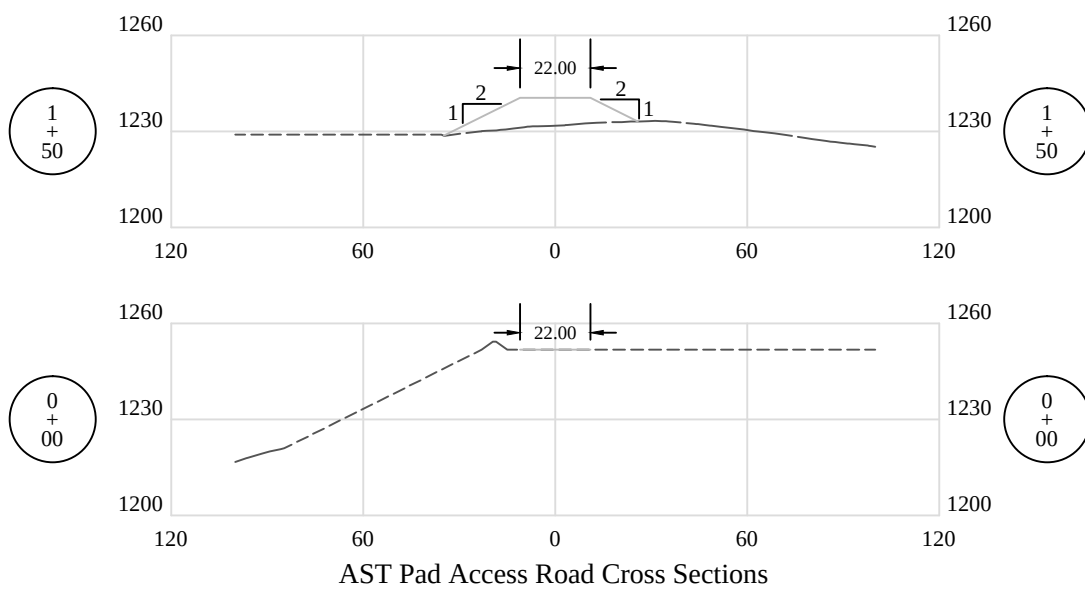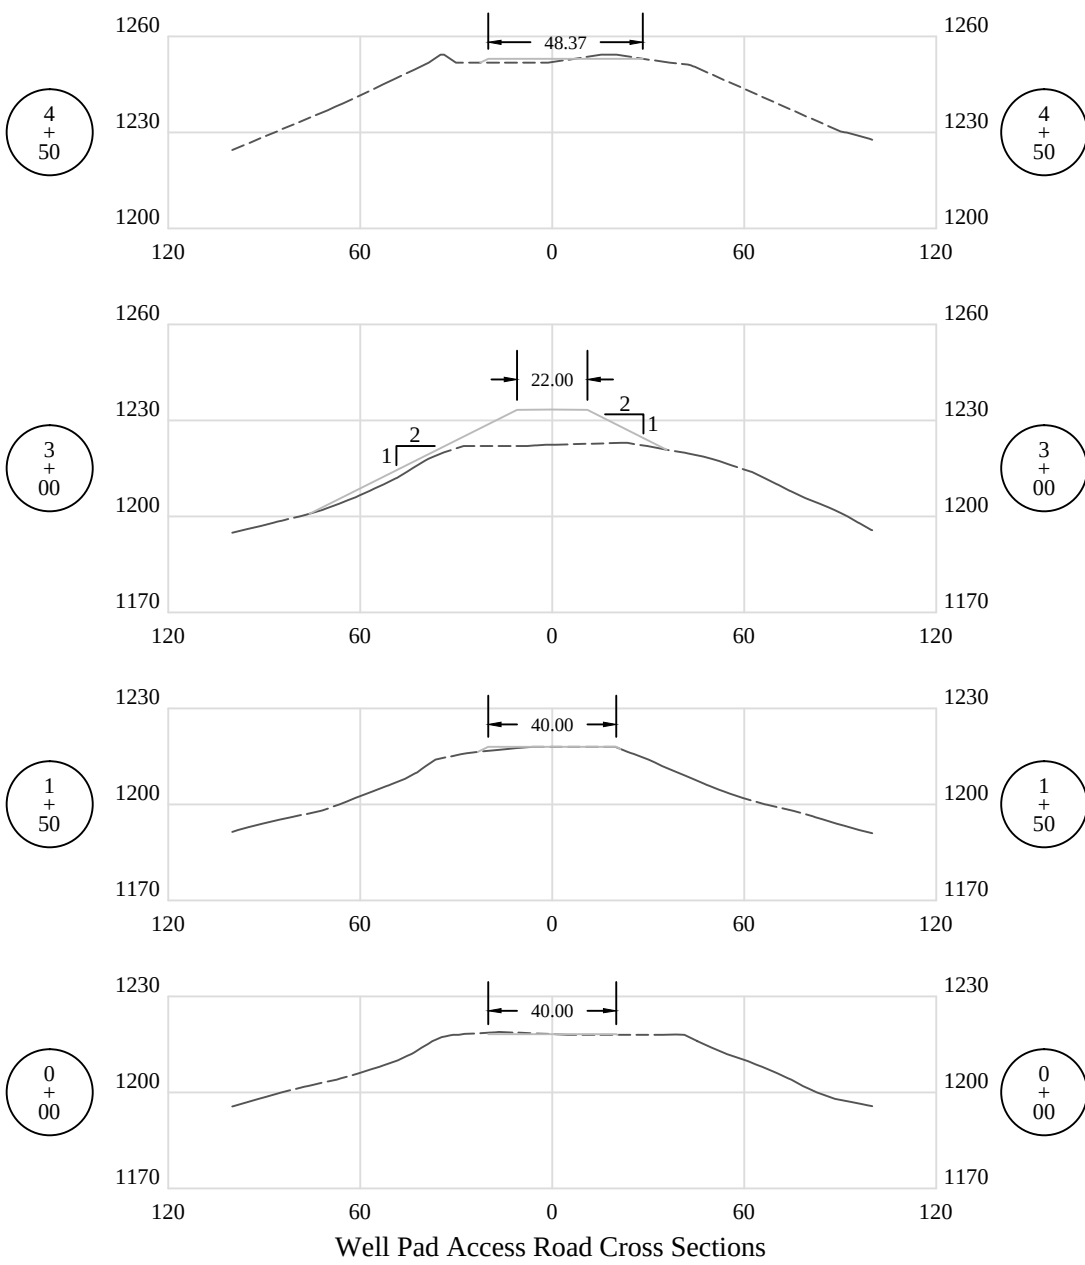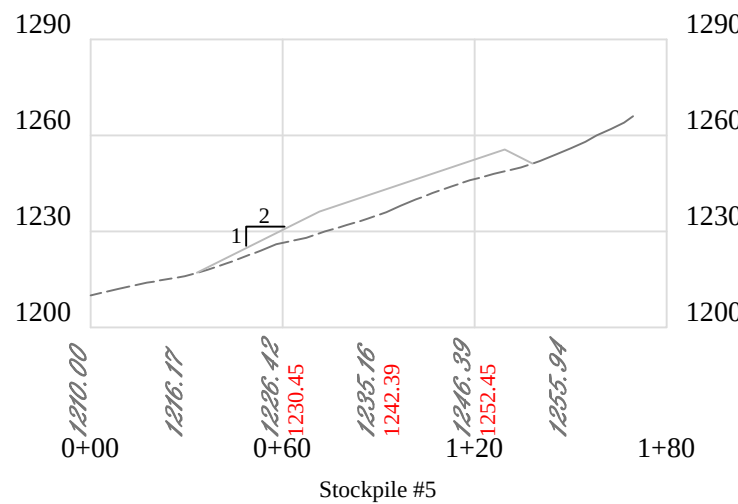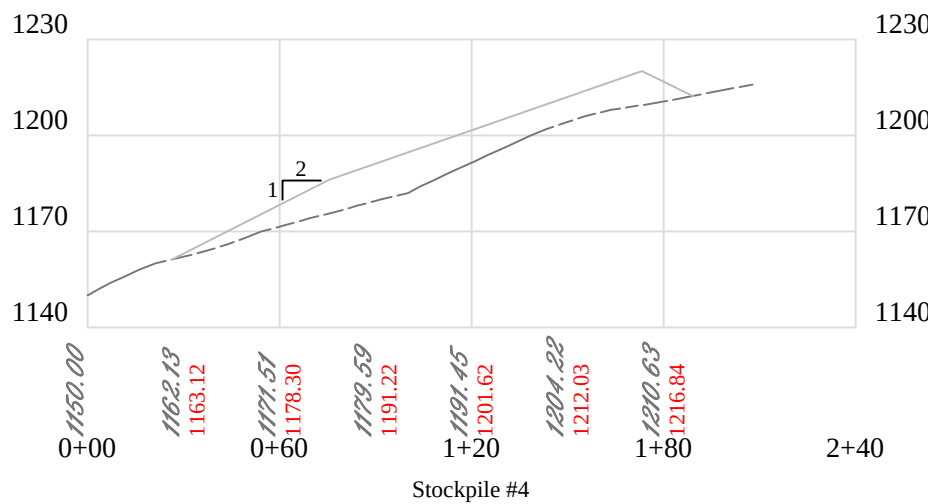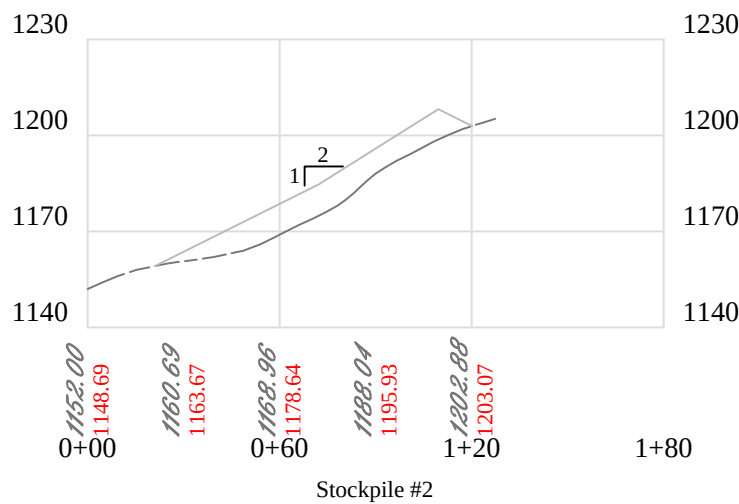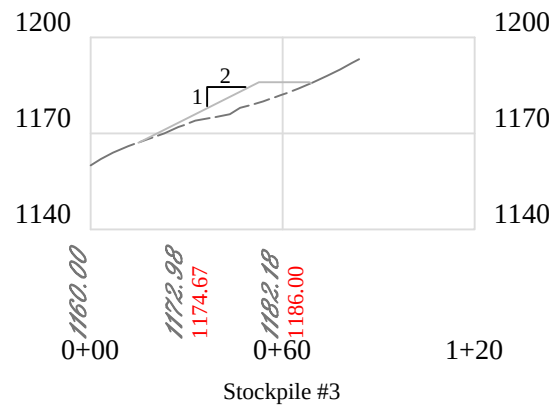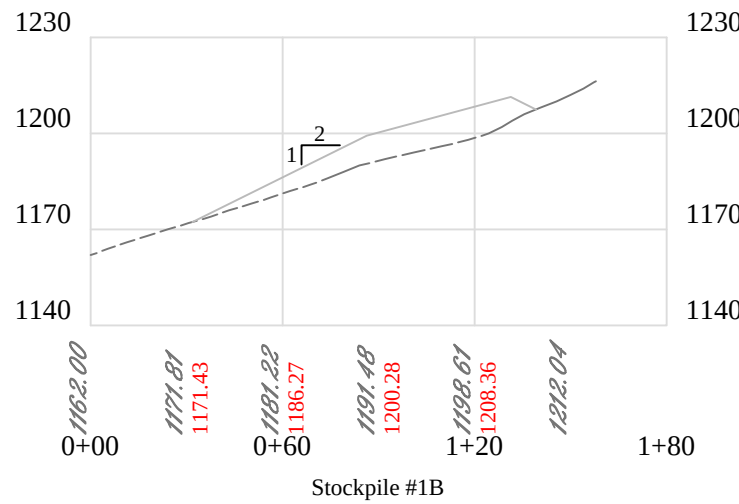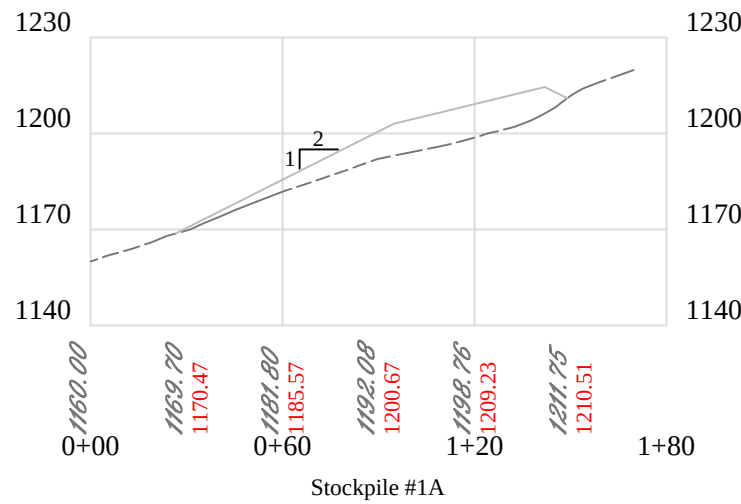

03/14/2025

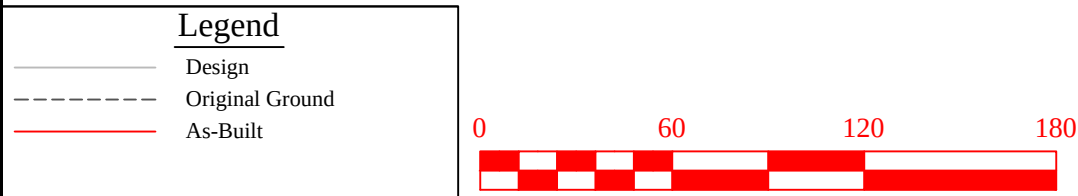

Revision	Design
Date	02-04-2025
THIS DOCUMENT PREPARED FOR HG ENERGY LLC	
Kelly Surveying P.O. Box 254 Dunbar, WV 26029 (304)338-0985	
Cross Sections - Access Road 1221 Well Site Freemans Creek District Lewis County, WV	
Date:	02/04/2025
Scale:	As Shown
Designed By:	ZS
File No.	
Sheet 28 of 32	

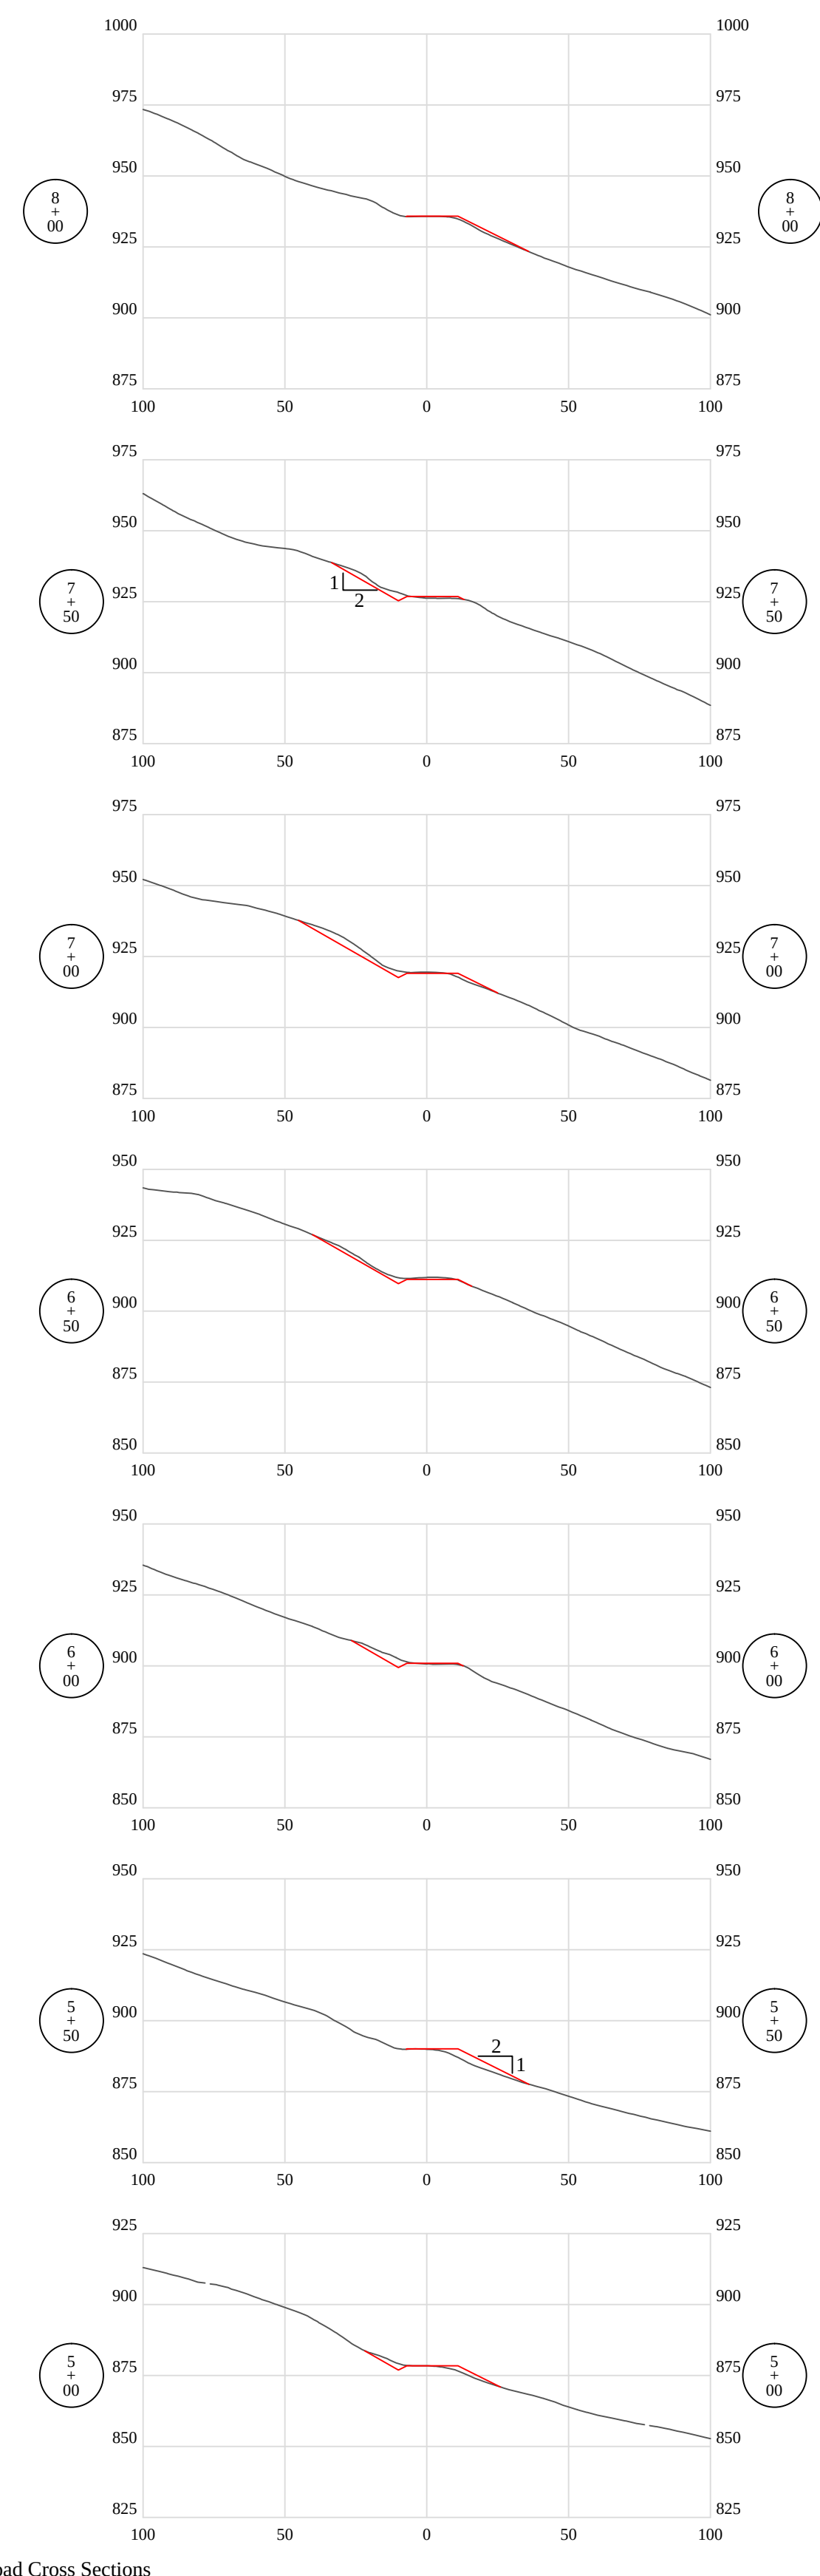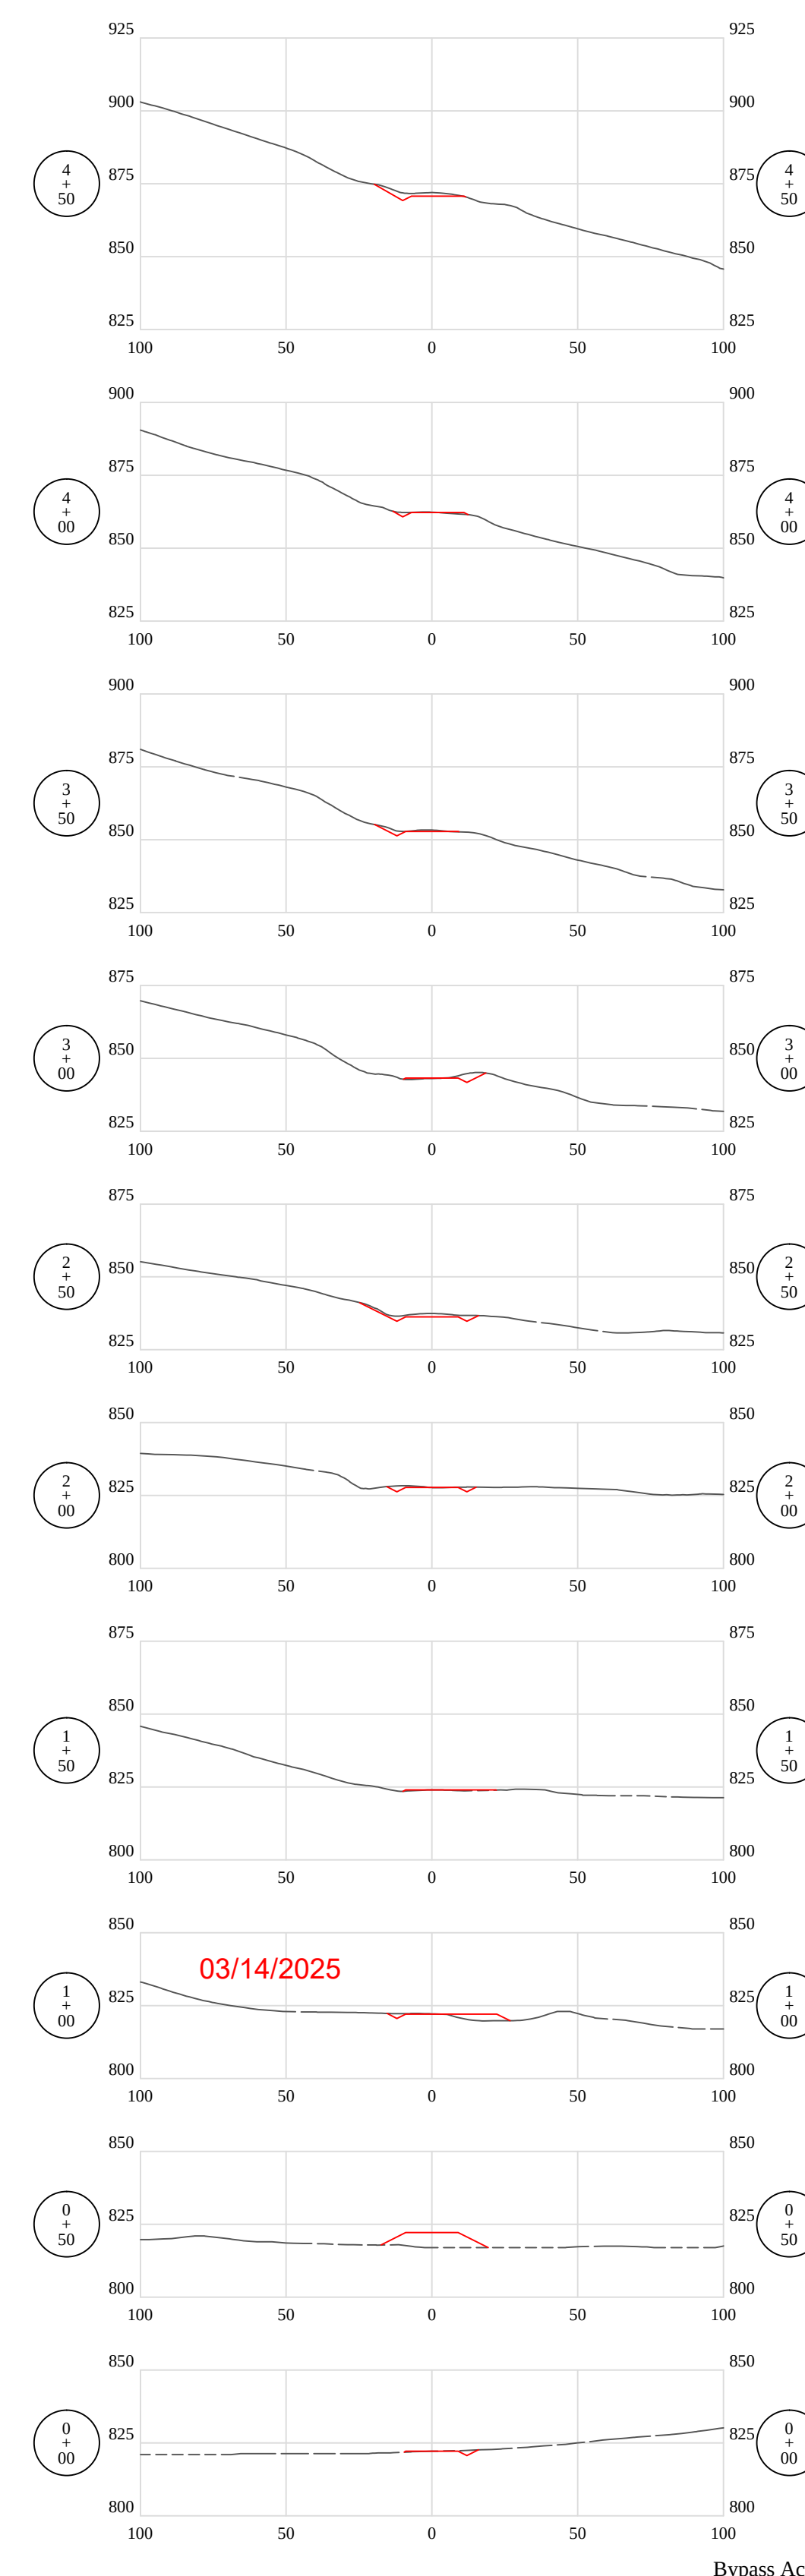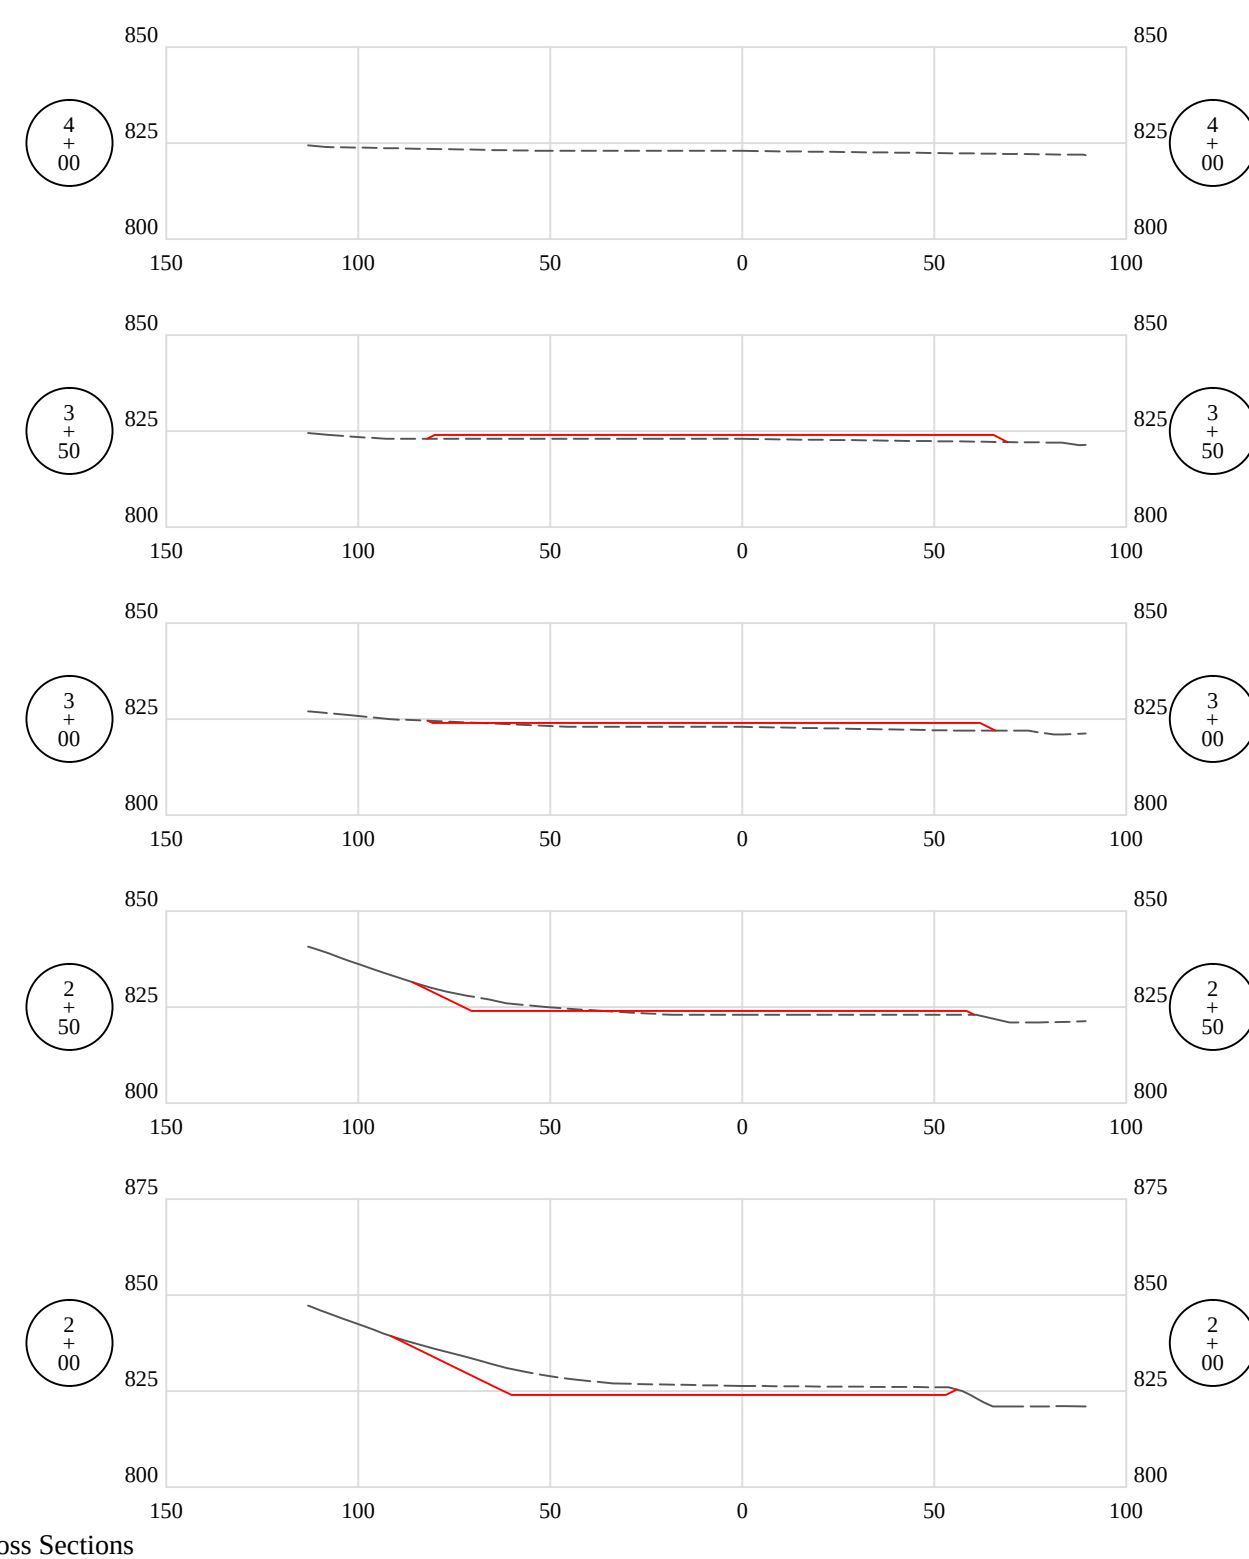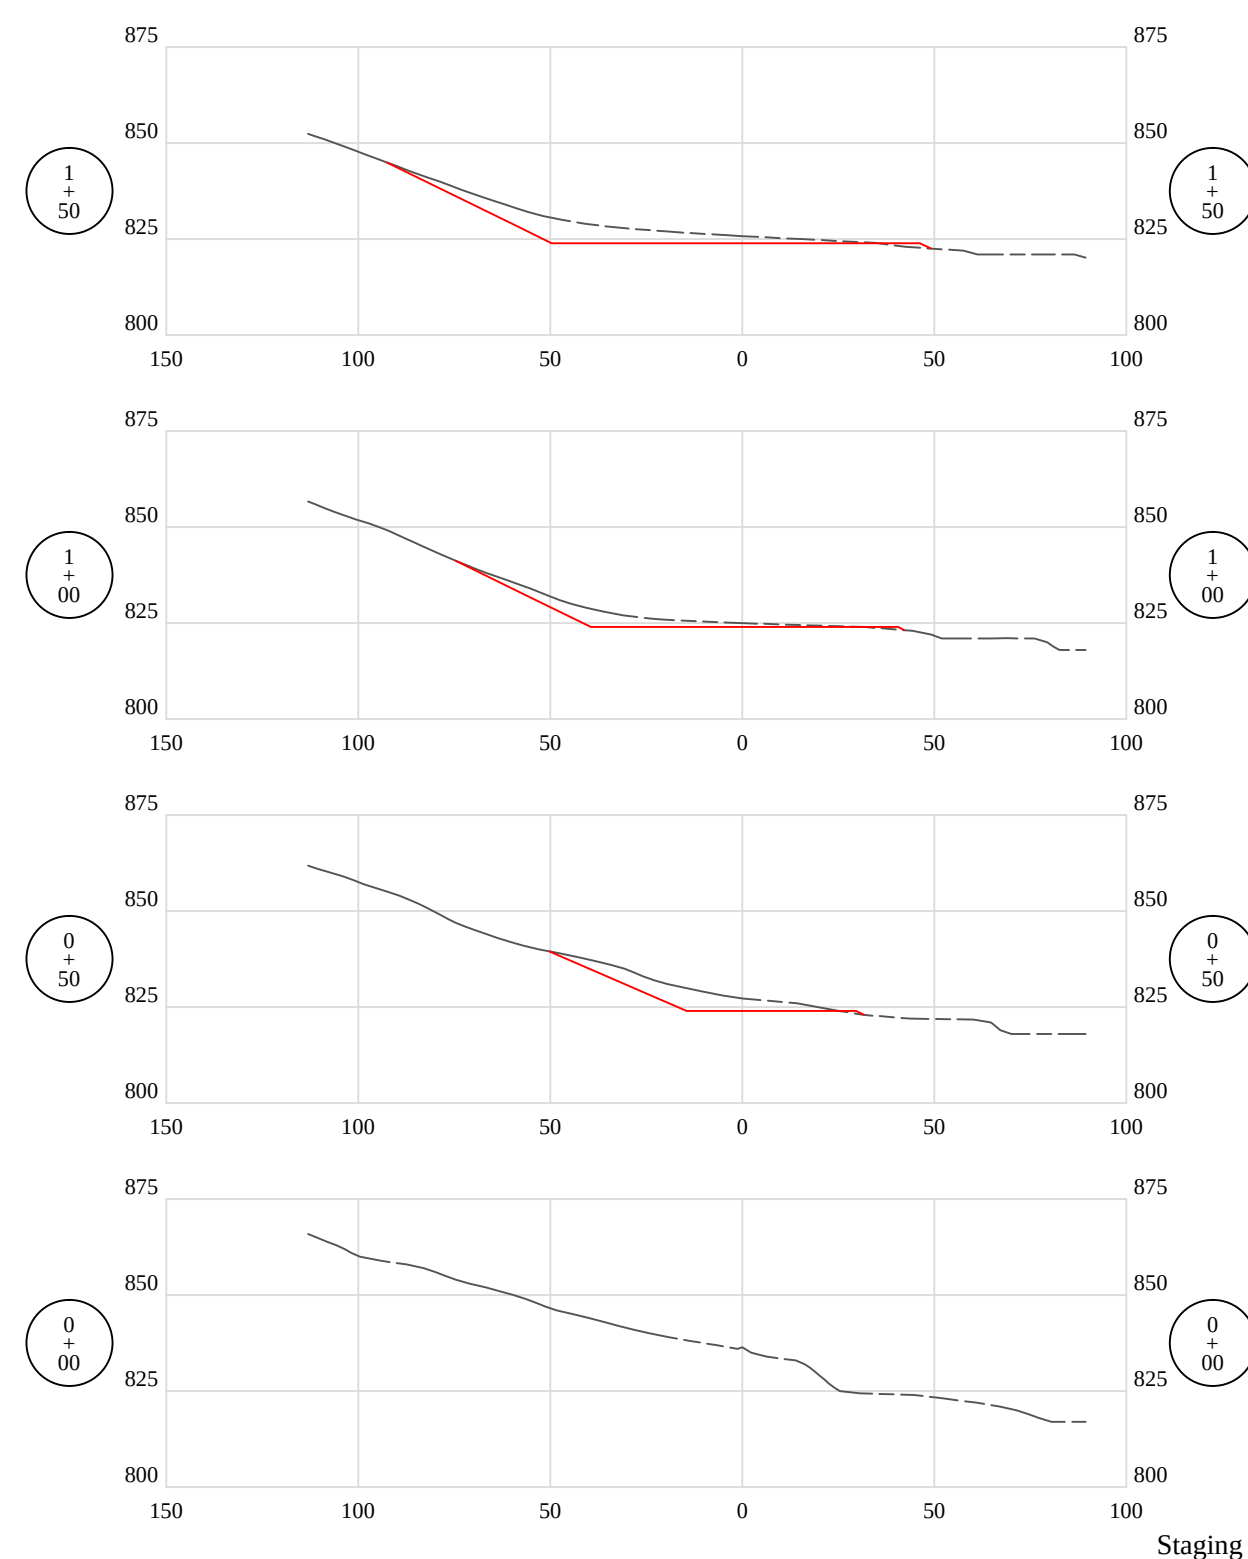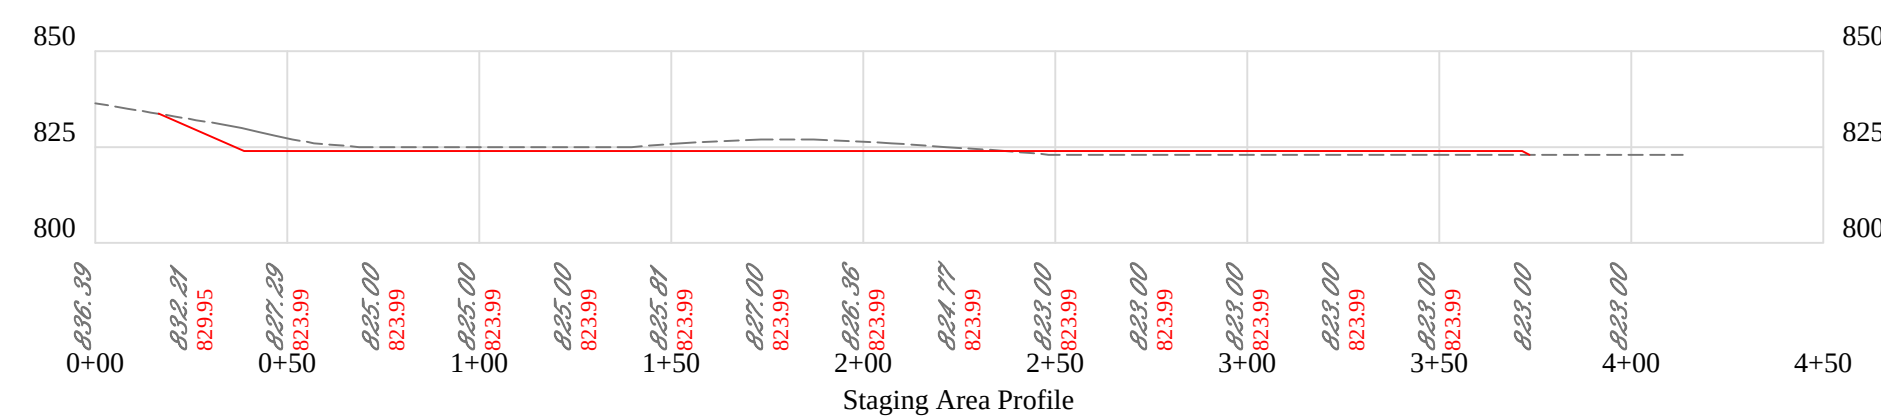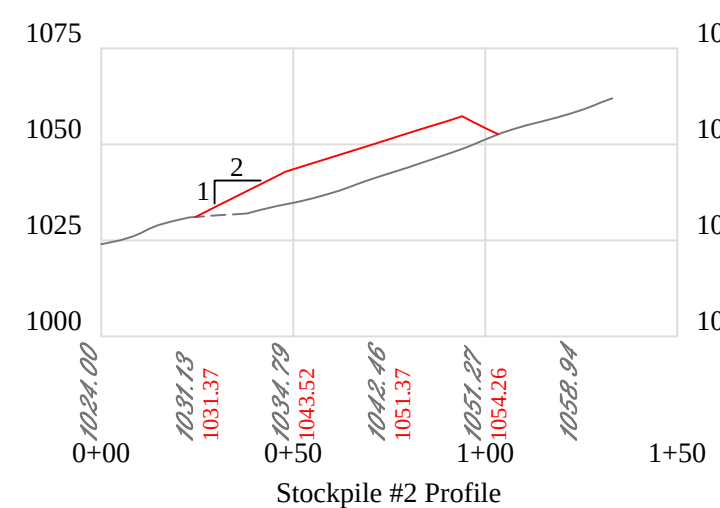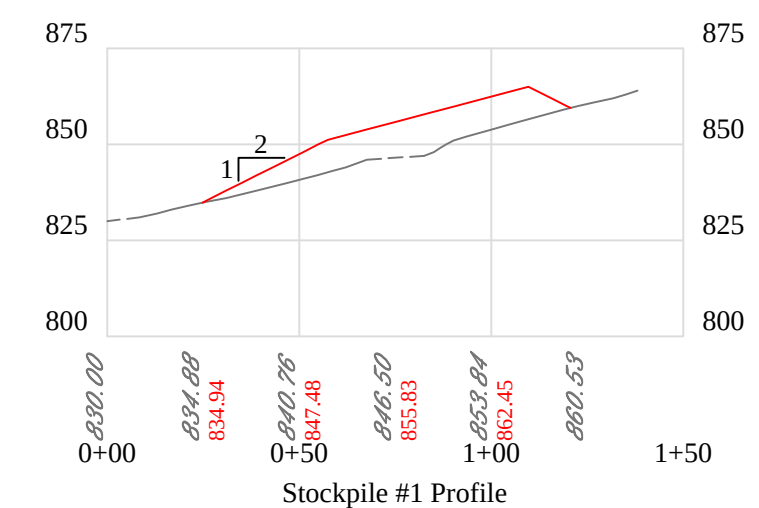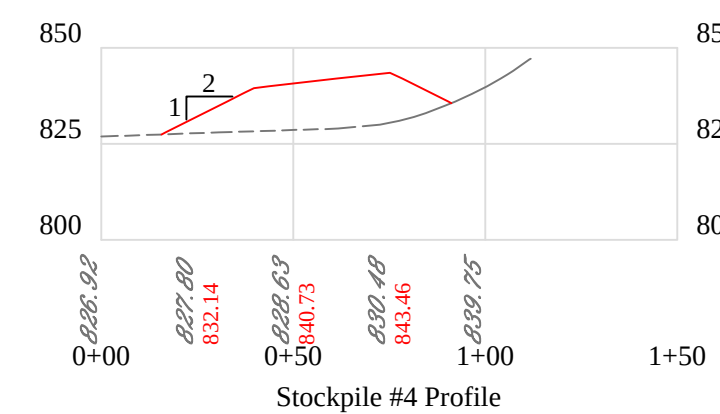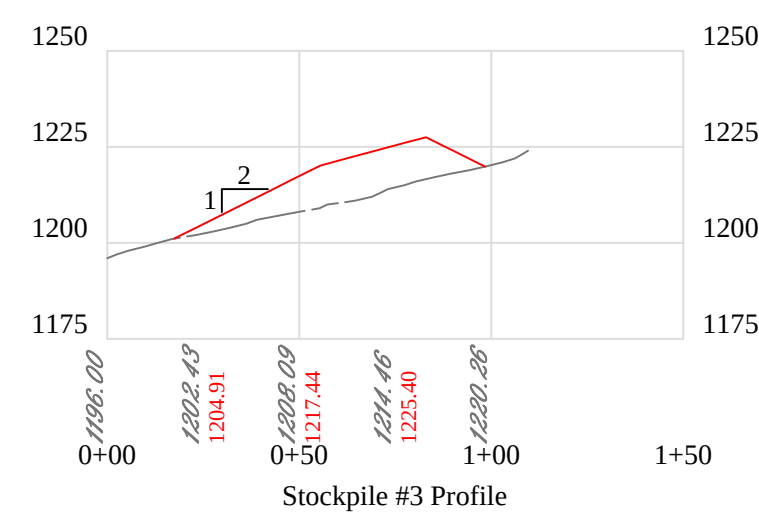

APPROVED
WVDEP OOG
Modification
3/14/2025

1221 Well Site Fink Creek Access

HG Energy LLC

Exhibit A: As-Built Modification

Date	Revision
12-04-2025	Design

Date
02-04-2025

THIS DOCUMENT
PREPARED FOR
HG ENERGY LLC



Cross Sections - Staging Area

1221 Well Site

Freemans Creek District
Lewis County, WV







Date: 02/04/2025
Scale: As Shown
Designed By: ZS
File No.
Sheet 29 of 32

APPROVED
WVDEP OOG
Modification
3/14/2025

1221 Well Site Fink Creek Access

HG Energy LLC

Exhibit A: As-Built Modification

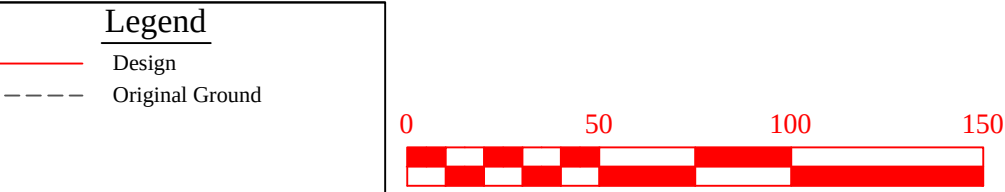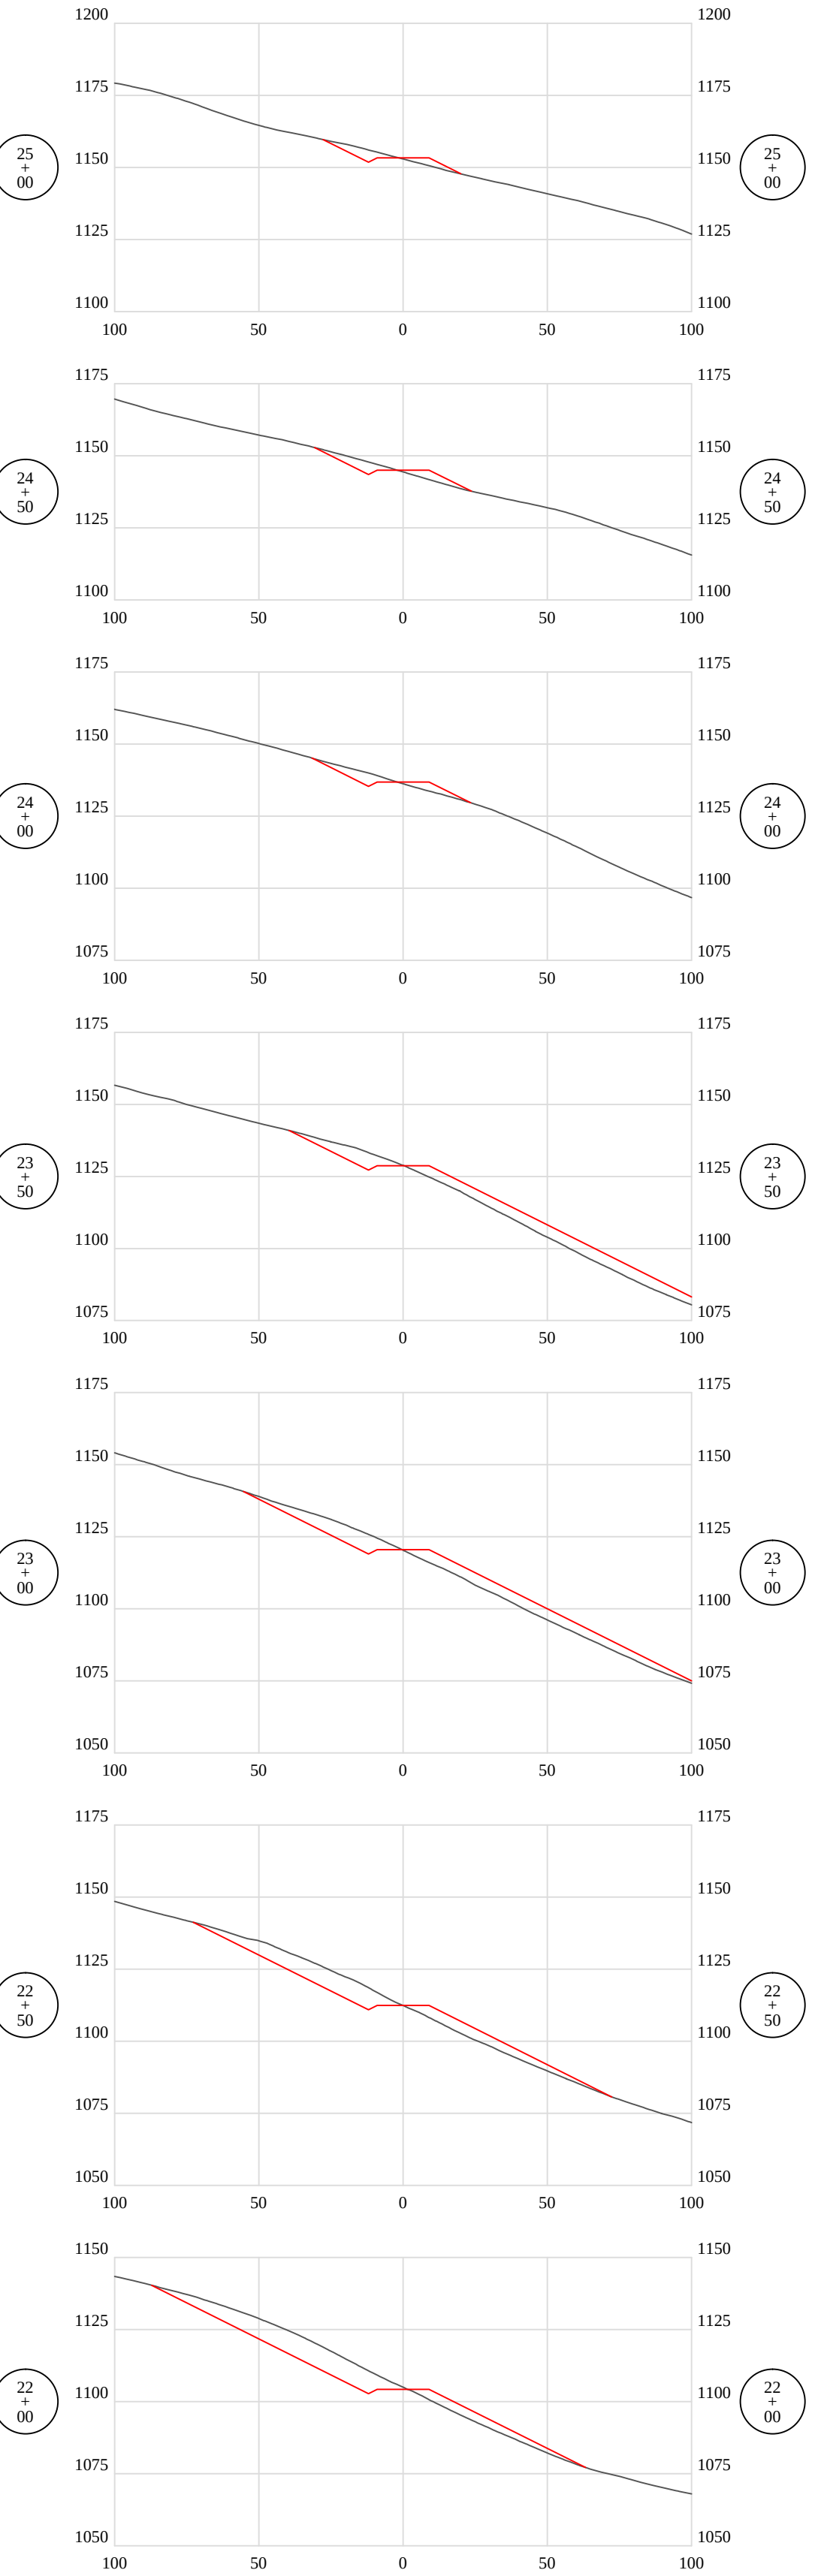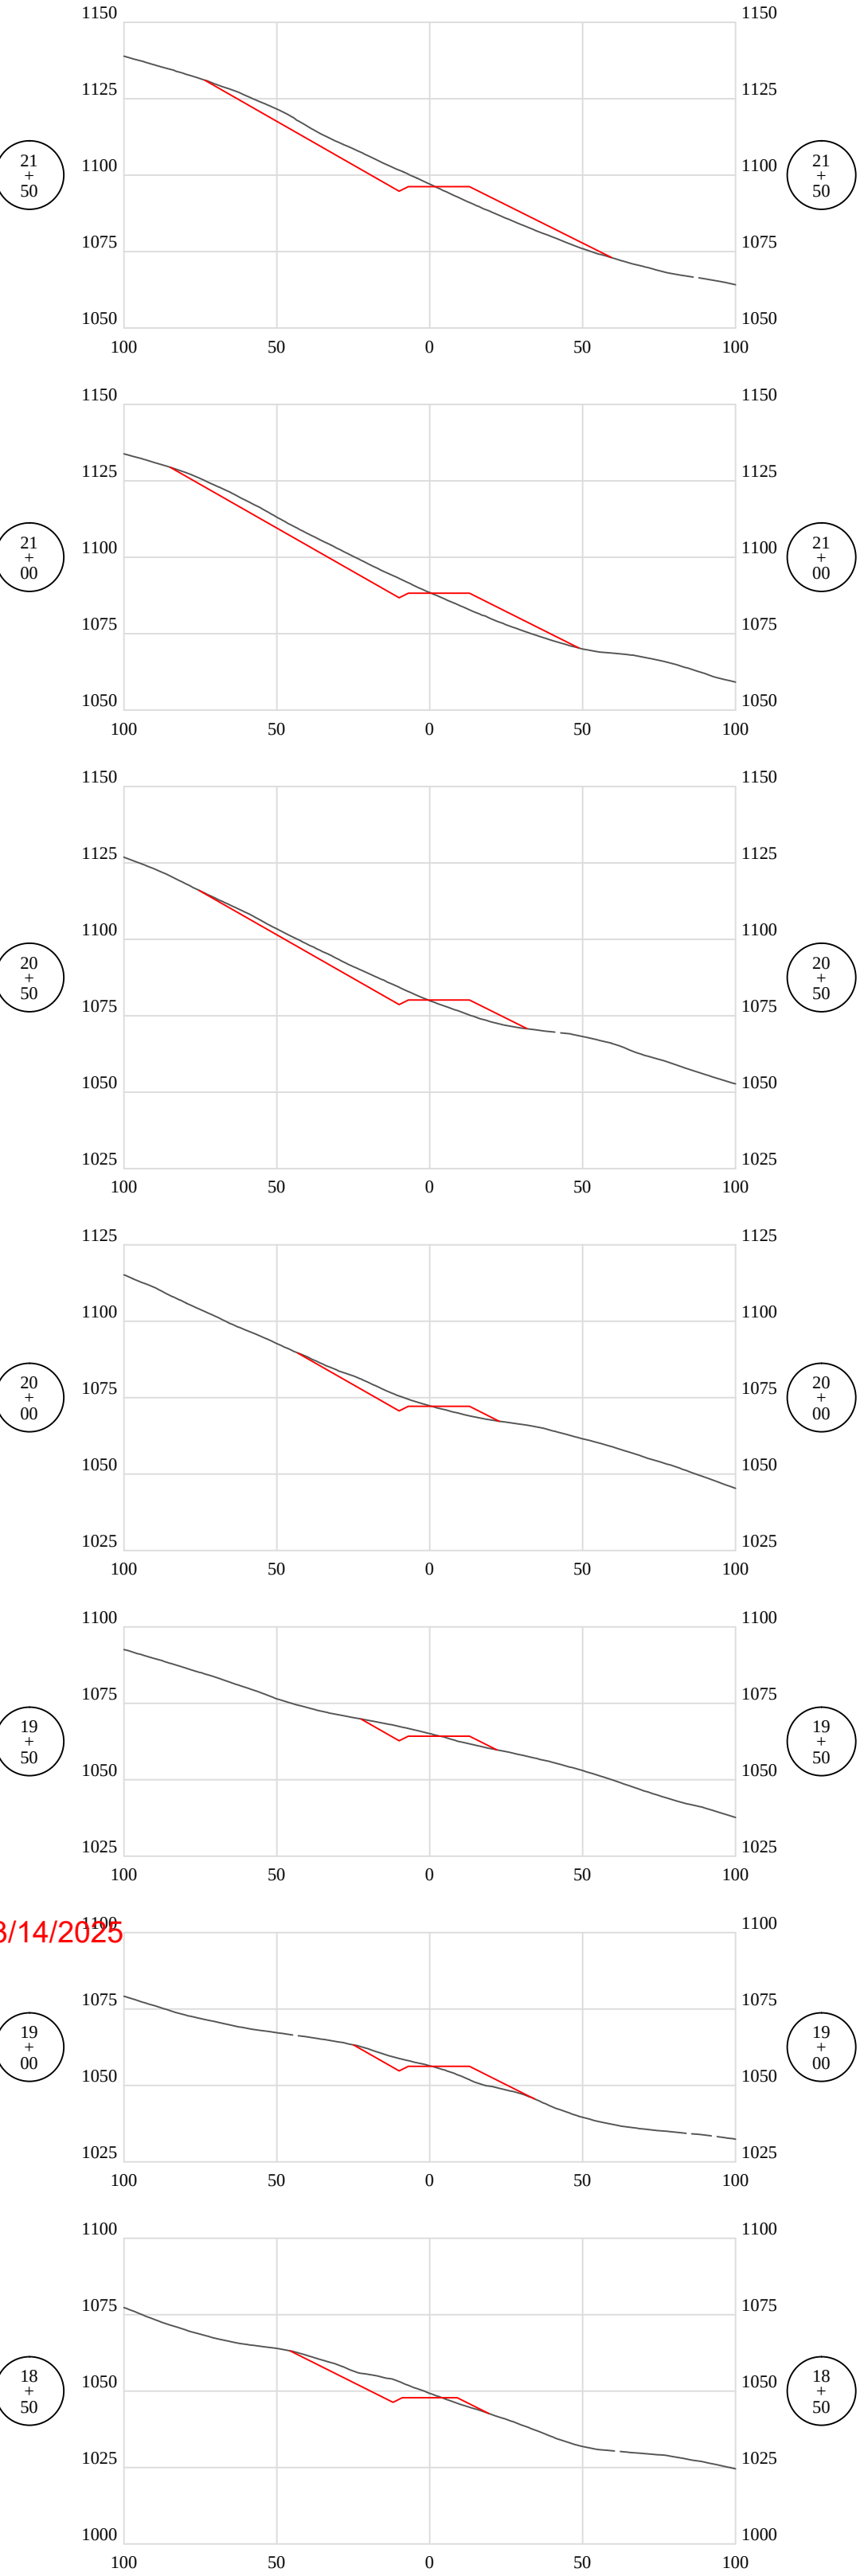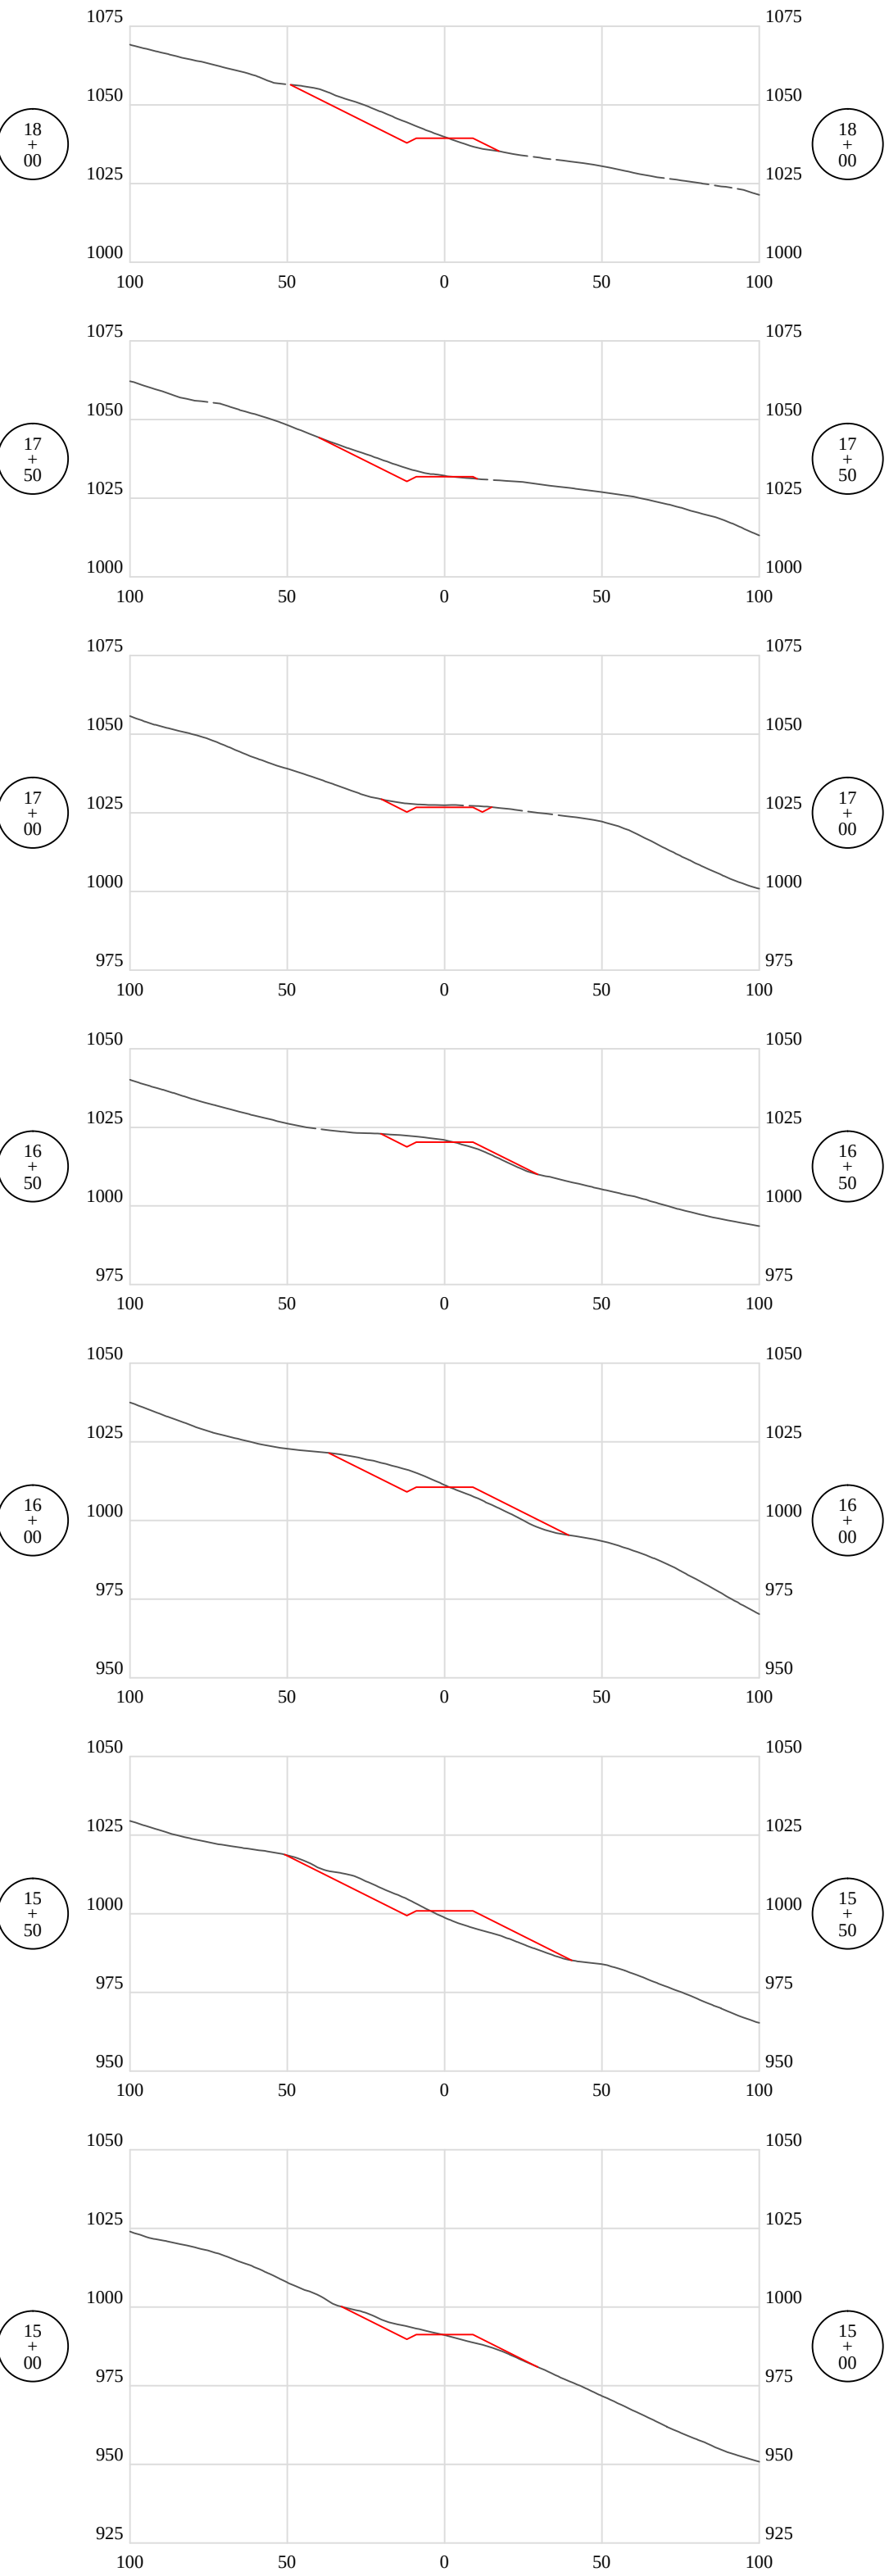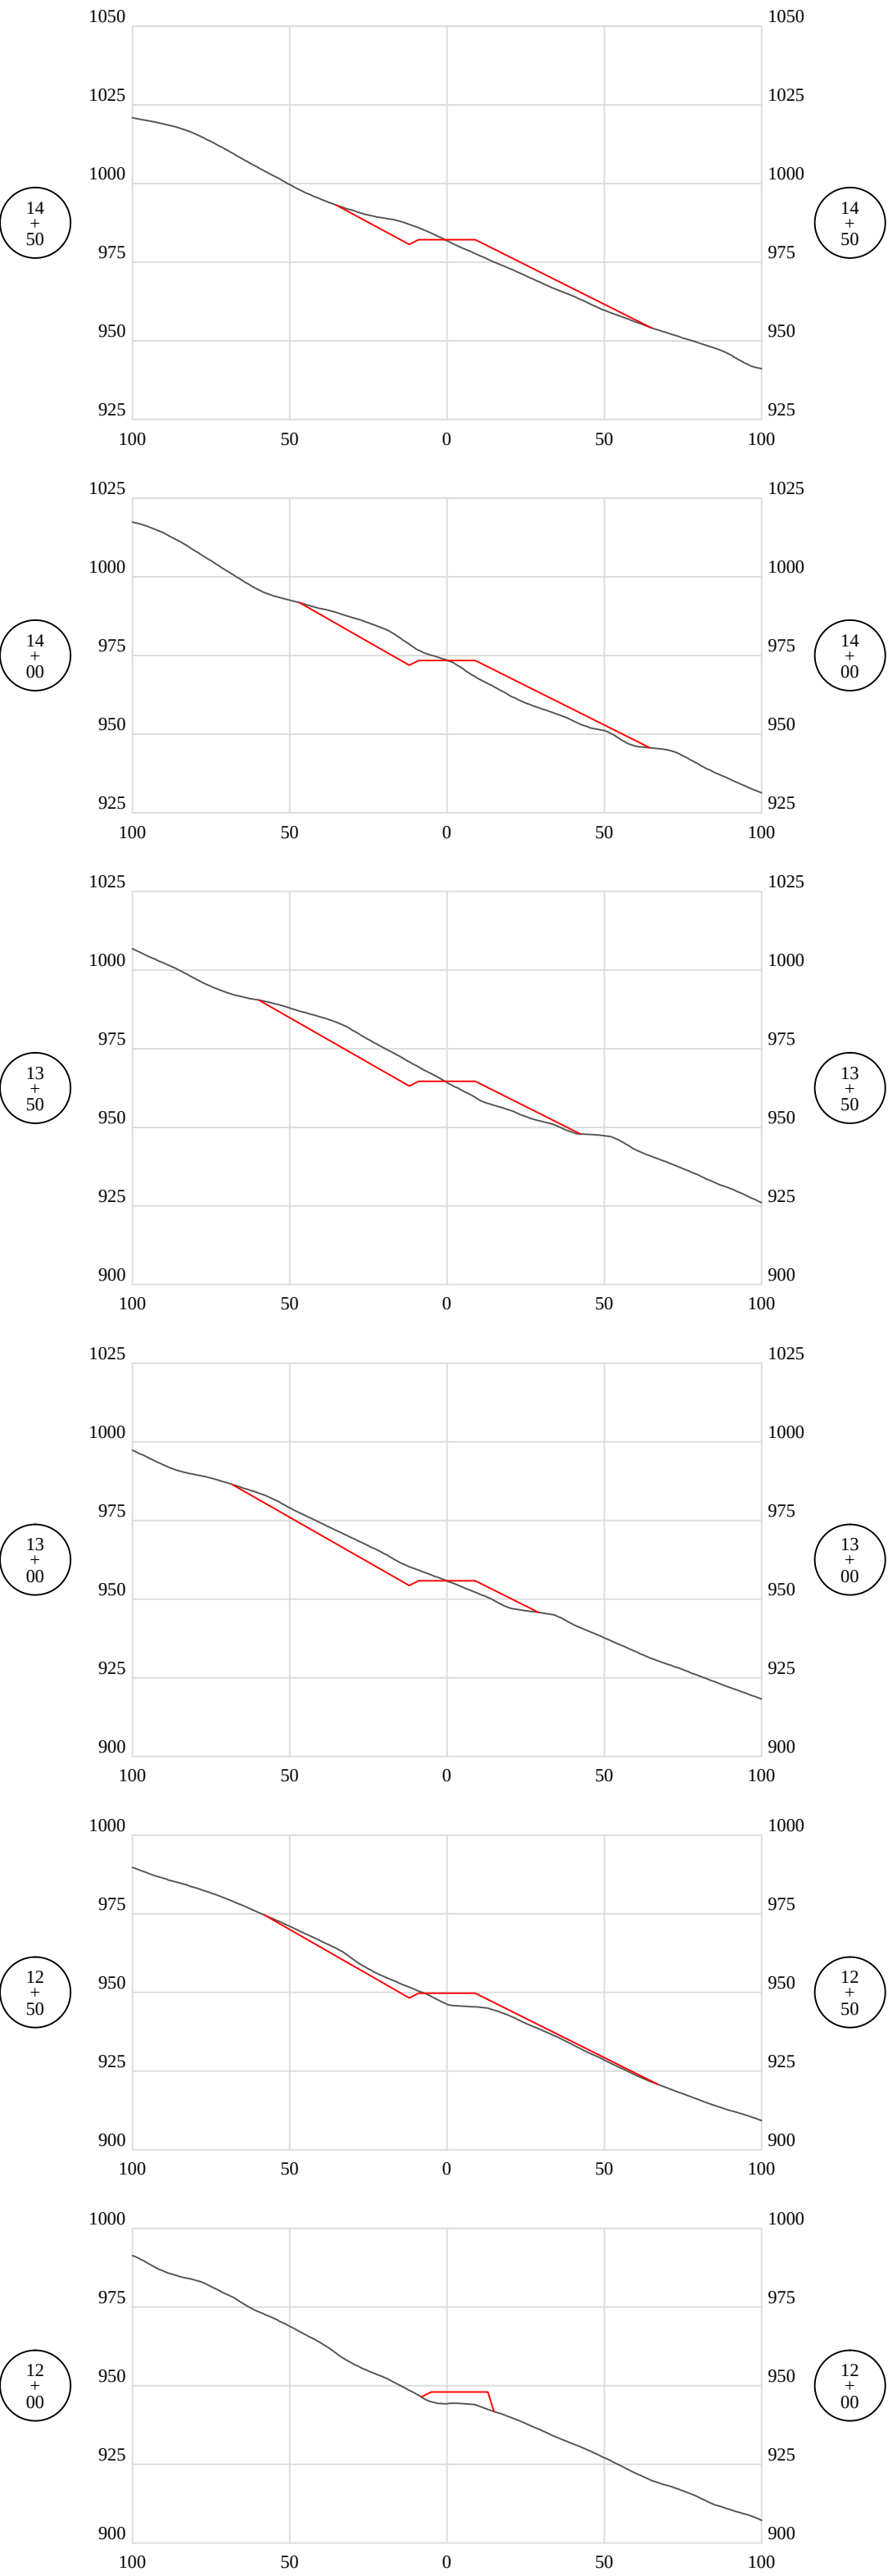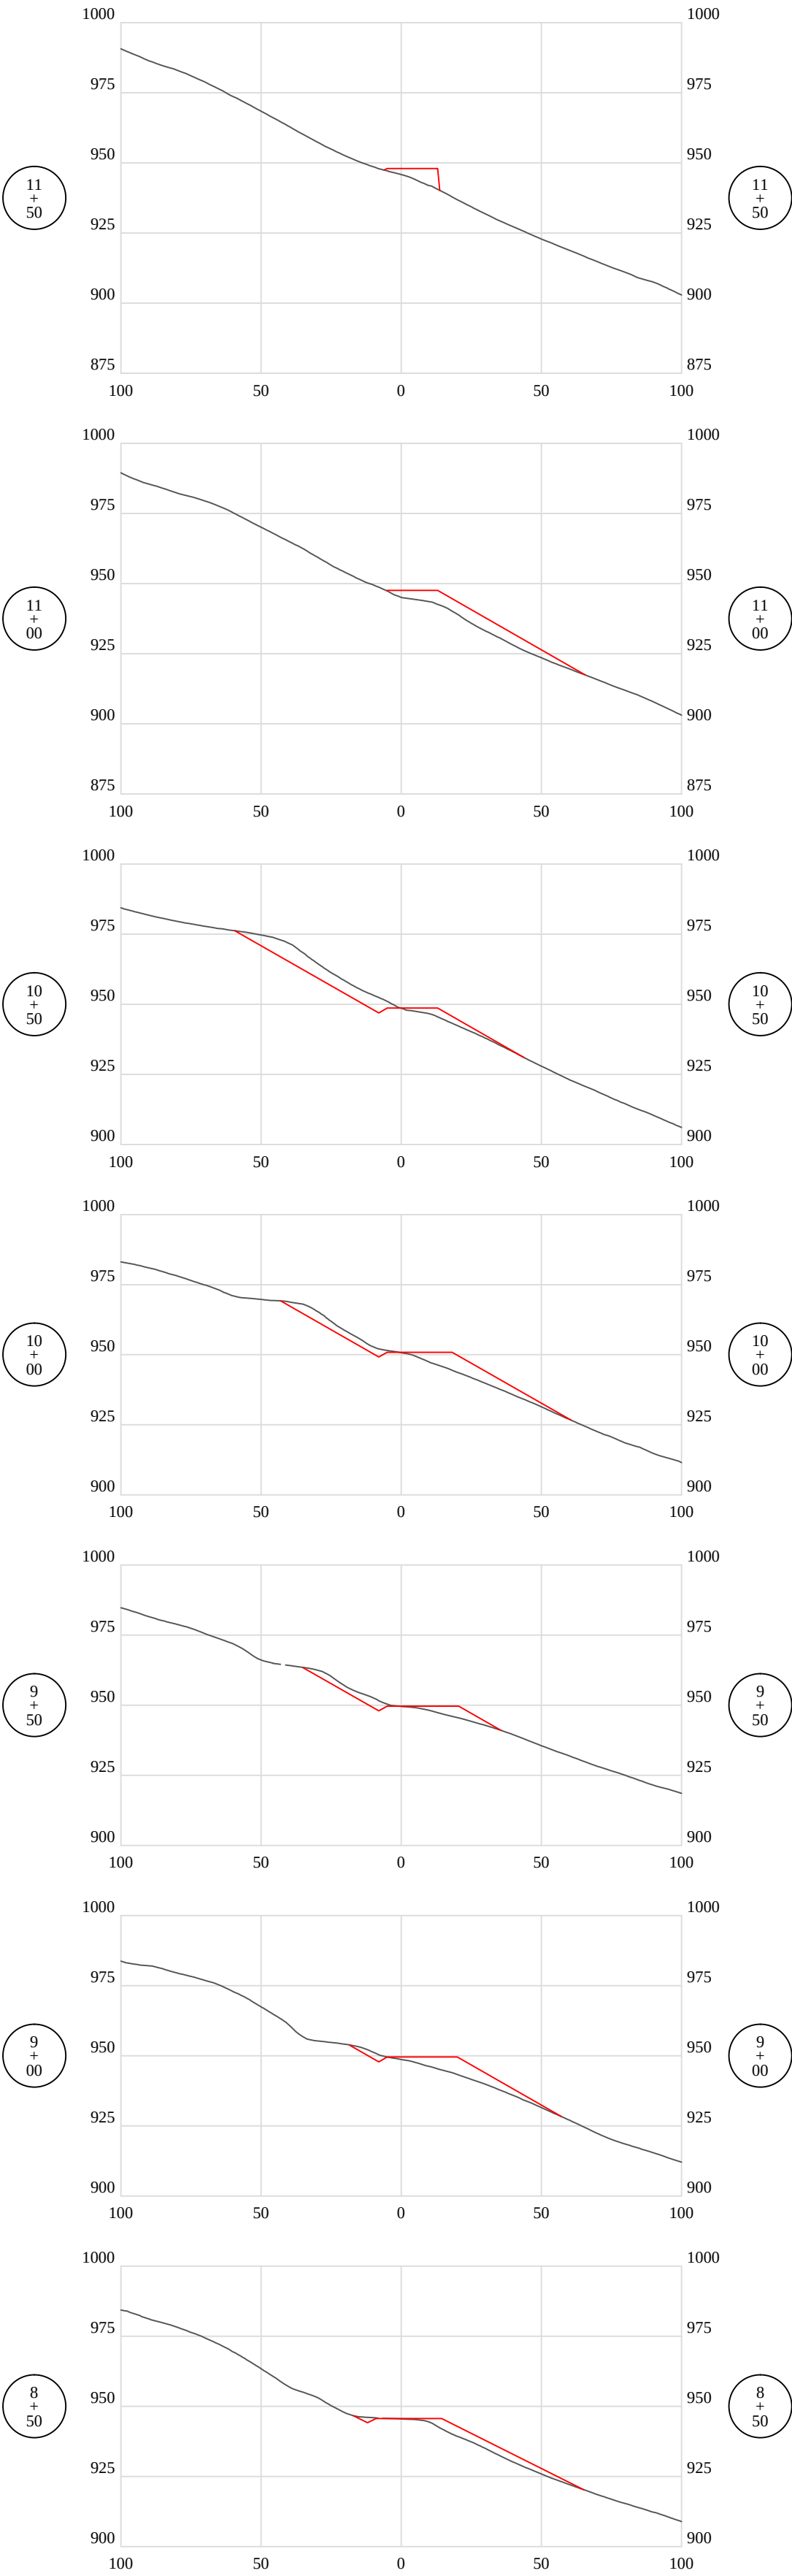

Revision
Design
Date
02-04-2025



THIS DOCUMENT
PREPARED FOR
HG ENERGY LLC

Kelly S. Surveying
P.O. Box 254
Biller, WV 26209
(304) 338-0985

Cross Sections - Bypass Access Road
1221 Well Site
Freemans Creek District
Lewis County, WV

Date: 02/04/2025
Scale: As Shown
Designed By: ZS
File No.
Sheet 30 of 32

APPROVED
WVDEP OOG
Modification
3/14/2025

1221 Well Site Fink Creek Access

HG Energy LLC

Exhibit A: As-Built Modification

Revision
Design

Date
02-04-2025




THIS DOCUMENT
PREPARED FOR
HG ENERGY LLC

Kelly Surveying
P.O. Box 254
Delmar, WV 26039
(304)338-0965

Cross Sections - Bypass Access Road
1221 Well Site
Freemans Creek District
Lewis County, WV

Date: 02/04/2025
Scale: As Shown
Designed By: ZS
File No.
Sheet 31 of 32

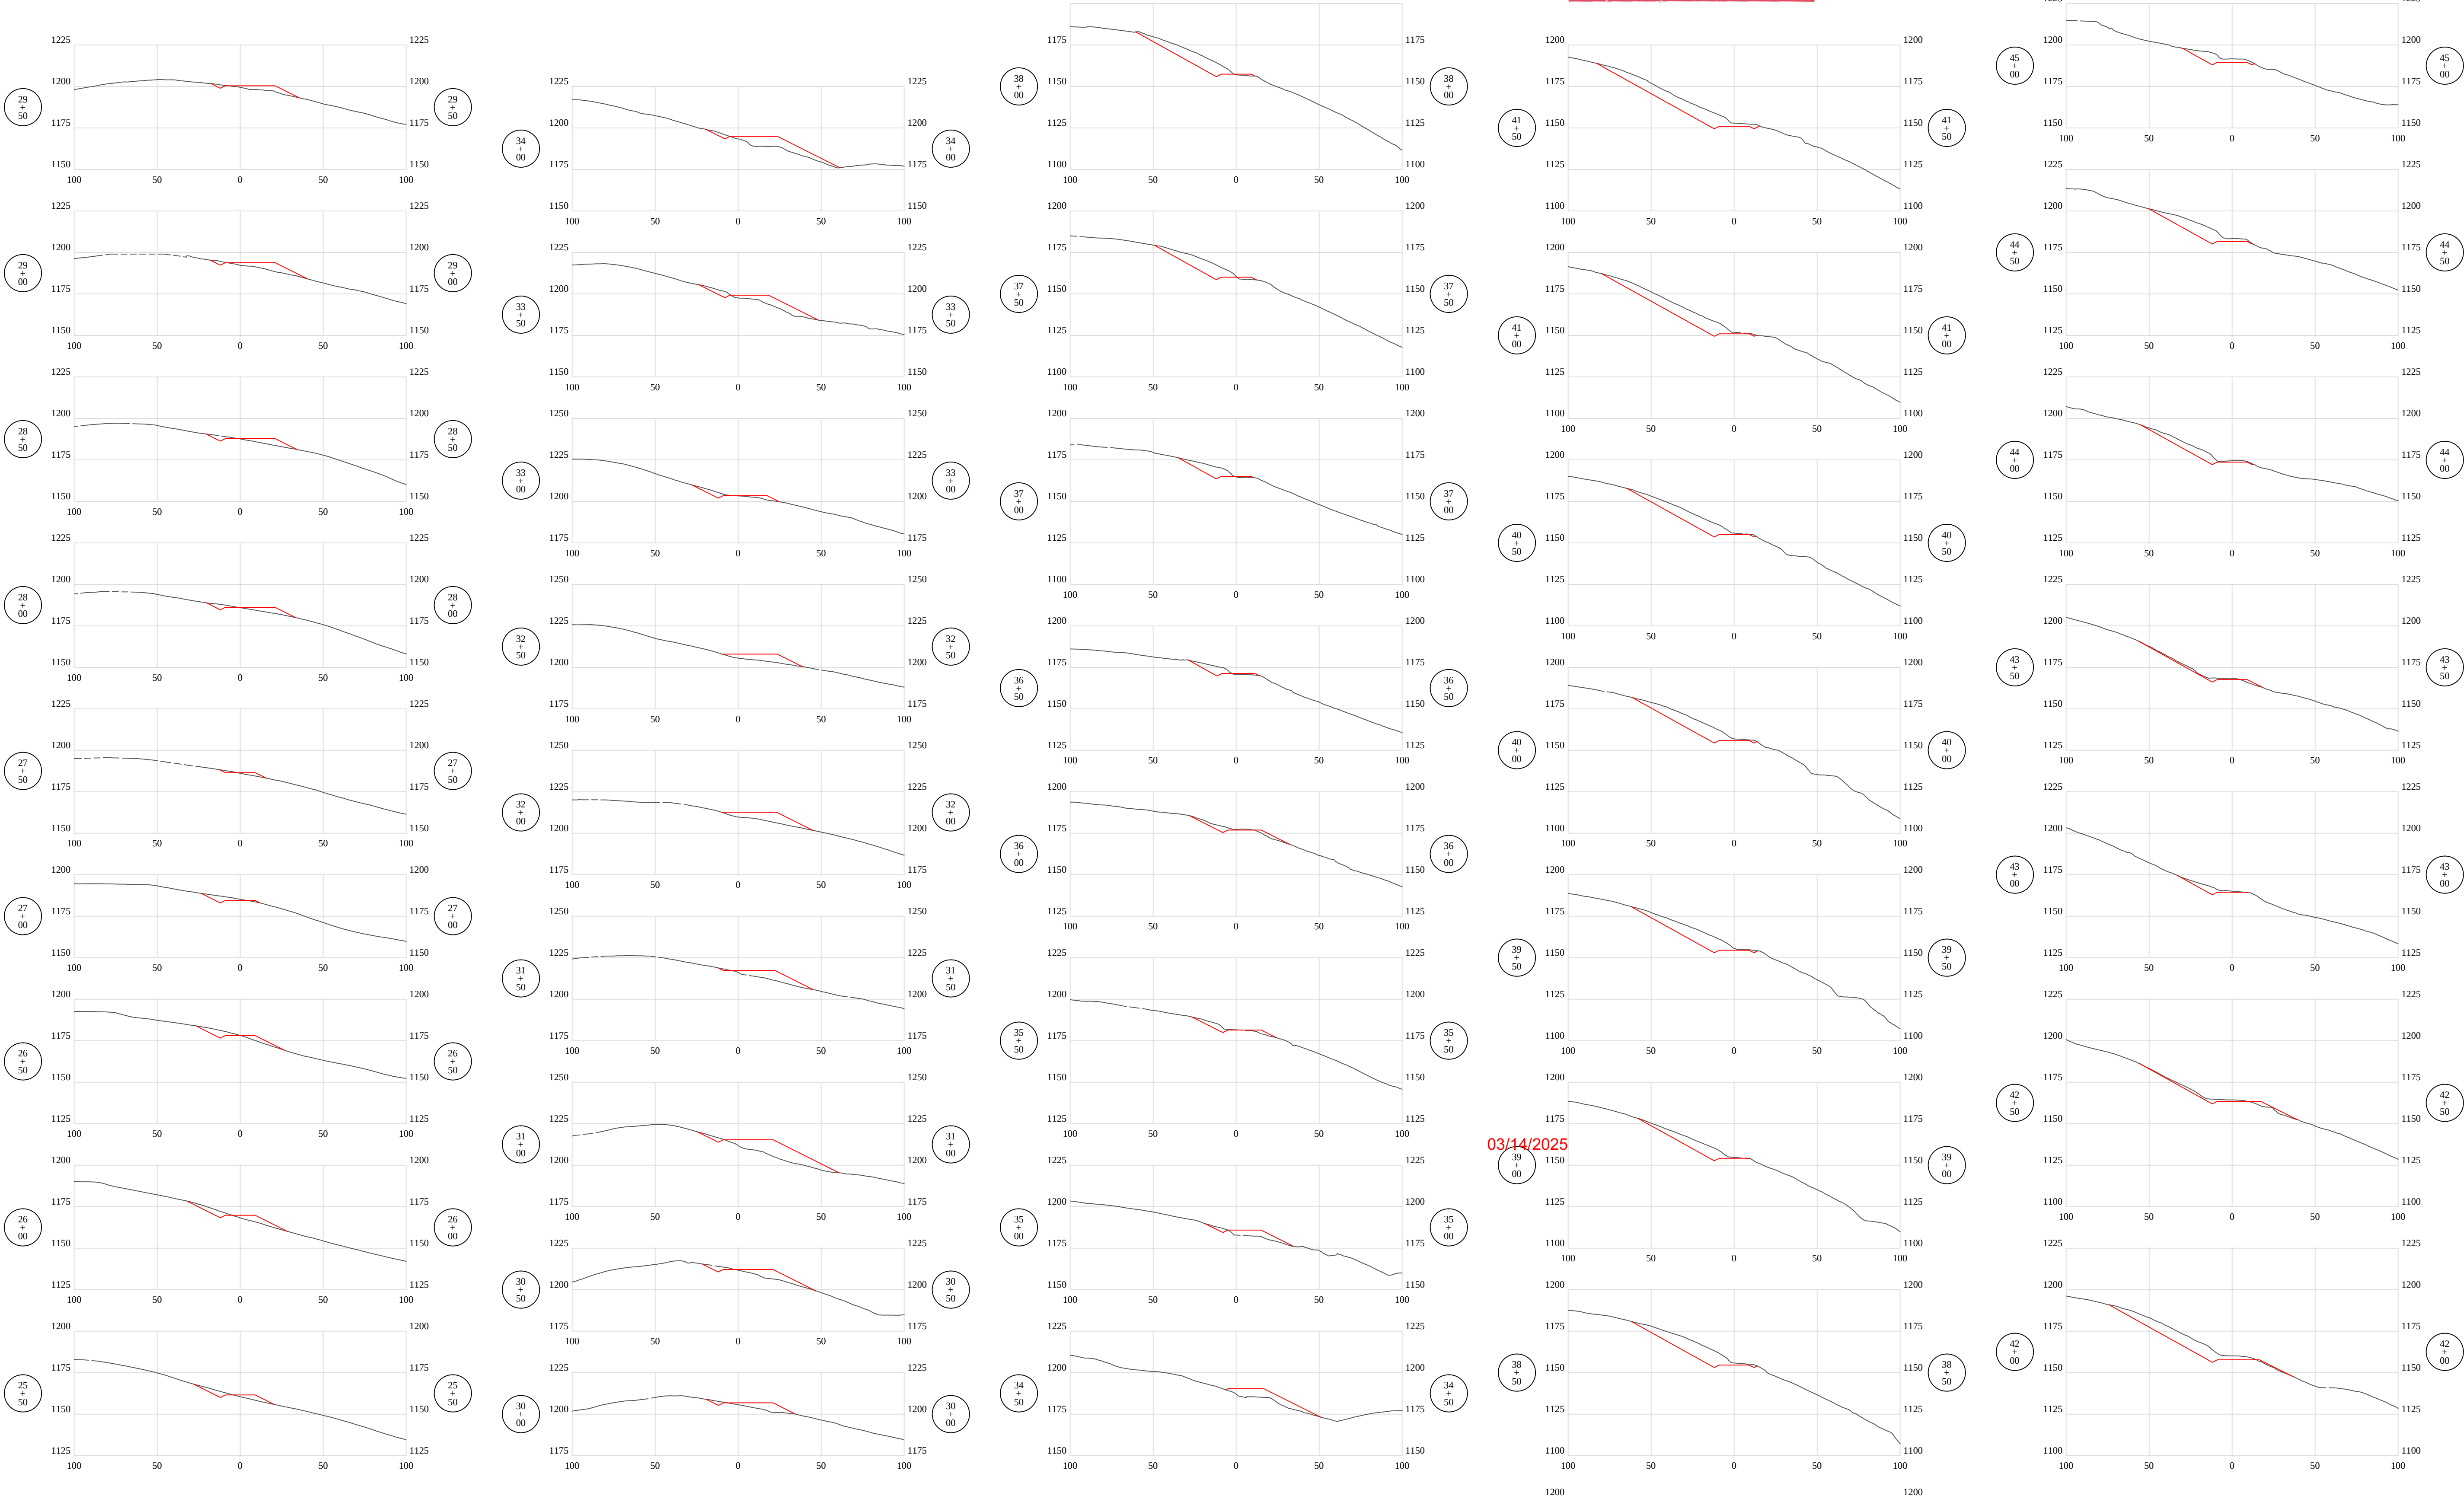



03/14/2025

1221 Well Site Fink Creek Access

HG Energy LLC

Exhibit A: As-Built Modification

APPROVED
WVDEP OOG
Modification
3/14/2025

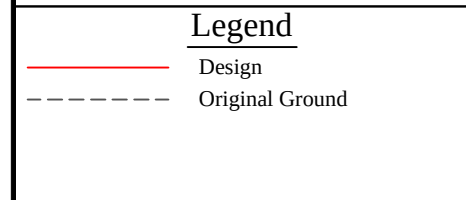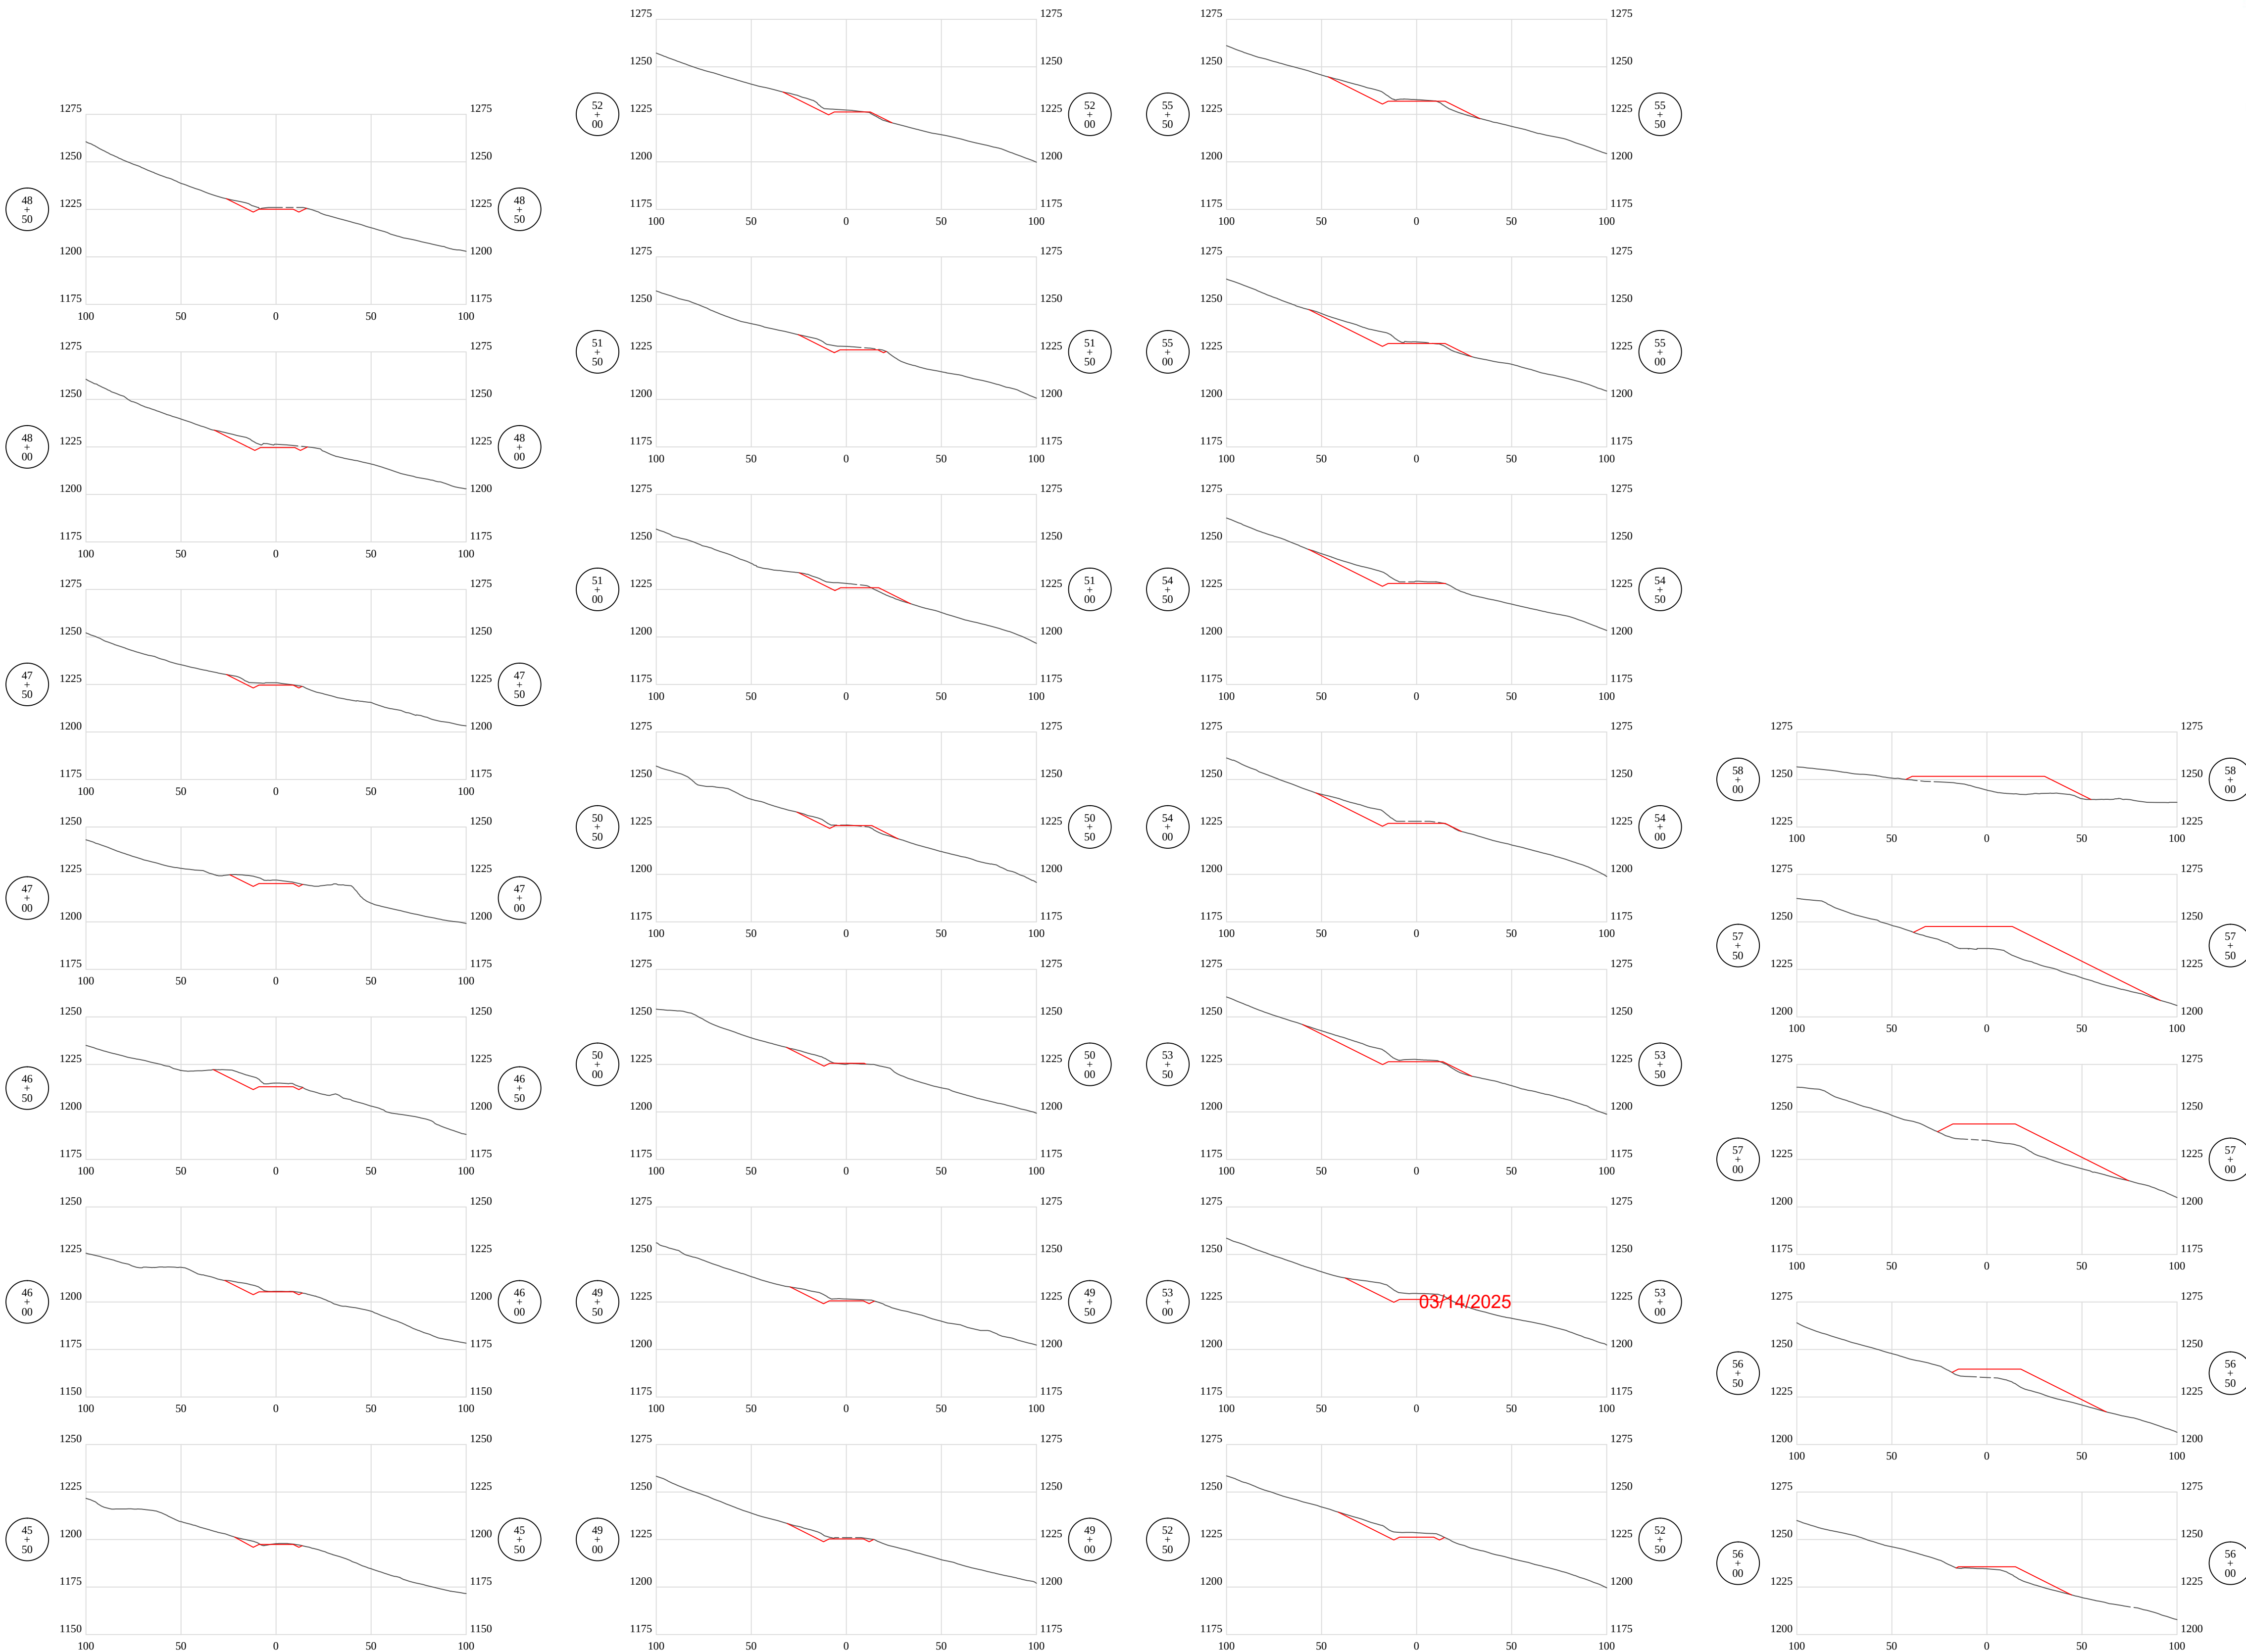

Revision
Design

Date
02-04-2025




THIS DOCUMENT
PREPARED FOR
HG ENERGY LLC

Kelly Surveying
P.O. Box 254
Biller, WV 26209
(304)338-0985

Cross Sections - Bypass Access Road
1221 Well Site
Freemans Creek District
Lewis County, WV

Date: 02/04/2025
Scale: As Shown
Designed By: ZS
File No.
Sheet 32 of 32

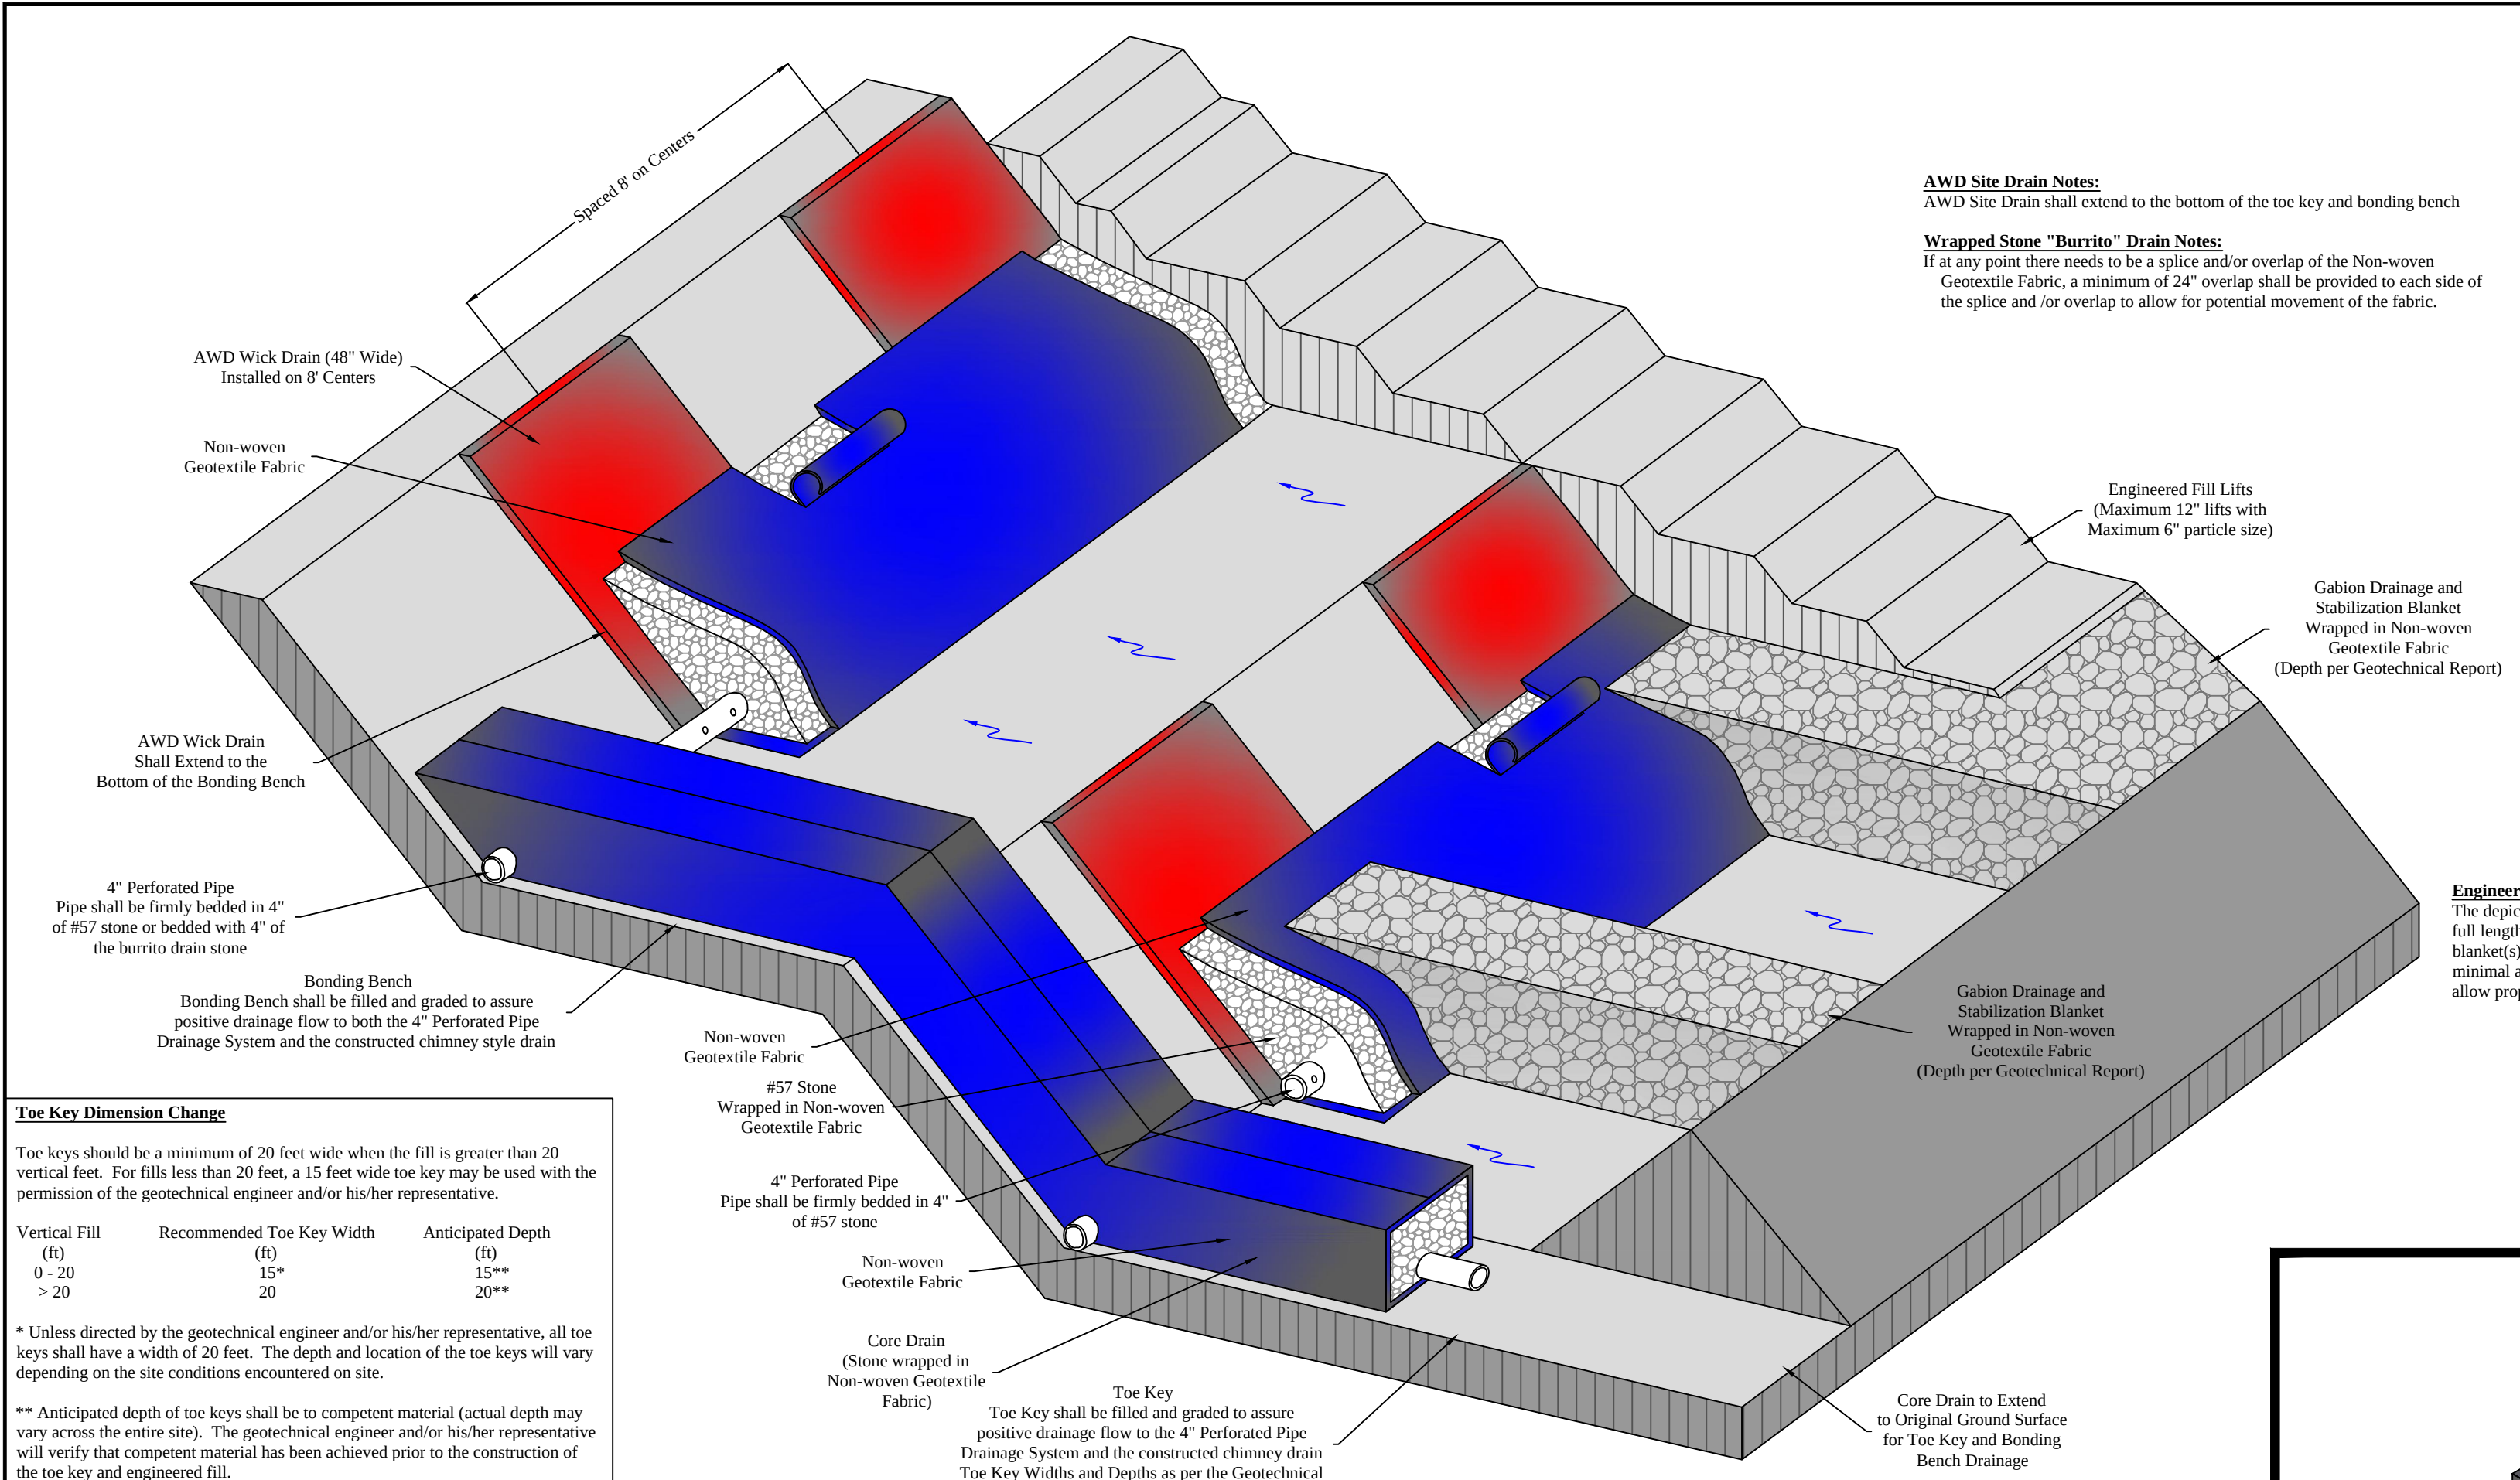

APPROVED
WVDEP OOG
Modification
3/14/2025

AWD Site Drain Notes:
AWD Site Drain shall extend to the bottom of the toe key and bonding bench


Wrapped Stone "Burrito" Drain Notes:
If at any point there needs to be a splice and/or overlap of the Non-woven Geotextile Fabric, a minimum of 24" overlap shall be provided to each side of the splice and /or overlap to allow for potential movement of the fabric.

Engineered Fill Note:
The depicted toe key, bonding bench, and drainage system shall be utilized for the full length of all fill areas exceeding four feet (4') in height. The drainage blanket(s) shall be graded to drain to a core drain. At the engineer's discretion, a minimal amount of fill may be installed prior to drainage blanket installation to allow proper drainage of the toe key and/or bonding bench.


Toe Key Dimension Change		
Vertical Fill (ft)	Recommended Toe Key Width (ft)	Anticipated Depth (ft)
0 - 20	15*	15**
> 20	20	20**

* Unless directed by the geotechnical engineer and/or his/her representative, all toe keys shall have a width of 20 feet. The depth and location of the toe keys will vary depending on the site conditions encountered on site.


** Anticipated depth of toe keys shall be to competent material (actual depth may vary across the entire site). The geotechnical engineer and/or his/her representative will verify that competent material has been achieved prior to the construction of the toe key and engineered fill.

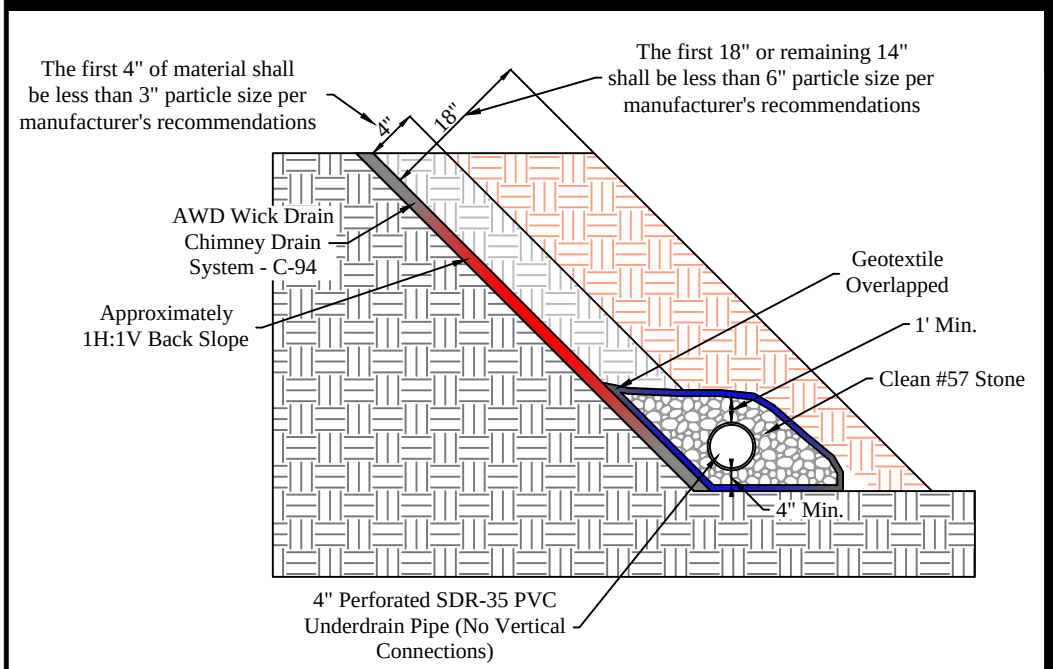

G2 Typical Face Drain Detail
Scale: NTS

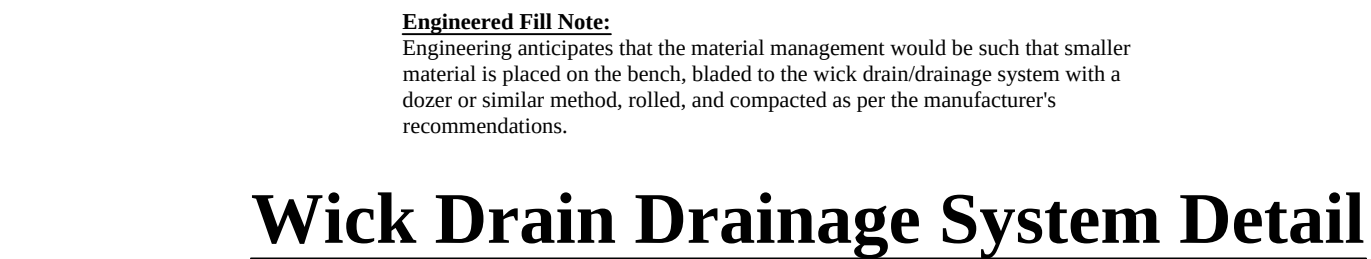


G1 Typical Engineered Fill Detail
Scale: NTS

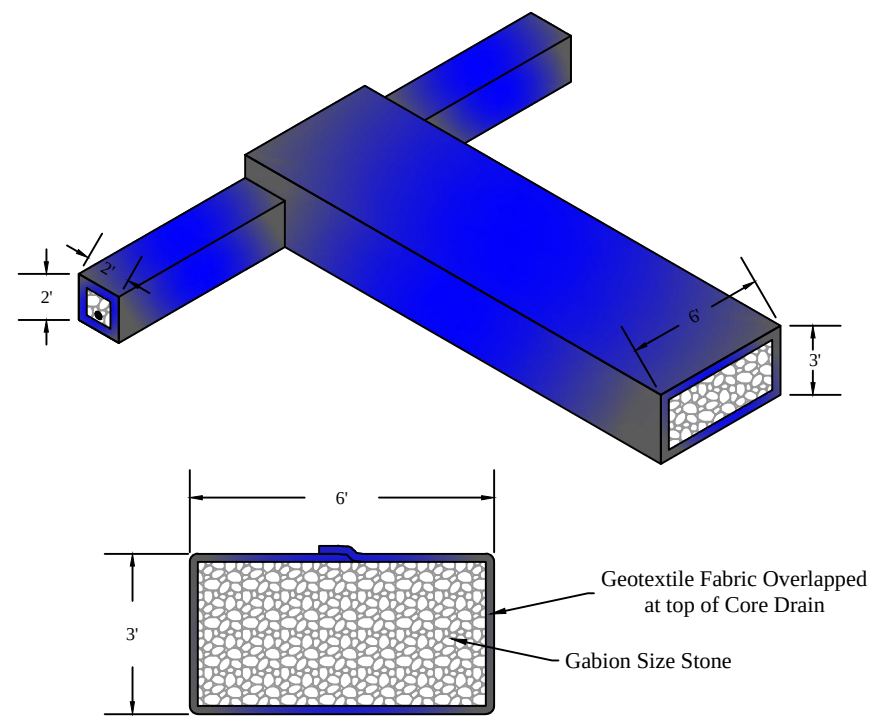

G3 Typical Core Drain Detail
Scale: NTS


1221 Well Site Fink Creek Access
HG Energy LLC
Exhibit A: As-Built Modification

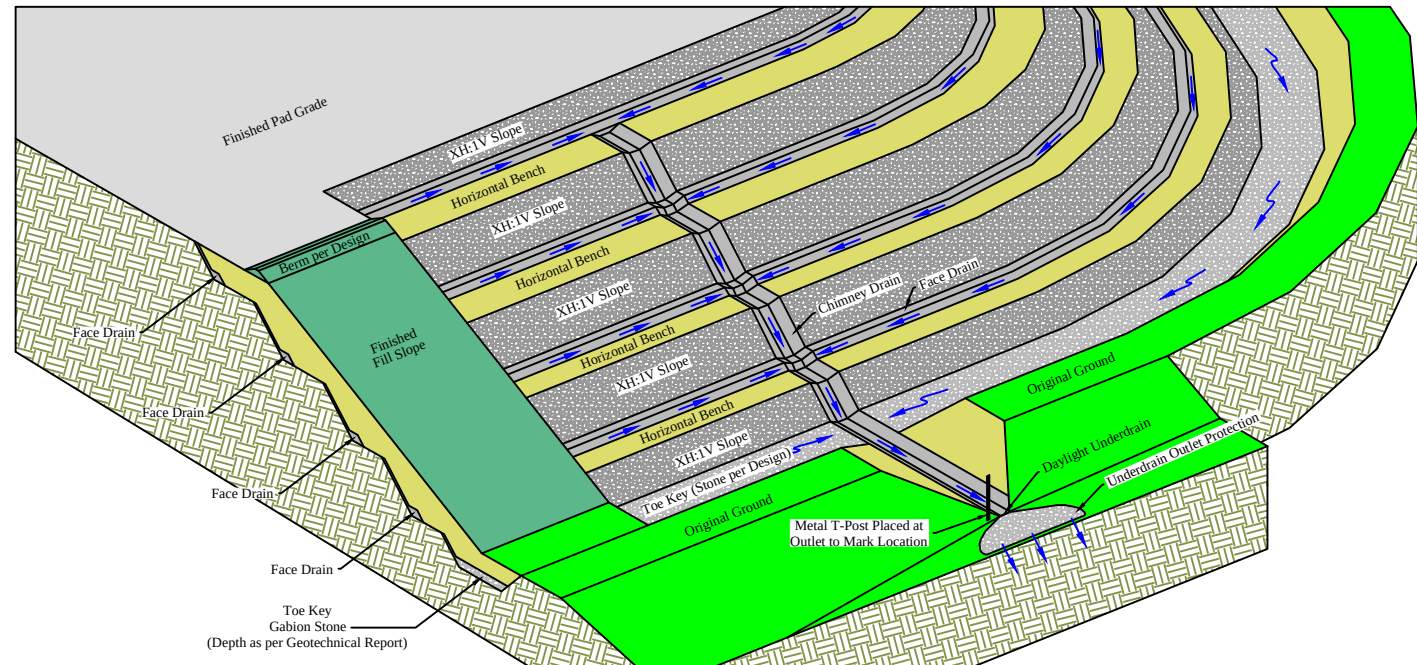

Note:
Toe Key and Bonding Bench Slope Cut as per the Geotechnical Report (XH:1V)

Finished Fill Slope as per the design

G4 Typical Engineered Fill Detail
Scale: NTS

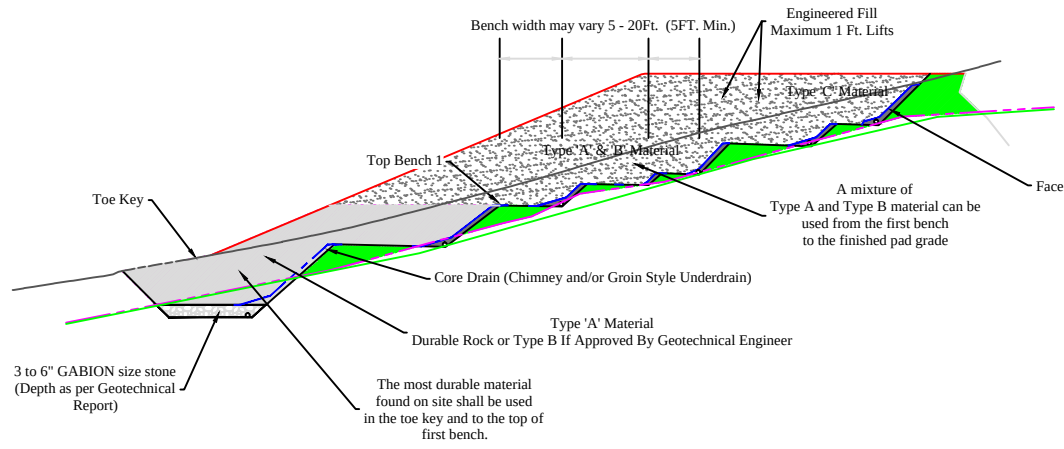


Material Management Detail
Scale = NTS

It is the contractors responsibility to review all available information; make a site visit and contact the design engineer prior to starting the project.

Material management will be strictly in accordance with the most durable material or rock available being used in the toe key construction and up to the first bench. The proctor used for testing in the toe key and up to the first bench will be for the material available on site classified as Type 'A' or a more durable Type 'B', the project may require an import material to meet the project specifications.


At no time shall the contractor excavate the toe key and replace with the same material unless it is durable rock or approved by the design engineer or geotechnical engineer.

G5 Material Management Detail
Scale: NTS

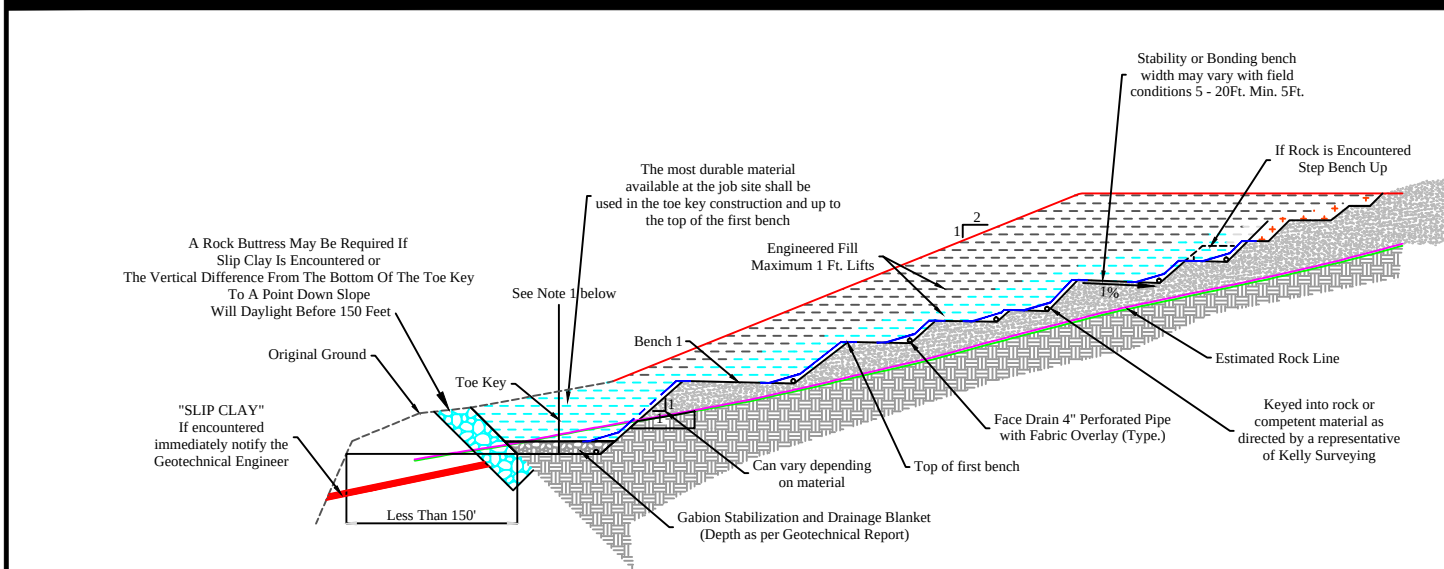


- Typical Fill Section @ Maximum Fill Height**
Scale = NTS
- Design slope intersection with ground line. The toe key width is centered about this point.
 - Extend this point to the bottom of the toe key. This will be the contour of the toe key.
 - Construct toe key drain(s) (see Toe Key Outlet Drain Detail)
 - Approved fill materials (including rock) shall be placed in lifts of maximum loose depth of 12 inches. The material shall be compacted to at least 95% of the maximum dry density at a moisture content within +/-3% of the optimum moisture as determined by ASTM D698.
 - Grade outer top of the toe key to allow for positive drainage and blend to original ground begin engineered fill.


G6 Typical Fill Section at Maximum Fill Height
Scale: NTS

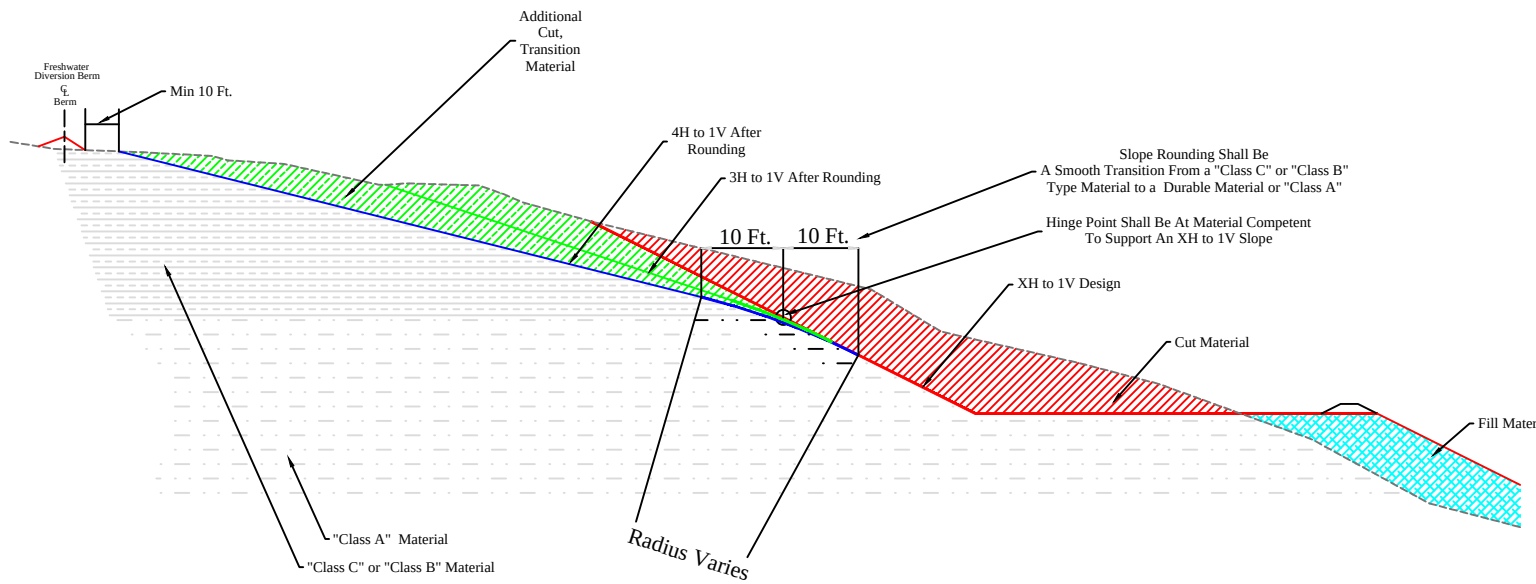


G7 Unstable Slope Management: Slope Rounding
Scale: NTS

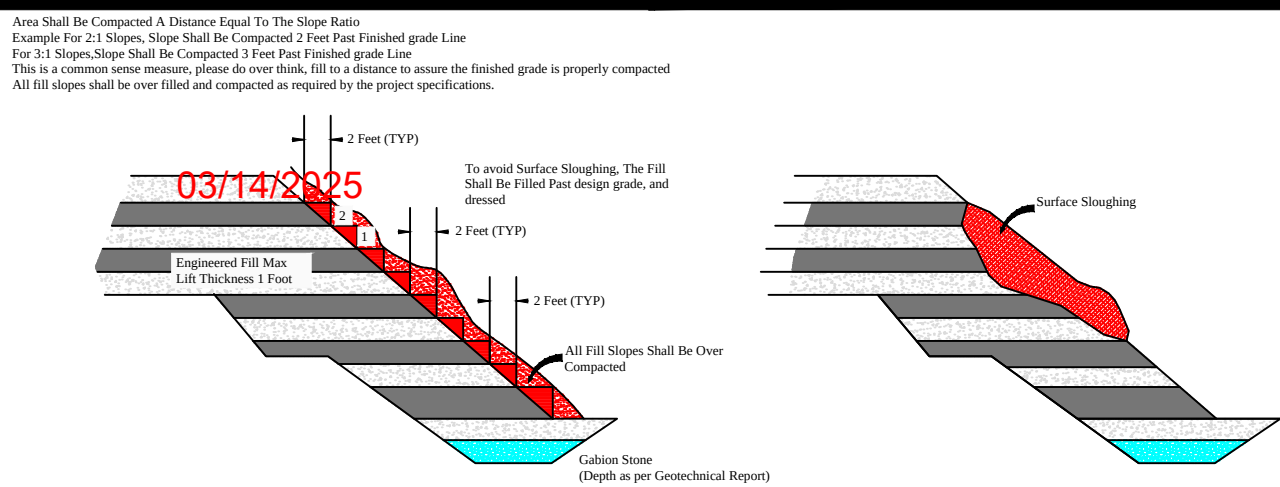


G8 Fill Slope Over-Compaction Detail
Scale: NTS

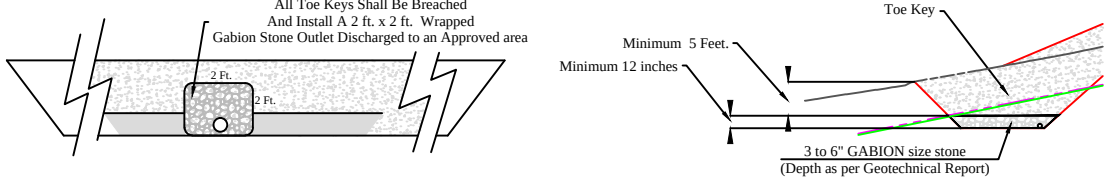

G10 Minimum Typical Toe Key Detail
Scale: NTS


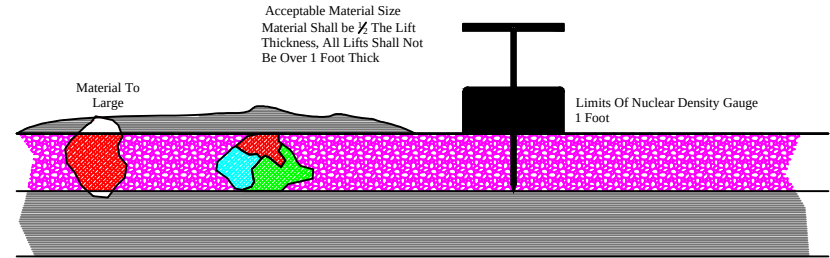


G9 Compaction Testing Detail
Scale: NTS

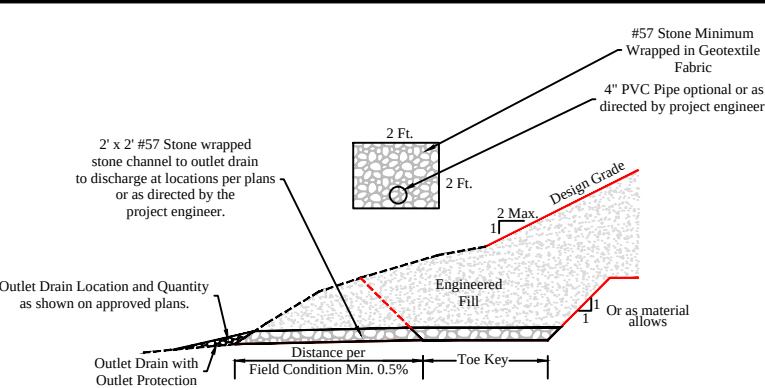

G11 Minimum Toe Key Outlet Drain Detail
Scale: NTS

Exhibit A: As-Built Modification

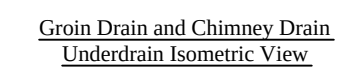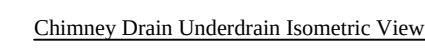

Scale: NTS



Notes:

The Toe Key outlets can be field adjusted depending on the material horizon. The toe key outlet locations are conceptual as shown on the plan with the intent of providing a location that shall guarantee positive drainage away from the Toe Key without impacting environmental or similar resources.

Fill to be Class A Material at 98% Compaction of
ASTM D 698 or as approved by the site
Geotechnical Engineer



Scale: NTS



Kelly Surveying
P.O. Box 254
Dalley, WV 26259
(304)338-6985

Typical Geotechnical Details

1221 Well Site

Teemalls Creek District
Lewis County, WV

APPROVED
WVDEP OOG
Modification
3/14/2025

Date: 02/04/2025
Scale: As Shown
Designed By: ZS
File No.
Sheet G2 of G2

1221 Well Site Fink Creek Access

HG Energy LLC

Exhibit A: As-Built Modification



APPROVED
WVDEP OOG
Modification
3/14/2025

Revision
Design

Date
02-04-2025


THIS DOCUMENT
PREPARED FOR
HG ENERGY LLC


Kelly Surveying
P.O. Box 254
Delmar, WV 26259
304-338-0965

Landowner Exhibit


1221 Well Site
Freemans Creek District
Lewis County, WV

Date: 02/04/2025
Scale: As Shown
Designed By: ZS
File No.
Sheet L1 of L1

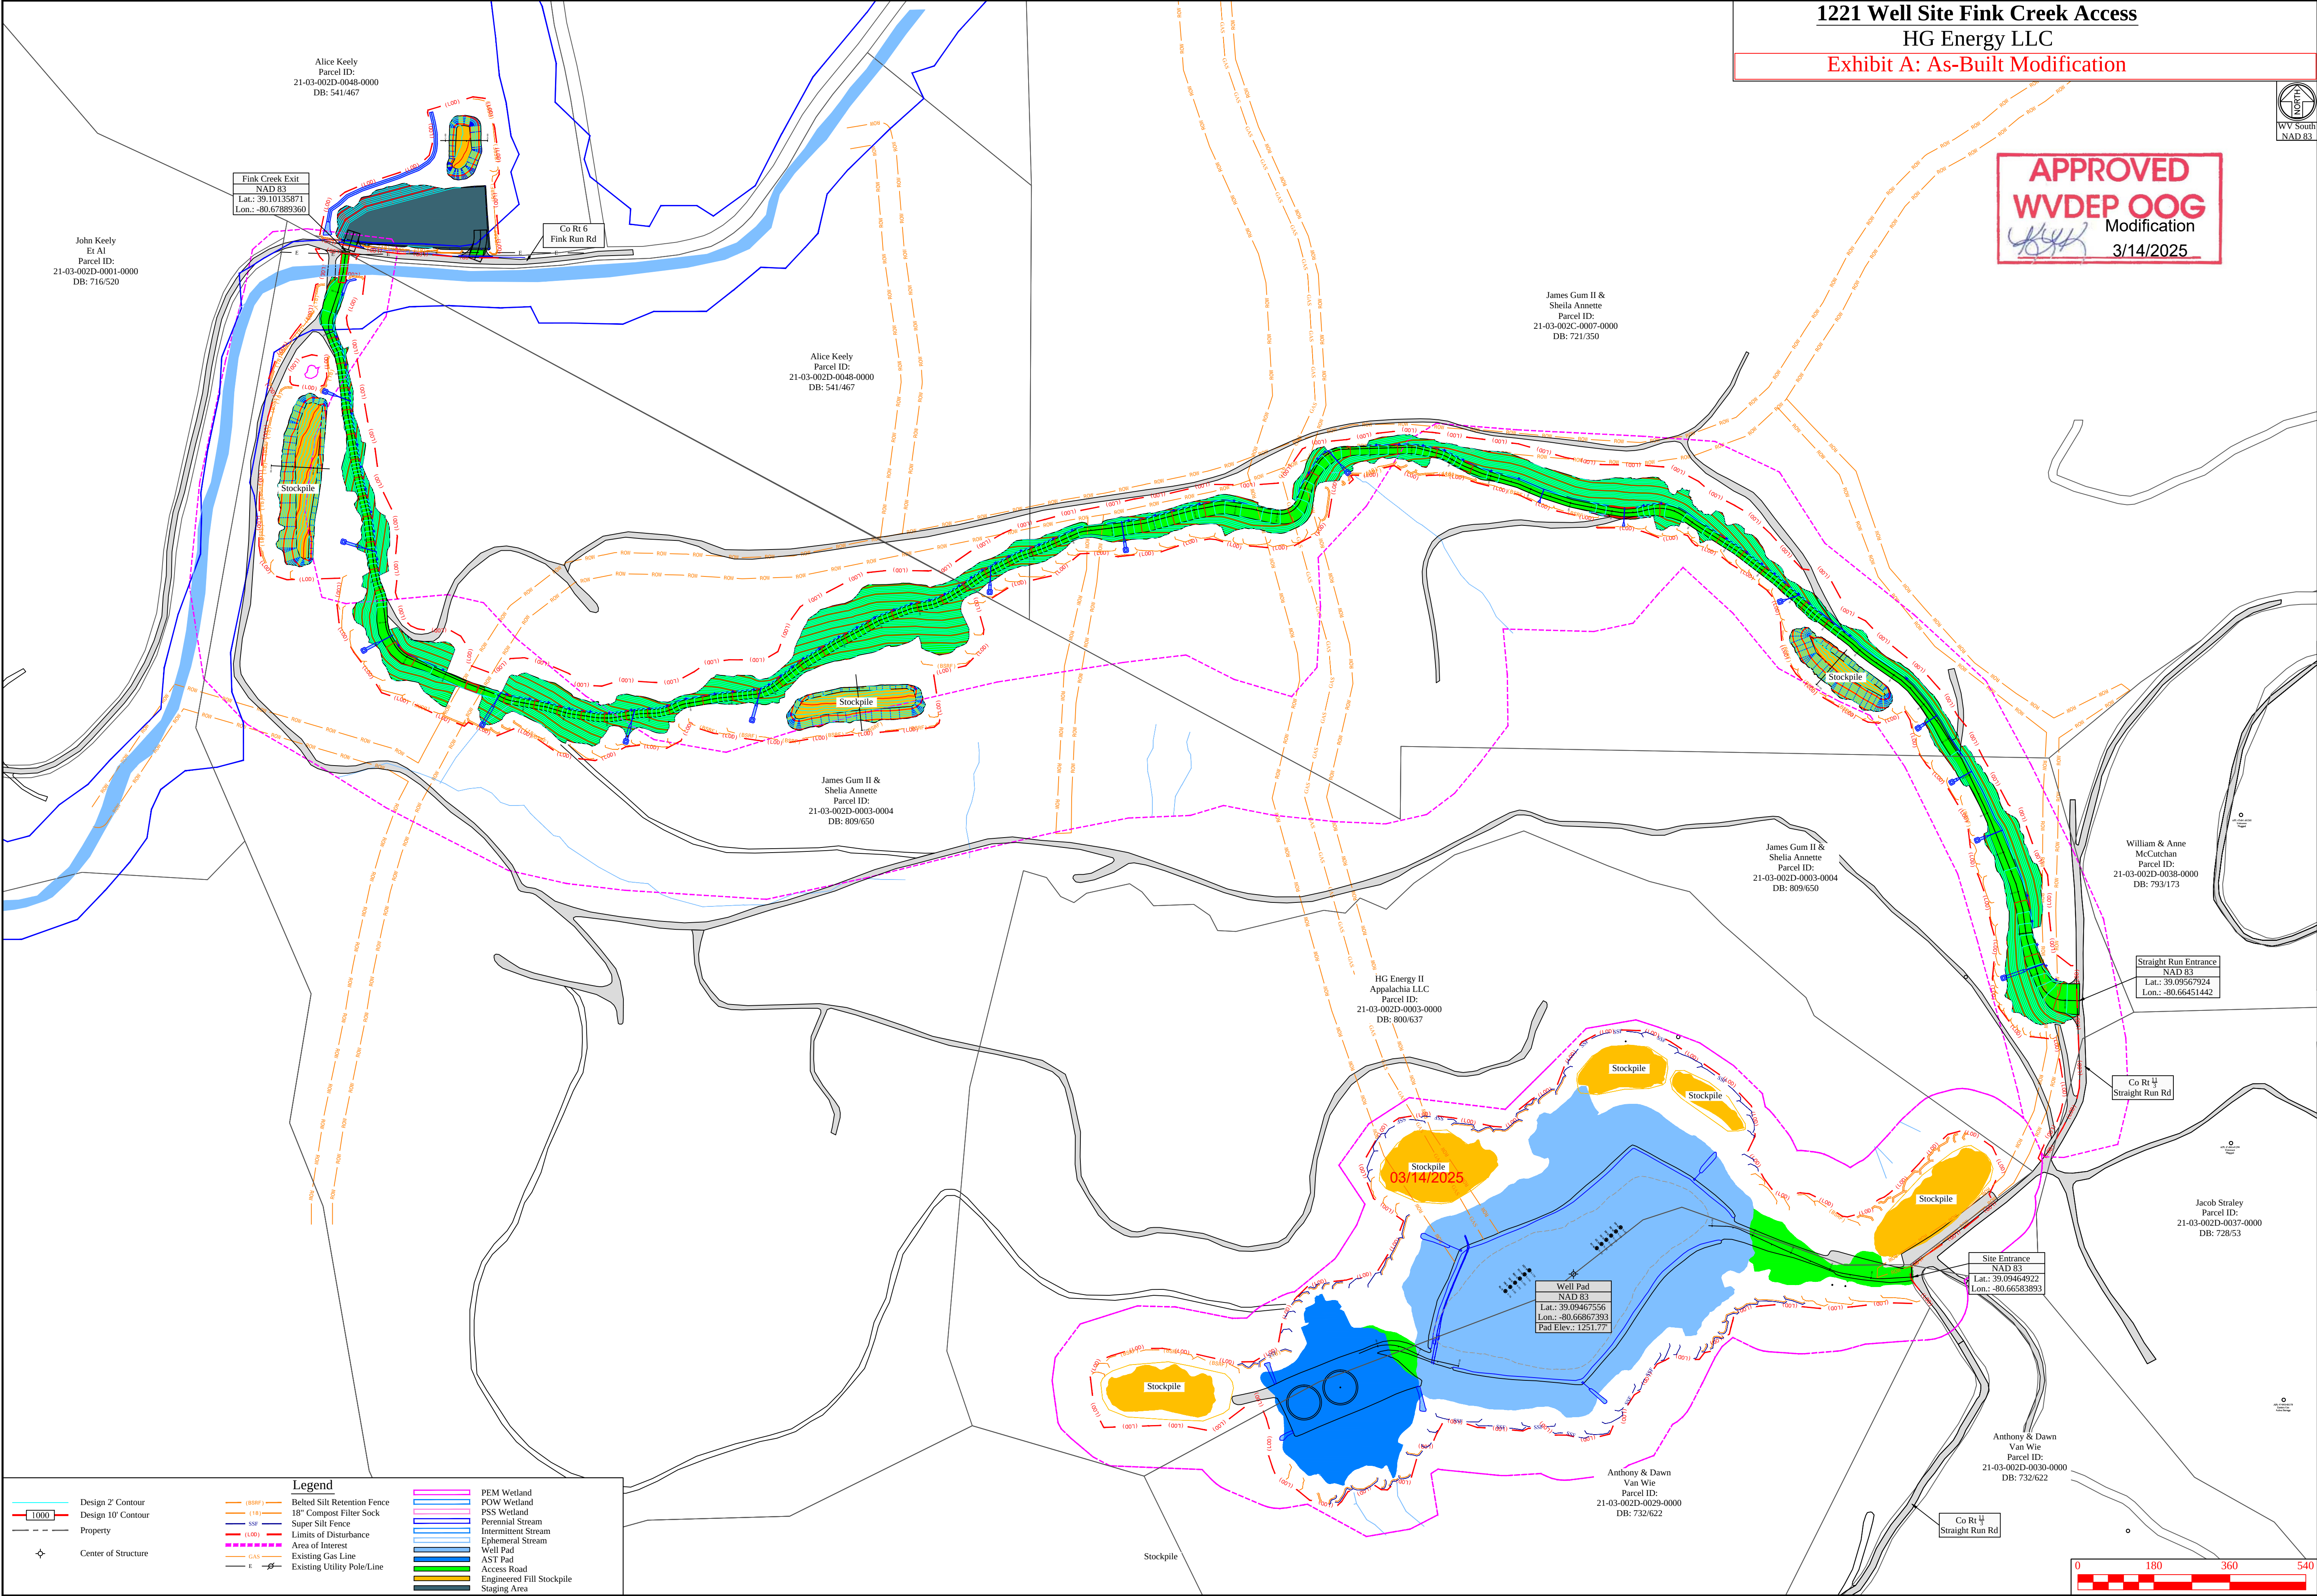

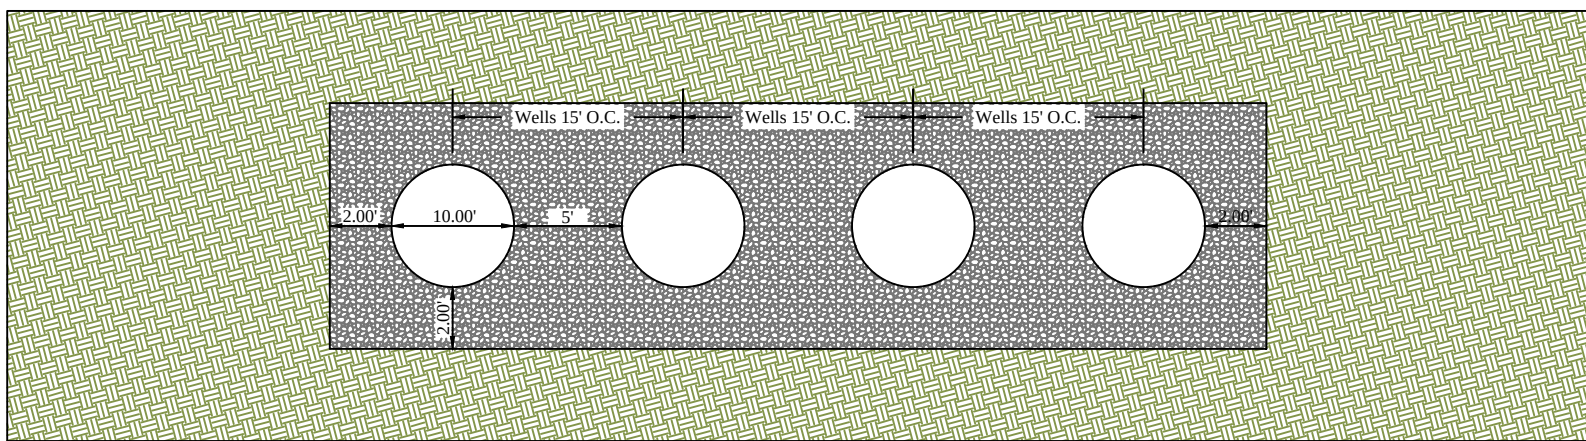


Trench Cellar Plan View

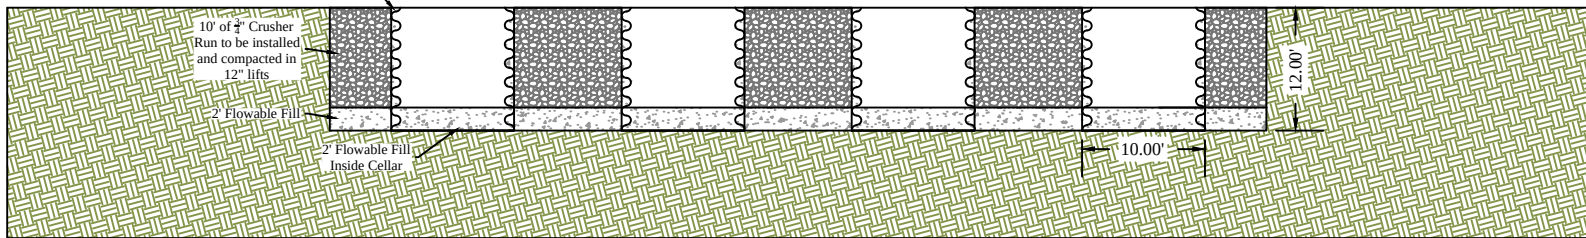


Trench Cellar Section View

M1 Typical Trenched Cellar Detail
Scale: NTS

Note:
All stone placed on the pad and around the cellars shall be compacted.

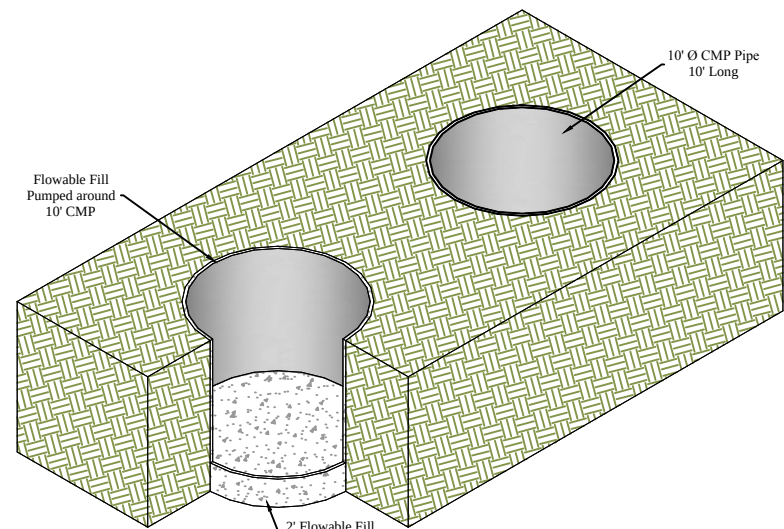


Auger Cellar Plan View

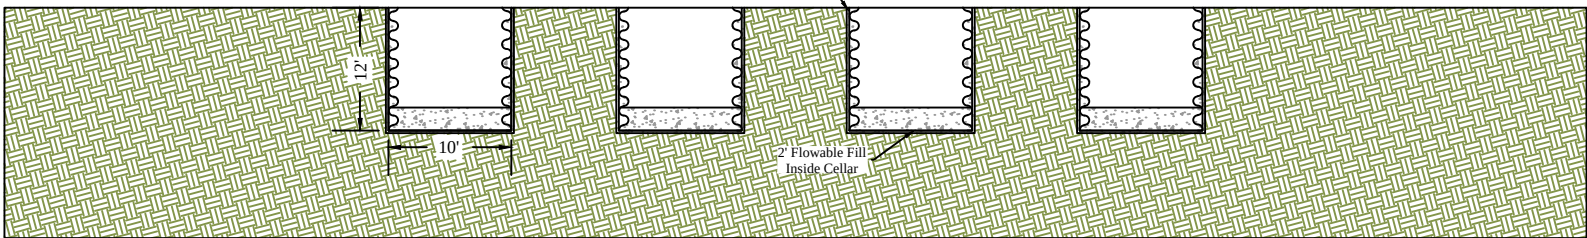

Auger Cellar Section View


M2 Typical Augered Cellar Detail
Scale: NTS

Note:
All stone placed on the pad and around the cellars shall be compacted.

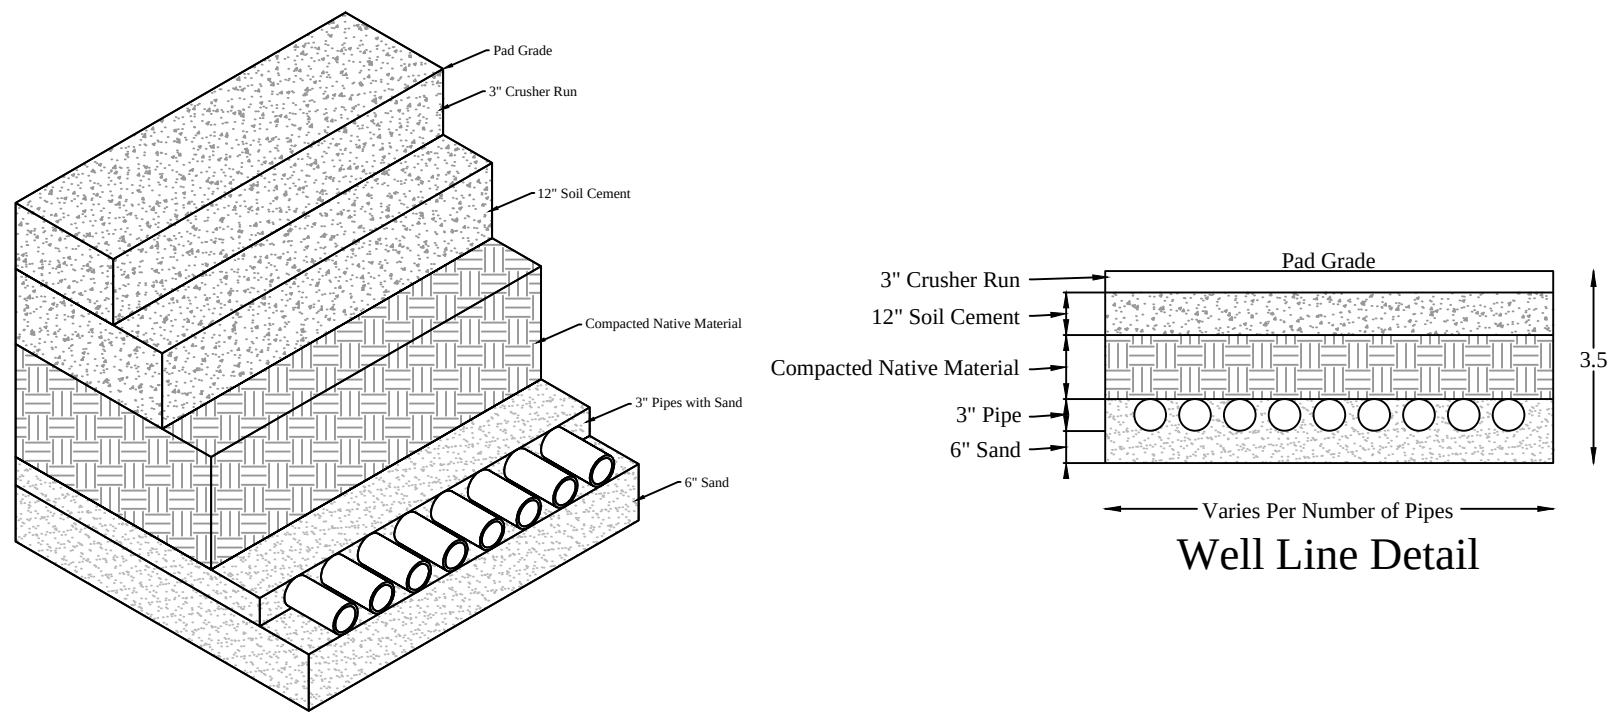


Note:
The number and size of pipe to vary with the well configuration
Sand to be compacted

M3 Typical Well Line Detail
Scale: NTS

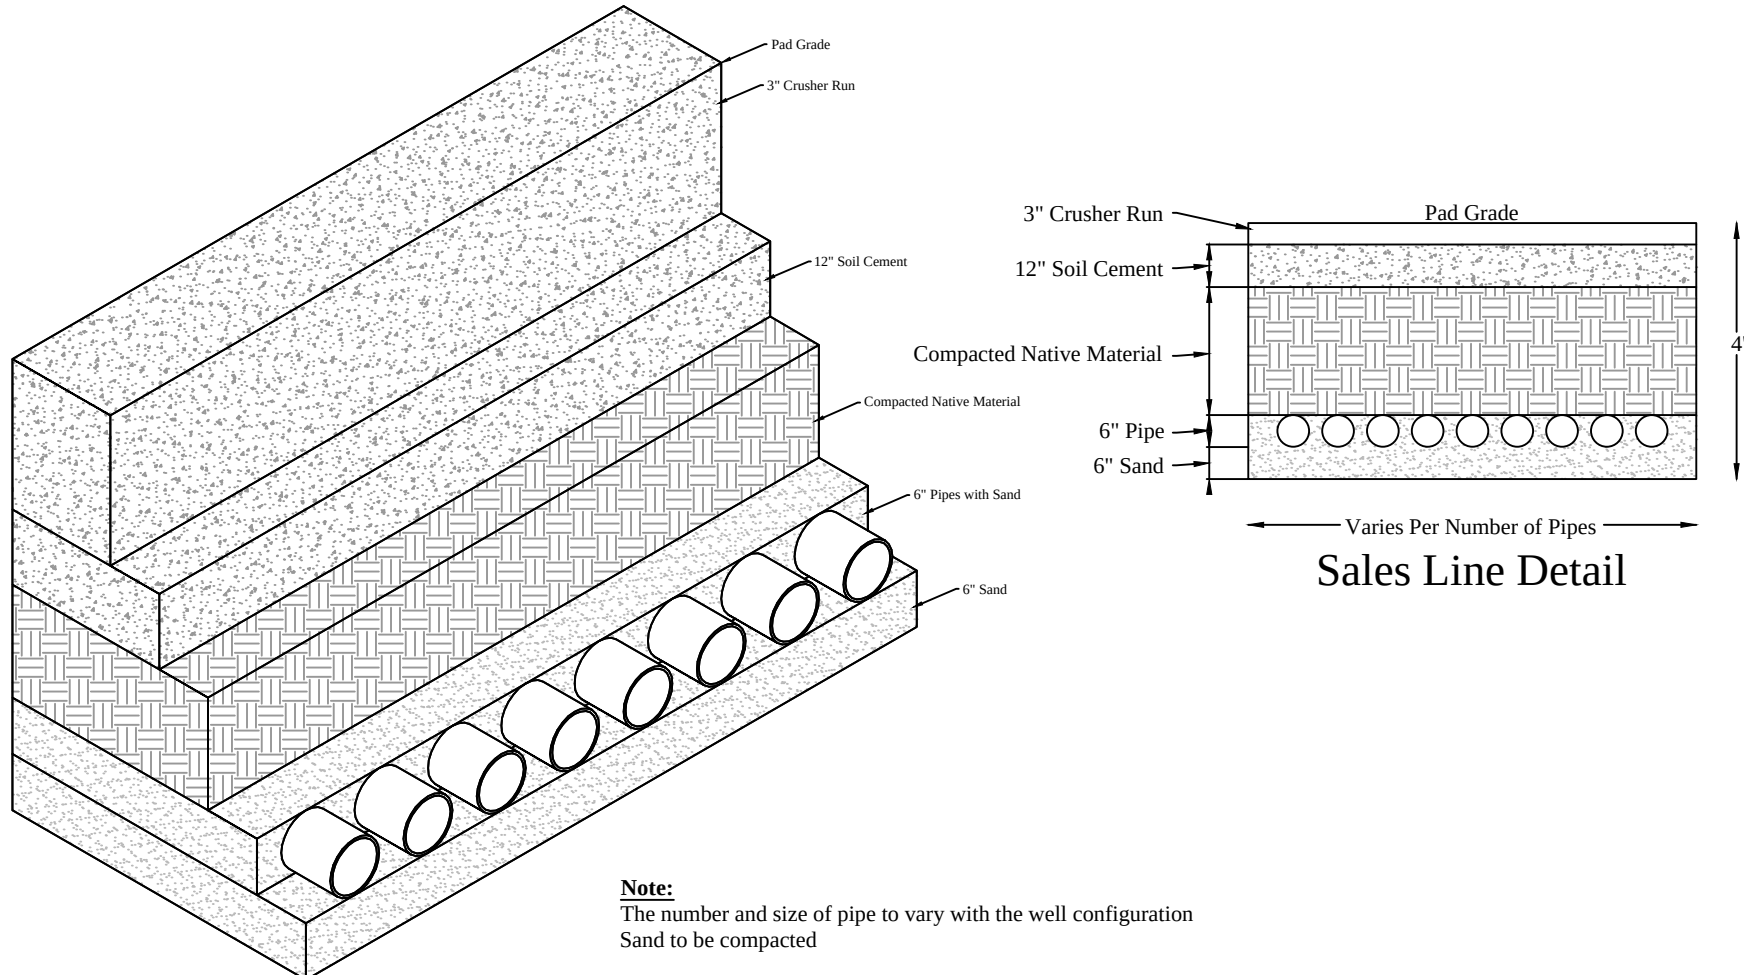


Note:
The number and size of pipe to vary with the well configuration
Sand to be compacted

M4 Typical Sales Line Detail
Scale: NTS

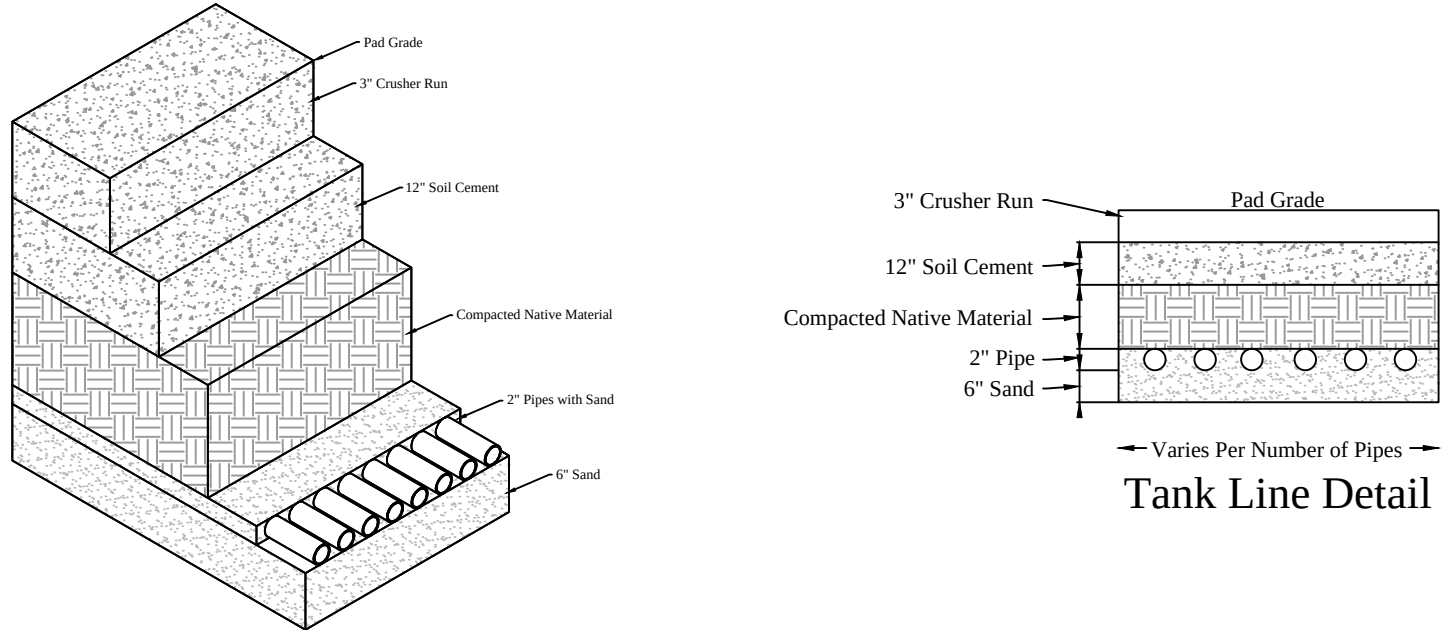


Note:
The number and size of pipe to vary with the well configuration
Sand to be compacted

M5 Typical Tank Line Detail
Scale: NTS

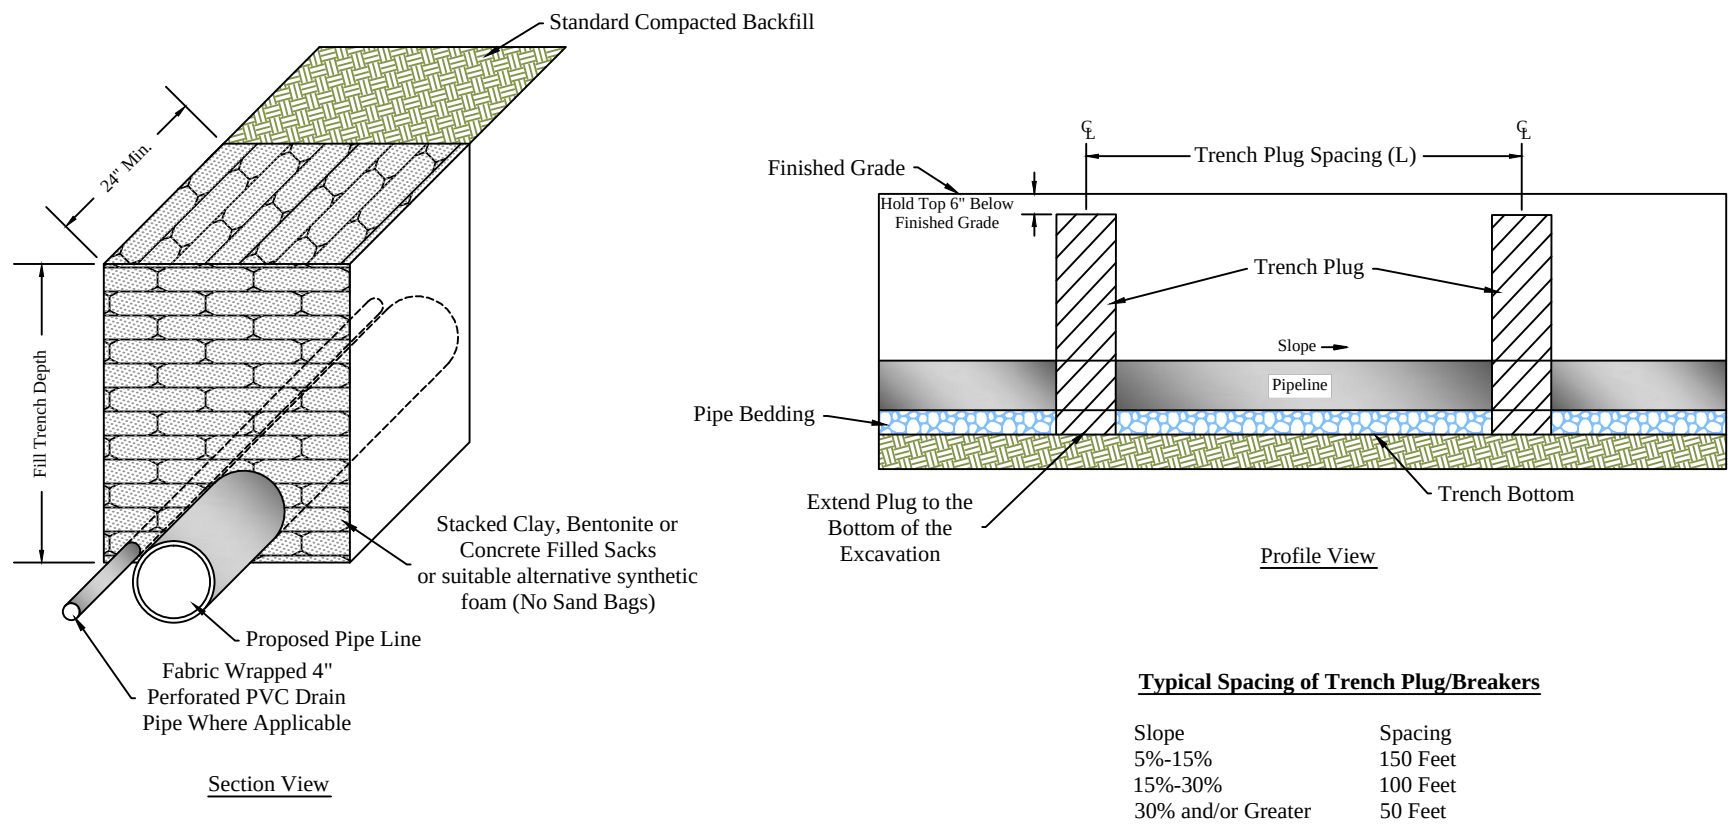

Typical Spacing of Trench Plug/Breakers	
Slope	Spacing
5%-15%	150 Feet
15%-30%	100 Feet
30% and/or Greater	50 Feet

M6 Typical Impervious Trench Plug/Breaker
Scale: NTS

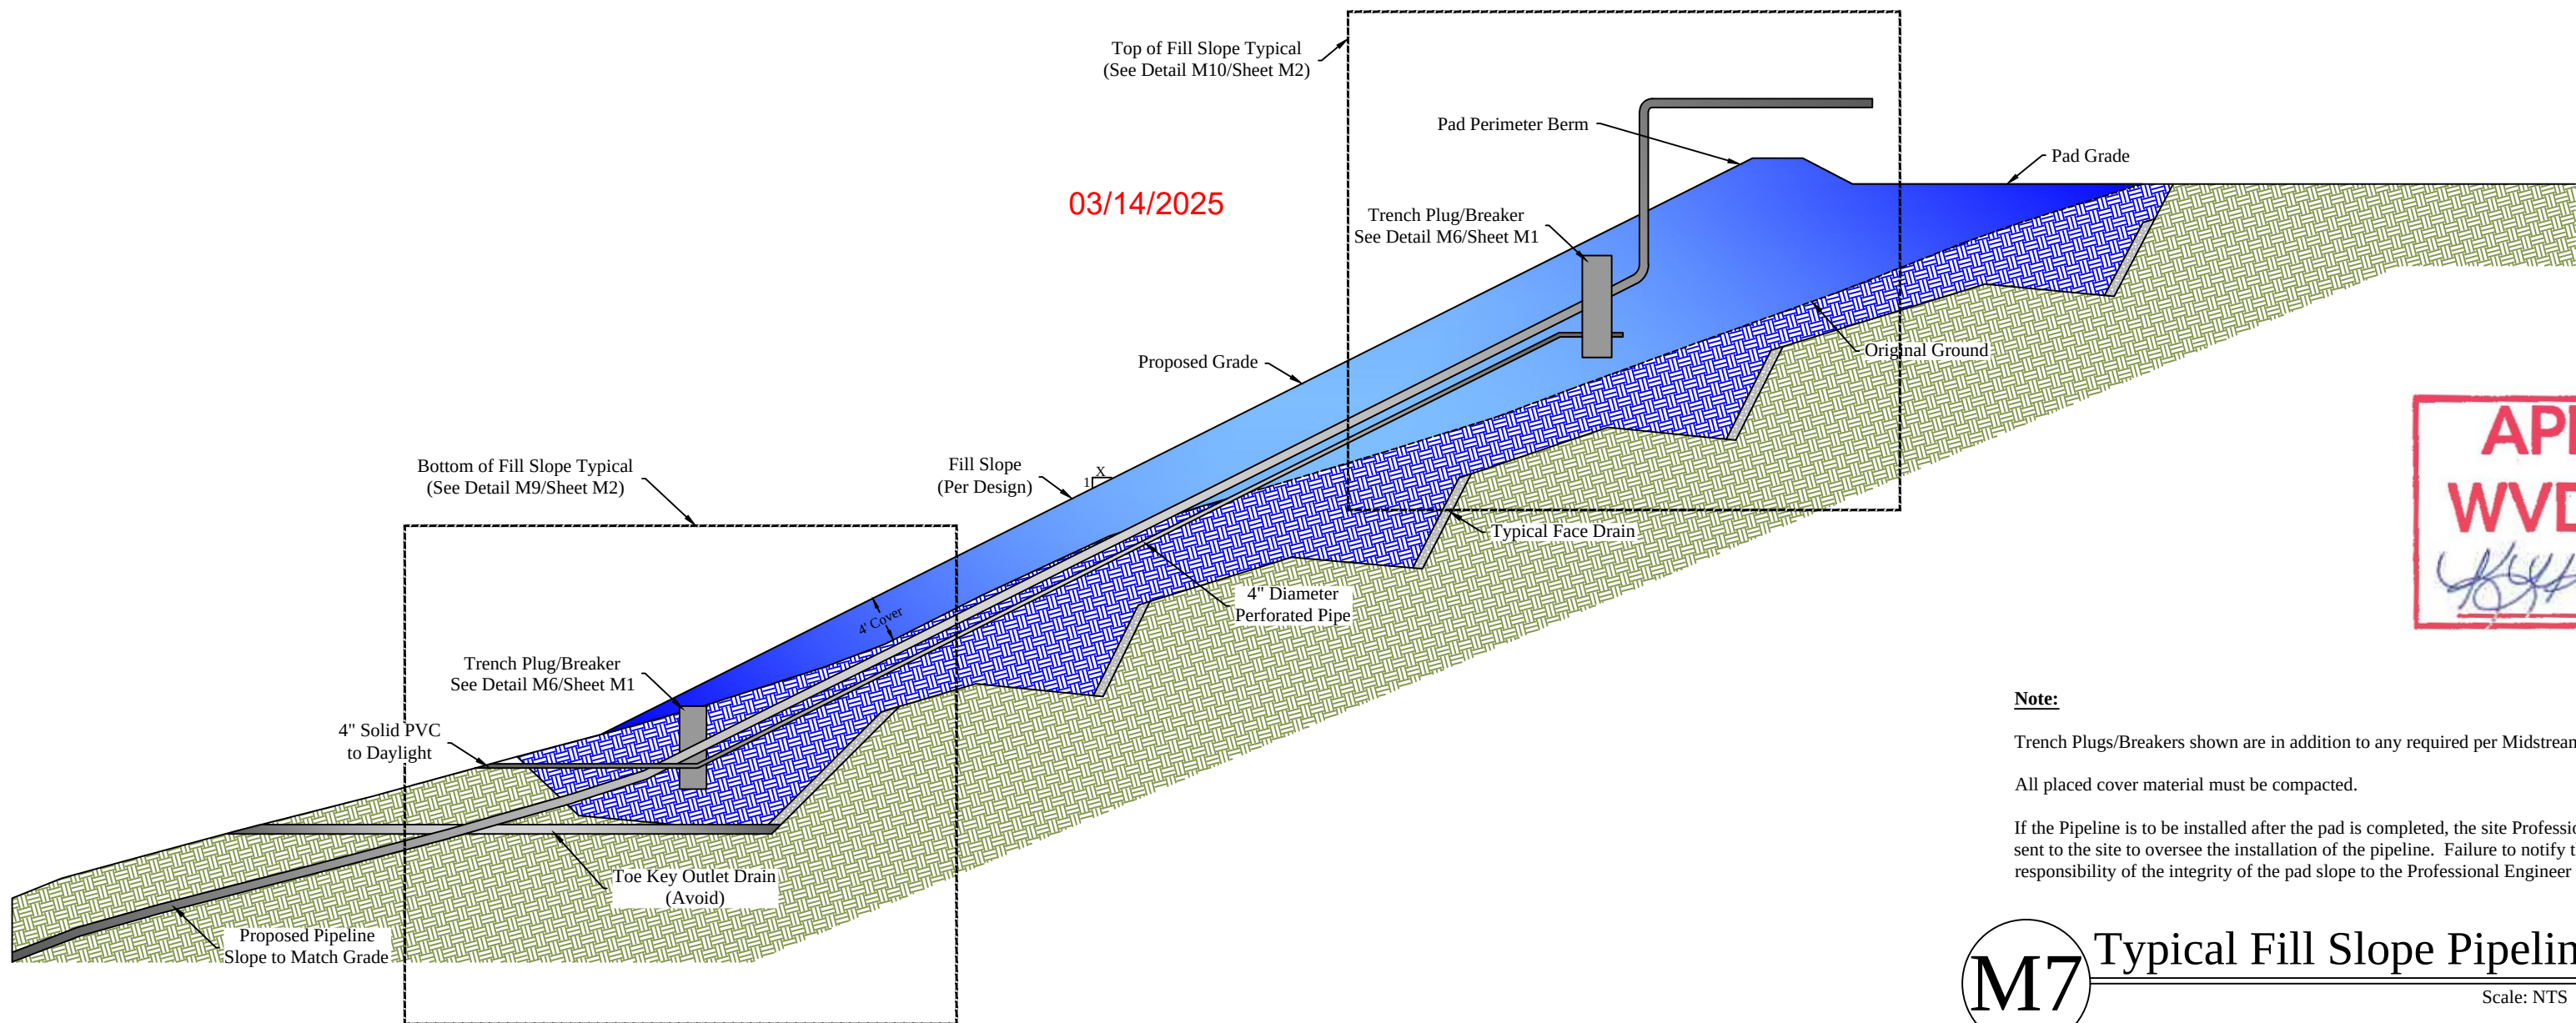

Note:
Trench Plugs/Breakers shown are in addition to any required per Midstream Plans/Details for the Proposed Pipeline.
All placed cover material must be compacted.

If the Pipeline is to be installed after the pad is completed, the site Professional Engineer must be contacted and an inspector sent to the site to oversee the installation of the pipeline. Failure to notify the site Professional Engineer will transfer the responsibility of the integrity of the pad slope to the Professional Engineer who designed the pipeline.

M7 Typical Fill Slope Pipeline Installation Section
Scale: NTS

Revision

Design

Date

02-04-2025



THIS DOCUMENT
PREPARED FOR
HG ENERGY LLC











Typical Midstream Production Details

1221 Well Site

Freemans Creek District
Lewis County, WV

Date: 02/04/2025
Scale: As Shown
Designed By: ZS
File No.
Sheet M1 of M2

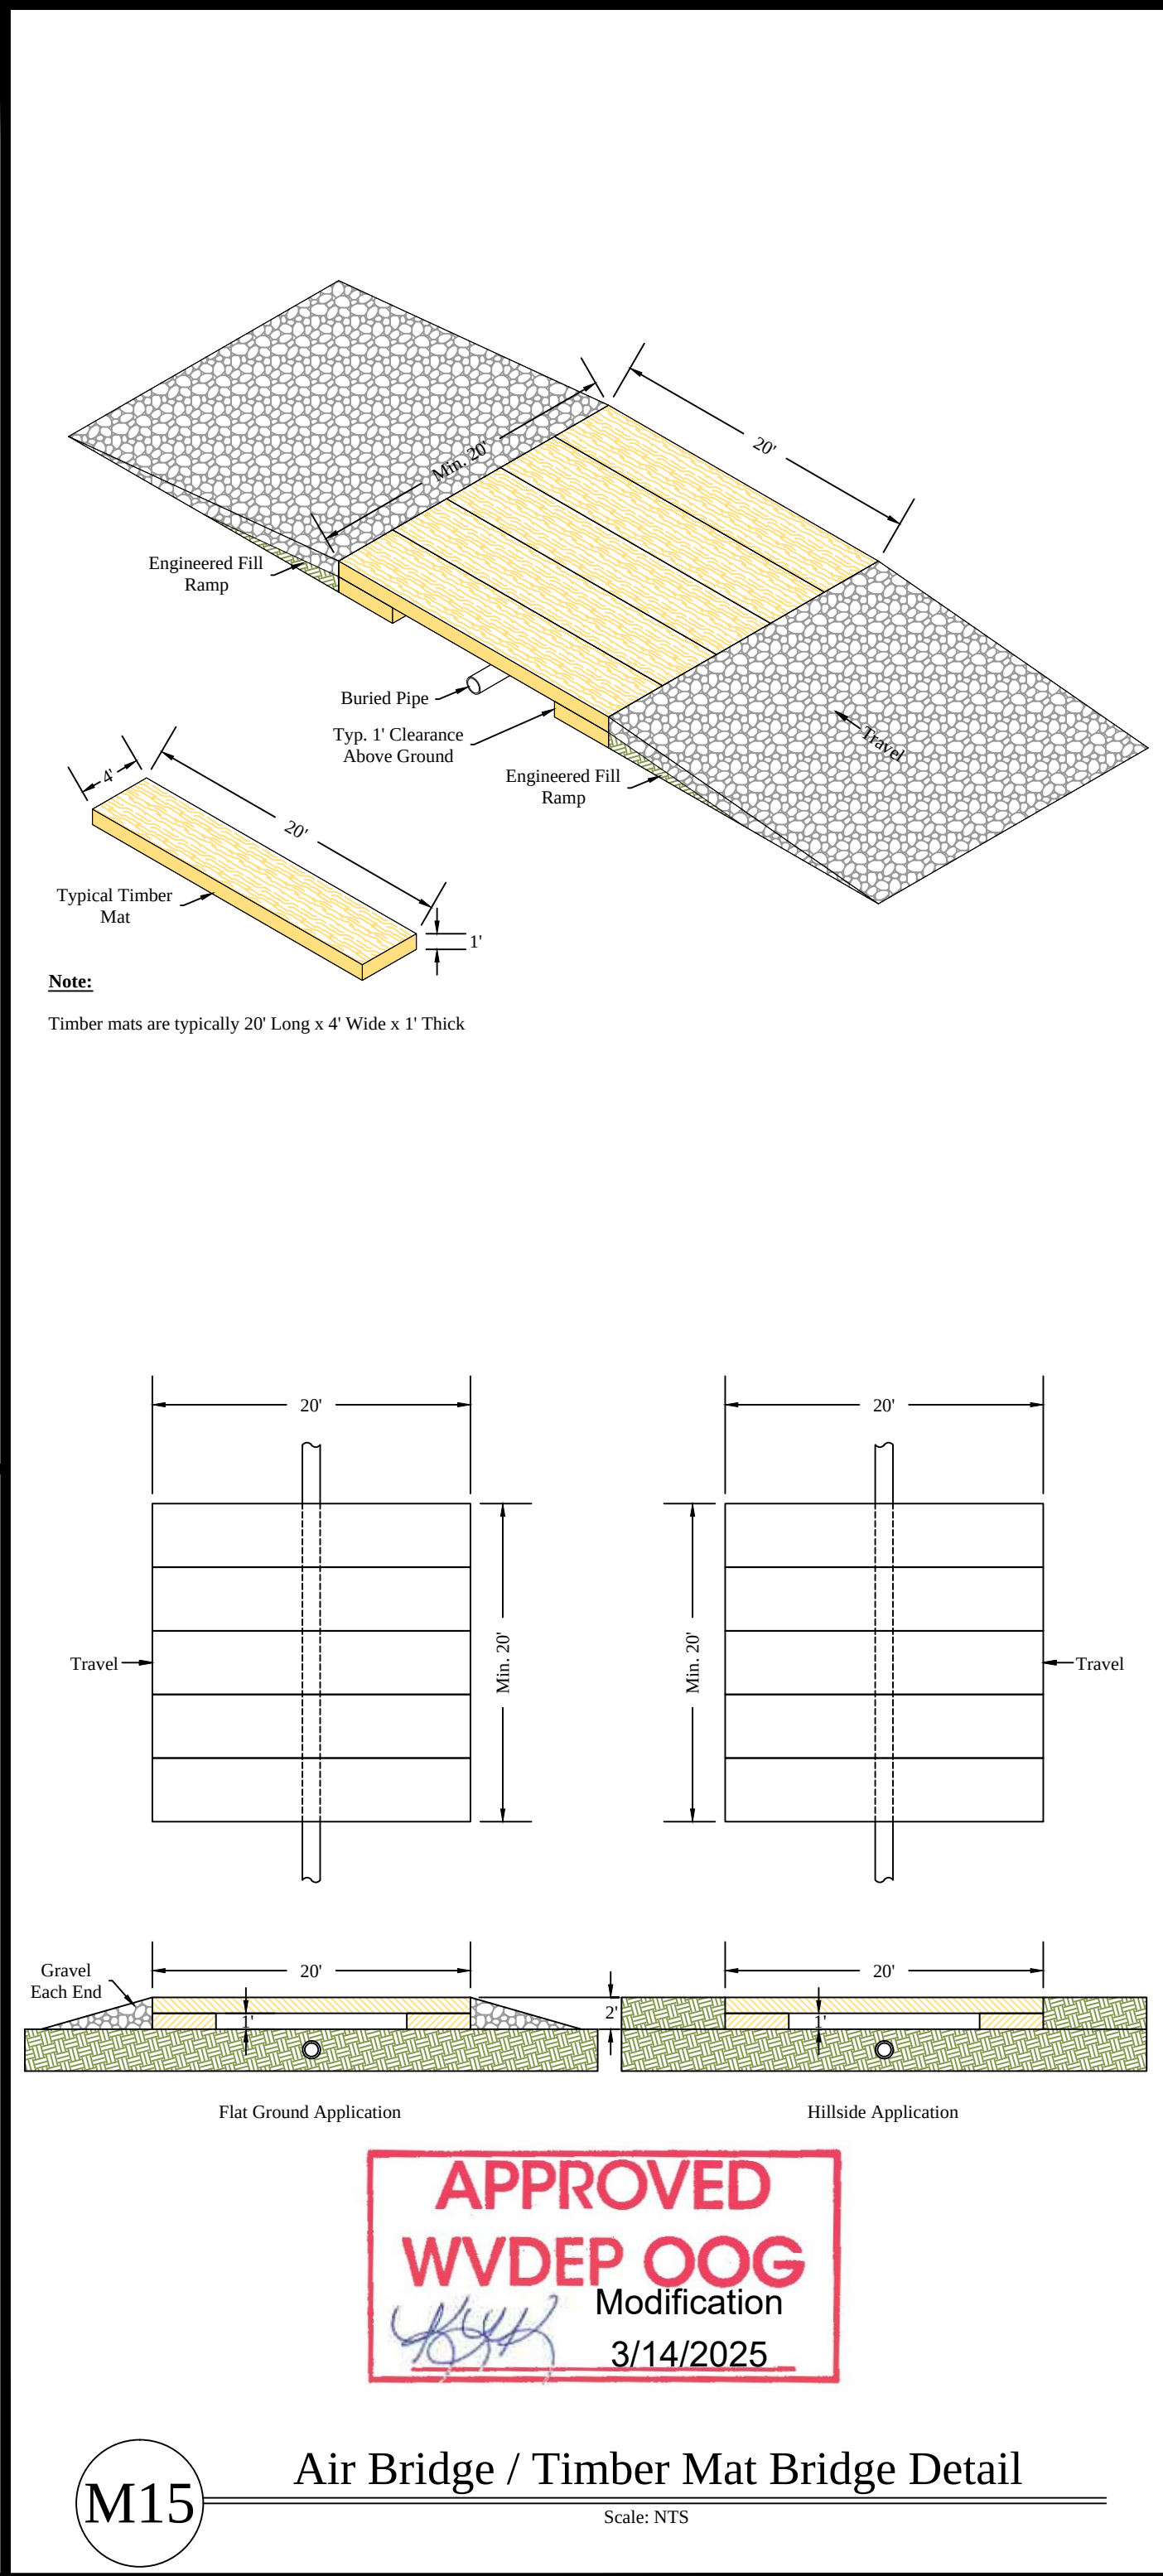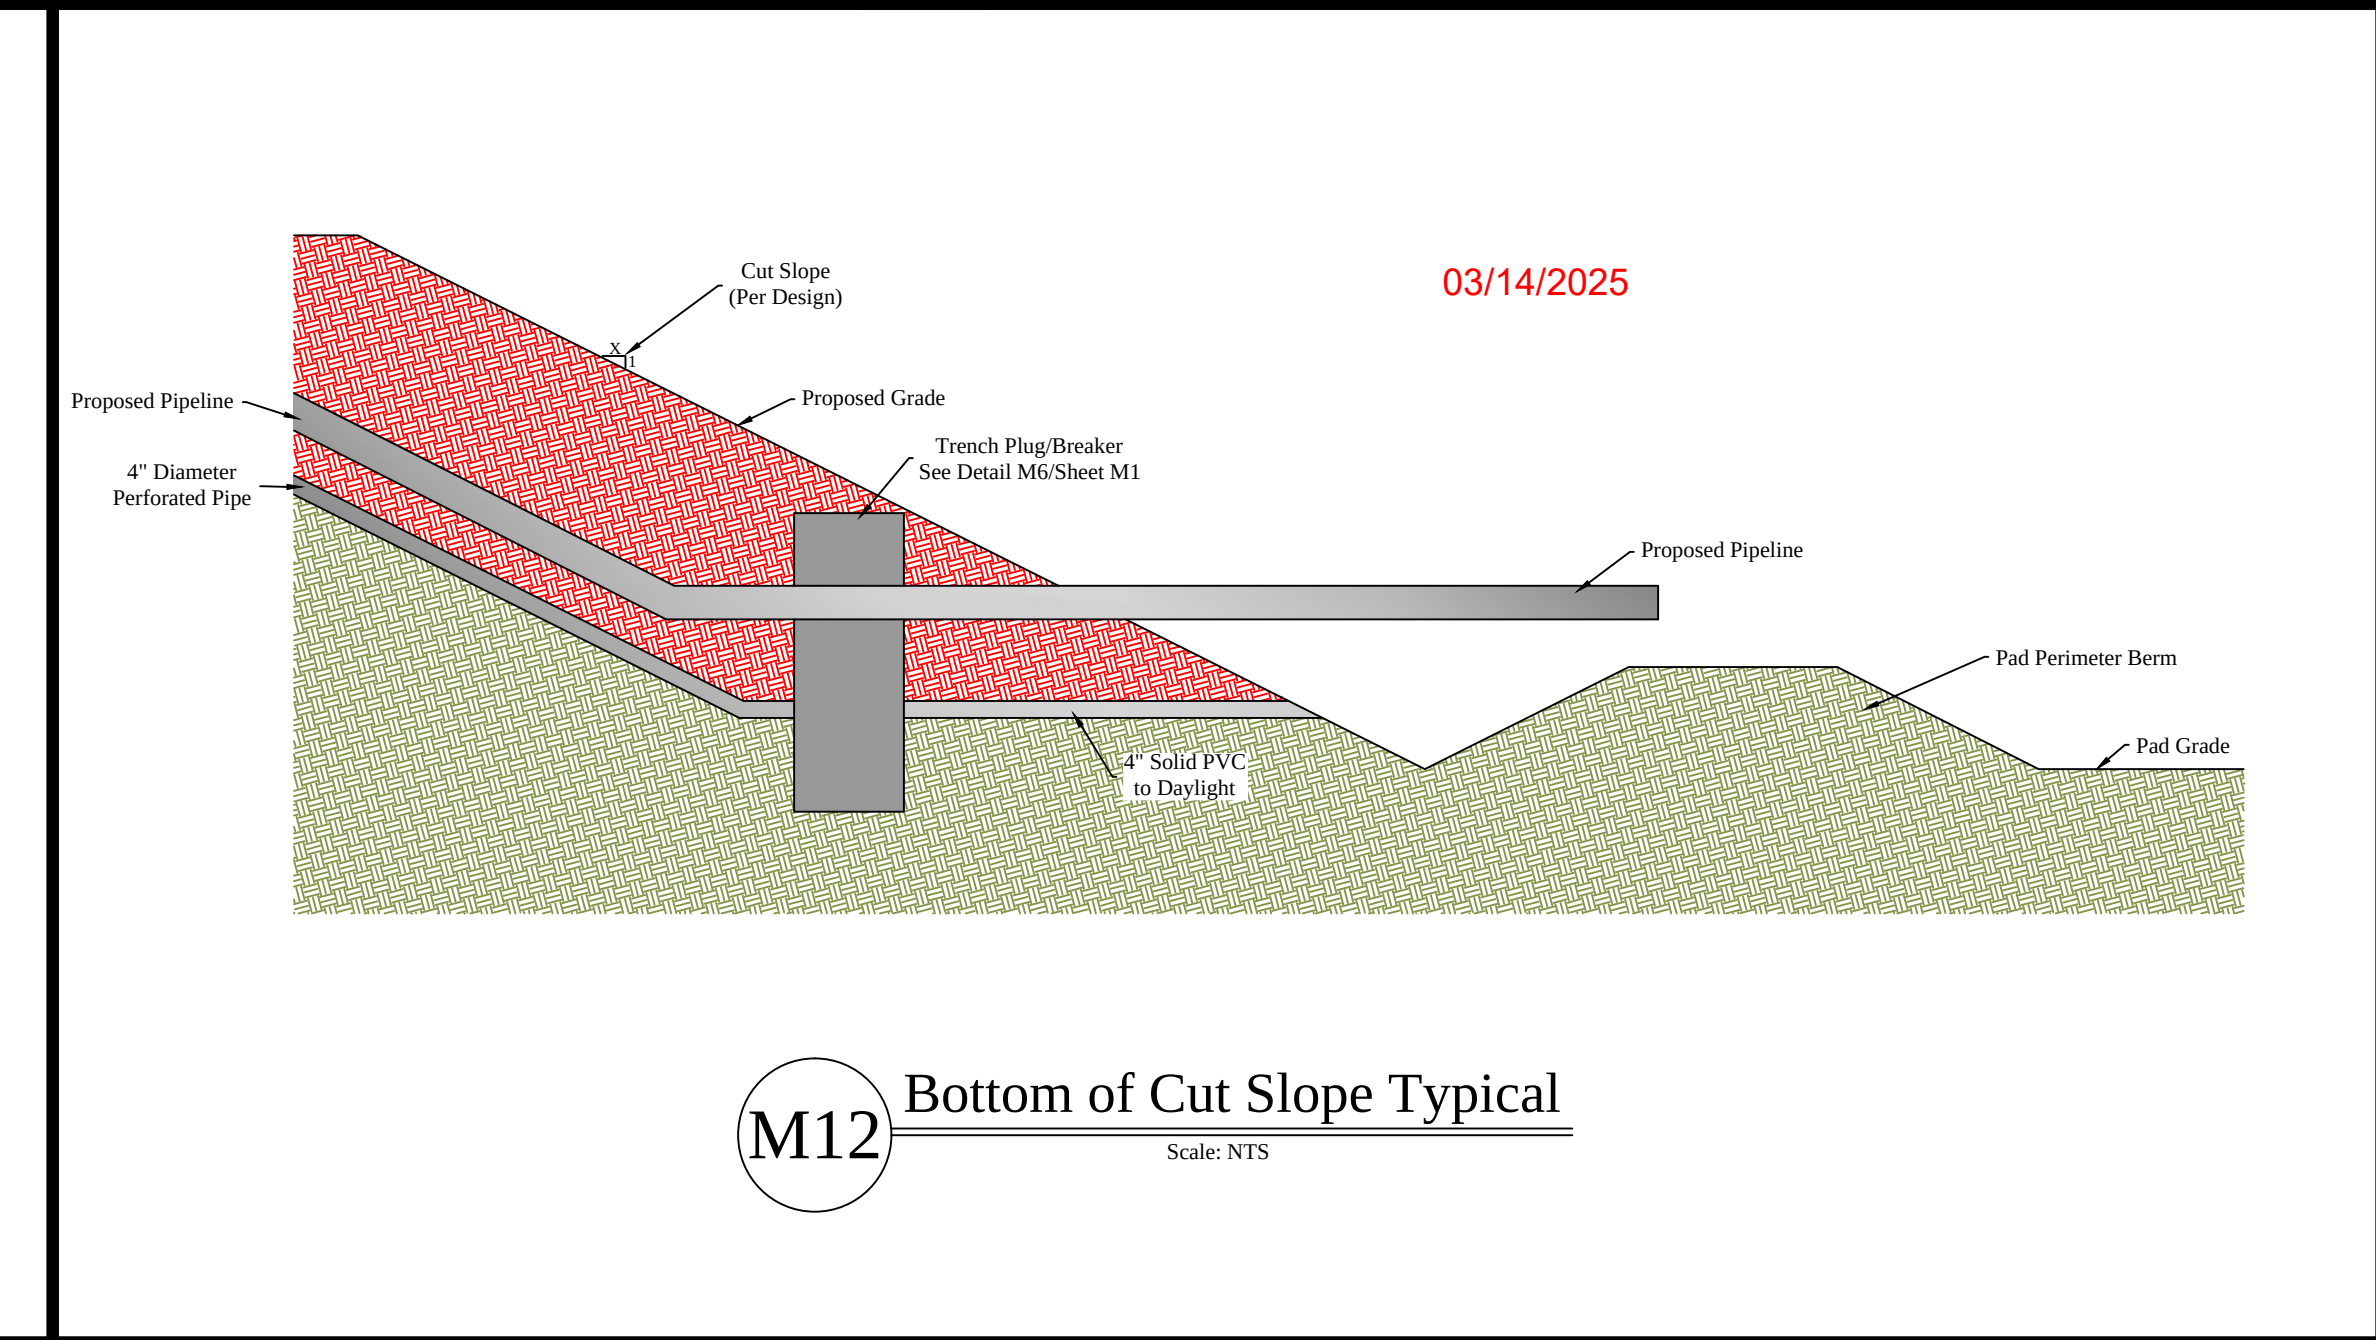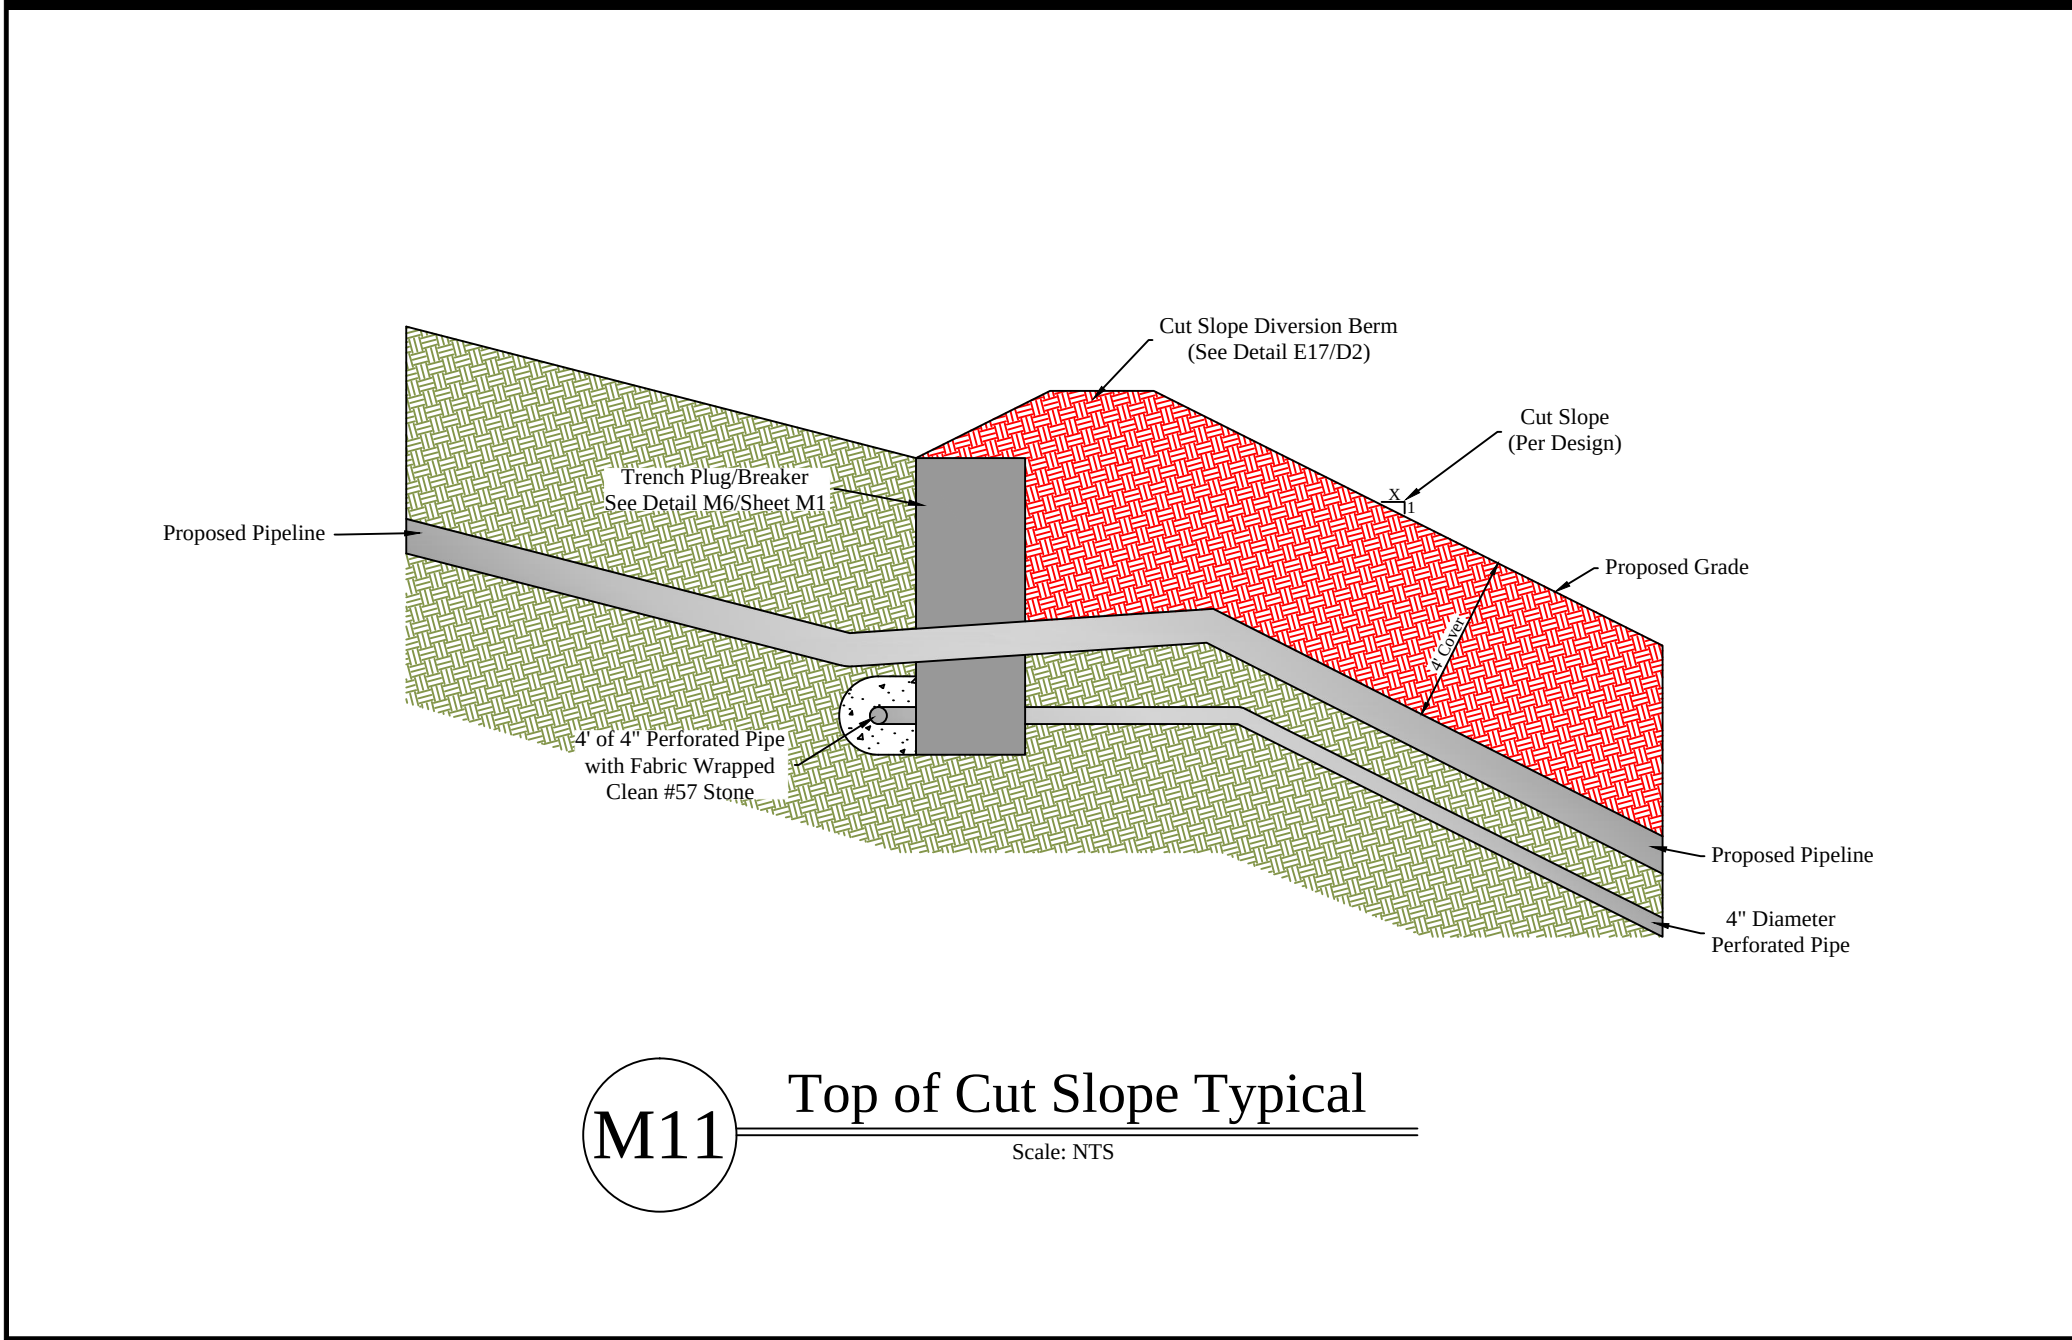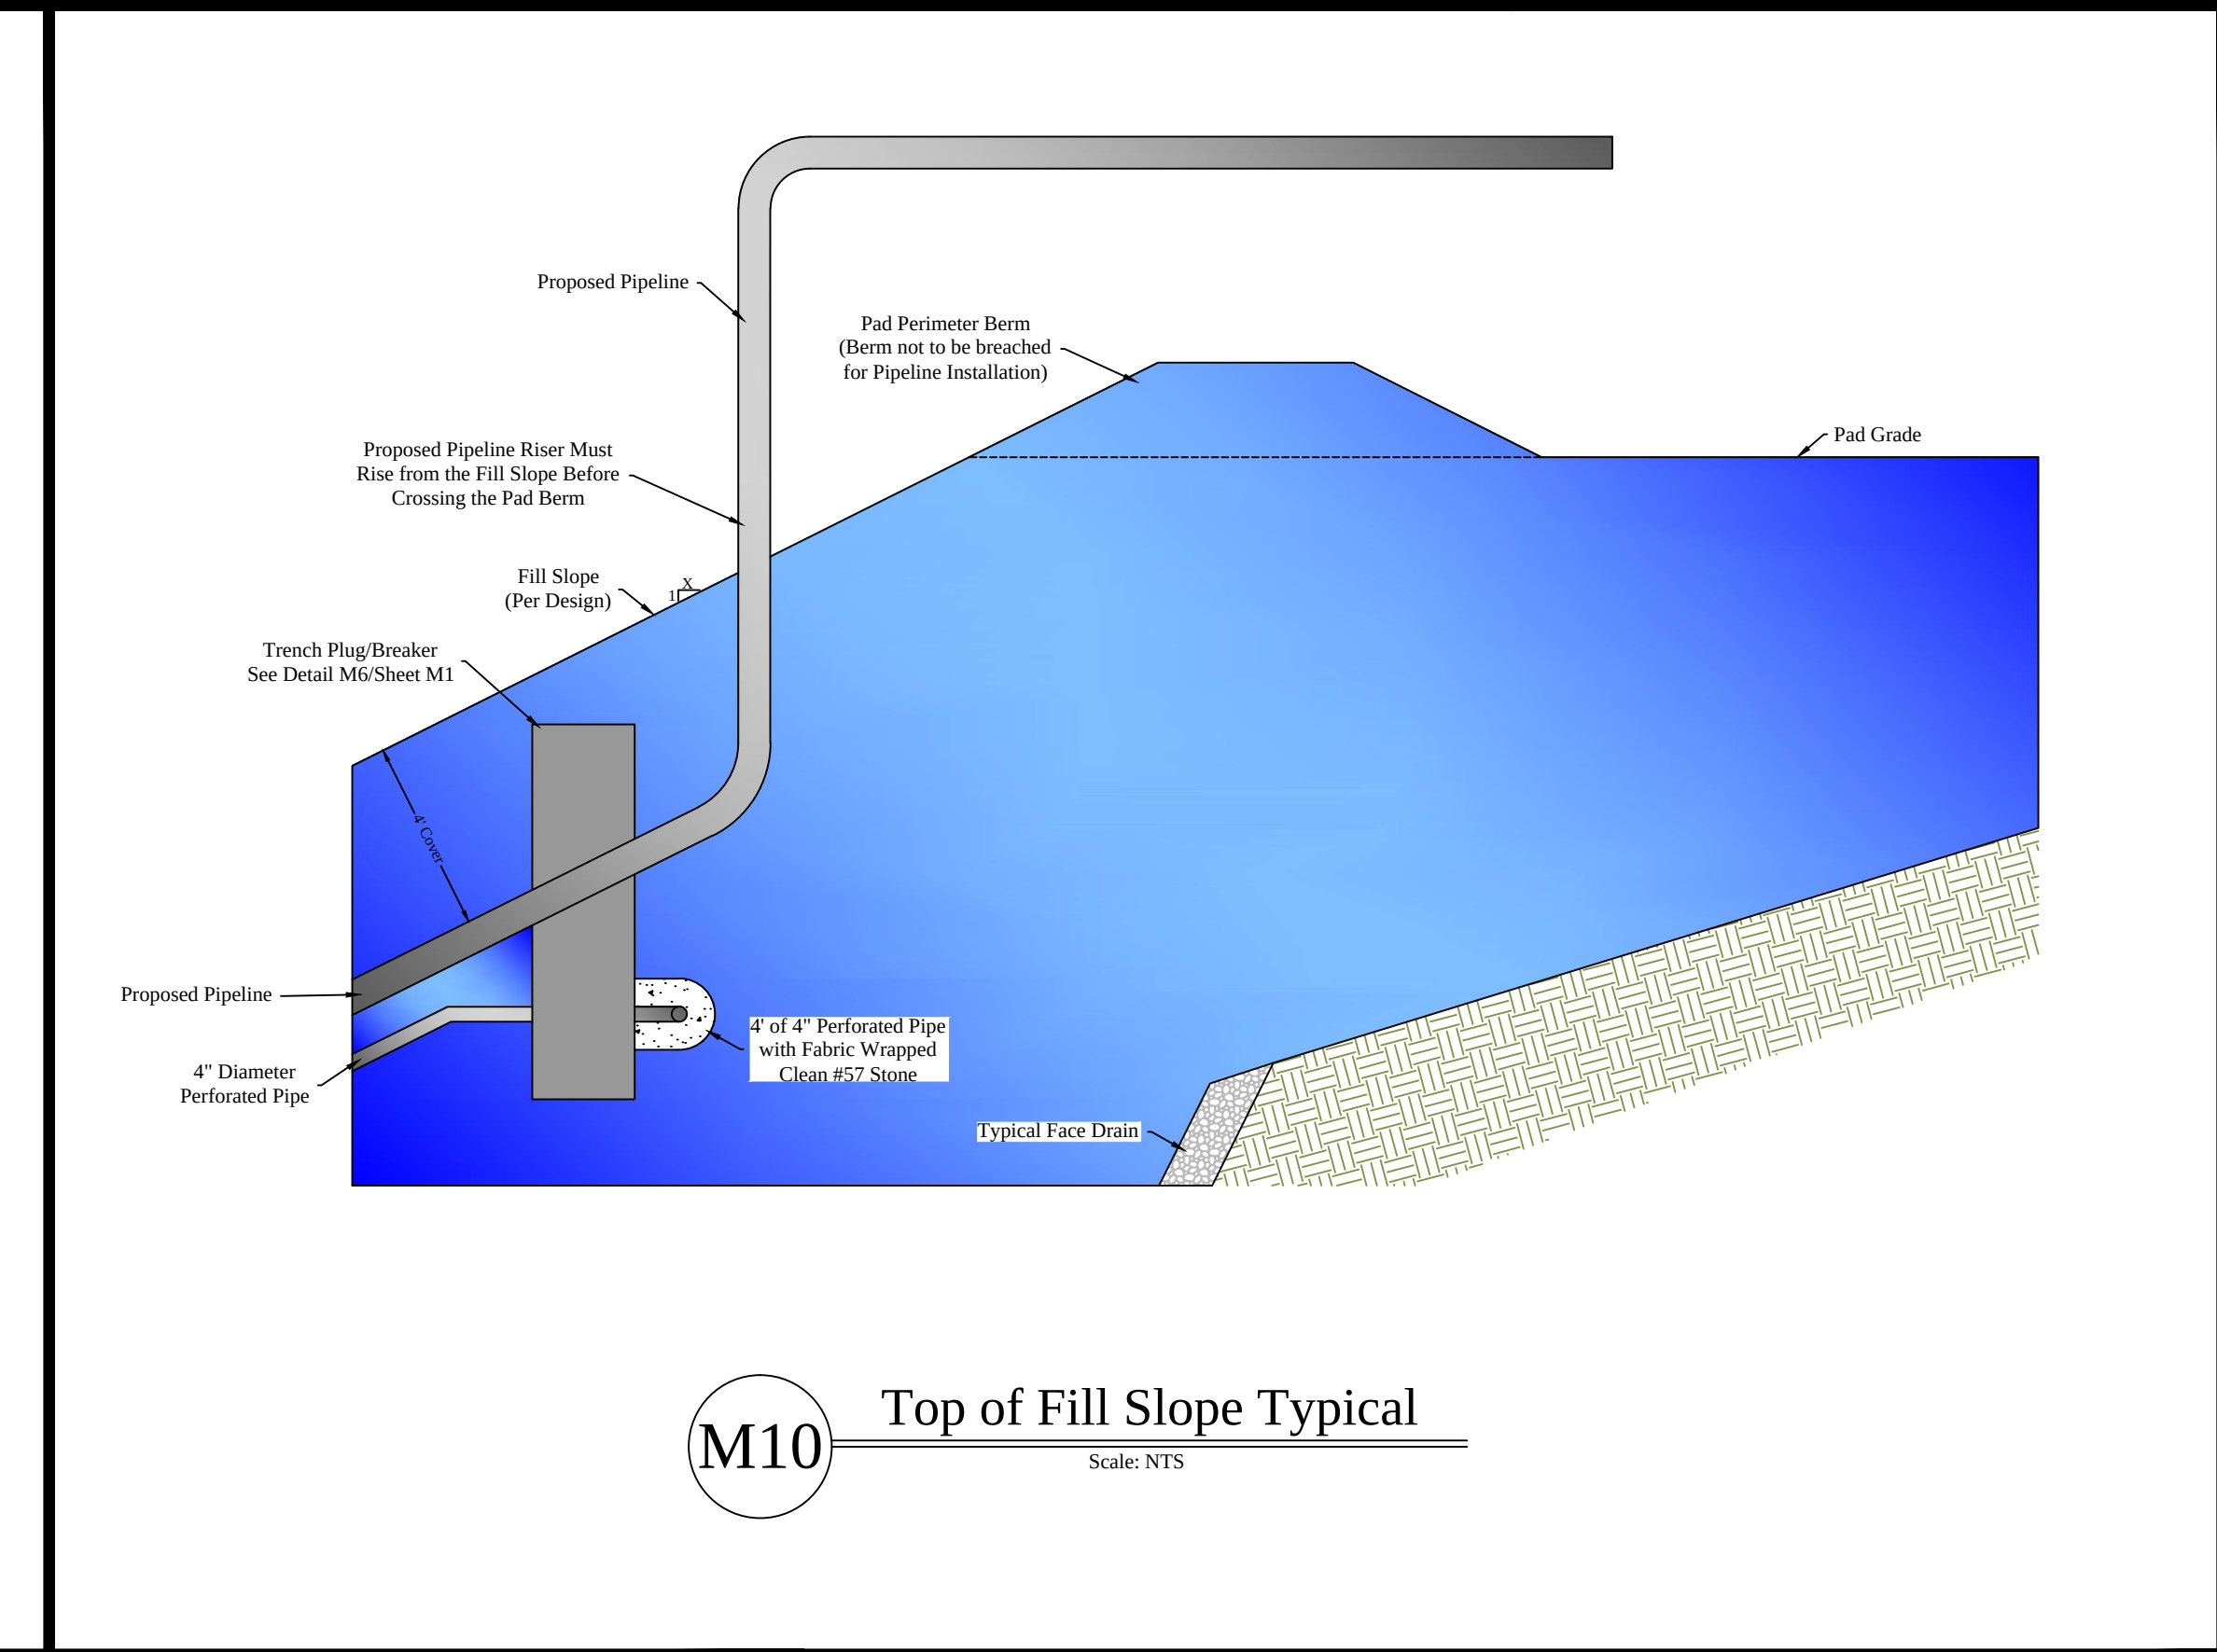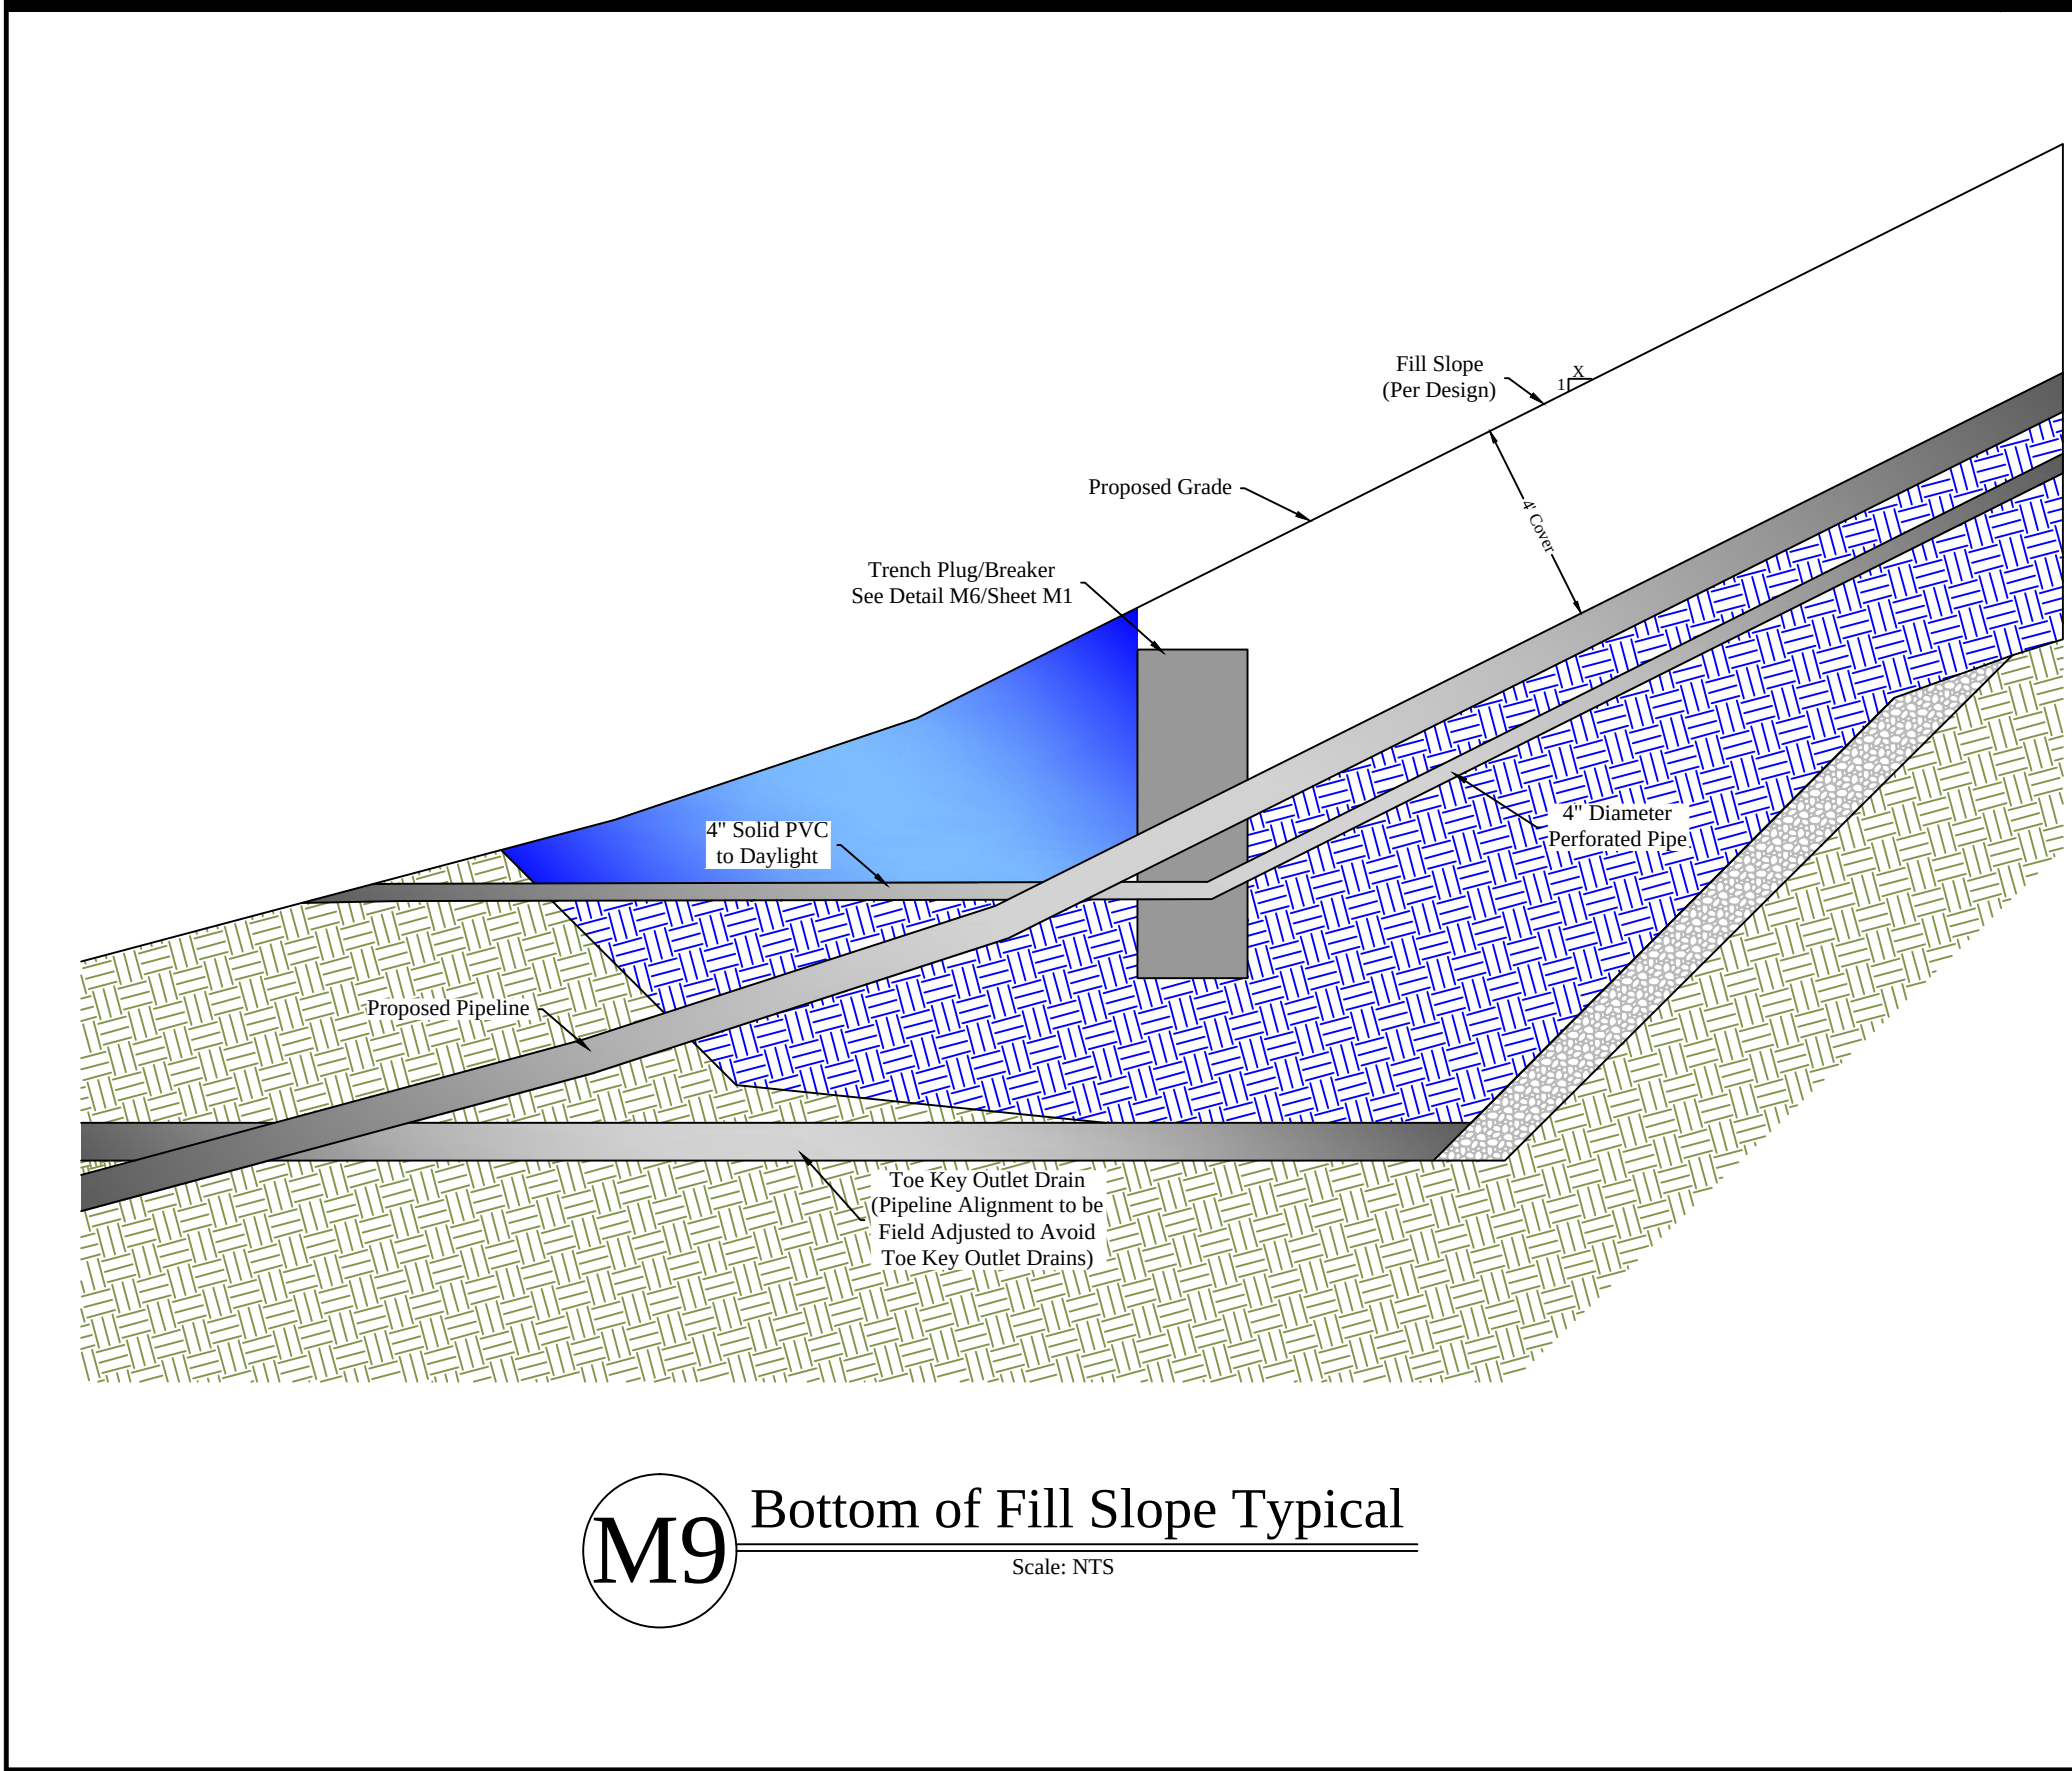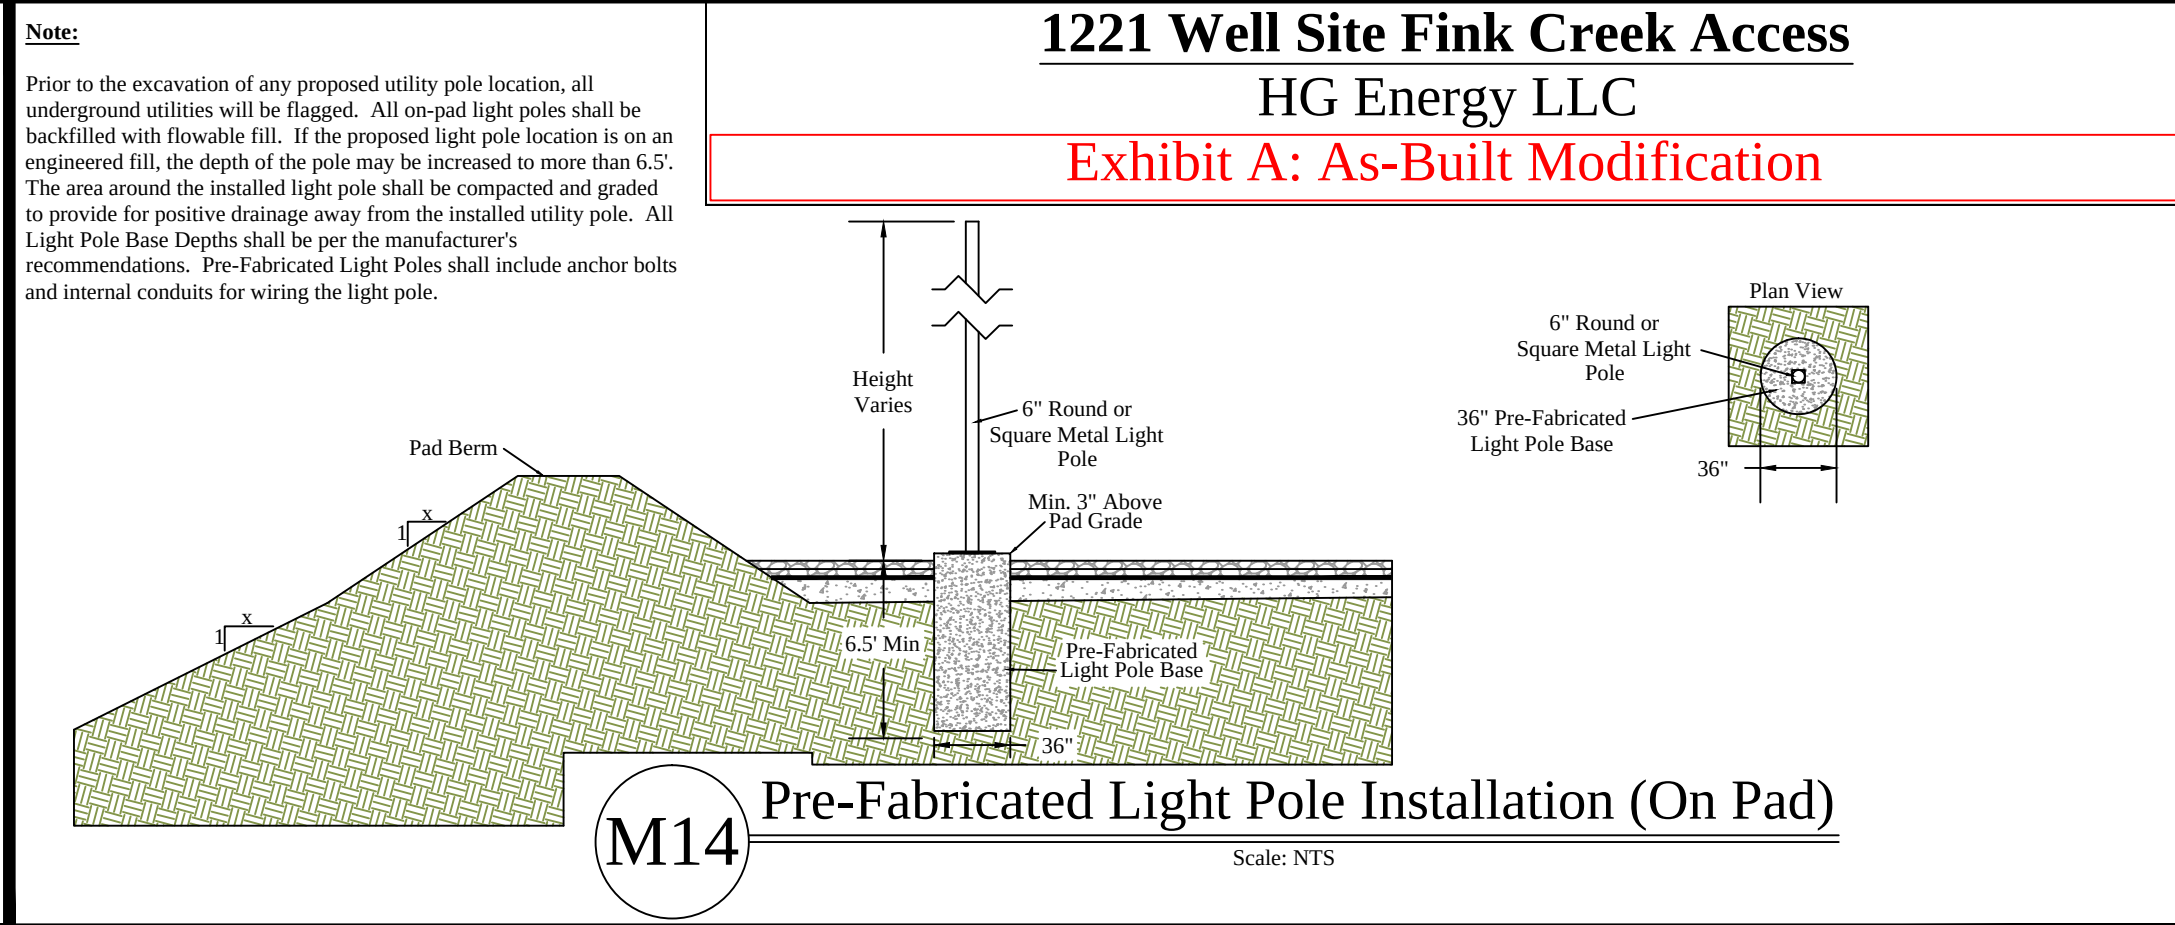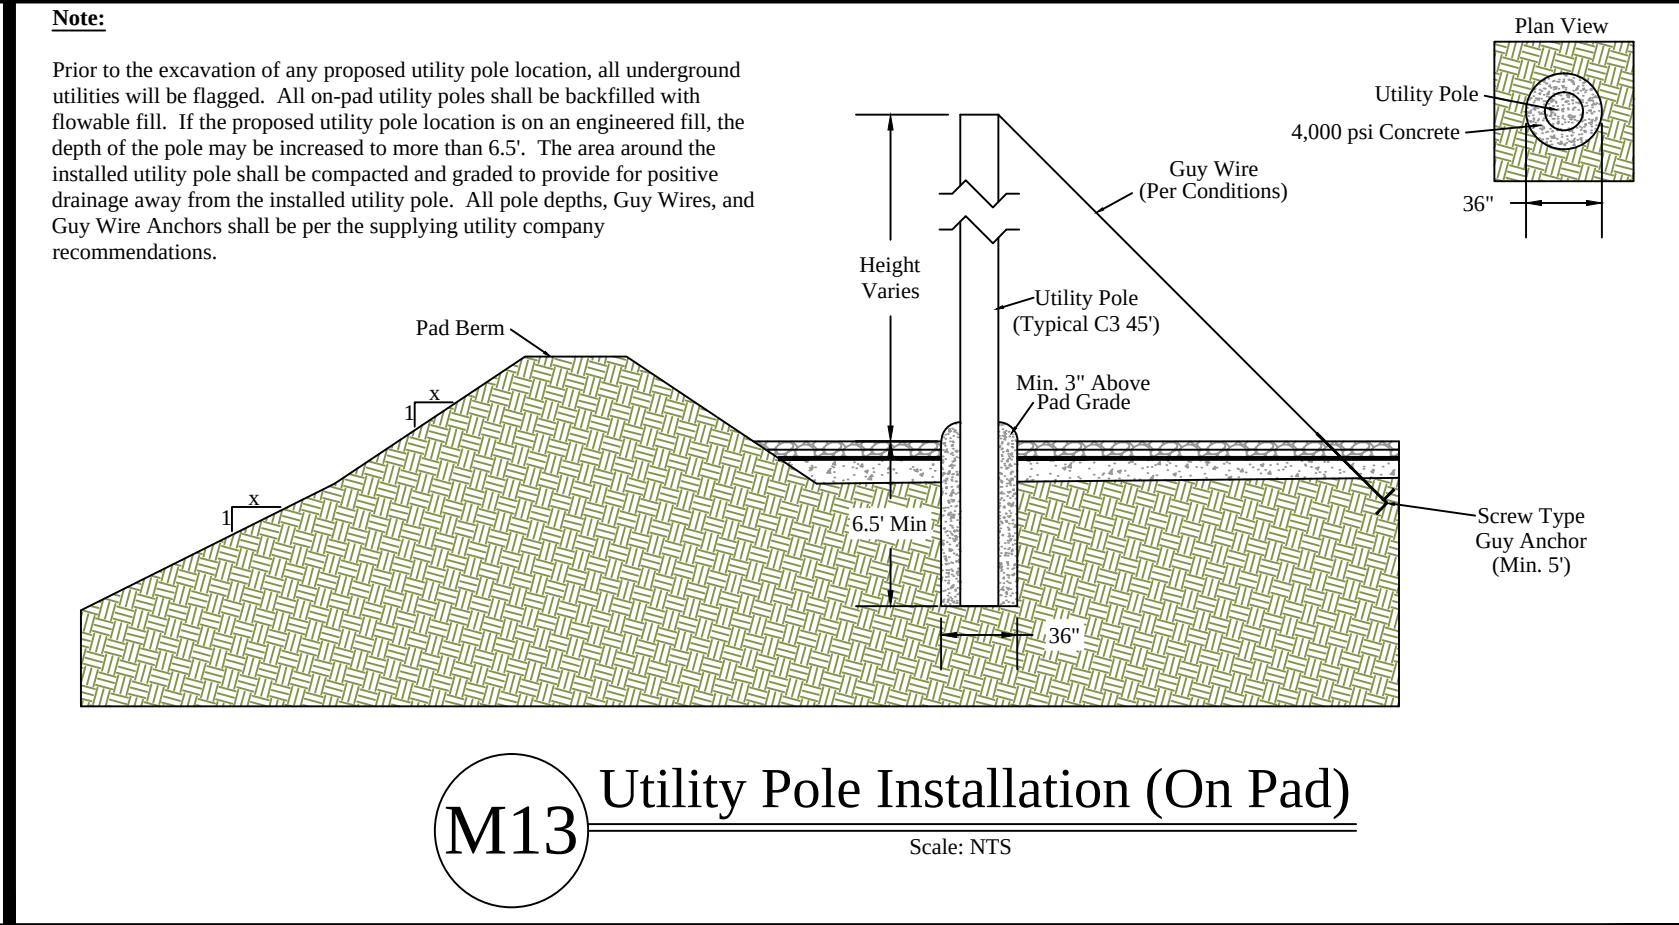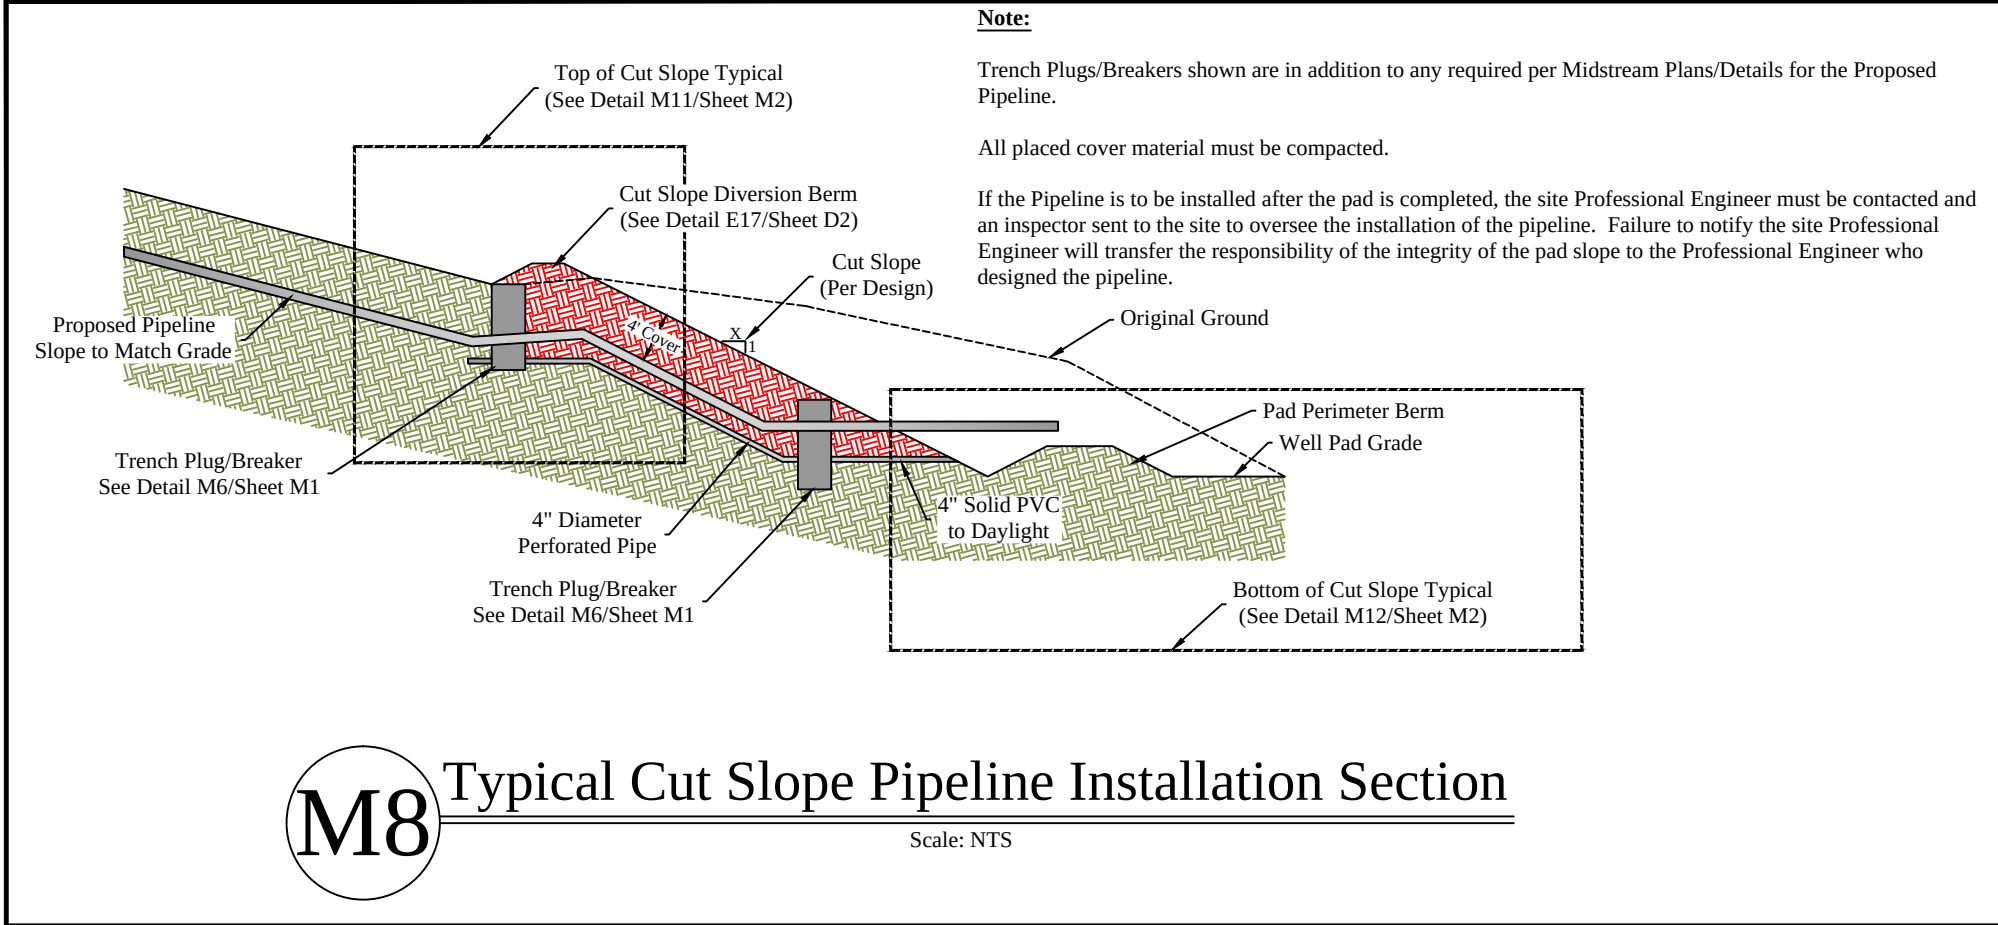

Revision

Design

Date

02-04-2025

THIS DOCUMENT
PREPARED FOR
HG ENERGY LLC

P.O. Box 254
Delmar, WV 26039
(304) 338-0965

Typical Midstream Production Details

1221 Well Site

Freemans Creek District
Lewis County, WV

Date: 02/04/2025










Scale: As Shown

Designed By: ZS

File No.

Sheet M2 of M2

APPROVED
WVDEP OOG
Modification
3/14/2025

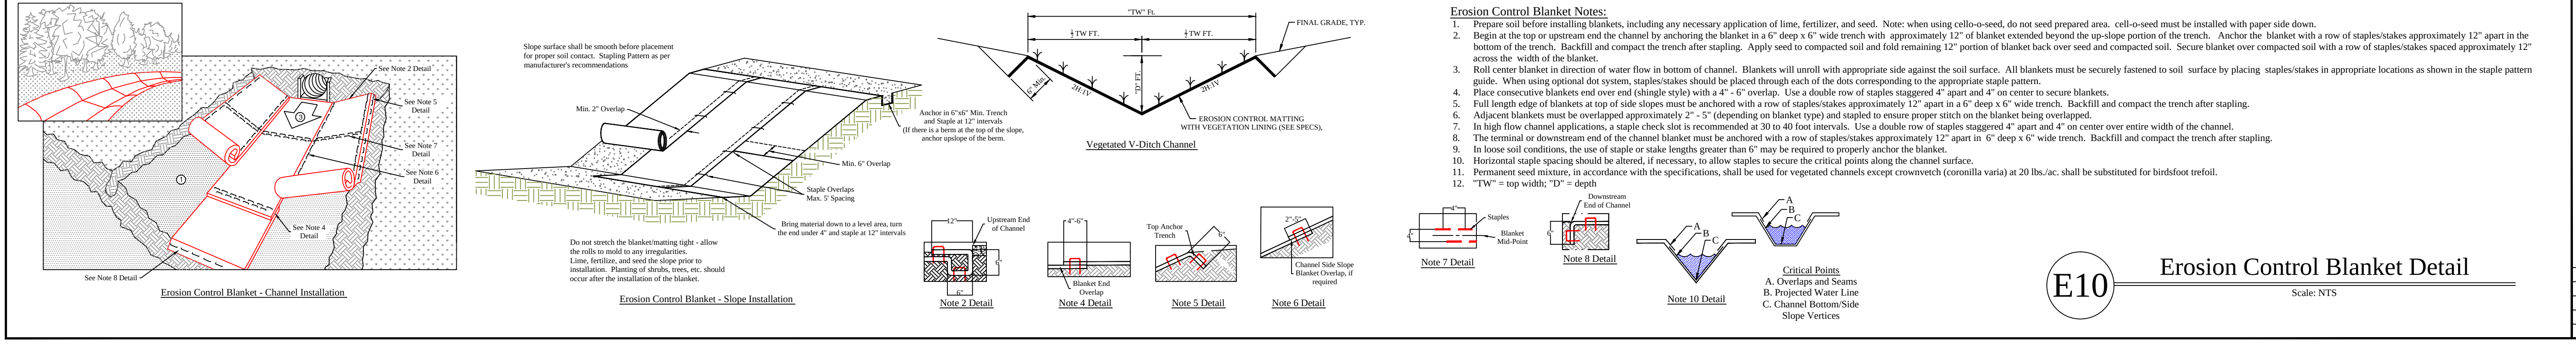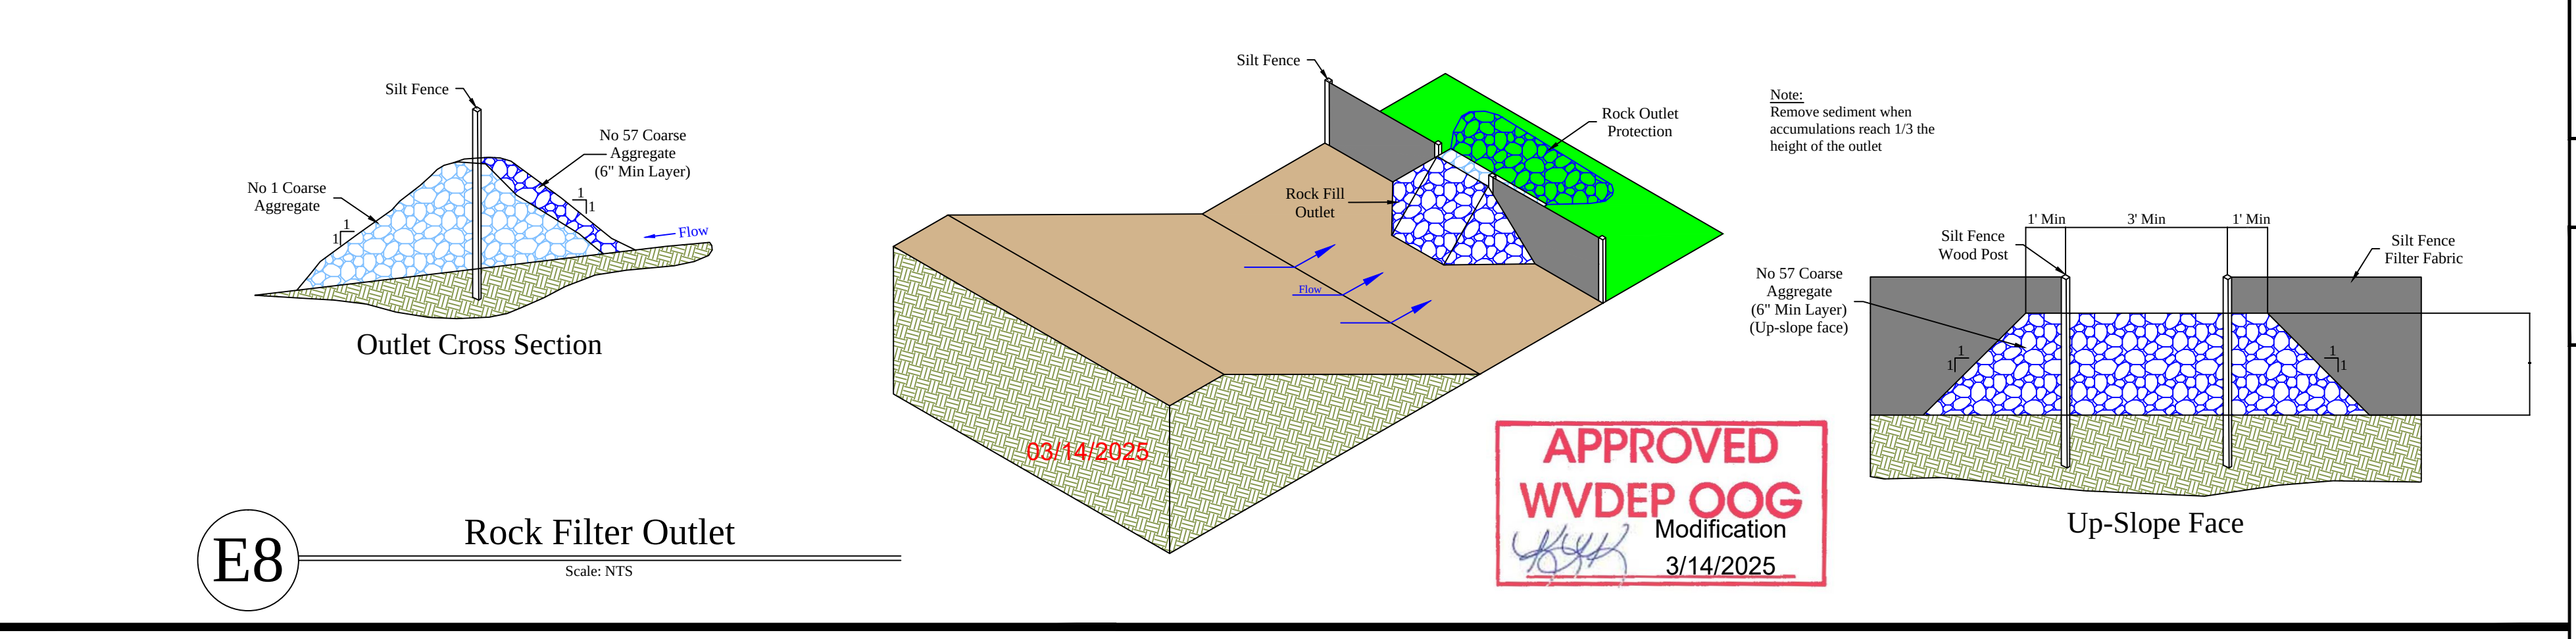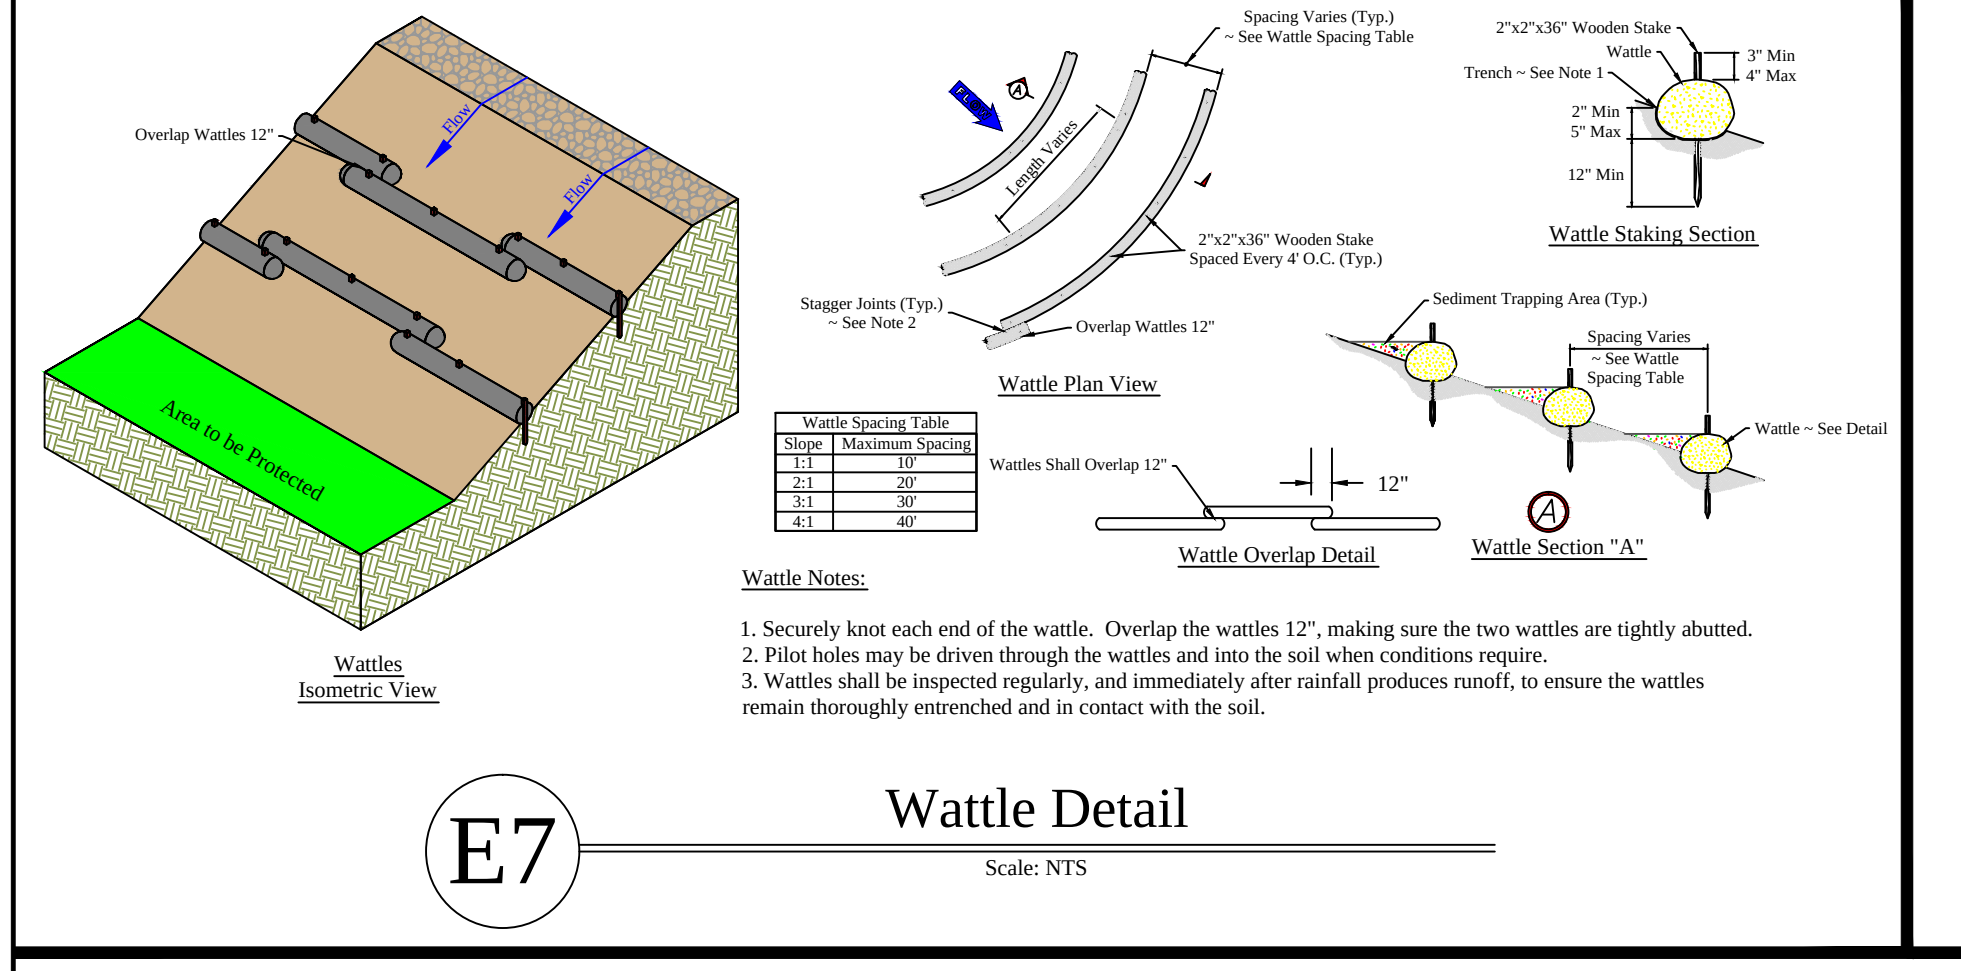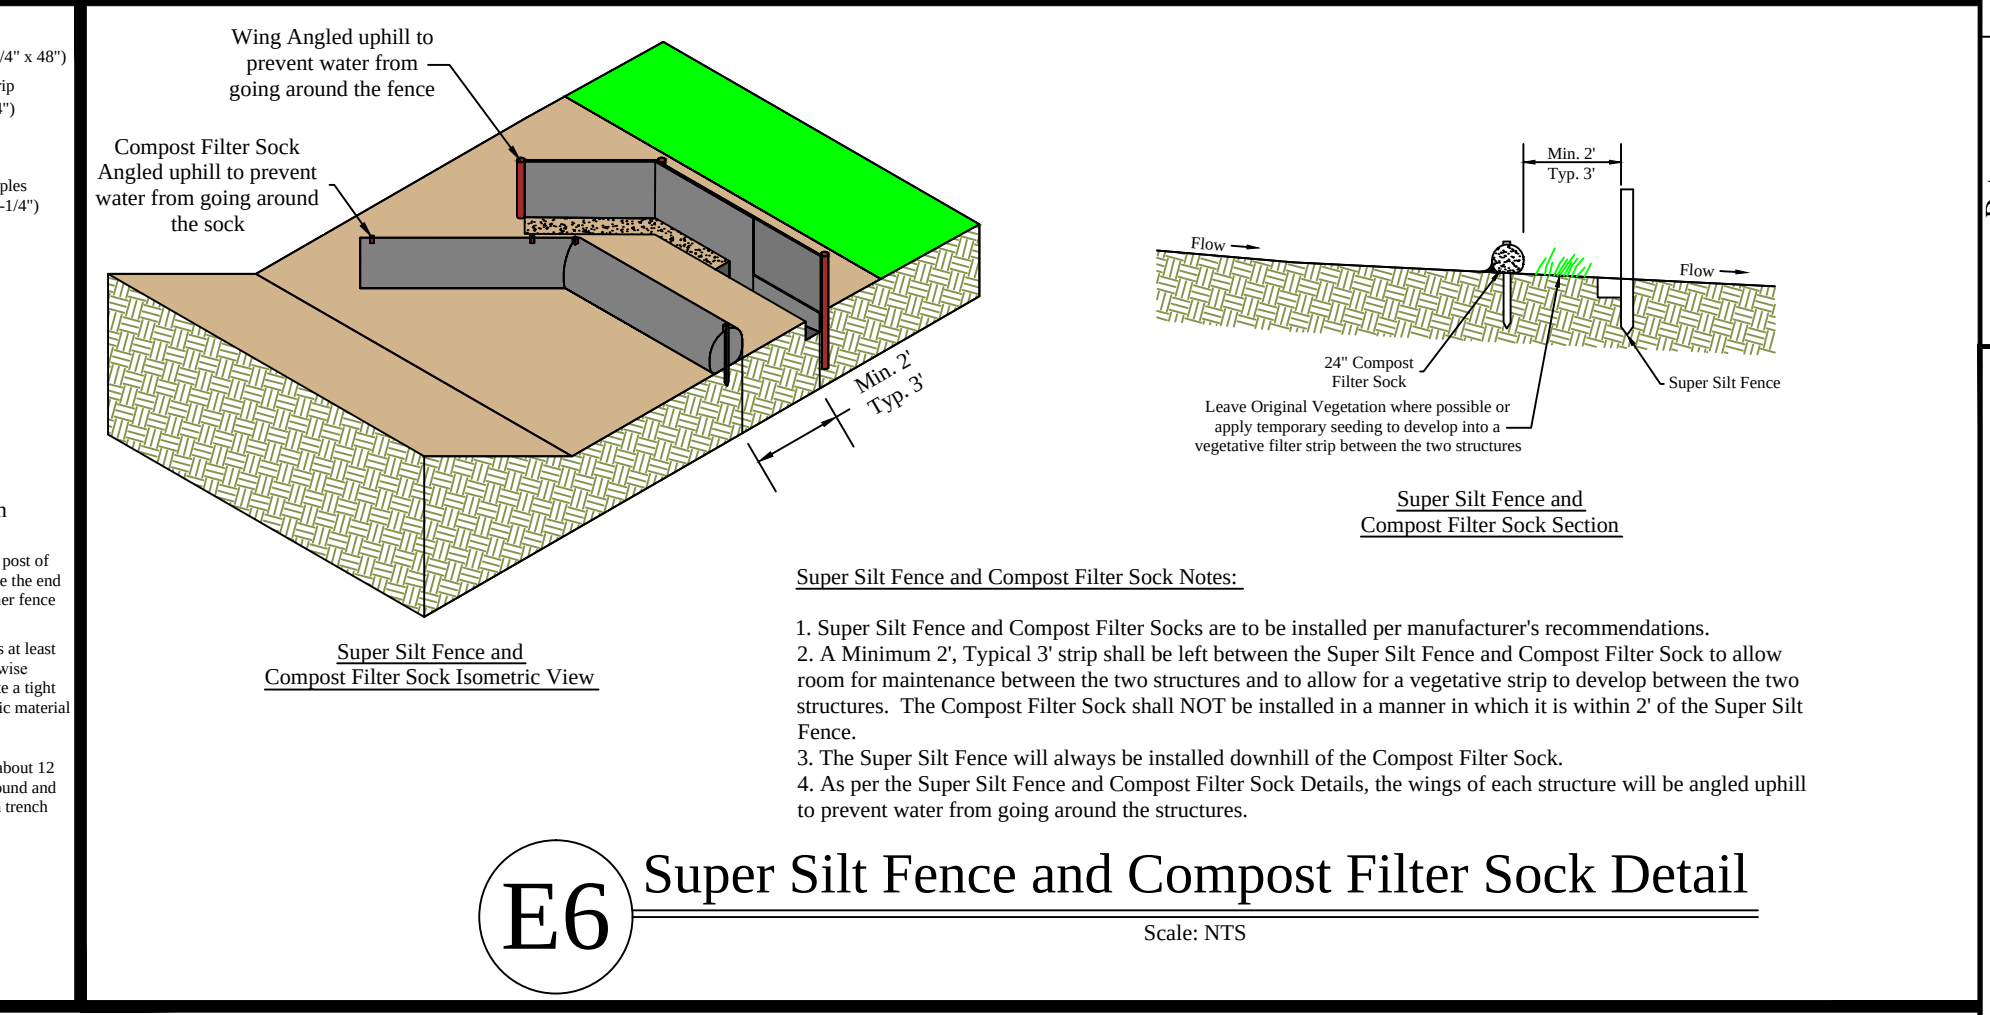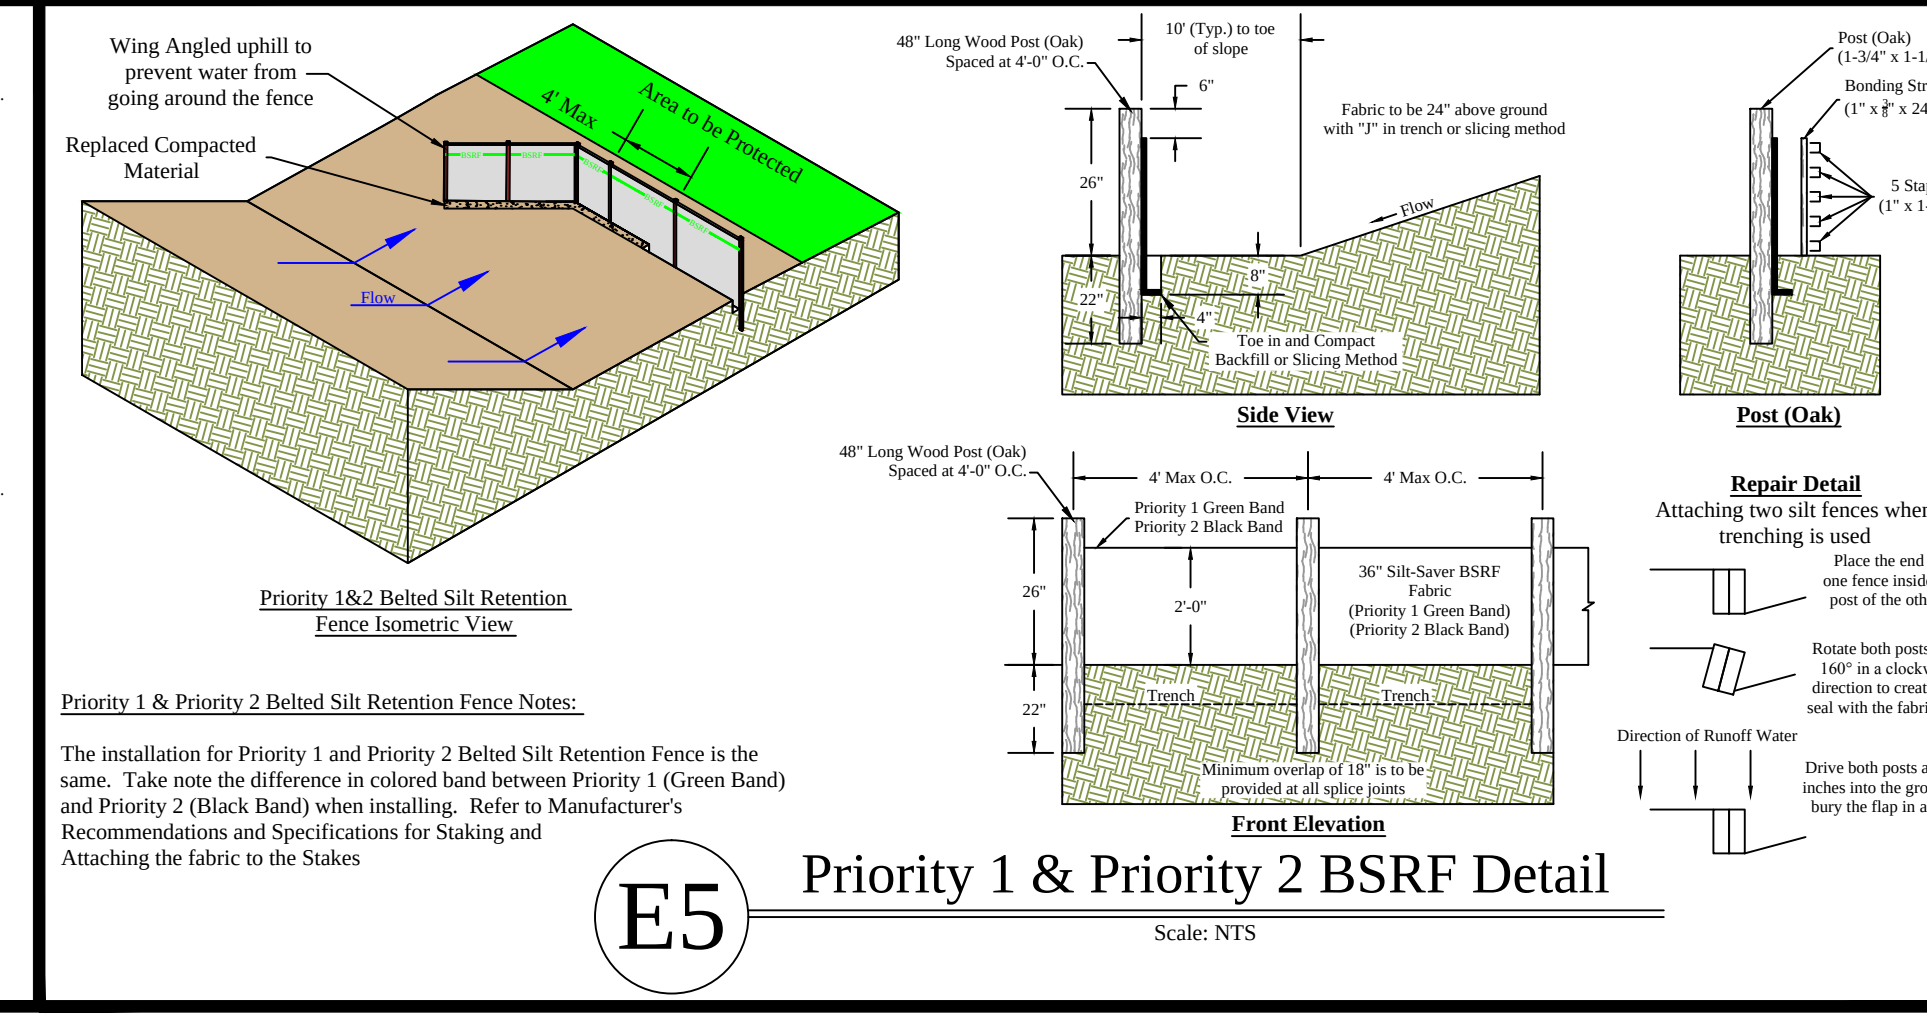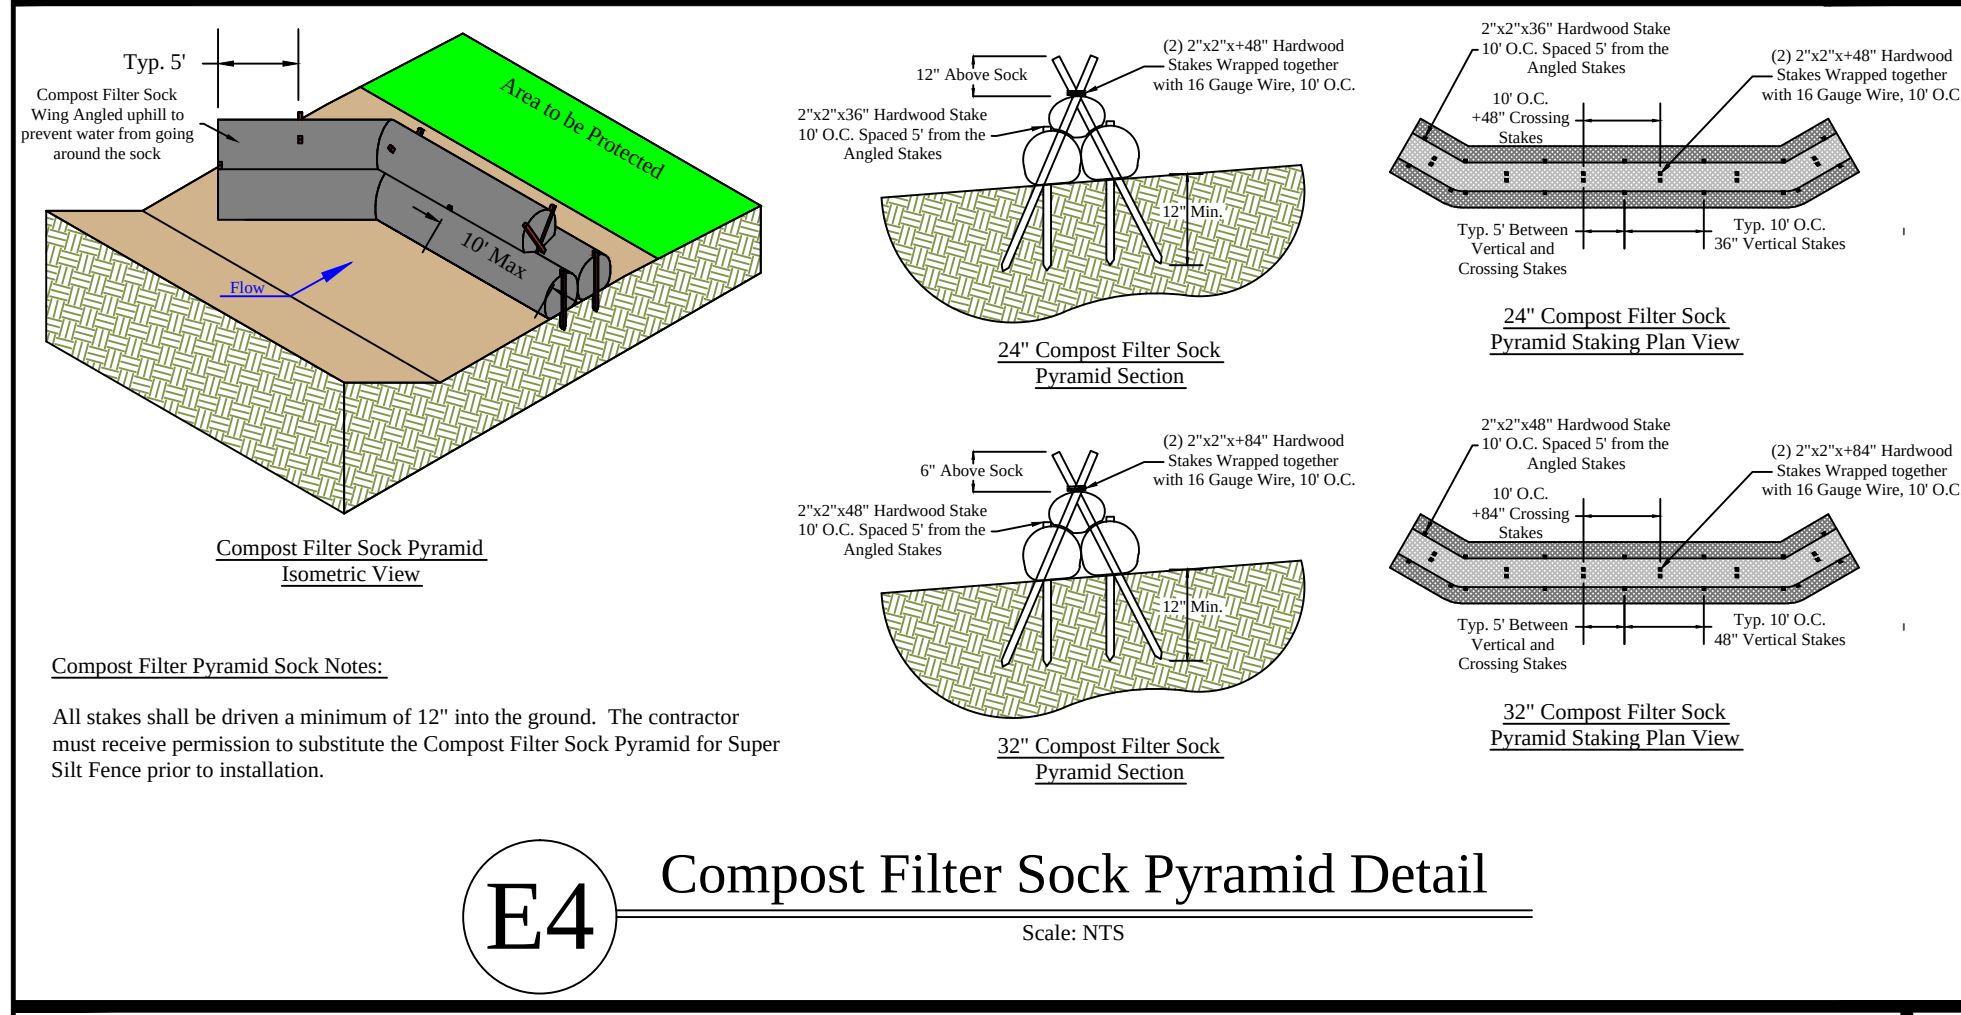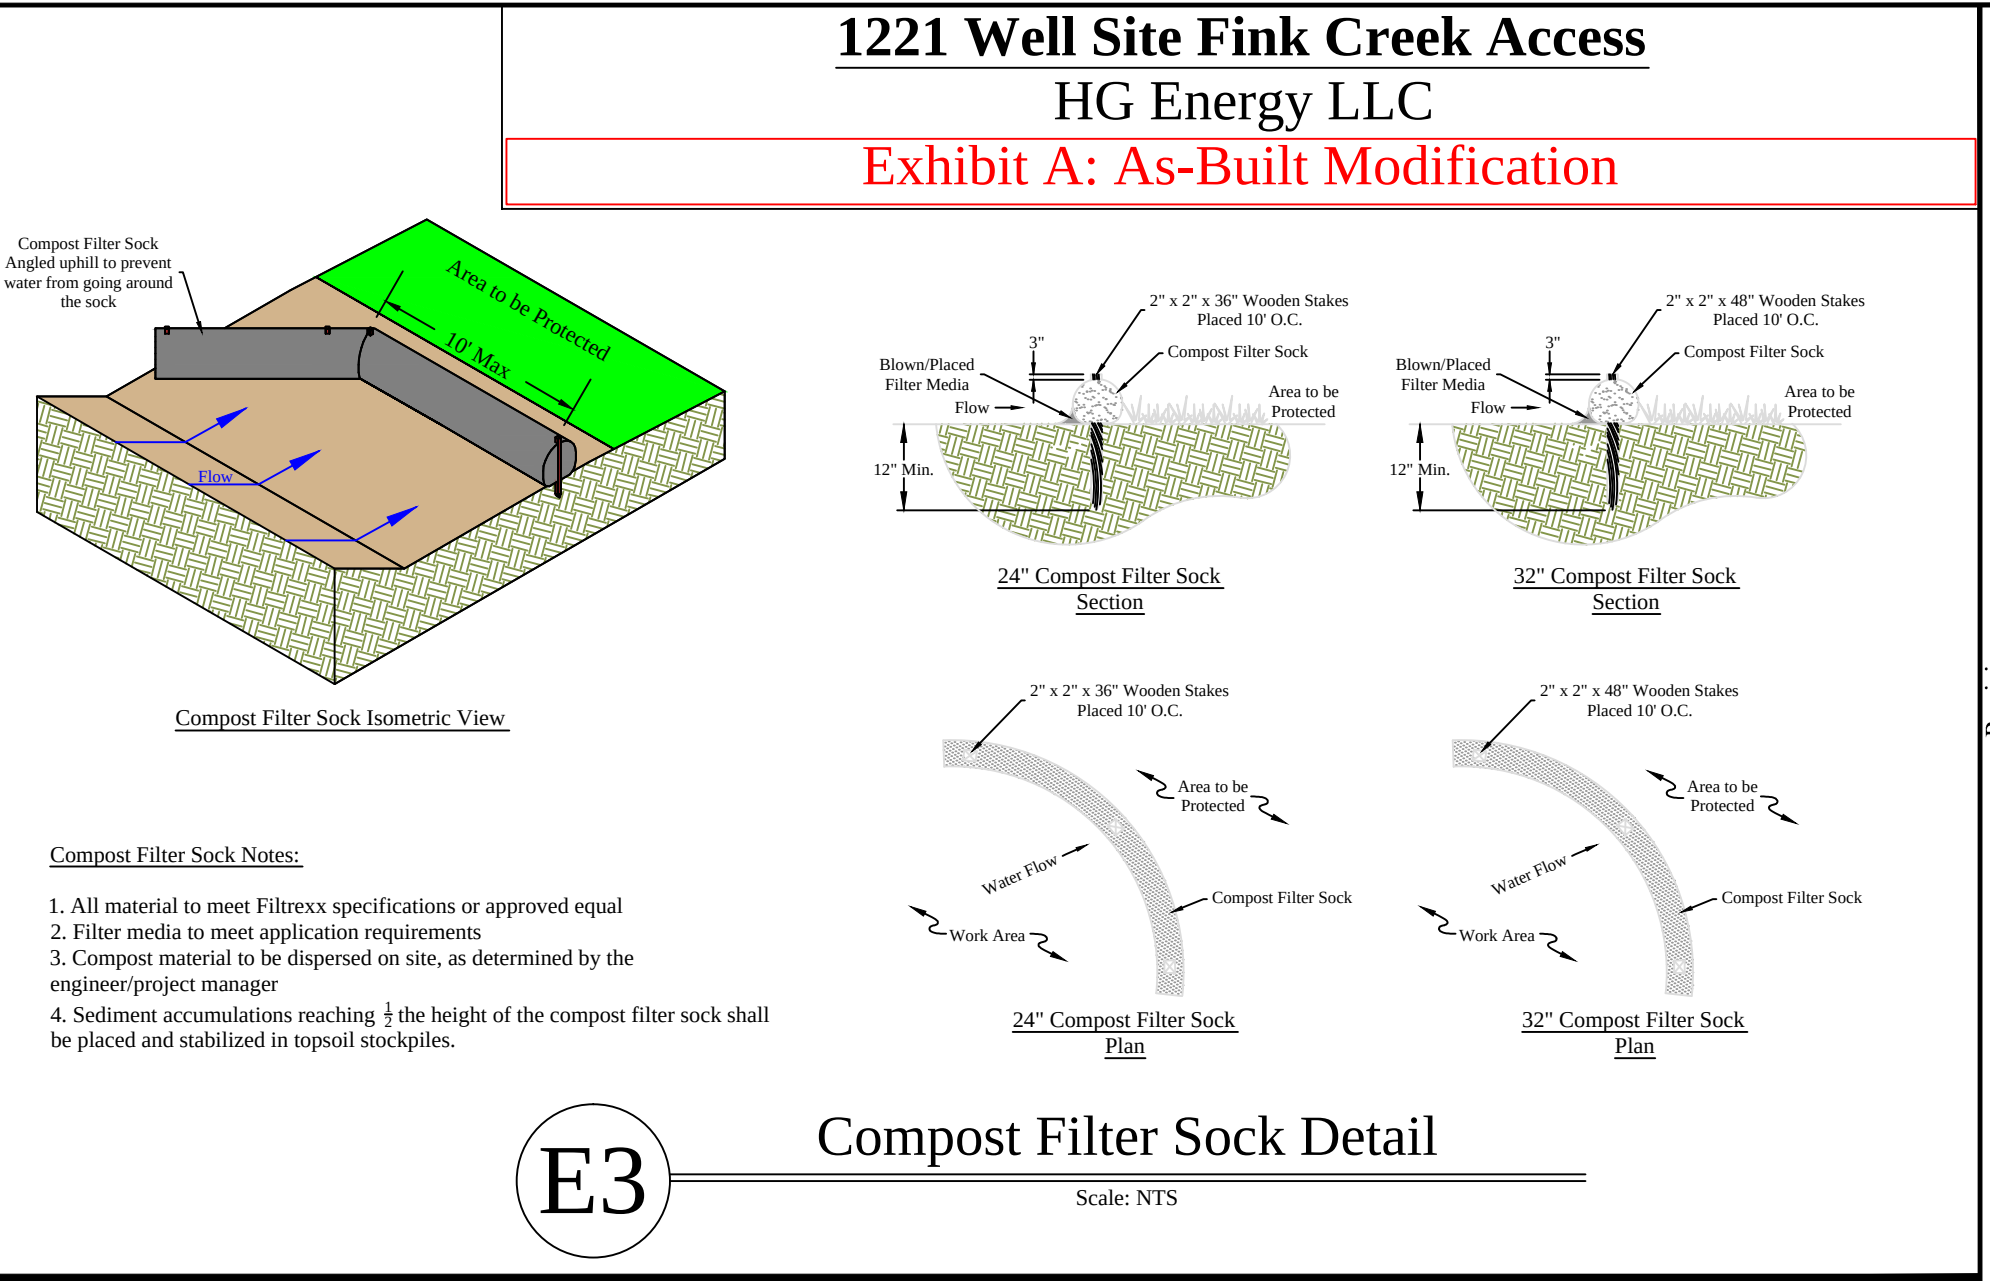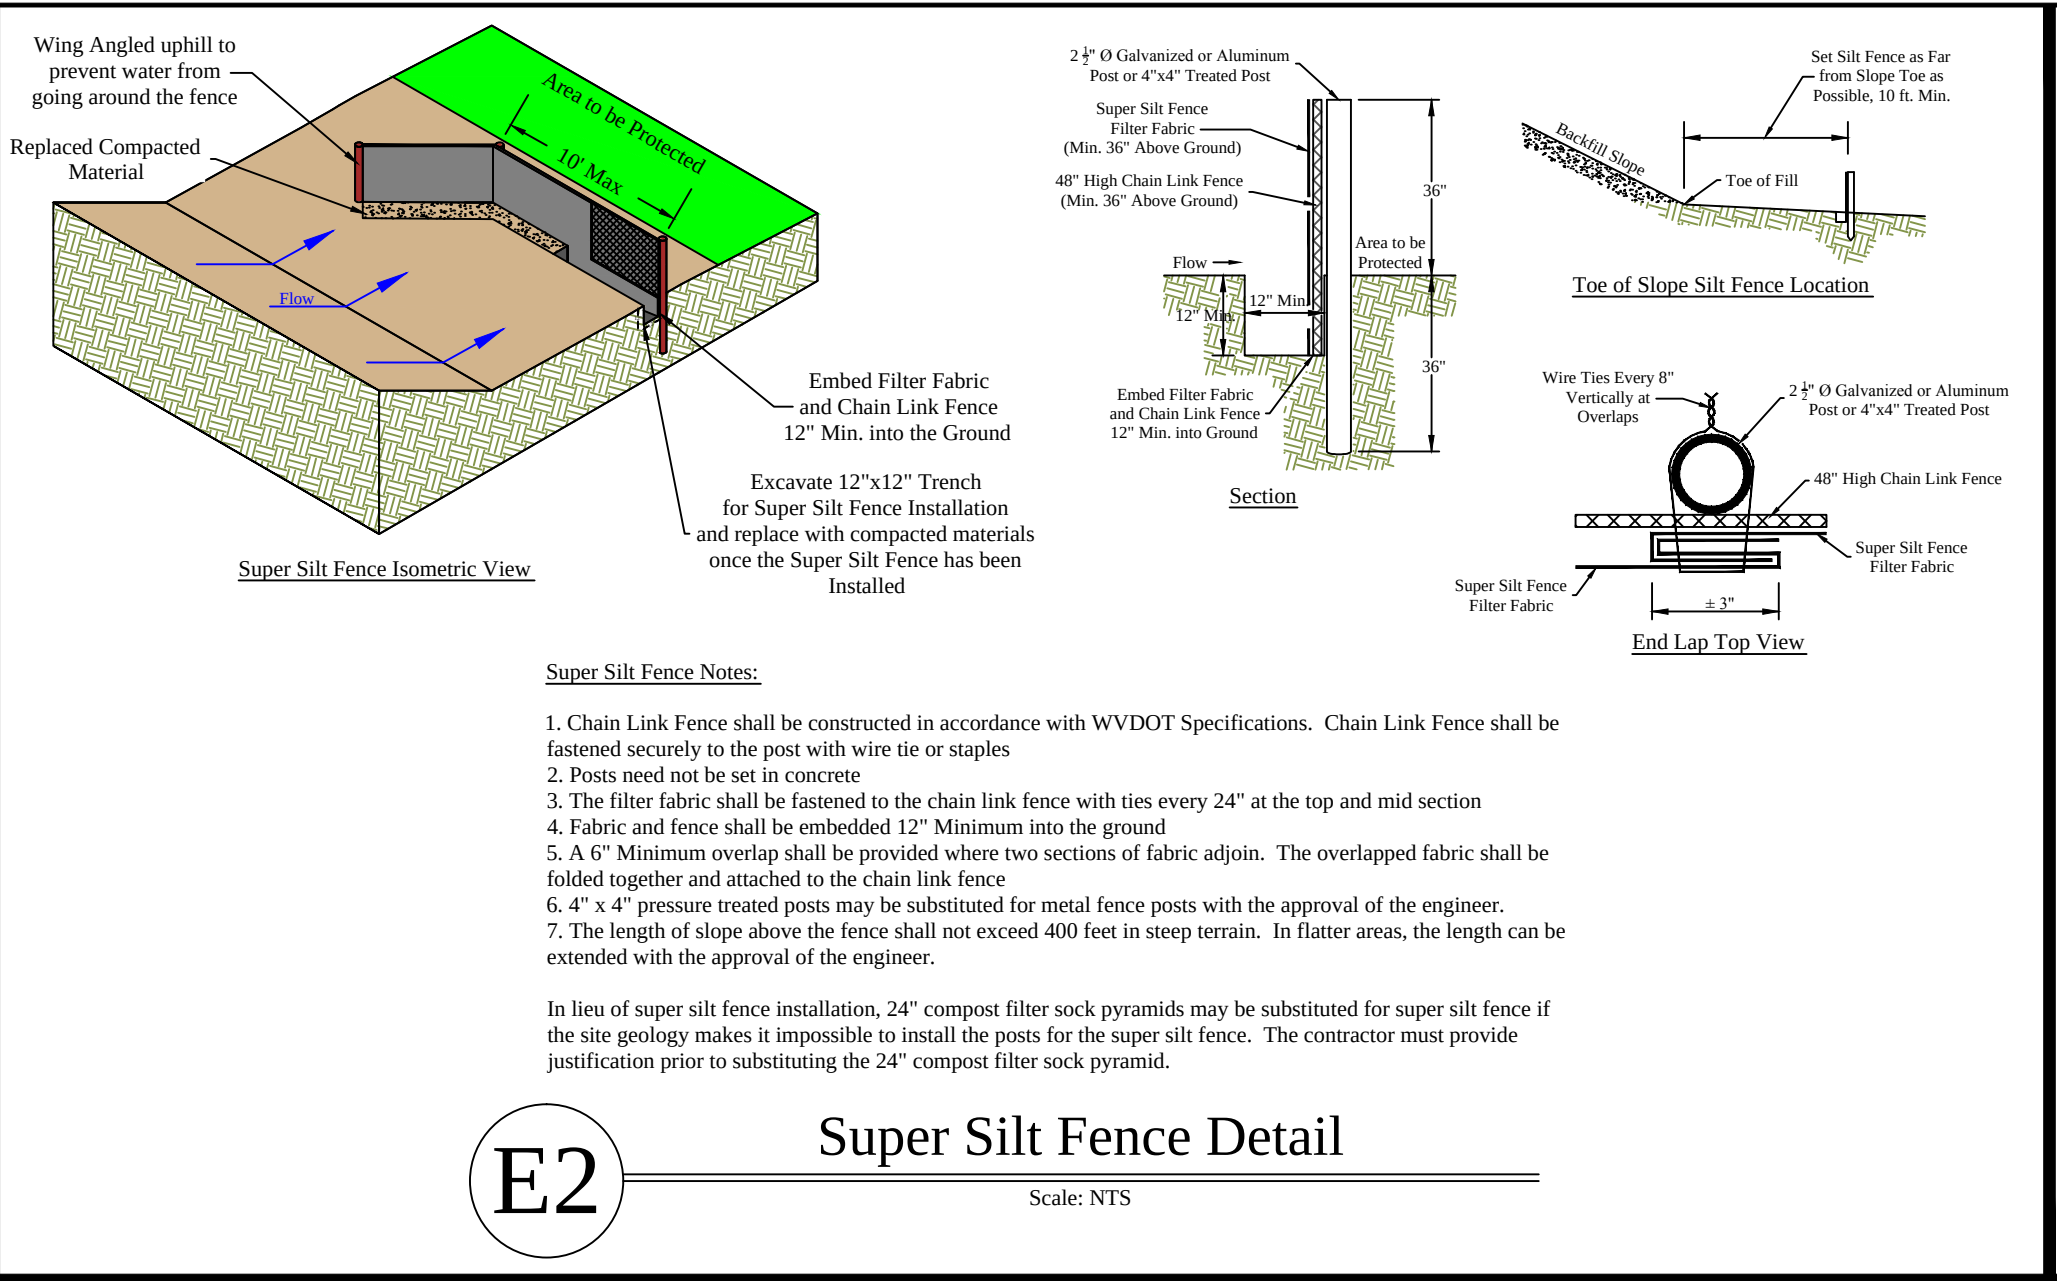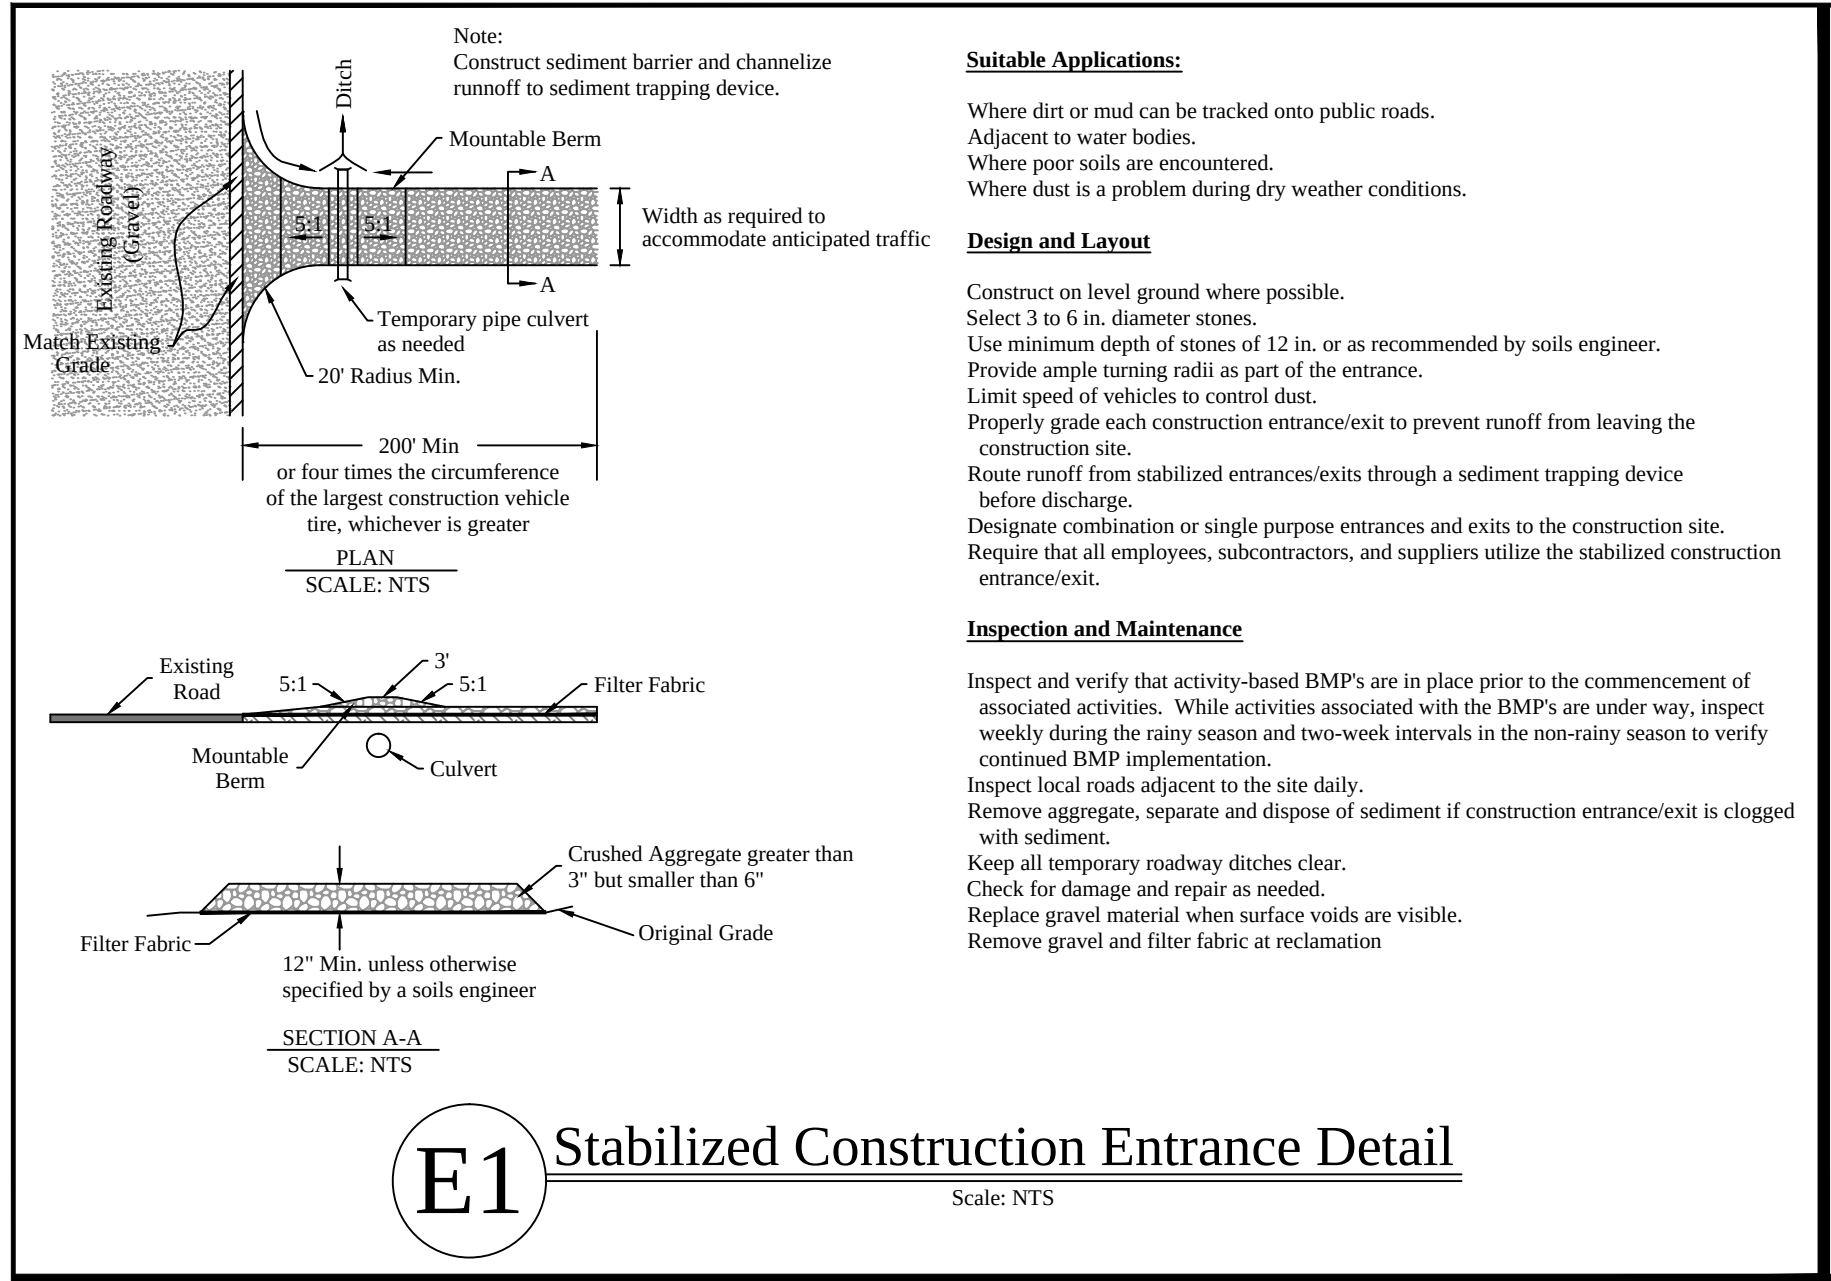

Revision
Design
Date
02-04-2025

HG ENERGY LLC

THIS DOCUMENT PREPARED FOR HG ENERGY LLC

Kelly Surveying
P.O. Box 254
Delmar, WV 26039
304-338-0965

Erosion and Sediment Control Details

1221 Well Site


Freemans Creek District
Lewis County, WV

Date: 02/04/2025
Scale: As Shown
Designed By: ZS
File No.
Sheet D1 of D2

1221 Well Site Fink Creek Access

HG Energy LLC


Exhibit A: As-Built Modification

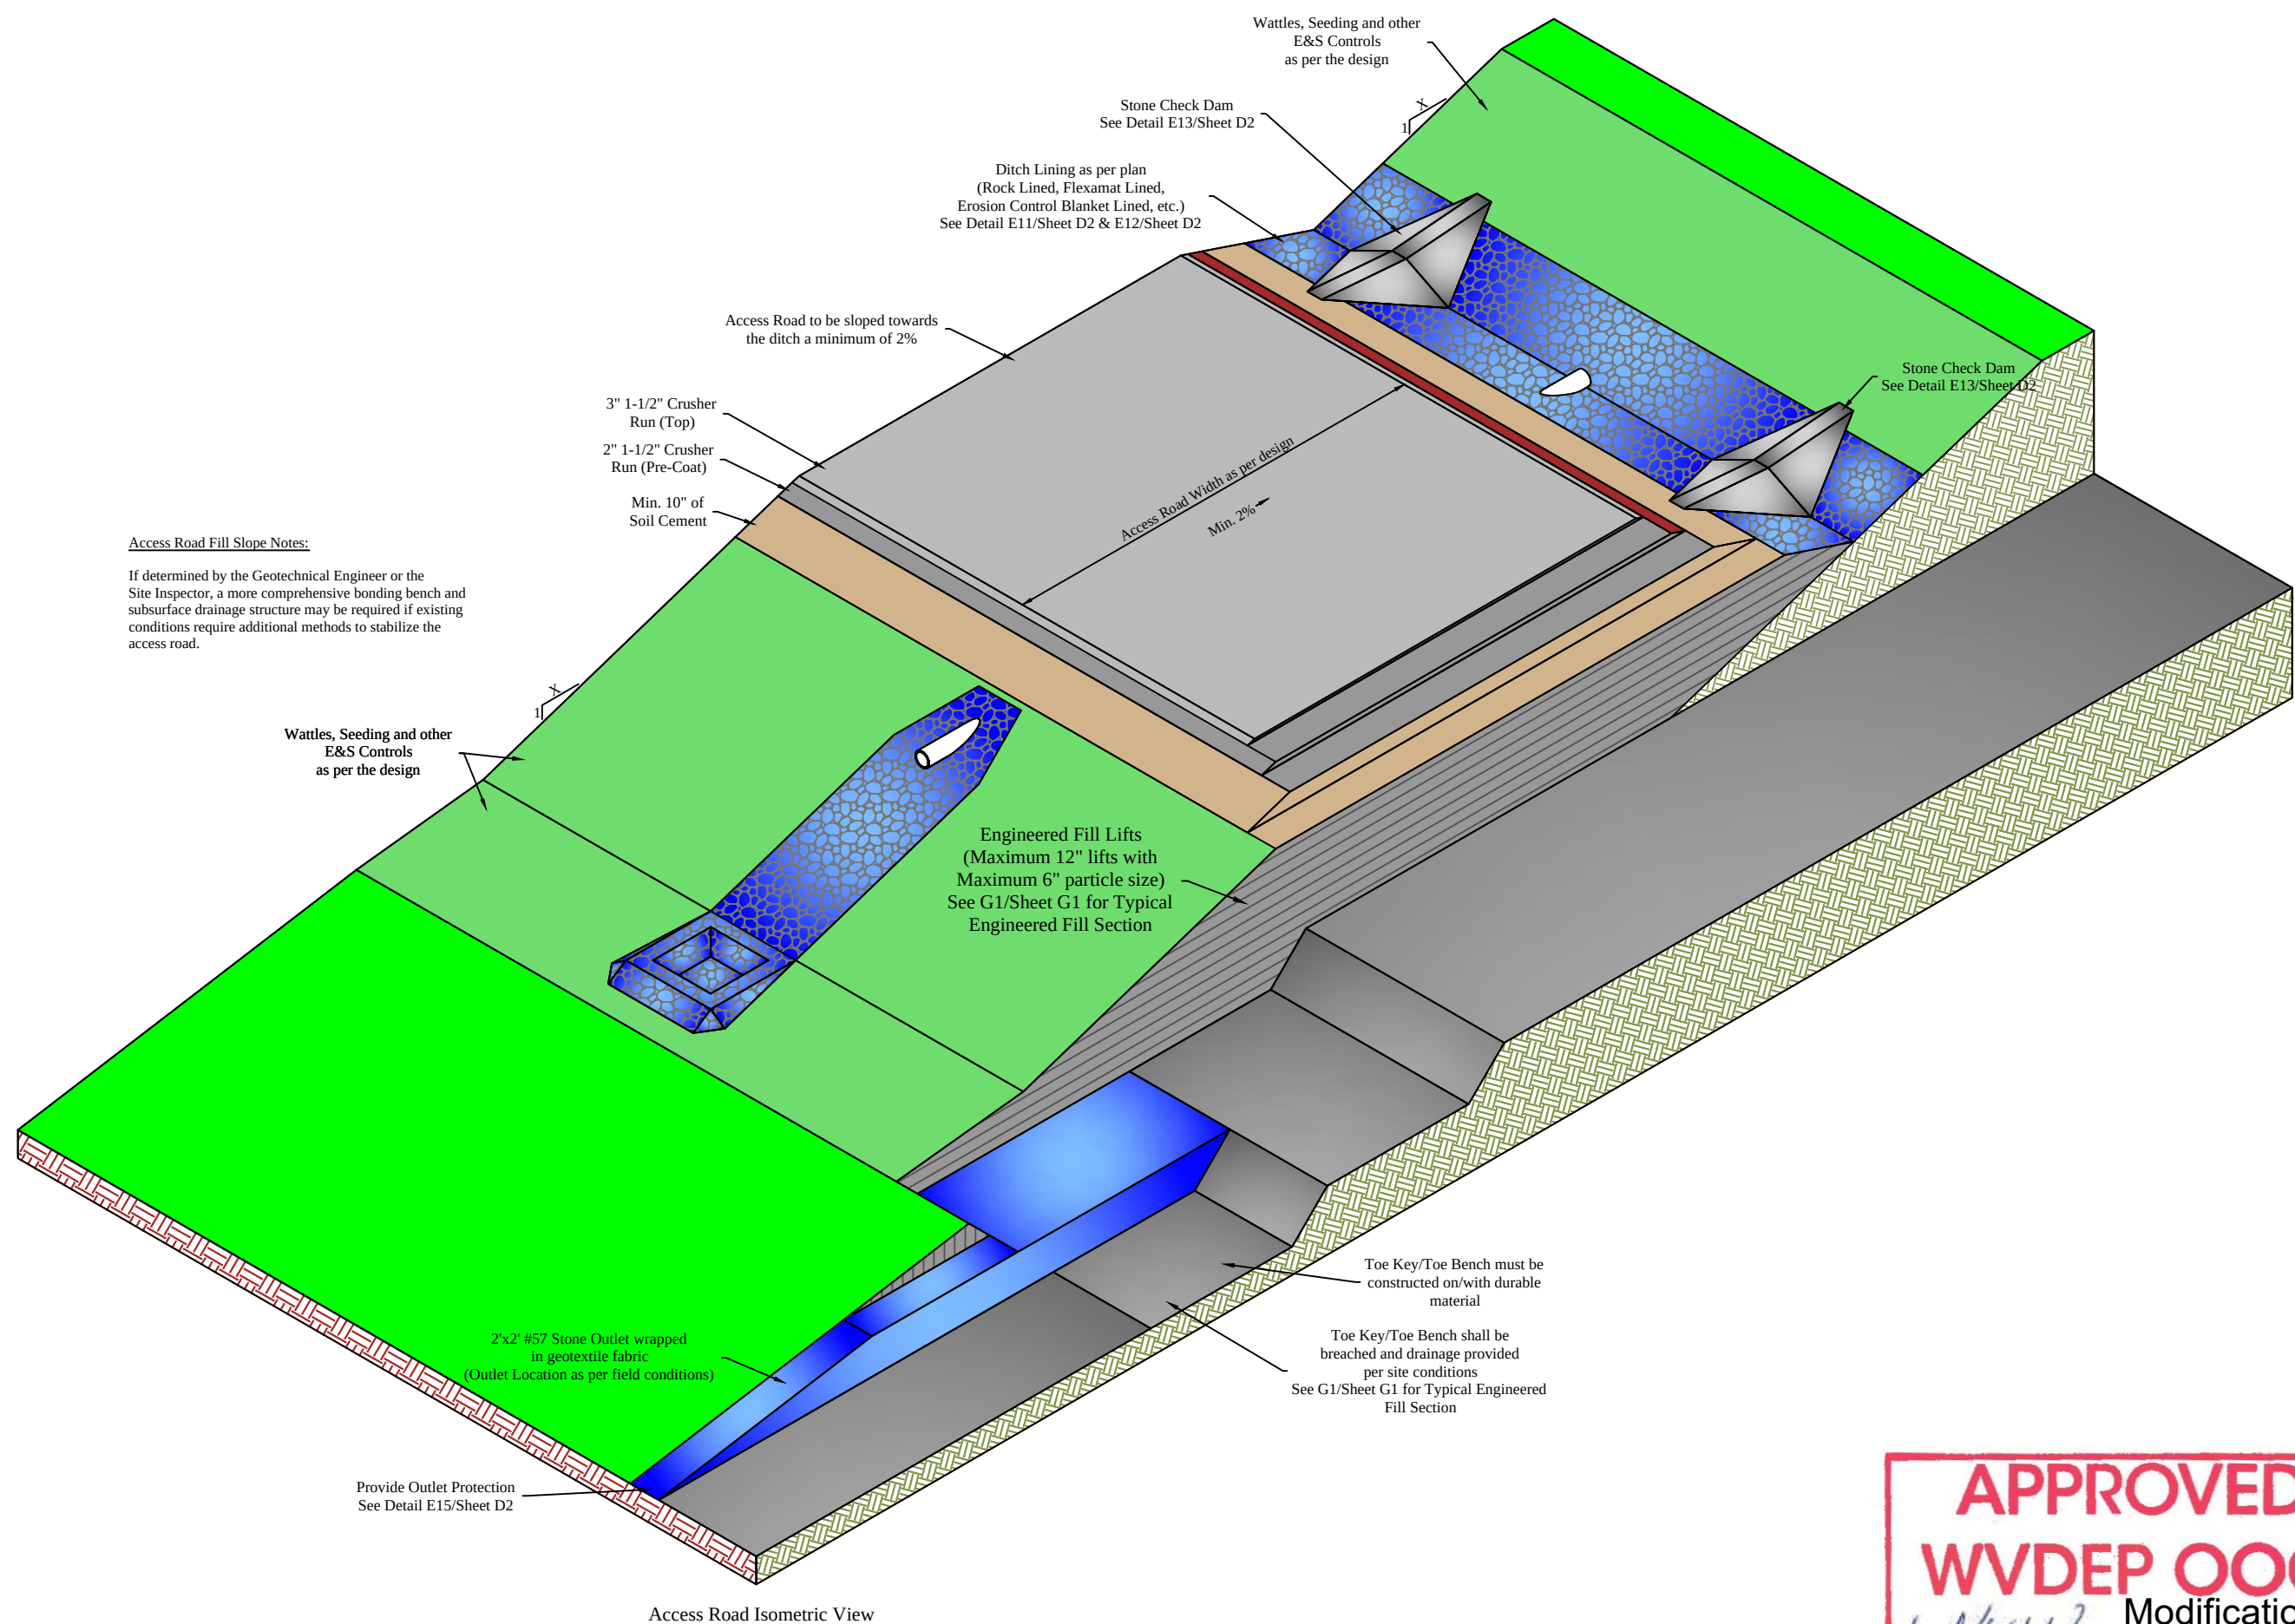

R1 Typical Access Road Cut Section Details


Scale: NTS

APPROVED
WVDEP OOG
Modification
3/14/2025

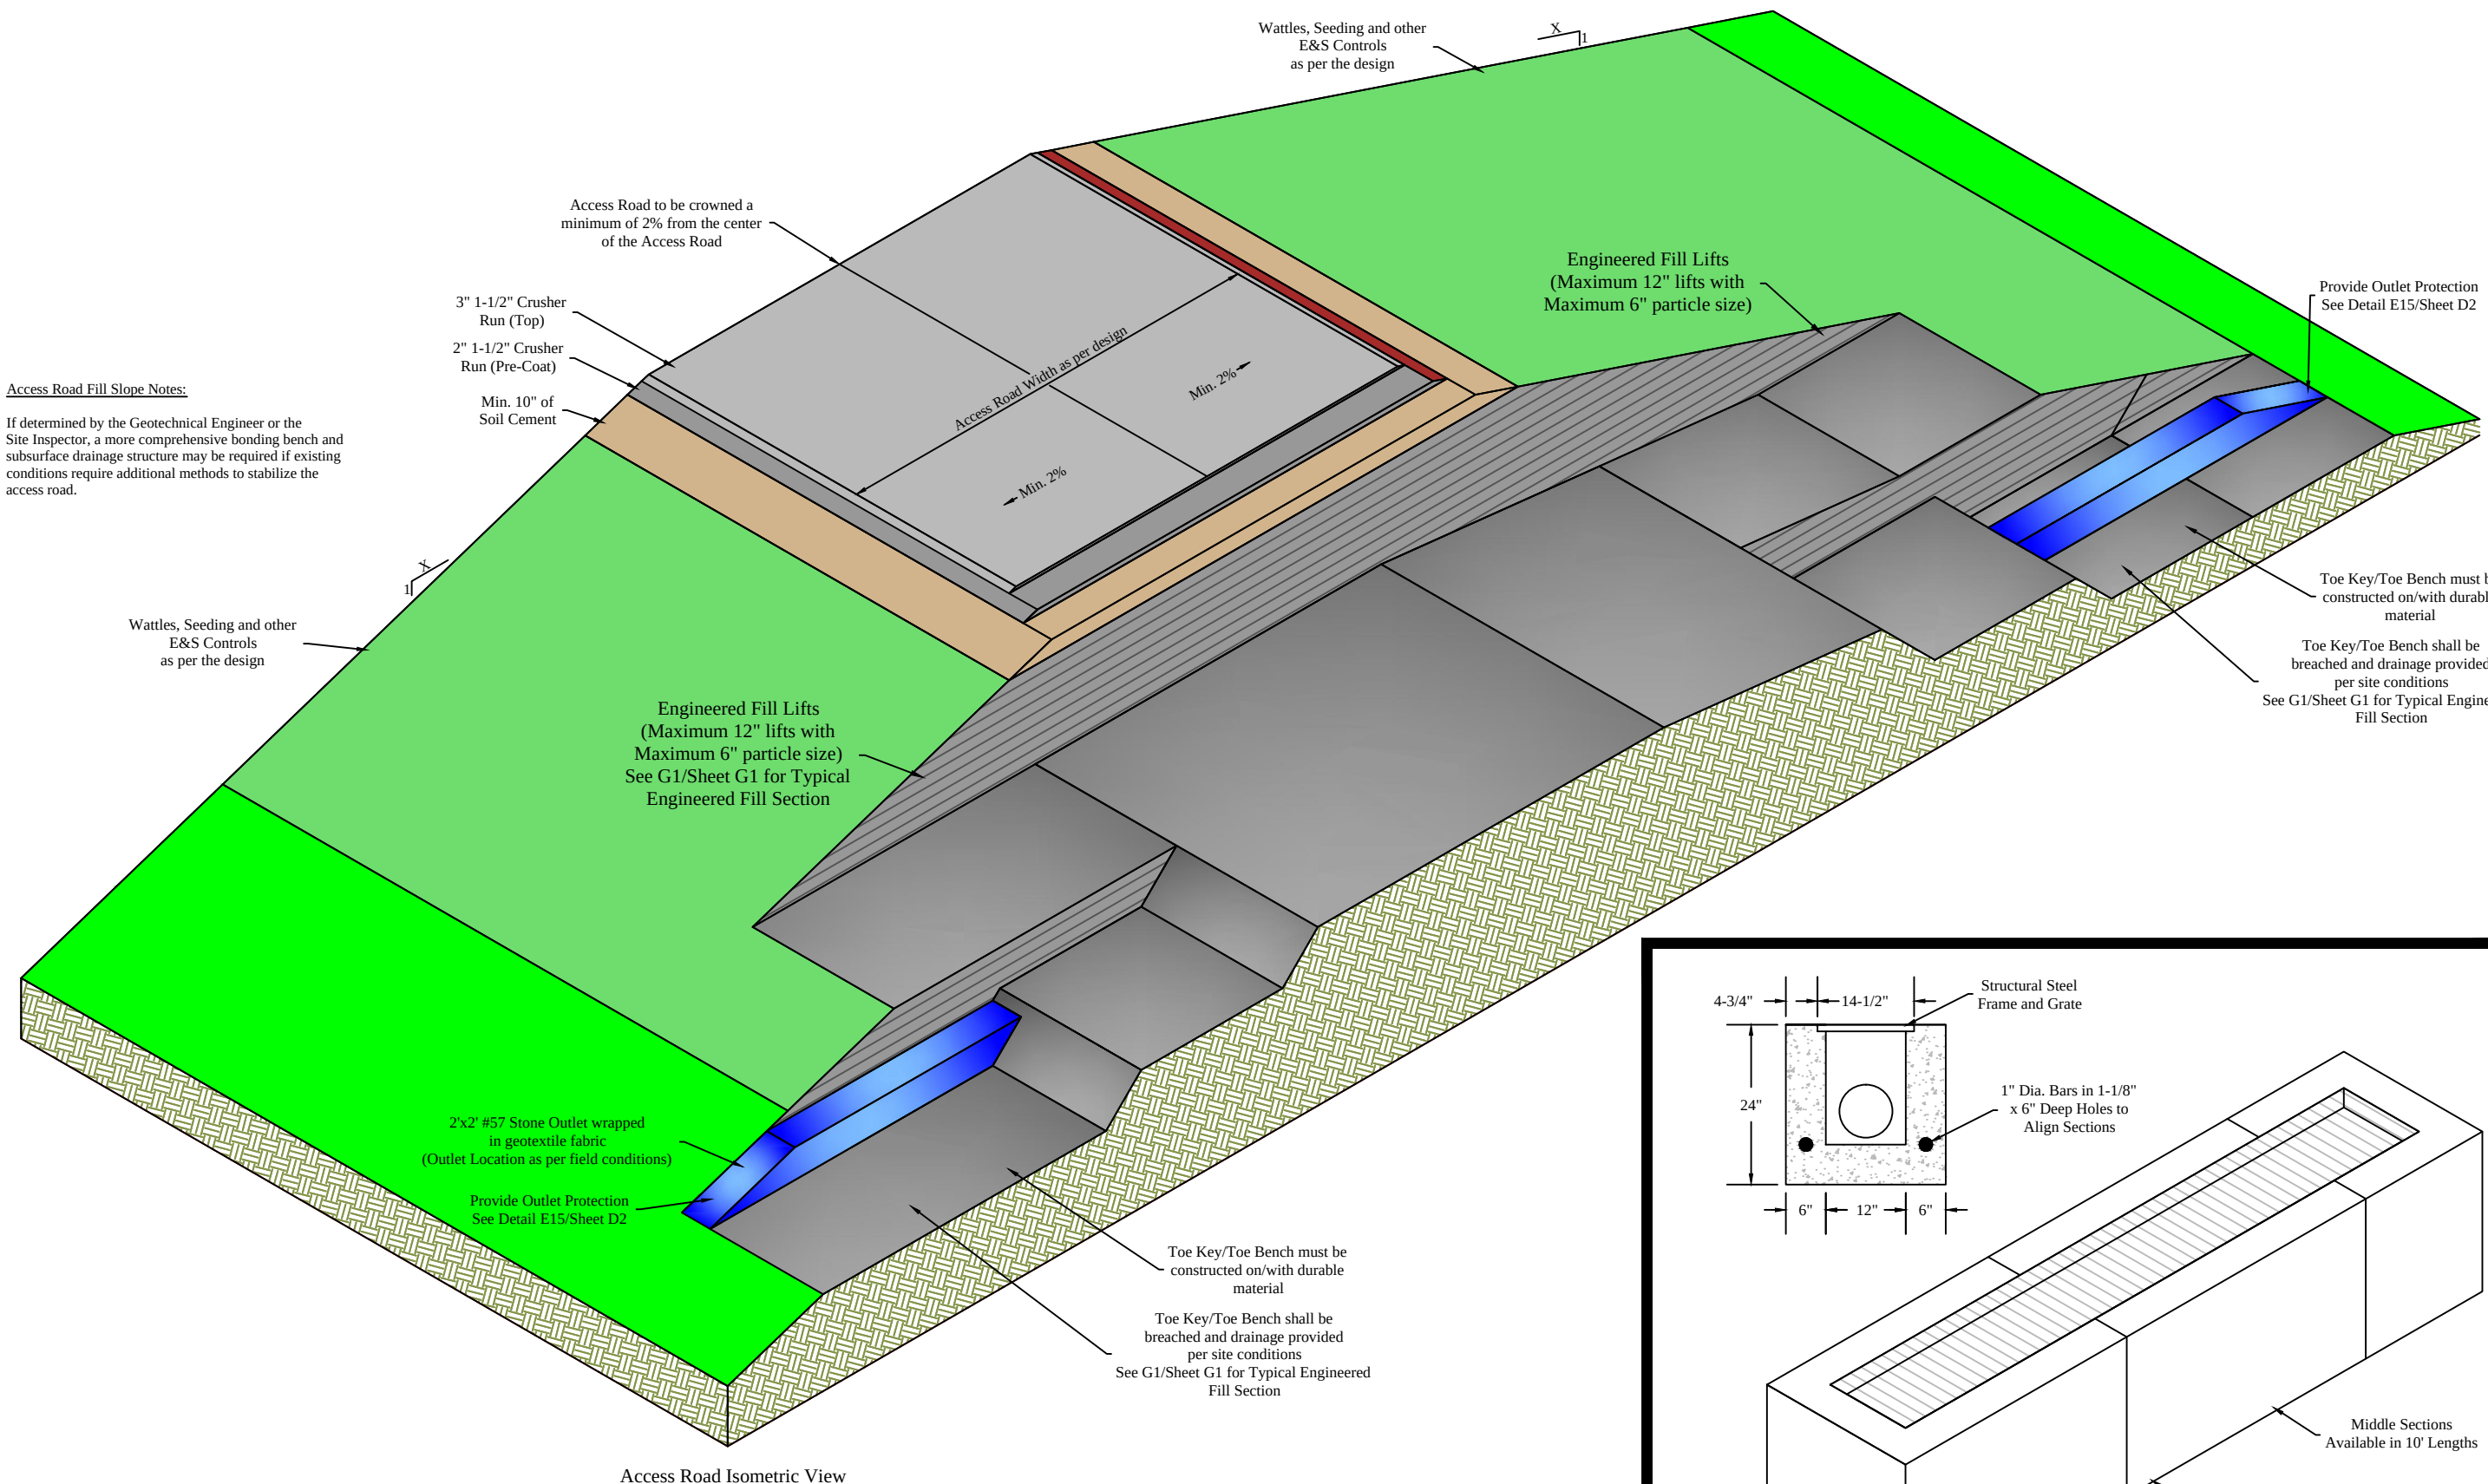


R2 Typical Access Road Fill Section Details

Scale: NTS

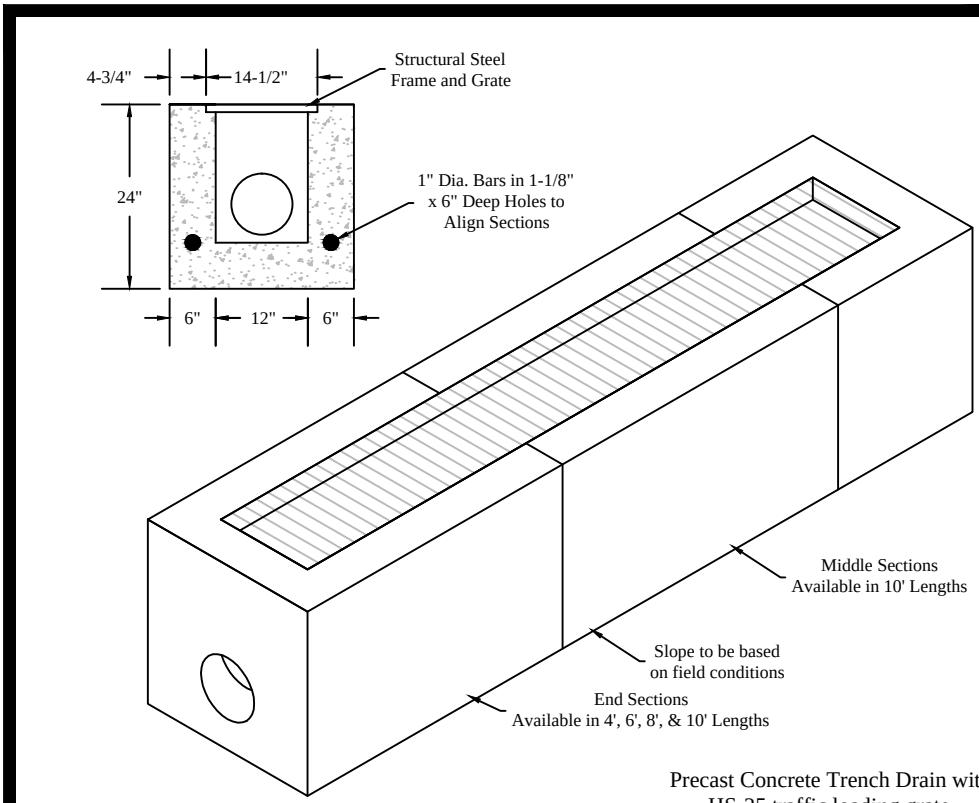


R8 Trench Grate Detail

Scale: NTS

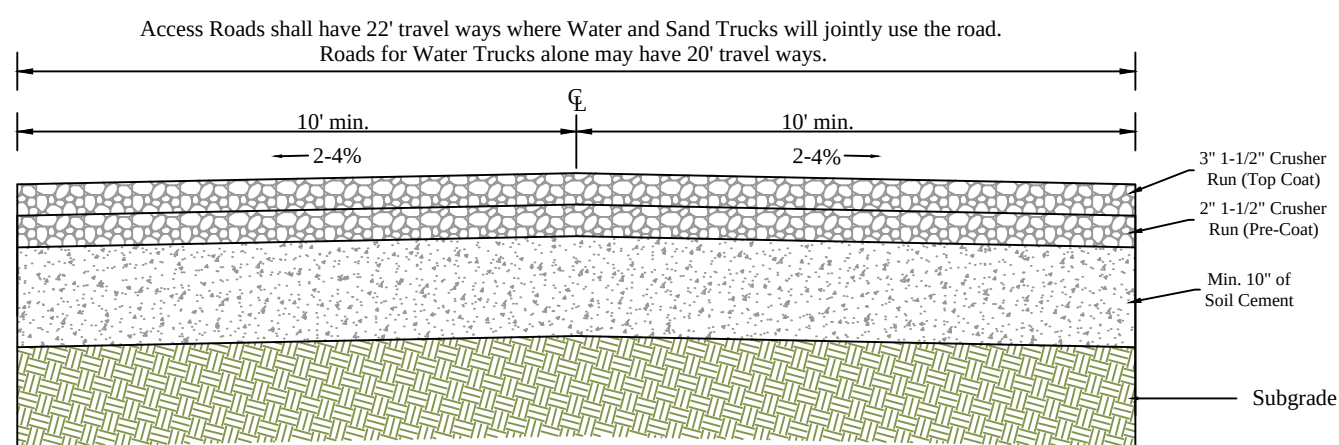


R3 Typical Access Road Surfacing Details

Scale: NTS

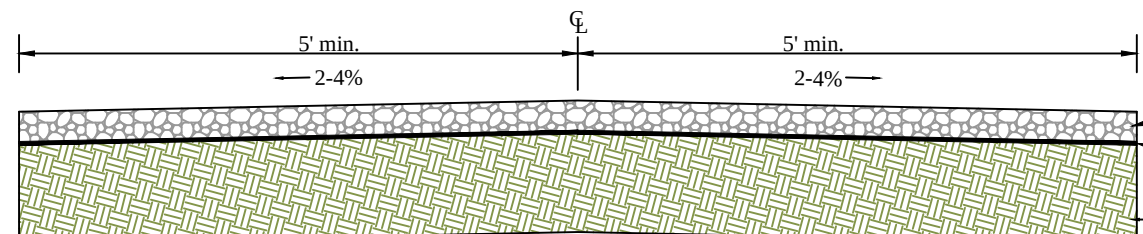


R4 Temporary/Adjacent Access Road Surfacing Details

Scale: NTS

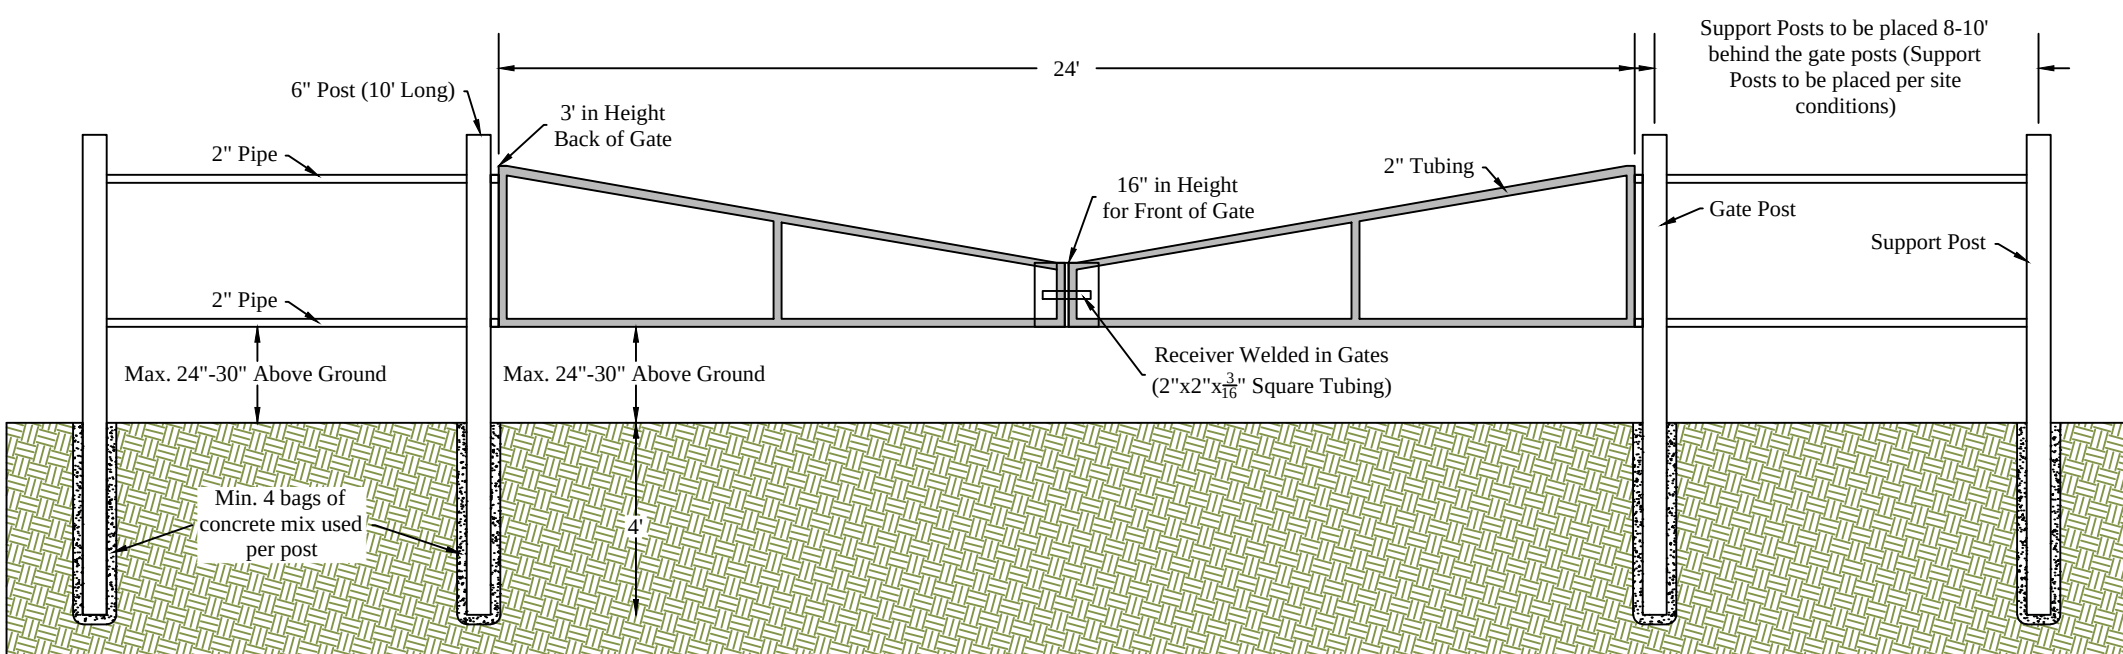

R5 Access Road Gate Detail

Scale: NTS

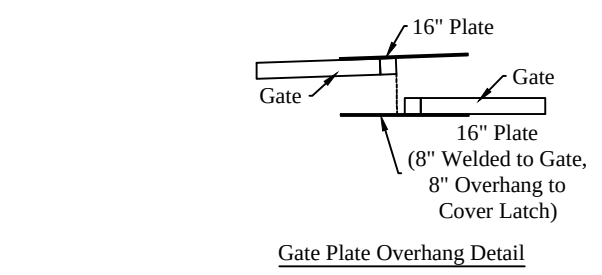

Gate Specification and Installation

- Prior to any excavation or installation, a "One Call" must be performed
- Gates shall be constructed of Two Inch (2") square tubing
 - Gate posts shall be constructed of Six Inch (6") Steel Pipe, Ten Feet (10') in length
 - Gates are to be Twelve Feet (12') in length each with at least 1 upright brace between the front and rear uprights
 - Two (2) posts will be used to hang gates and an additional Two (2) posts shall be used as supports, approximately 8-10' behind the gate posts
 - Two Inch (2") pipe may be used as bracing between gate posts to secure posts and keep ATV's from going around the gate
 - Gate posts should be installed Four Feet (4') in the ground with a minimum of four (4) bags of concrete mix used per post
 - Gates will have a Sixteen Inch (16") steel plate welded at closure points to secure locks. The plate shall be mounted so that Eight Inches (8") of the plate is welded to the gate and Eight Inches (8") is left to overhang to overlap the other gate
 - The receiver for the latch on the gate needs to be constructed using 2"x2"x 1/8" tubing to allow space for the latch
 - The bottom of the gates shall be between 24"-30" max. above the road surface to prevent ATV's from driving under the gates
 - Gates shall be painted safety yellow and signs shall be provided to attach to the gates
 - A spacing of 1" between the gates needs to be maintained for the latch to fit and operate properly
 - Fabricators shall have freedom to design their hinges to allow adjustability as the gates require precise installation for the latch system to work properly. A typical design is available from HG Energy LLC
 - Proper function of the gates must be verified before leaving the site

CONSTRUCTION STAKING GUIDE & STANDARD RIBBON COLOR SCHEME

03/14/2025

	Yellow Ribbon: Yellow Ribbon used to indicate top of Cuts (C) Cut to be determined at time of stakeout Slope determined by site design		Blue & White Stripe Ribbon: Blue & White Stripe Ribbon used to indicate Limits of Disturbance (LOD) and Clearing Limits
	Yellow & Orange Ribbon: Yellow and Orange Ribbon used to indicate Grade at Top of Pad/Pond/Pit		Orange & Black Stripe Ribbon: Orange & Black Stripe Ribbon used to indicate Vertical Cut (VC) at Centerline or edge of access road Orange & Black Stripe Ribbon used to indicate Vertical Fill (VF) at centerline or edge of access road
	Orange Ribbon: Orange Ribbon used to indicate toes of Fills (F) Fill to be determined at time of stakeout Slope determined by site design		Pink & White Stripe Ribbon: Pink & White Stripe Ribbon used to indicate Erosion and Sediment Control Structures Silt Fence (SF) Reinforced Filter Fence (RFF) Super Silt Fence (SSF) Filter Sock (FS)
	Pink Ribbon: Pink Ribbon used to indicate Top Hole Location Pink Ribbon used to indicate Survey Control Location		Orange & White Stripe Ribbon: Orange & White Stripe Ribbon used to indicate Topsoil Stockpile Locations / Engineered Fill Stockpiles
	Pink & Black Stripe Ribbon: Pink & Black Stripe Ribbon used to indicate Vertical Cut (VC) at Pad/Pond/Pit corner or edge Pink & Black Stripe Ribbon used to indicate Vertical Fill (VF) at Pad/Pond/Pit corner or edge Vertical Cut/Vertical Fill to be determined at time of stakeout		Blue Ribbon: Blue Ribbon used to indicate Centerline (CL) Ditch Blue Ribbon used to indicate Bottom (BTM) Sediment Traps

R6 Construction Staking Guide

Scale: NTS

Revision
Design

Date
02-04-2025




THIS DOCUMENT
PREPARED FOR
HG ENERGY LLC




Typical Access Road Details
1221 Well Site
Freemans Creek District
Lewis County, WV


Date: 02/04/2025
Scale: As Shown
Designed By: ZS
File No.
Sheet R1 of R1

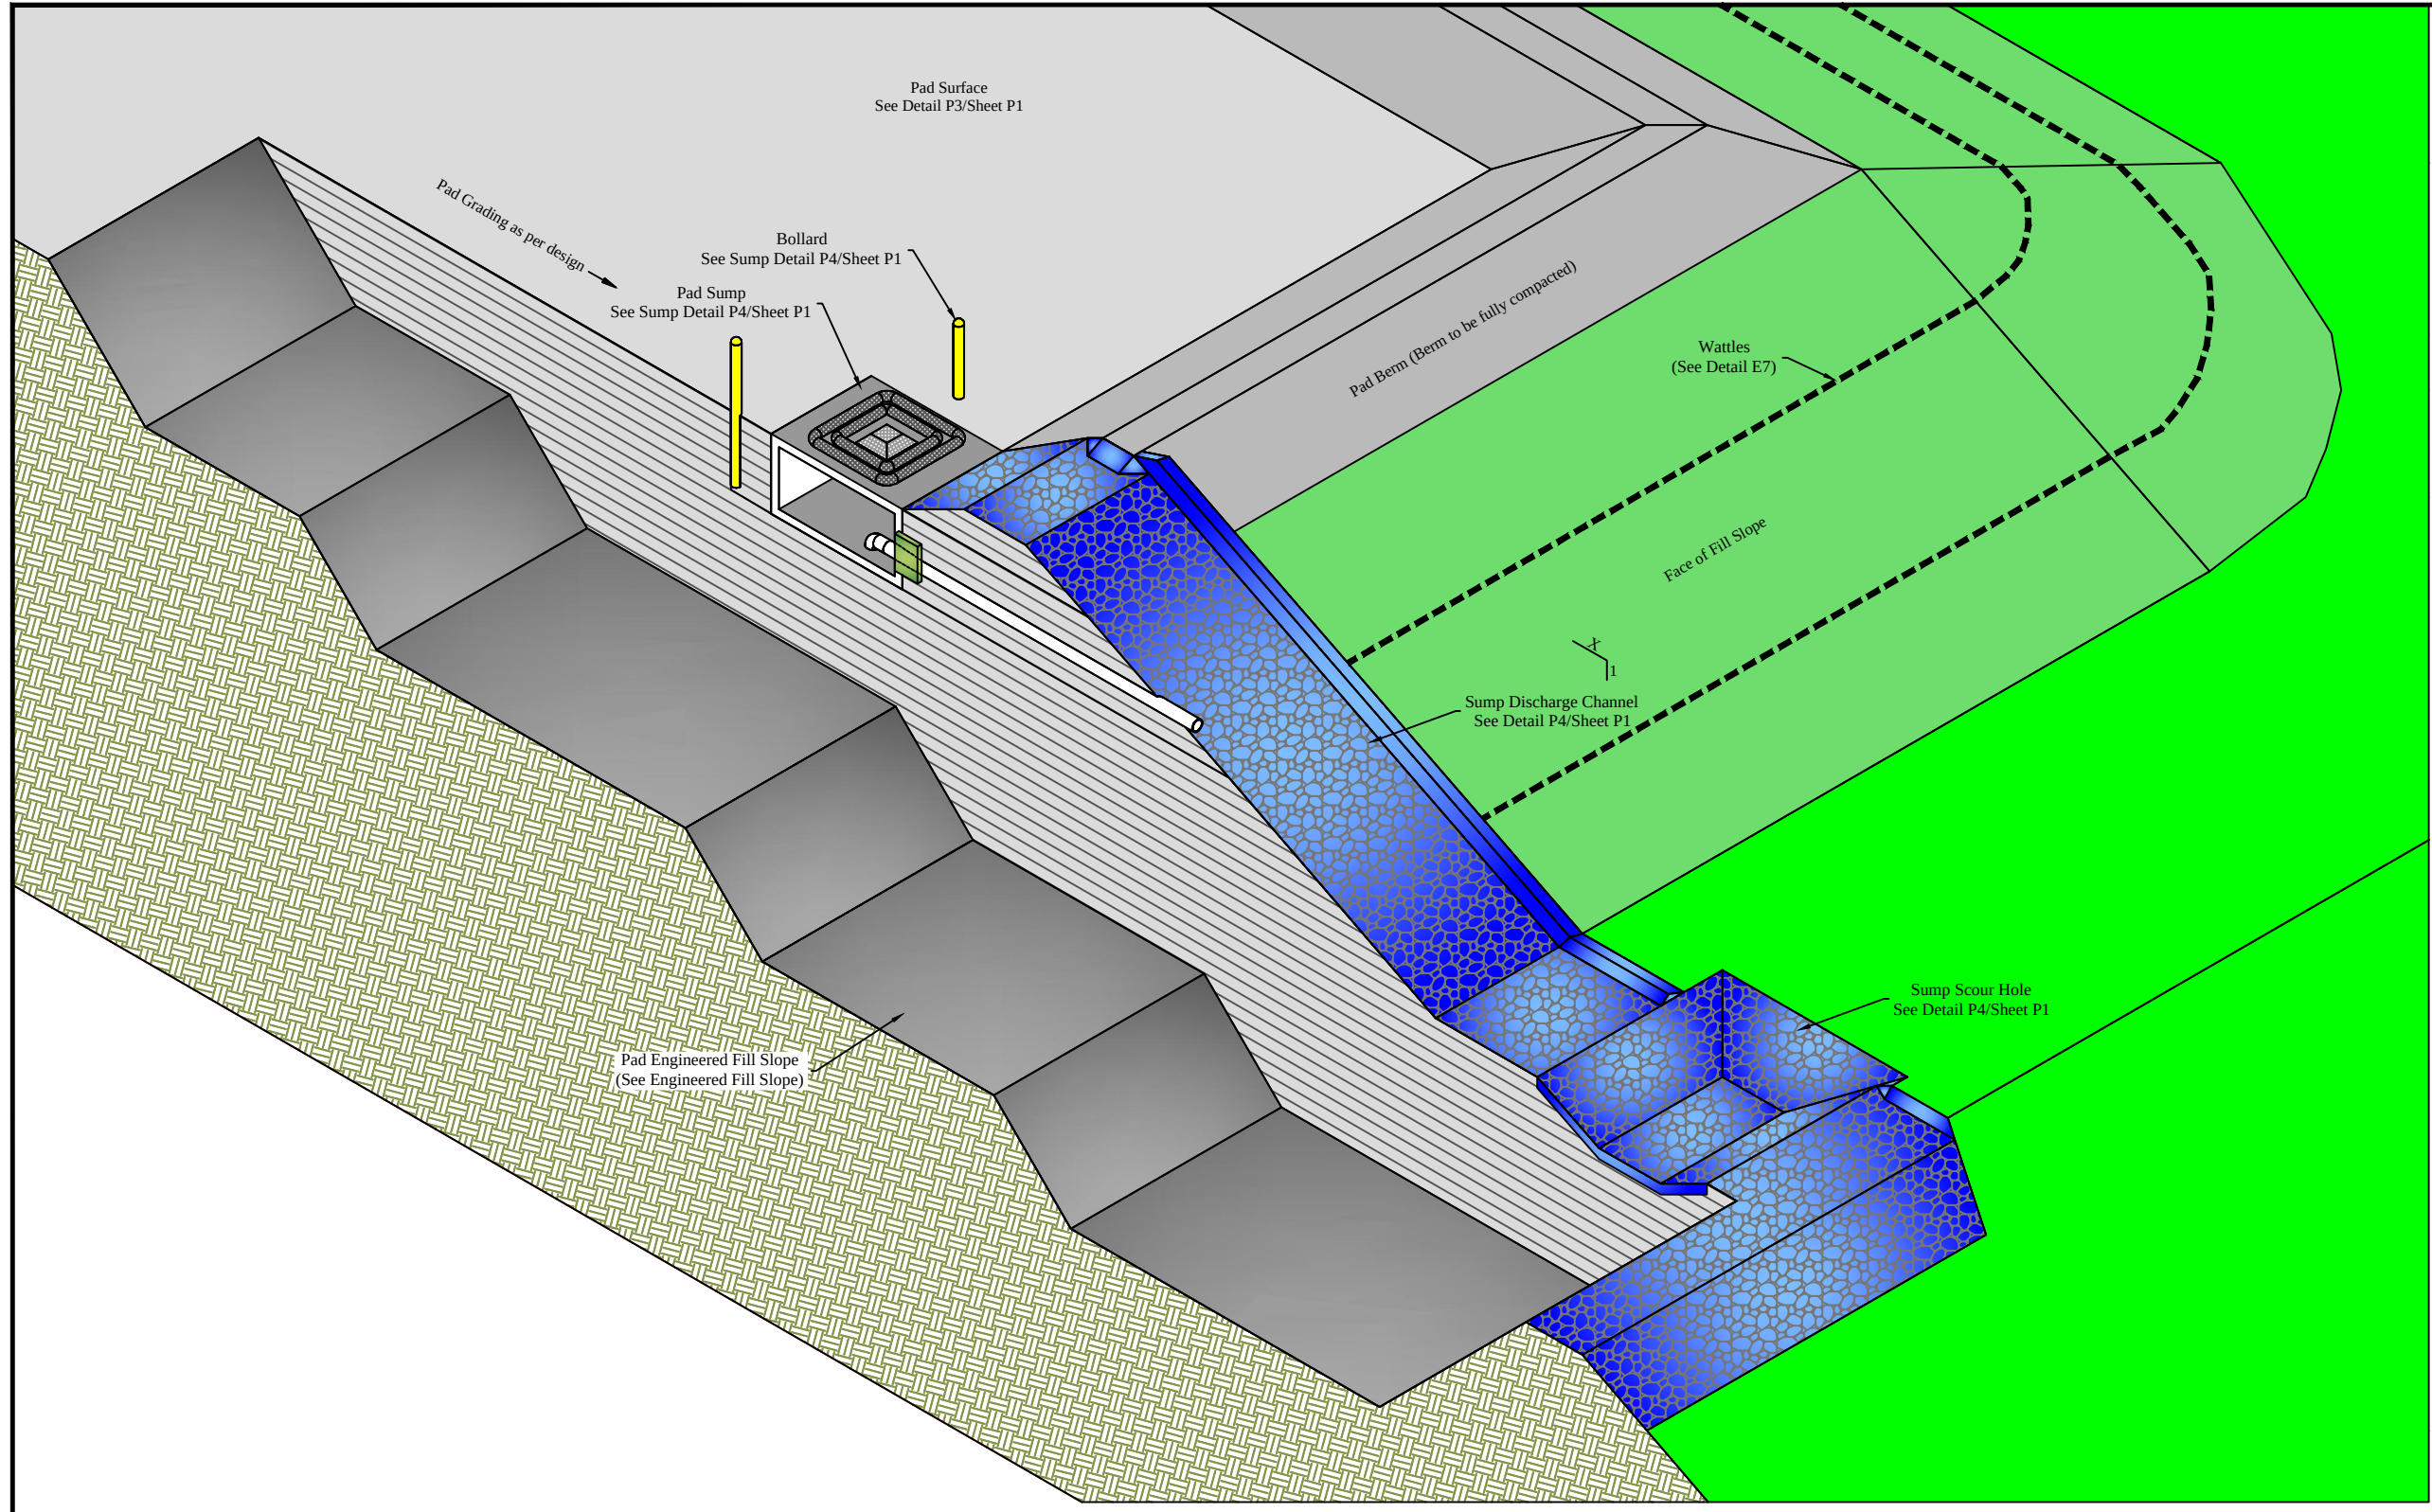


P1 Typical Pad Isometric View Detail
Scale: NTS

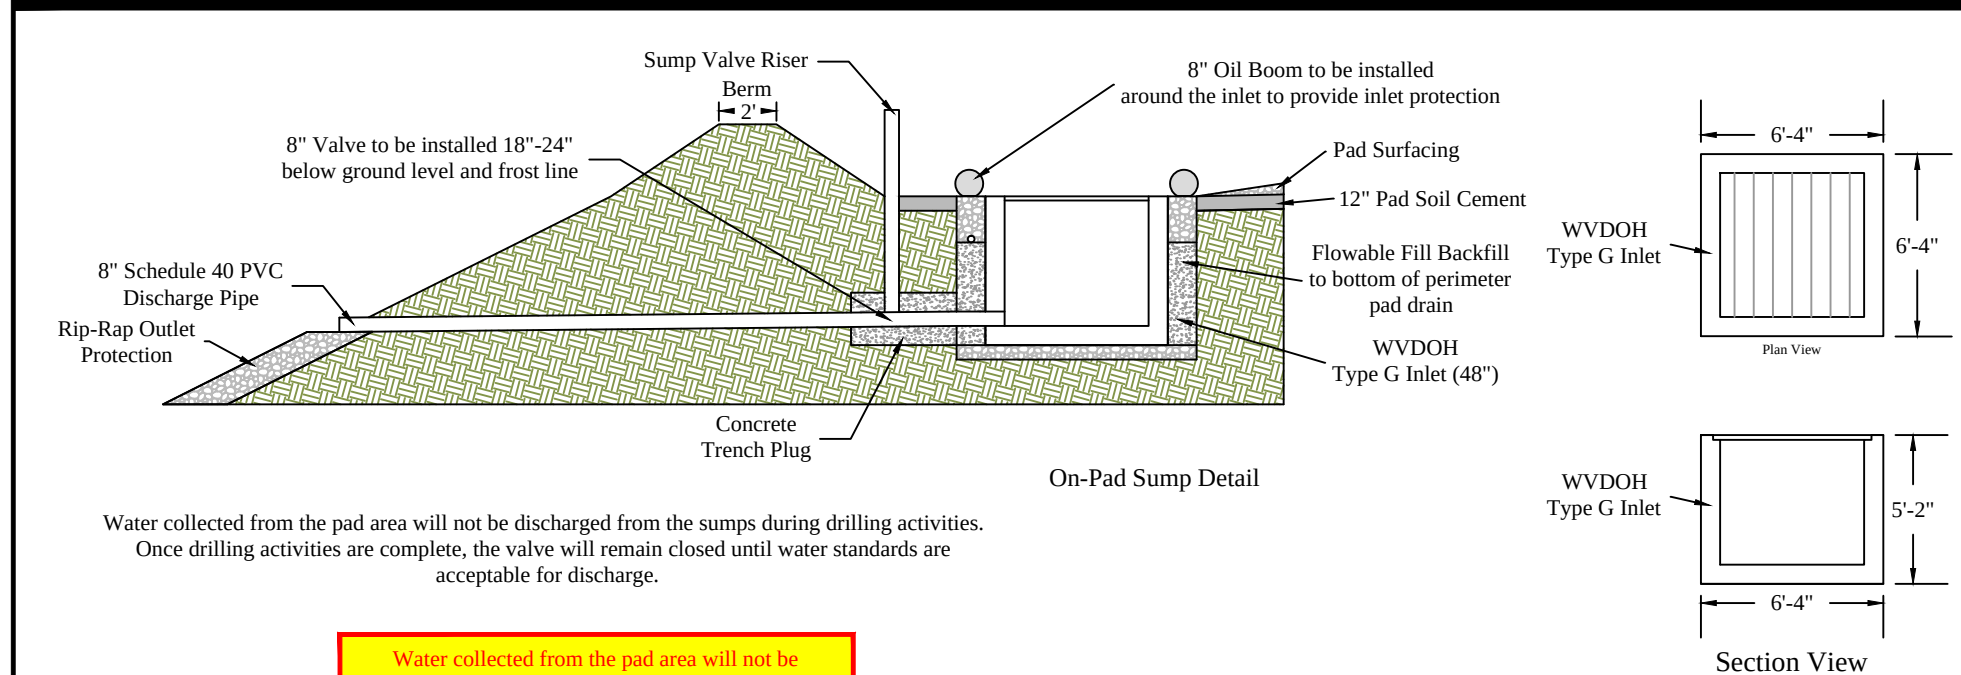


Water collected from the pad area will not be discharged from the sumps during drilling activities. Once drilling activities are complete, the valve will remain closed until water standards are acceptable for discharge.

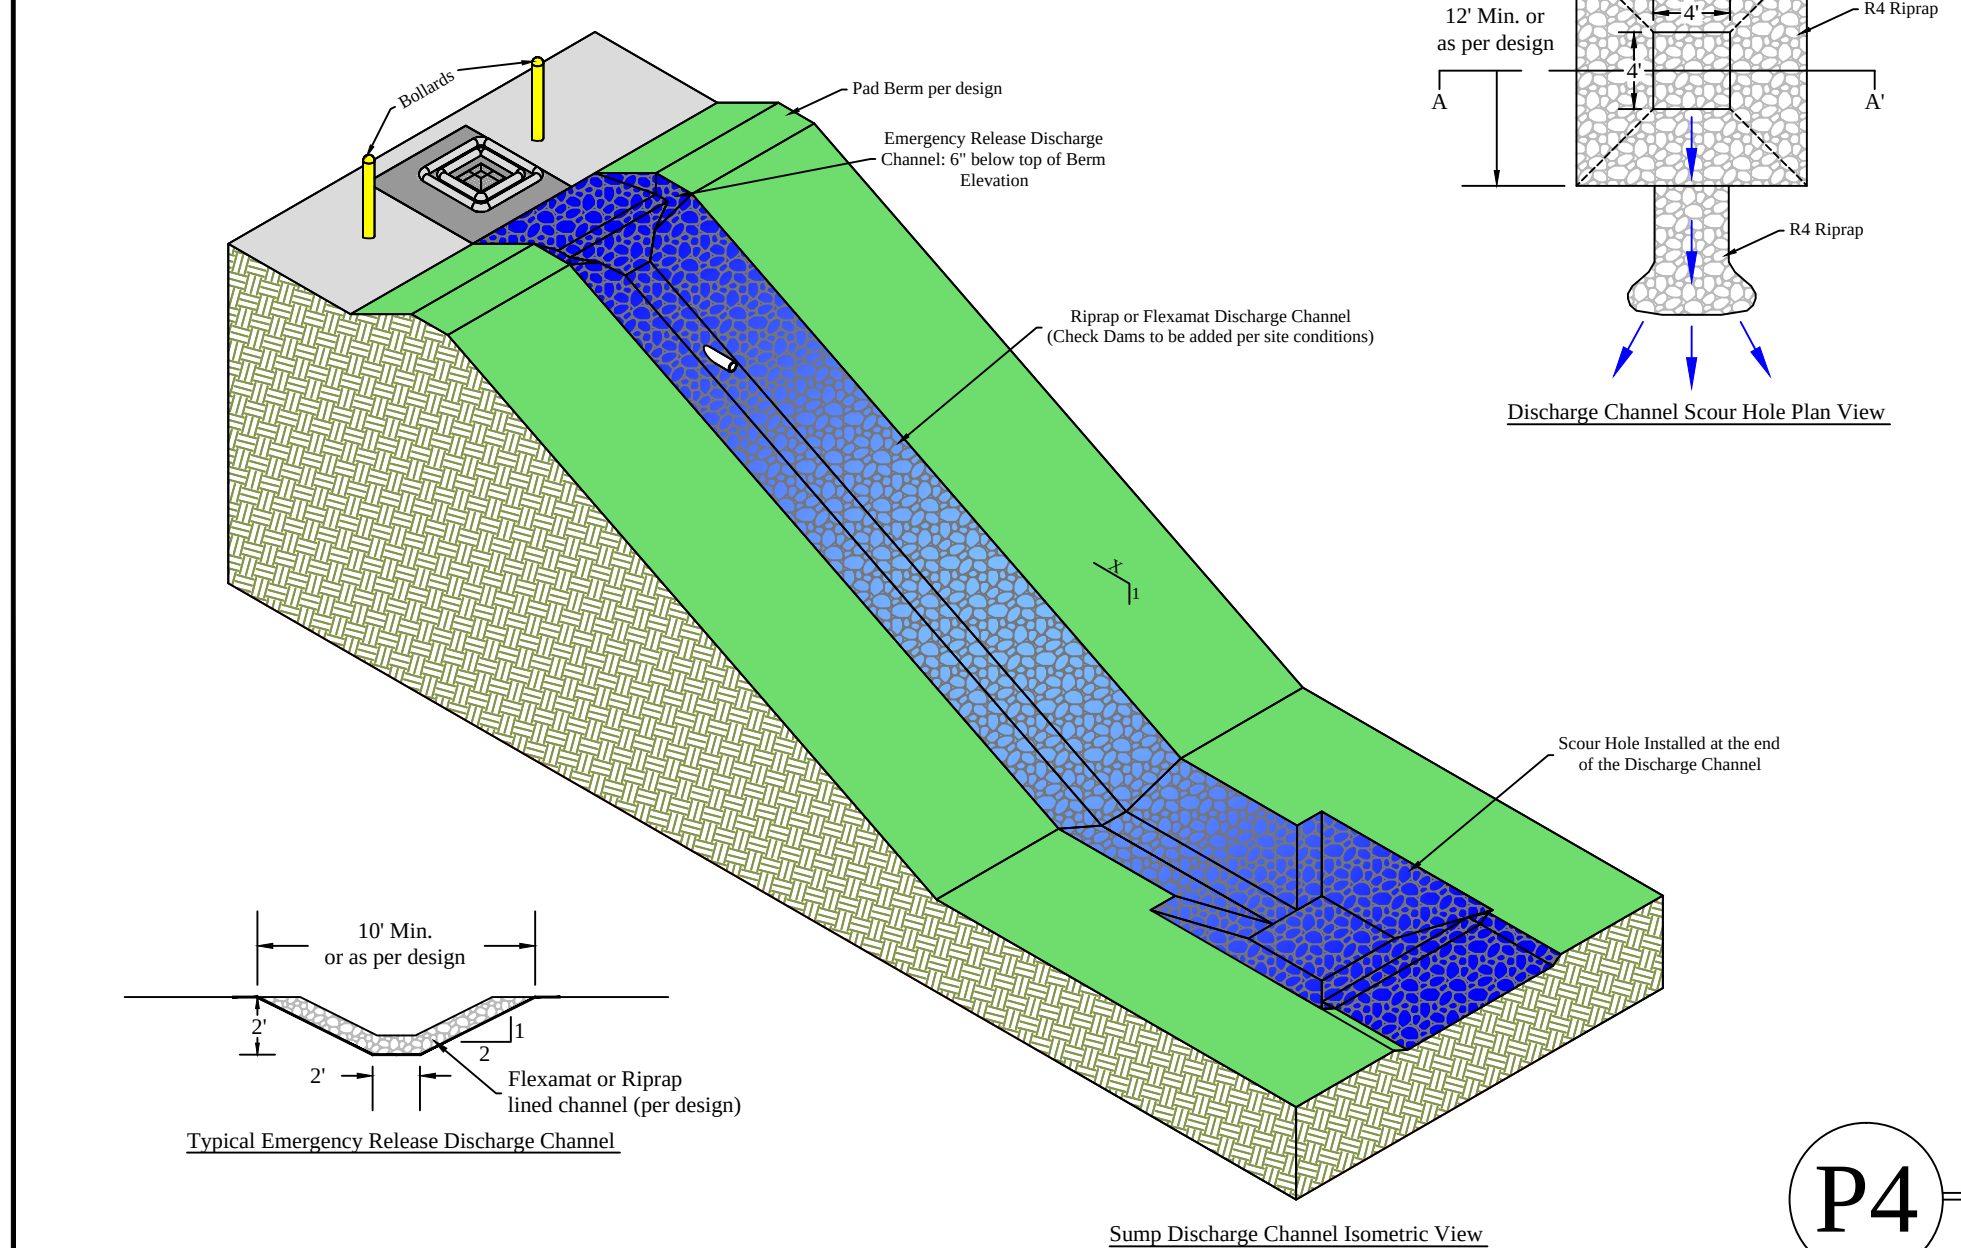


P4 On-Pad Sump Detail
Scale: NTS

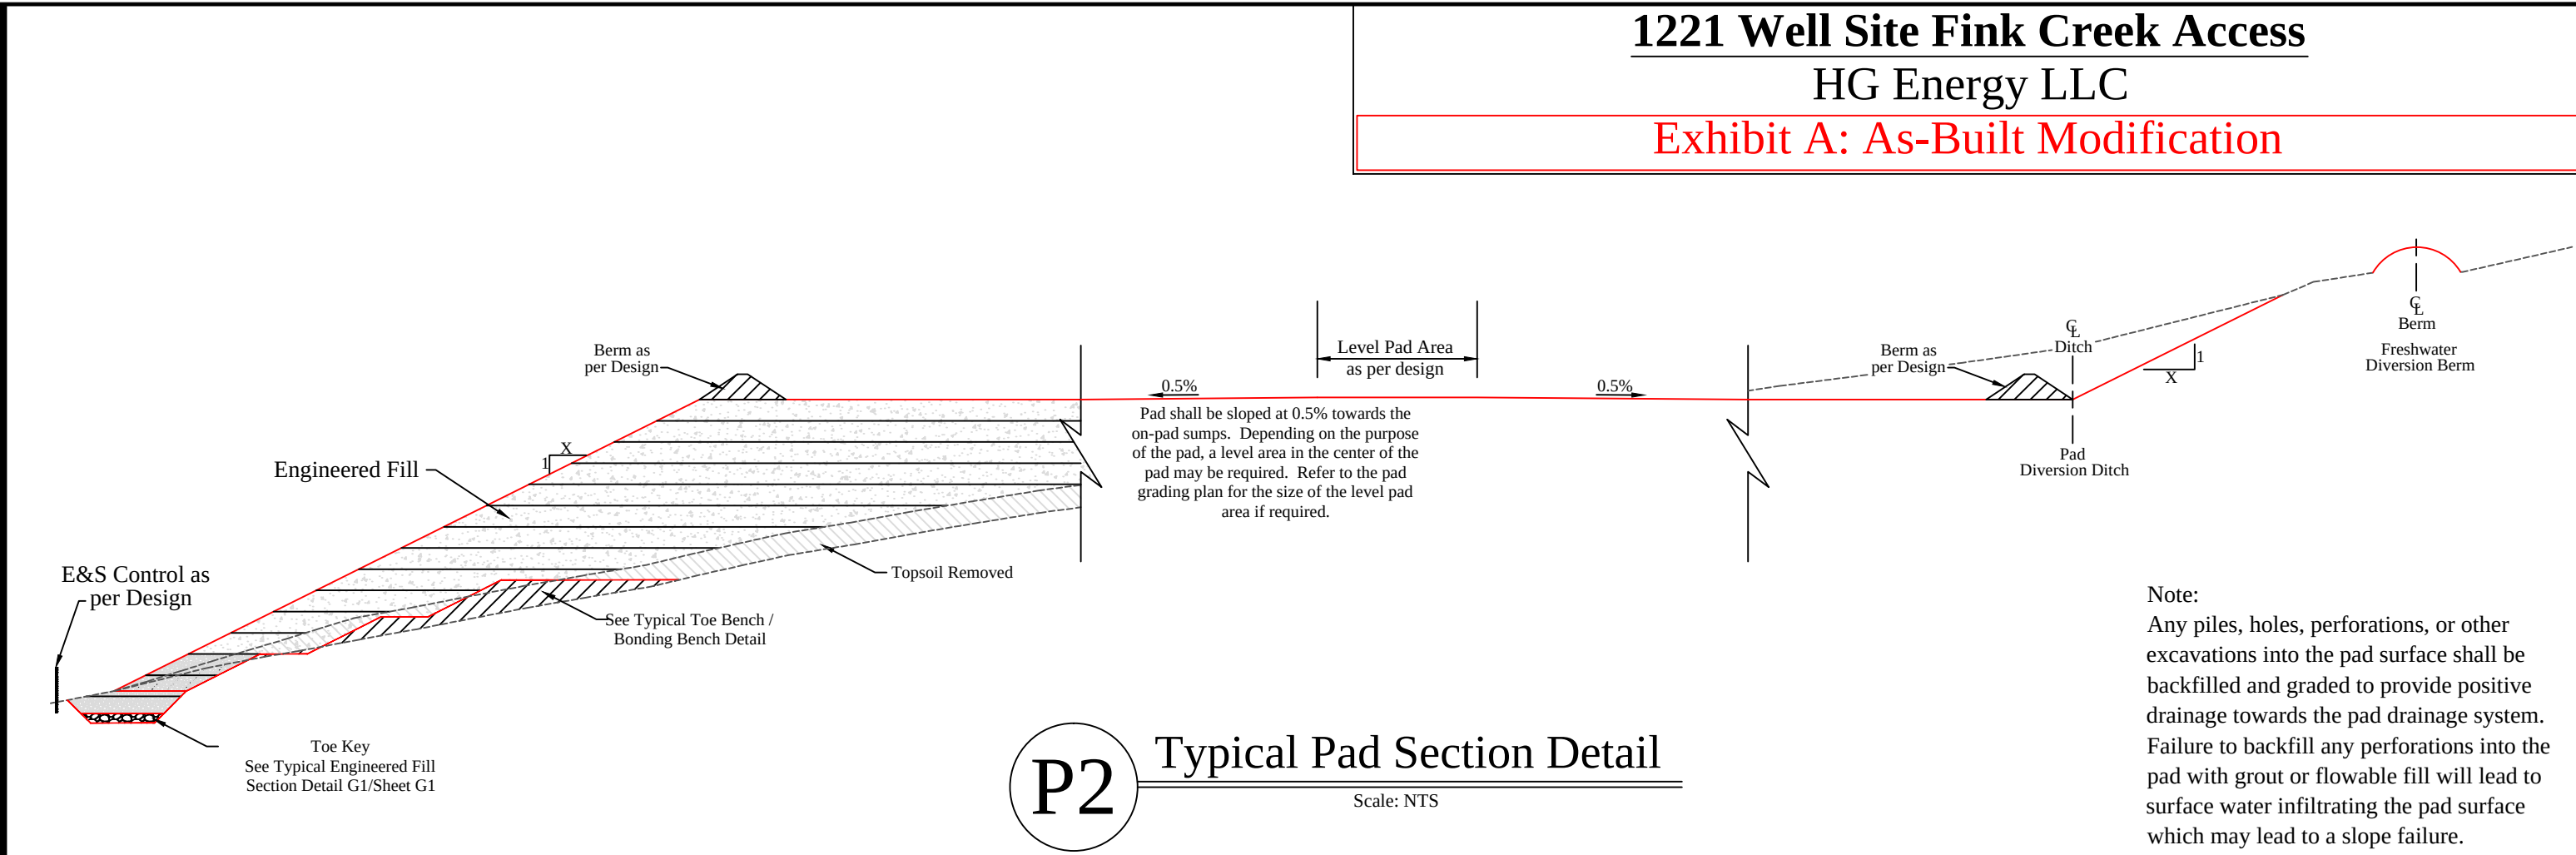


P2 Typical Pad Section Detail
Scale: NTS

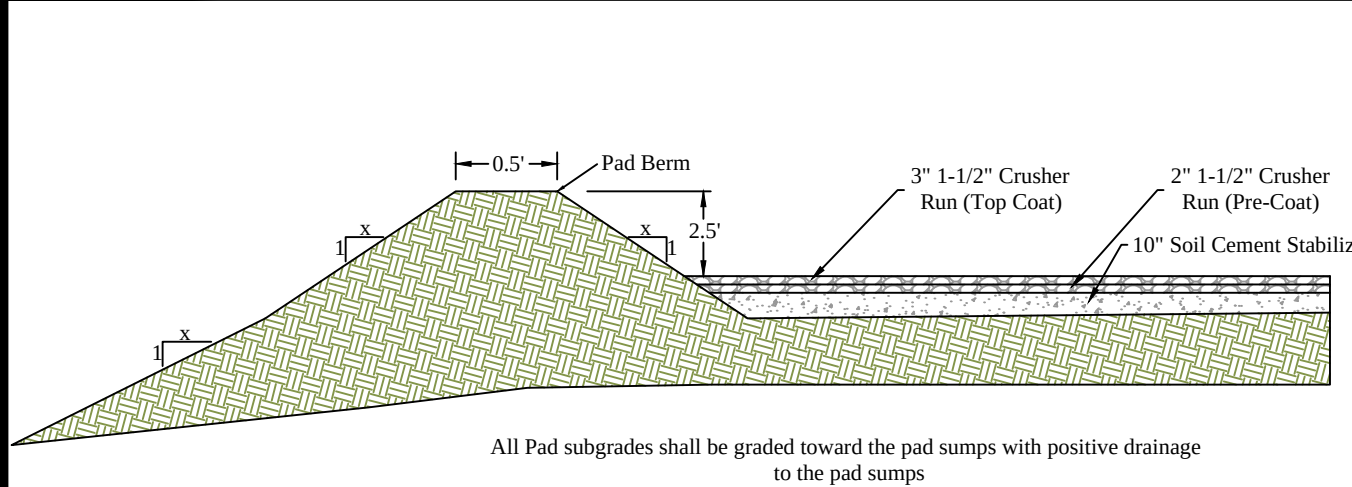

P3 Pad Surfacing Detail
Scale: NTS

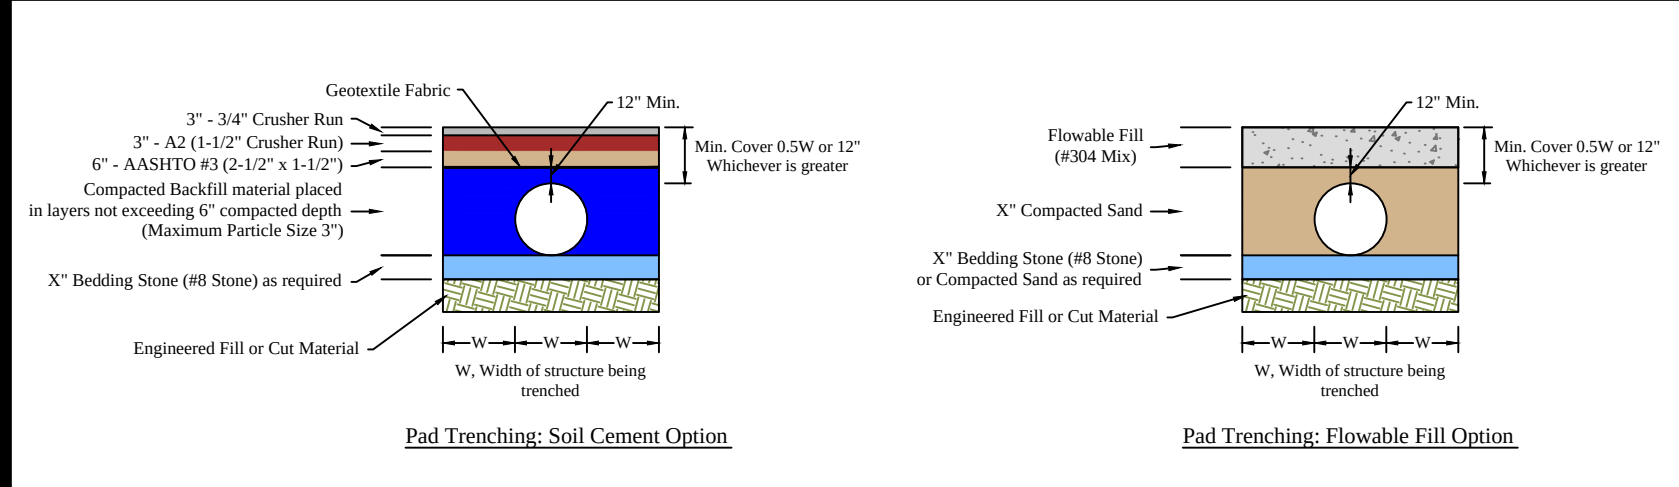

P6 Typical Pad Trenching Detail
Scale: NTS

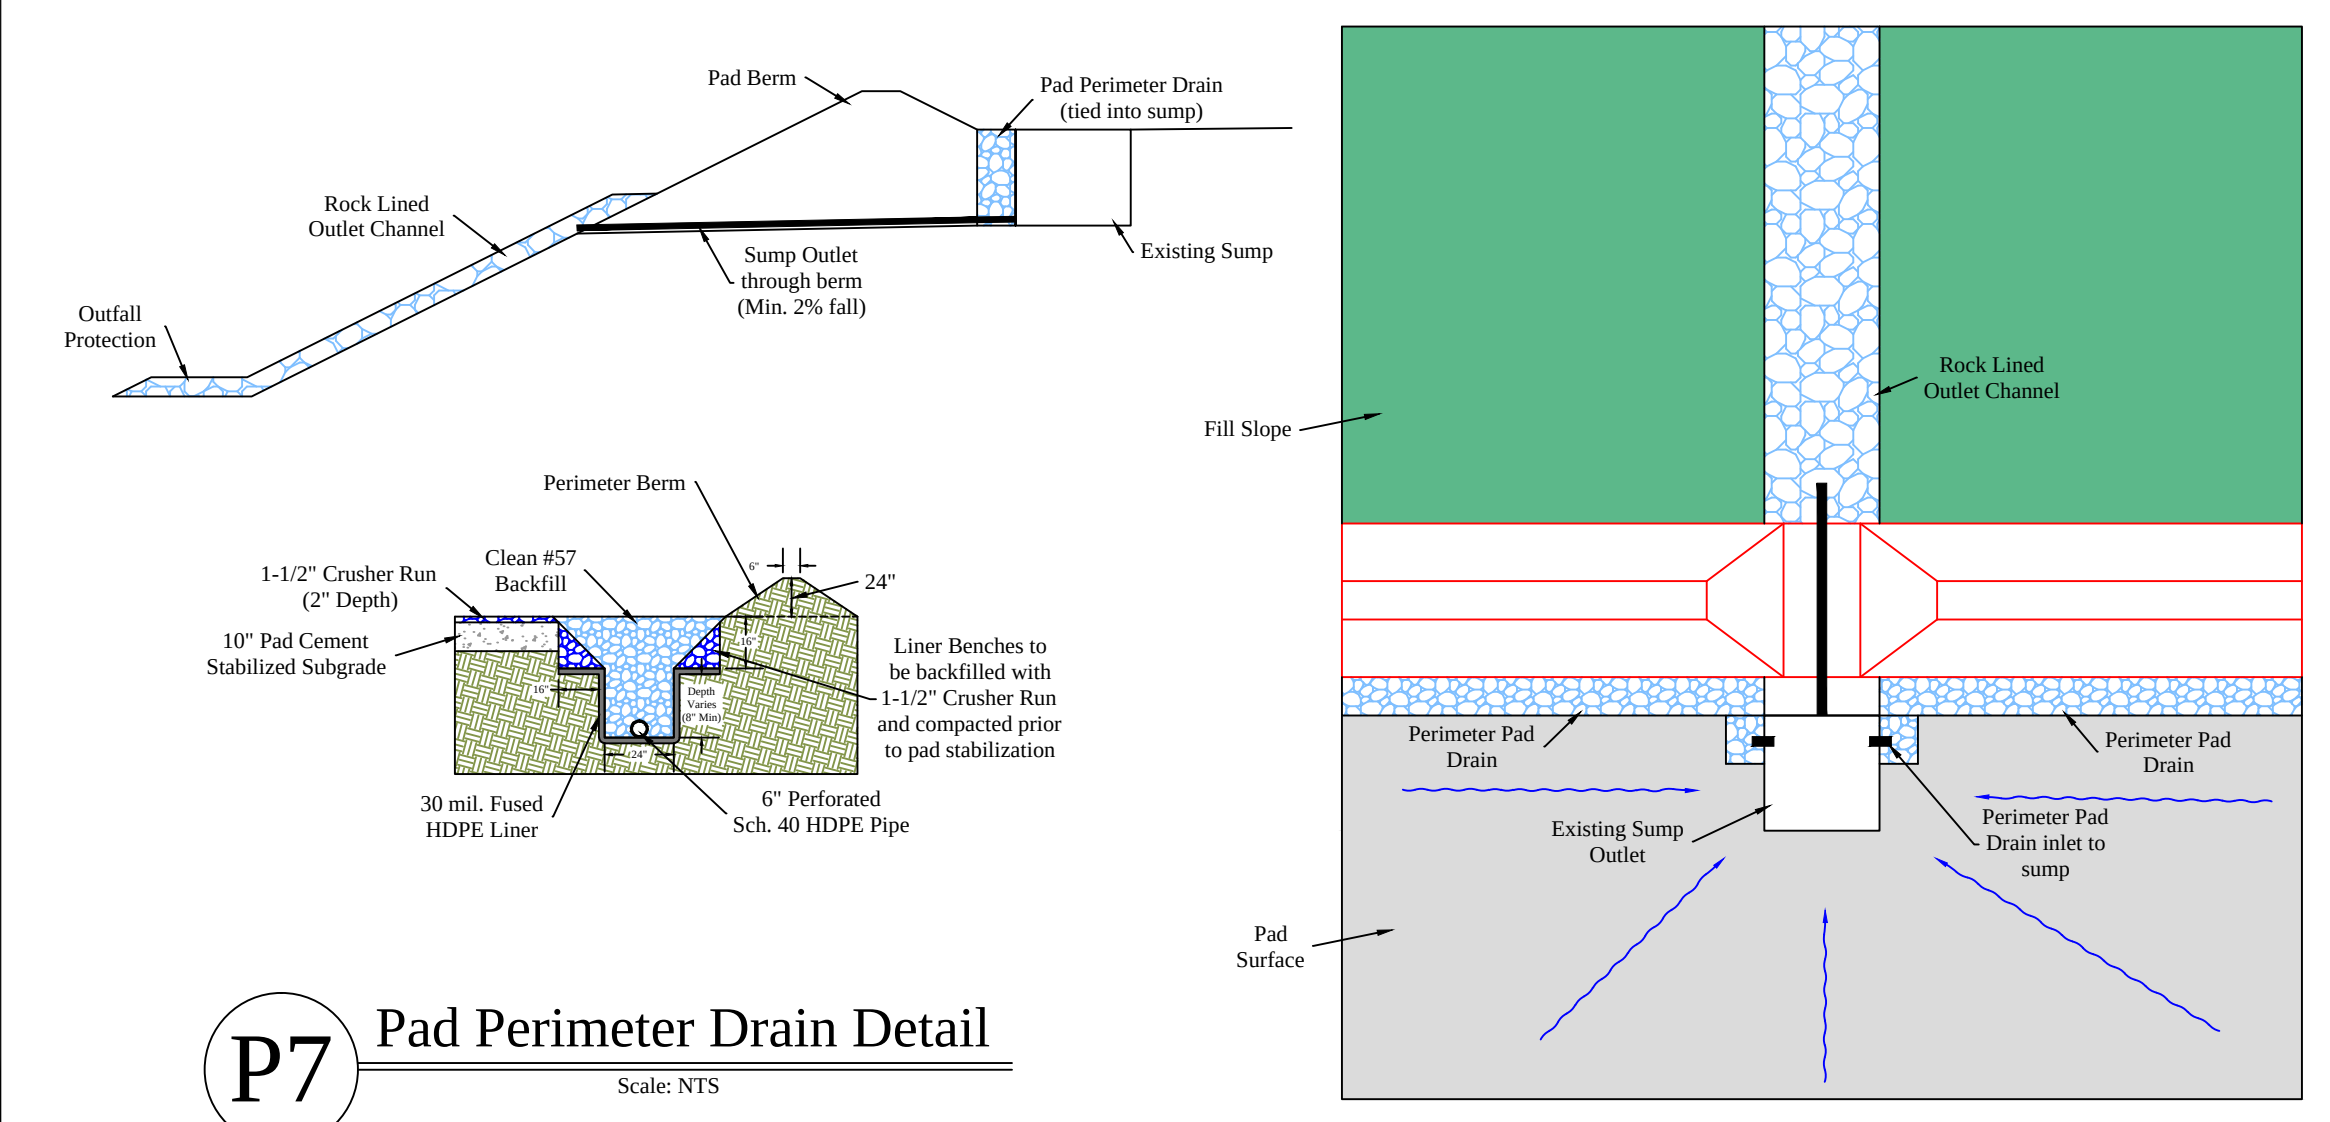

P7 Pad Perimeter Drain Detail
Scale: NTS

Revision	
Design	
Date	
02-04-2025	
THIS DOCUMENT PREPARED FOR HG ENERGY LLC	
Kelly Surveying P.O. Box 254 Beller, WV 26239 (304) 338-0965	
Typical Pad Details	
1221 Well Site	
Freemans Creek District	
Lewis County, WV	
Date: 02/04/2025	
Scale: As Shown	
Designed By: ZS	
File No.	
Sheet P1 of P1	

APPROVED
WVDEP OOG
Modification
3/14/2025